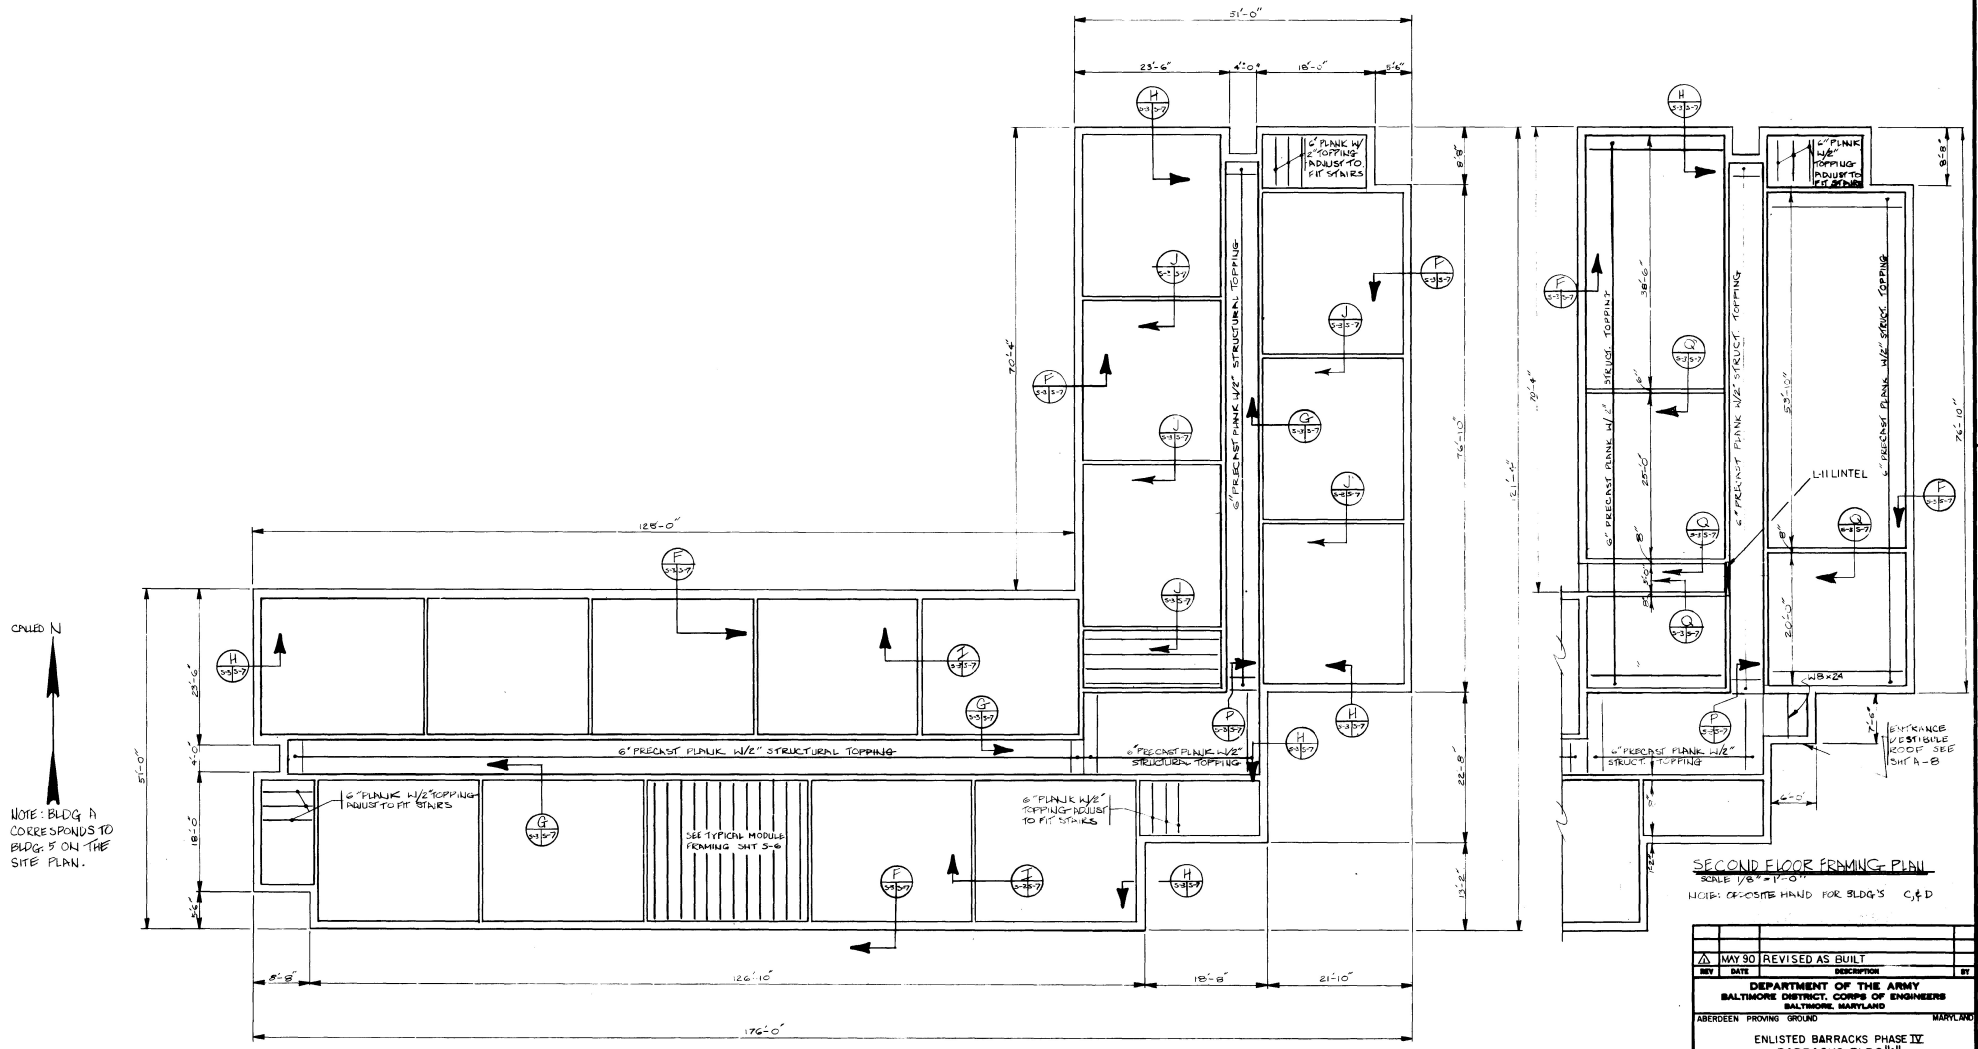

3RD FLOOR FRAMING PLAN
SCALE 1/8"=1'-0"
4 0 4 8 12 16 20

SECOND FLOOR FRAMING PLAN
SCALE 1/8"=1'-0"
NOTE: OPPOSITE HAND FOR BLDG'S C & D

REV	DATE	DESCRIPTION	BY
1	MAY 90	REVISED AS BUILT	

DEPARTMENT OF THE ARMY
BALTIMORE DISTRICT, CORPS OF ENGINEERS
BALTIMORE, MARYLAND

ABERDEEN PROVING GROUND MARYLAND

ENLISTED BARRACKS PHASE IV
BARRACKS BLDG. "A"
SECOND AND THIRD FLOOR
FRAMING PLAN

DRAWING NUMBER F-721-90-12 PLATE 100

SCALE: AS SHOWN DATE: 5 FEB. 1987 SHEET S-3

41805