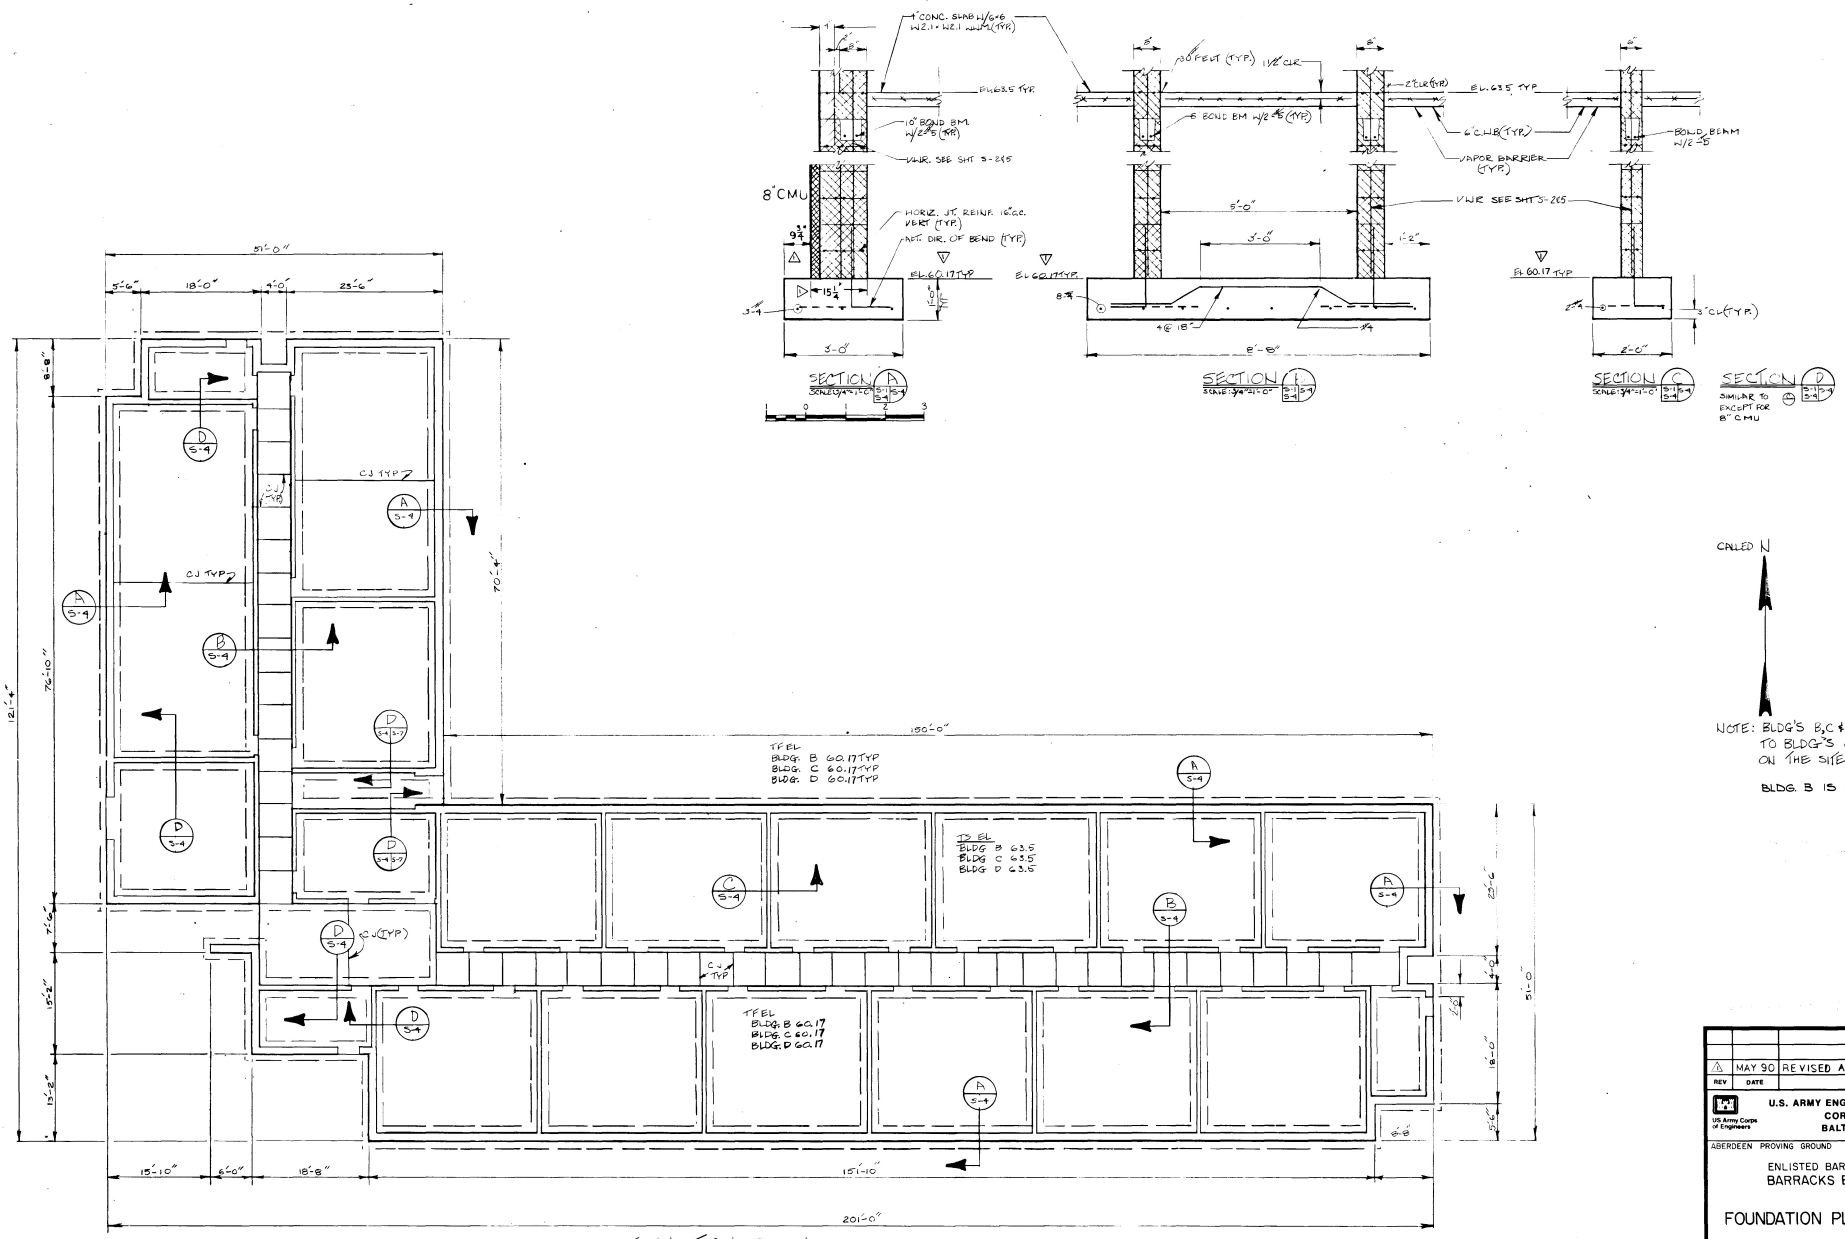

FOUNDATION-PLAN

SCALE: 1/8" = 1'-0"

NOTE: ALL MASONRY WALLS NOT SHOWN SHALL BE LIGHTWEIGHT

REV	DATE	DESCRIPTION	BY
1	MAY 90	REVISED AS BUILT	

US Army Corps of Engineers

U.S. ARMY ENGINEER DISTRICT, BALTIMORE
CORPS OF ENGINEERS
BALTIMORE, MARYLAND

ABERDEEN PROVING GROUND MARYLAND

ENLISTED BARRACKS PHASE IV
BARRACKS BLDG. "B", "C", & "D"

FOUNDATION PLAN AND DETAILS

DRAWING NUMBER F-721-90-12 PLATE 101

SCALE: AS SHOWN DATE: 5 FEB. 1987 SHEET S-4

41806