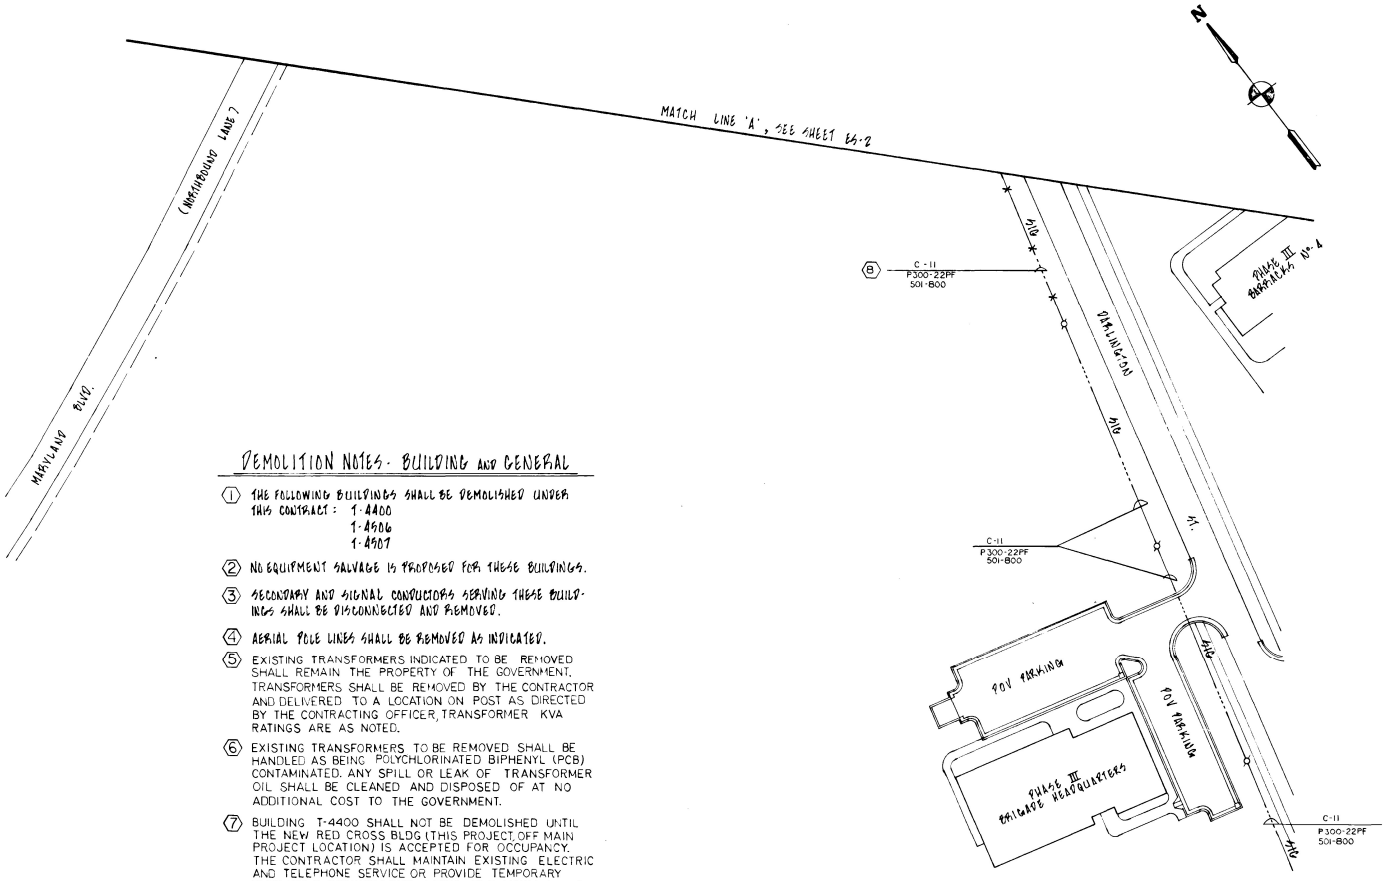

SITE PLAN

SCALE: 1 INCH = 40 FEET 0 INCHES

SITE LEGEND

EXISTING	EXISTING TO BE REMOVED	
P	P	AERIAL PRIMARY LINE KV RATING AS NOTED.
SIG	SIG	AERIAL SIGNAL LINE (TELEPHONE, FIRE ALARM, ETC.)
SEC	SEC	AERIAL SECONDARY
		WOOD POLE
		DOWN GUY
HG	HG	HEAD GUY
		POLE MOUNTED 1 ϕ TRANSFORMERS
UGT		UNDERGROUND TELEPHONE CABLE (FIBER OPTIC)
		CABLE CUT LOCATION

TELEPHONE CABLE LEGEND

C-11 / P300-22PF / 501-800 = CABLE NUMBER / NUMBER OF PAIRS-WIRE GAUGE, FLEXGEL FILLED / PAIR NUMBER

DEMOLITION NOTES - BUILDING AND GENERAL

1. THE FOLLOWING BUILDINGS SHALL BE DEMOLISHED UNDER THIS CONTRACT: 1-4400, 1-4506, 1-4507
2. NO EQUIPMENT SALVAGE IS PROPOSED FOR THESE BUILDINGS.
3. SECONDARY AND SIGNAL CONDUCTORS SERVING THESE BUILDINGS SHALL BE DISCONNECTED AND REMOVED.
4. AERIAL POLE LINES SHALL BE REMOVED AS INDICATED.
5. EXISTING TRANSFORMERS INDICATED TO BE REMOVED SHALL REMAIN THE PROPERTY OF THE GOVERNMENT. TRANSFORMERS SHALL BE REMOVED BY THE CONTRACTOR AND DELIVERED TO A LOCATION ON POST AS DIRECTED BY THE CONTRACTING OFFICER. TRANSFORMER KVA RATINGS ARE AS NOTED.
6. EXISTING TRANSFORMERS TO BE REMOVED SHALL BE HANDLED AS BEING POLYCHLORINATED BIPHENYL (PCB) CONTAMINATED. ANY SPILL OR LEAK OF TRANSFORMER OIL SHALL BE CLEANED AND DISPOSED OF AT NO ADDITIONAL COST TO THE GOVERNMENT.
7. BUILDING T-4400 SHALL NOT BE DEMOLISHED UNTIL THE NEW RED CROSS BLDG (THIS PROJECT, OFF MAIN PROJECT LOCATION) IS ACCEPTED FOR OCCUPANCY. THE CONTRACTOR SHALL MAINTAIN EXISTING ELECTRIC AND TELEPHONE SERVICE OR PROVIDE TEMPORARY ELEC/TELE SERVICE WHICH MEETS THE APPROVAL OF THE CONTRACTING OFFICER TO THIS BUILDING. TEMPORARY ELEC/TELE SERVICE FOR THIS BUILDING WILL BE PROVIDED AT NO ADDITIONAL COST TO THE GOVERNMENT.
8. EXISTING TELEPHONE CABLE SHALL NOT BE REMOVED UNTIL NEW TELEPHONE CABLE IS INSTALLED. REMOVAL OF EXISTING TELEPHONE CABLE AND INSTALLATION OF NEW TELEPHONE CABLE SHALL BE ACCOMPLISHED WITH NO INTERRUPTION OF SERVICE. FOR LOCATION OF NEW TELEPHONE CABLE SEE SHEETS ES-3 AND ES-4.

REV	DATE	DESCRIPTION	BY
	MAY 90	AS BUILT	

U.S. Army Corps of Engineers

U.S. ARMY ENGINEER DISTRICT, BALTIMORE
CORPS OF ENGINEERS
BALTIMORE, MARYLAND

ABERDEEN PROVING GROUND MARYLAND

ENLISTED BARRACKS PHASE IV

DEMOLITION PLAN

LEGEND AND NOTES

DRAWING NUMBER F-721-90-12 PLATE 167

SCALE 1" = 40'-0" DATE: 5 FEB 1987 SHEET ES-1

41872