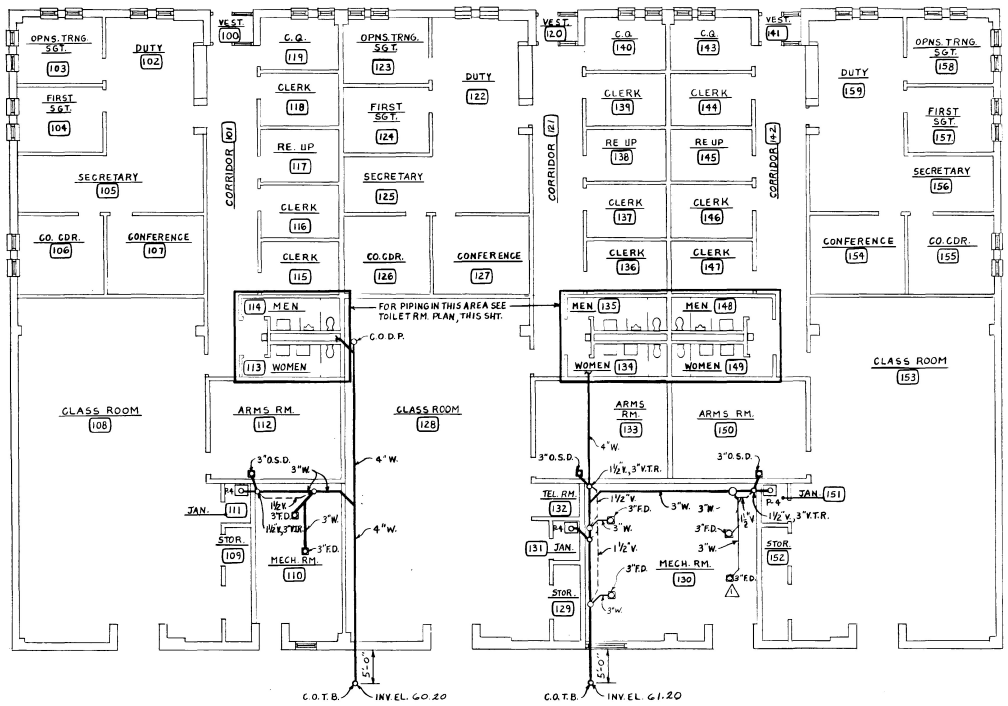

PLUMBING PLAN
DRAIN, WASTE & VENT PIPING
SCALE: 1/8"=1'-0"

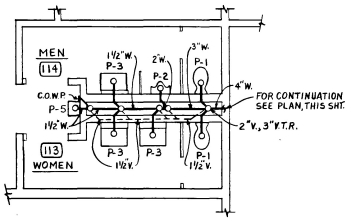

TOILET RMS. 113 & 114
DRAIN, WASTE & VENT PIPING
SCALE: 1/4"=1'-0"

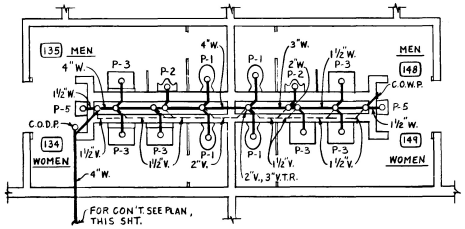

TOILET ROOMS 134, 135, 148 & 149
DRAIN, WASTE & VENT PIPING
SCALE: 1/4"=1'-0"

SCALE: 1/8 IN.=1 FT.
SCALE: 1/4 IN. = 1 FT.

REV	DATE	DESCRIPTION	BY
1	MAY 90	REVISED AS BUILT	

US Army Corps of Engineers

U.S. ARMY ENGINEER DISTRICT, BALTIMORE
CORPS OF ENGINEERS
BALTIMORE, MARYLAND

ABERDEEN PROVING GROUND MARYLAND

ENLISTED BARRACKS PHASE IV
ADMIN. & SUPPLY BLDG.

DRAIN WASTE AND VENT PIPING

DRAWING NUMBER F-721-90-12
PLATE 156

SCALE: AS SHOWN
DATE: FEB. 1987
SHEET P-9

[redacted]

41861