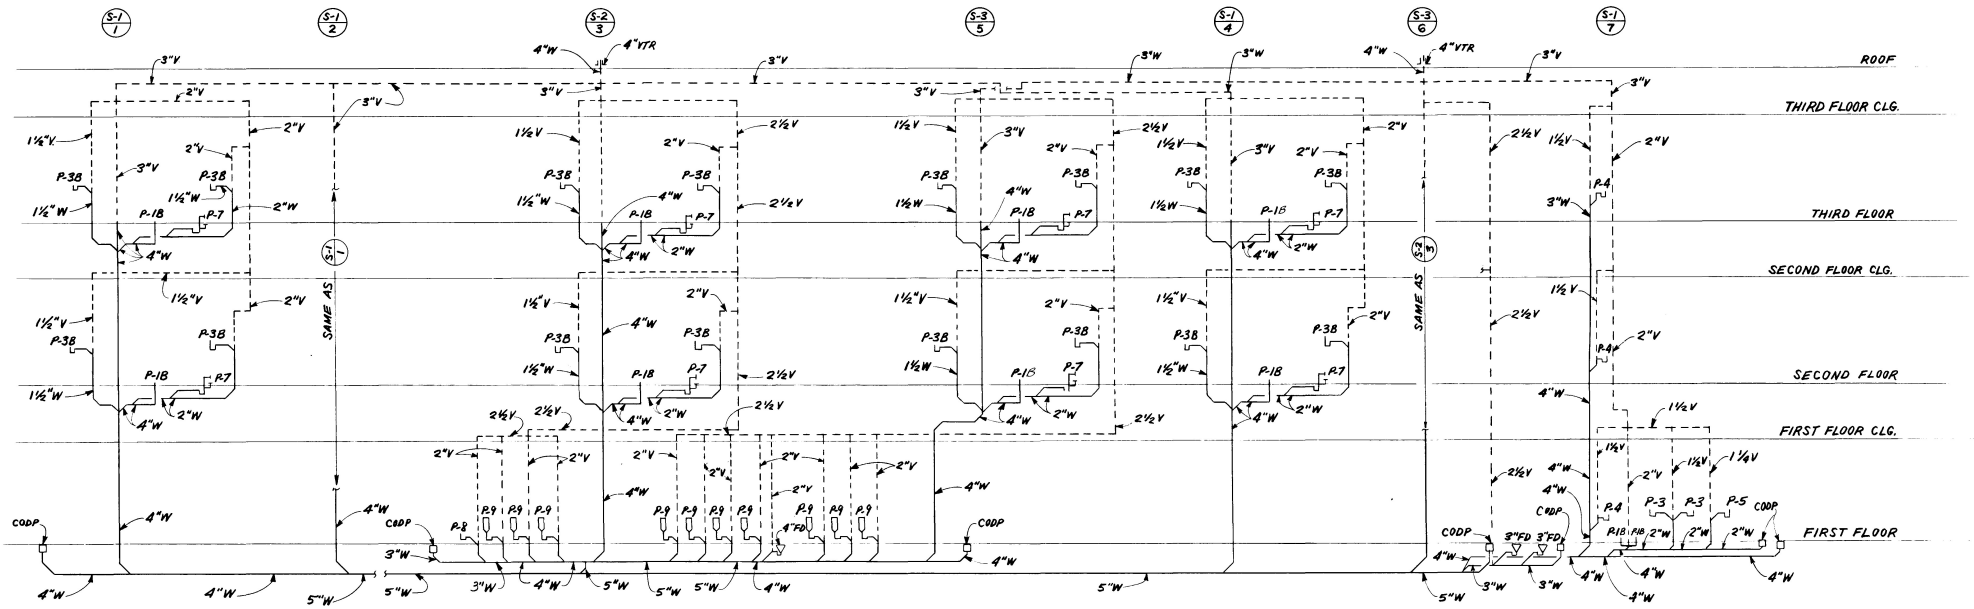

DRAIN, WASTE + VENT RISER DIAGRAM
NOT TO SCALE

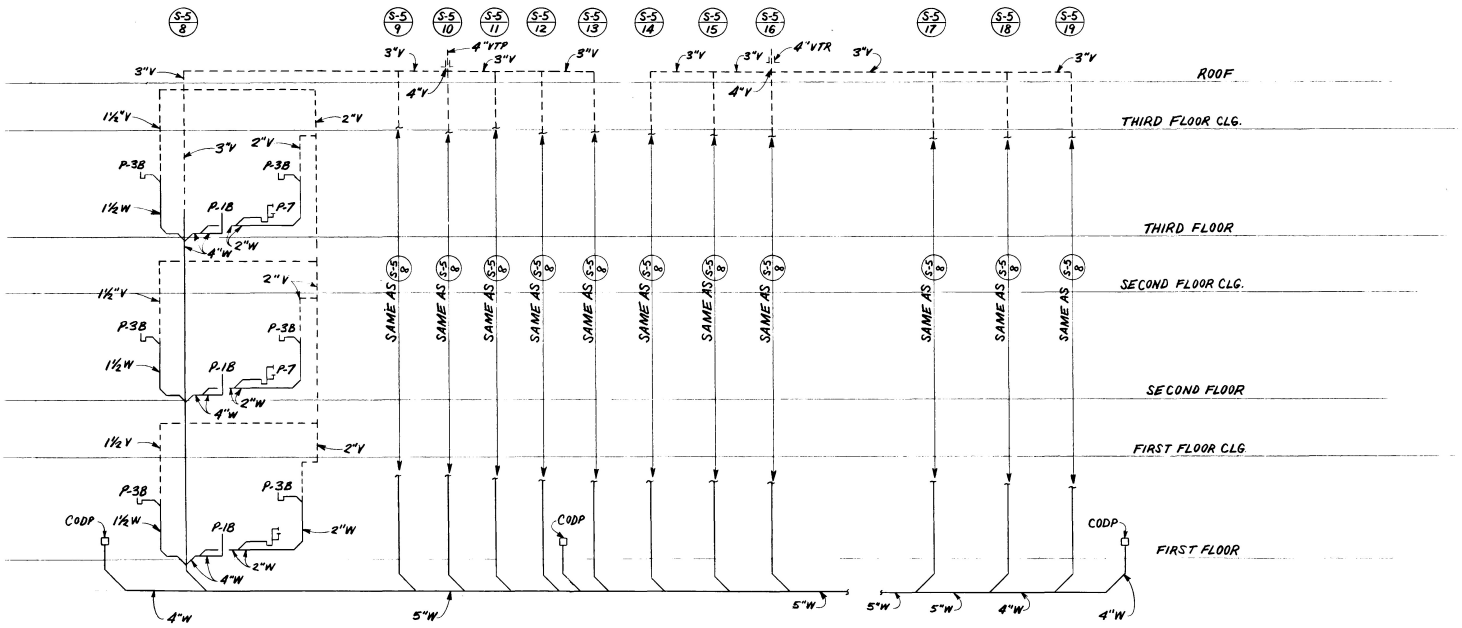

DRAIN, WASTE + VENT RISER DIAGRAM
NOT TO SCALE

GENERAL NOTES:

1. WASTE AND VENT RISER (S-5/18) AND (S-3/19) ARE NOT REQUIRED FOR BLDG #5
2. PROVIDE ONLY 8 WASHING MACHINES (P-9) FOR BLDG #5 (SEE ARCH. DWGS.)

REV	DATE	DESCRIPTION	BY
	MAY 90	AS BUILT	

US Army Corps of Engineers

U.S. ARMY ENGINEER DISTRICT, BALTIMORE
CORPS OF ENGINEERS
BALTIMORE, MARYLAND

ABERDEEN PROVING GROUND MARYLAND

ENLISTED BARRACKS PHASE IV
BARRACKS BLDG.
DRAIN WASTE AND VENT
RISER PIPING

DRAWING NUMBER F-721-90-12
PLATE 151

SCALE: AS SHOWN
DATE: 5 FEB 1987
SHEET P-4

41856