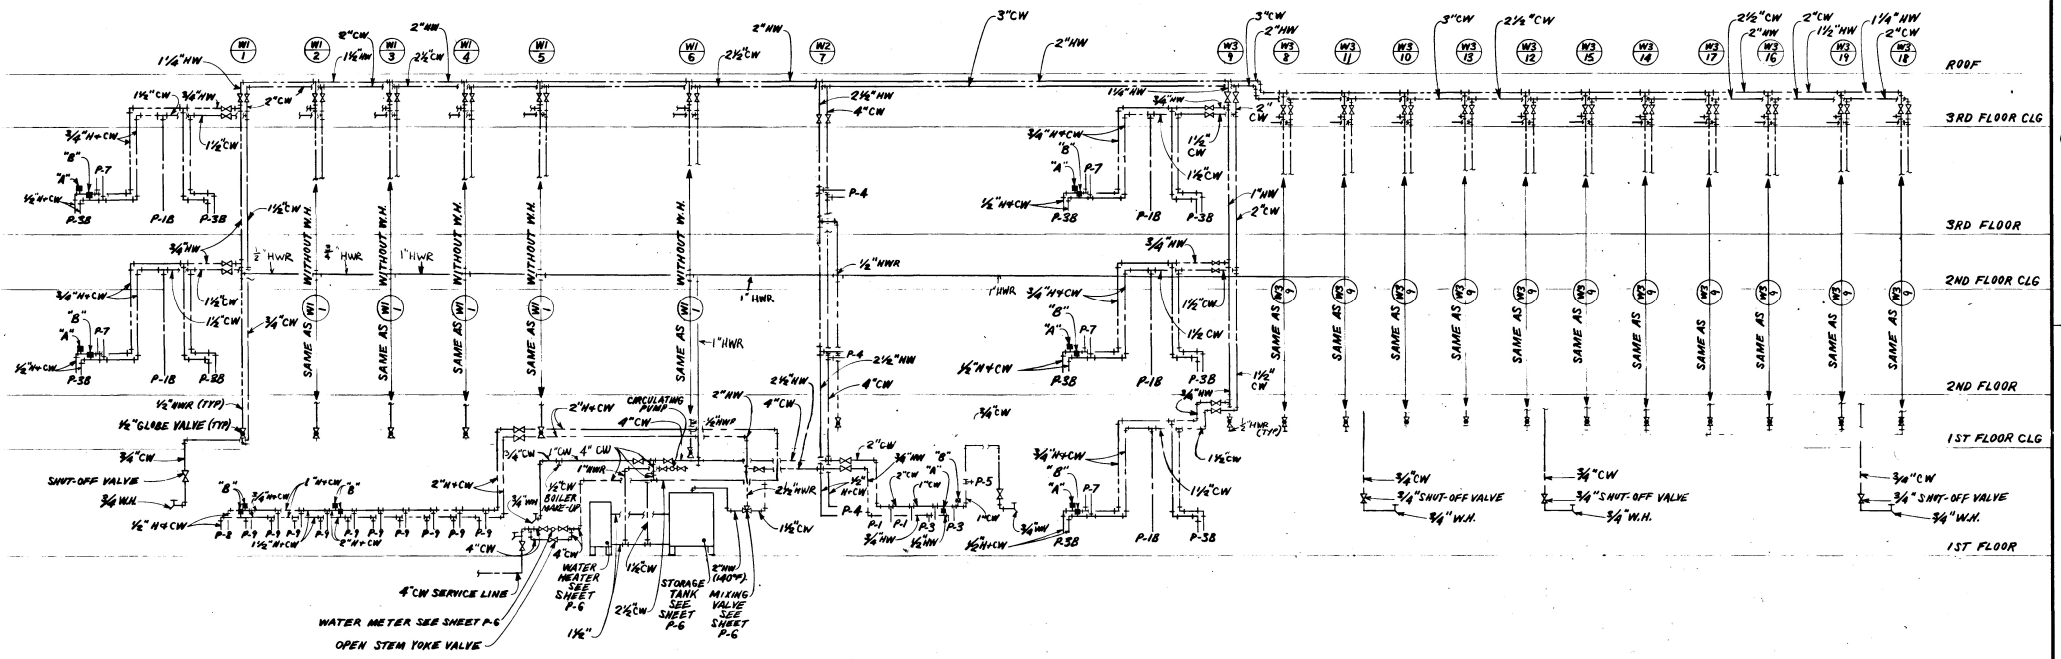

DOMESTIC WATER RISER DIAGRAM

NOT TO SCALE

NOTES

1. RISER W-3/18 AND W-3/19 ARE NOT REQUIRED ON BLDG. #5
2. FOR EQUIPMENT SIZES SEE SHEET P-6
3. PROVIDE ONLY 8 CLOTHES WASHING MACHINES (P-9) FOR BLDG. #5 (SEE ARCH. DWGS.)

REV	DATE	DESCRIPTION	BY
1	MAY 90	REVISED AS BUILT	

US Army Corps of Engineers

U.S. ARMY ENGINEER DISTRICT, BALTIMORE
CORPS OF ENGINEERS
BALTIMORE, MARYLAND

ABERDEEN PROVING GROUND MARYLAND

ENLISTED BARRACKS PHASE IV
BARRACKS BLDG.

DOMESTIC WATER RISER DIAGRAM

DRAWING NUMBER F-721-90-12 PLATE 155

SCALE: AS SHOWN DATE: 5 FEB. 1987 SHEET P-8

41860