NOTE:
FOR NORTH ARROW SEE SITE DRAWINGS

NOTES:
1. SEE RISER DIAGRAM ON SHEET P-4 AND TOILET RM. PLAN ON SHEET P-1, FOR ALL PIPE SIZES NOT SHOWN.

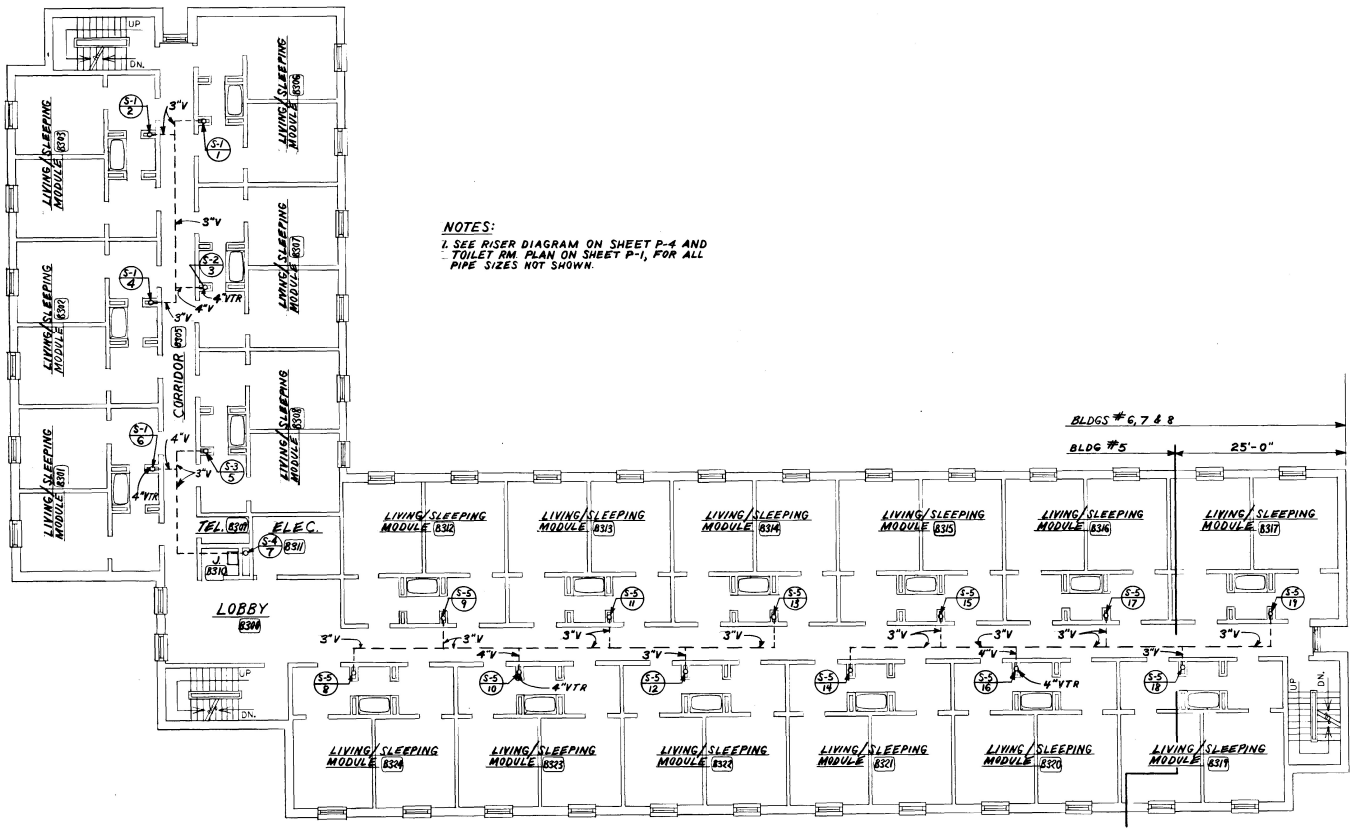

DRAIN WASTE & VENT PIPING
THIRD FLOOR PLAN
SCALE: 1/8 = 1'-0"

SCALE: 1/8 IN. = 1 FT.
4 0 4 8 12 16 20

REV	DATE	DESCRIPTION	BY
	MAY 90	AS BUILT	

US Army Corps of Engineers
U.S. ARMY ENGINEER DISTRICT, BALTIMORE
CORPS OF ENGINEERS
BALTIMORE, MARYLAND

ABERDEEN PROVING GROUND MARYLAND

ENLISTED BARRACKS PHASE IV
BARRACKS BLDG.
THIRD FLOOR, DRAIN, WASTE & VENT PIPING

DRAWING NUMBER: F-721-90-12
PLATE: 150
SCALE: AS SHOWN
DATE: 5 FEB. 1987
SHEET: P-3

41855