NOTE:
FOR NORTH ARROW
SEE SITE DWGS

NOTE:
FOR PIPE SIZES NOT SHOWN, SEE RISER DIAGRAM ON SHEET P-8 AND TOILET ROOM PLAN ON SHEET P-5

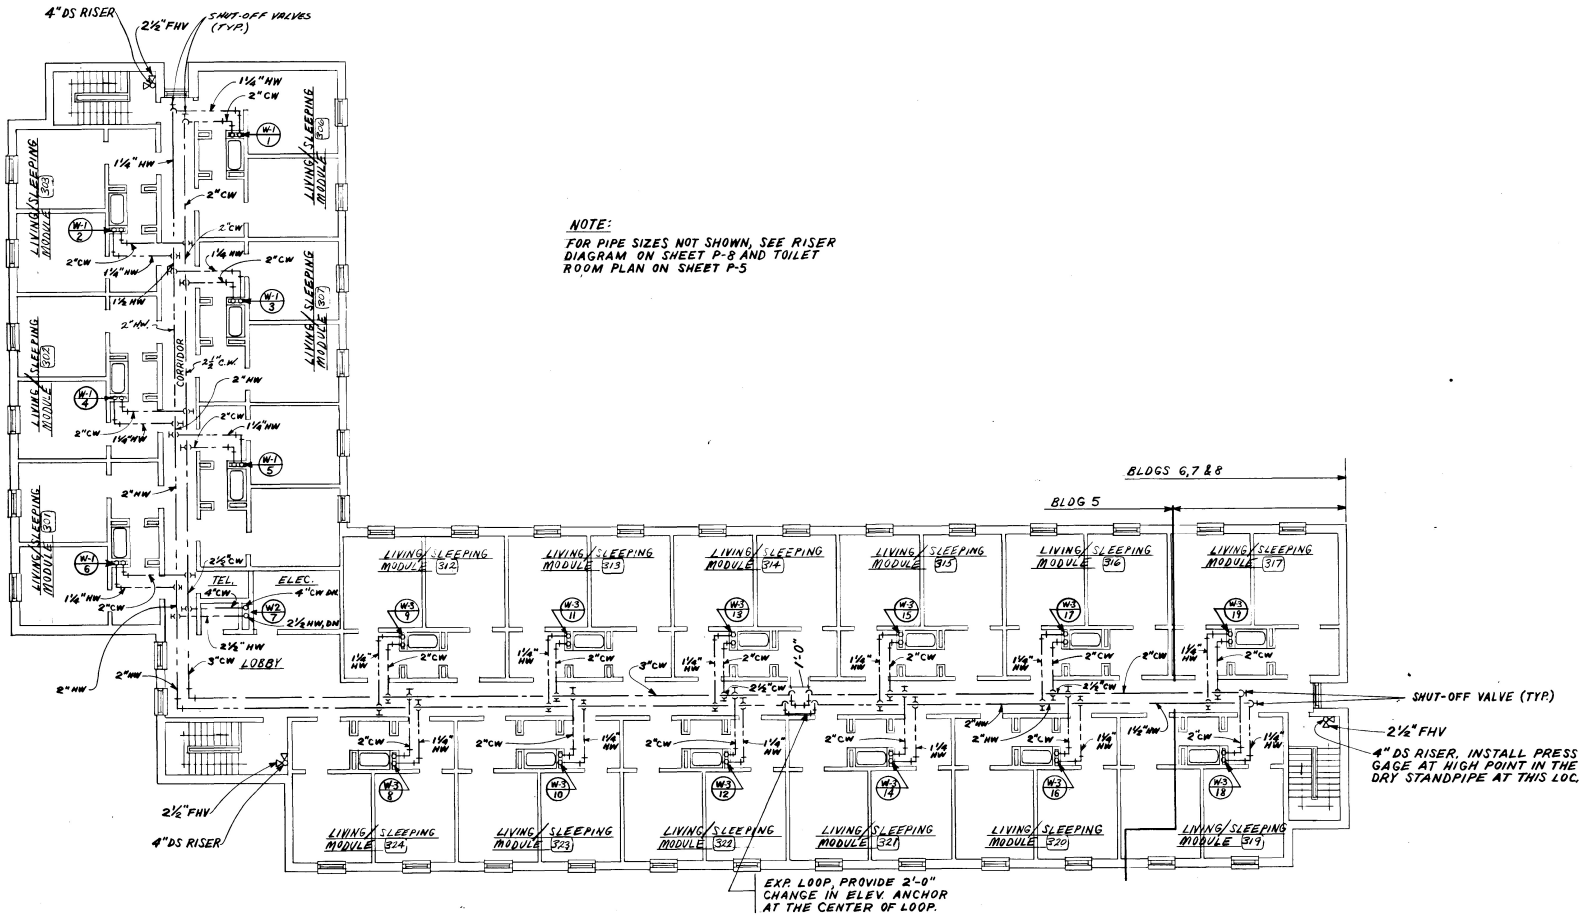

THIRD FLOOR PLANS
DOMESTIC WATER PIPING & DRY STANDPIPE
SCALE: ¼ = 1'-0"

SCALE: 1/8 IN. = 1 FT.

REV	DATE	DESCRIPTION	BY
	MAY 90	AS BUILT	

U.S. ARMY ENGINEER DISTRICT, BALTIMORE
CORPS OF ENGINEERS
BALTIMORE, MARYLAND

ABERDEEN PROVING GROUND MARYLAND

ENLISTED BARRACKS PHASE IV
BARRACKS BLDG.
THIRD FLOOR, DOMESTIC WATER PIPING & DRY STANDPIPING

DRAWING NUMBER F-721-90-12 PLATE 154

SCALE: AS SHOWN DATE: 5 FEB. 1987 SHEET P-7

41859