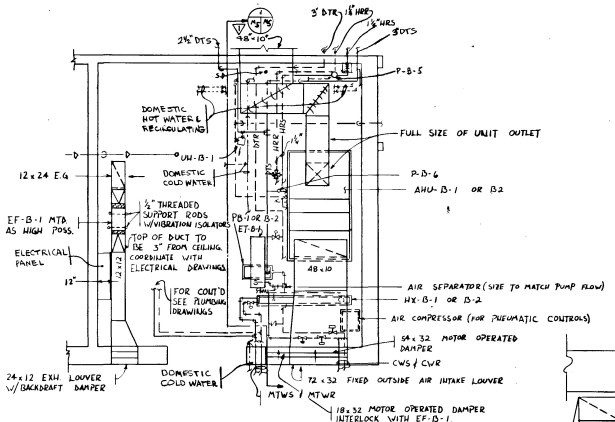

ENLARGE MECH. RM
SCALE: ¼" = 1'-0"

NOTE:

1. FOR UNDERGROUND UTILITIES AND BUILDING ENTRANCE DETAILS SEE DRAWINGS ON PLUMBING AND UNDERGROUND DISTRIBUTION SYSTEMS.
2. FOR ALL VALVES SEE FLOW DIAGRAM.
3. ALL MT / DT PIPING SHALL BE HUNG FROM ABOVE BY SPRING HANGERS WITH 1" DEFLECTION.

Plate 121 Enlarged Mech. Rm. Plan: Change the designation on ductwork at the top of the plan from "48 HD" to "48 x 10".

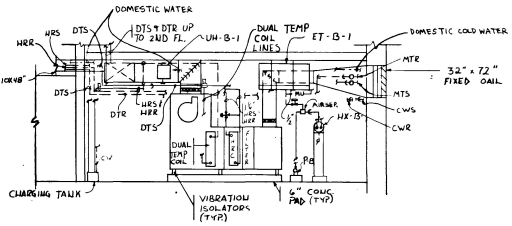

SECTION 1 (M5 / M5)
SCALE: ¼" = 1'-0"

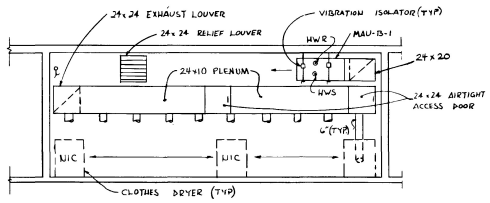

SECTION 3 (M2 / M5)
SCALE: ¼" = 1'-0"

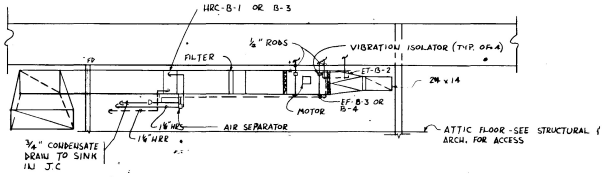

SECTION 1 (M4 / M5)
SCALE: ¼" = 1'-0"

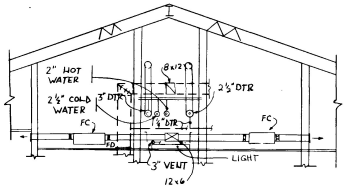

SECTION 2 (M4 / M5)
SCALE: ¼" = 1'-0"

SCALE: 1/4 IN. = 1 FT.

REV	DATE	DESCRIPTION	BY
2	MAY 90	REVISED AS BUILT	
1	JUNE 87	MECH RM. DUCTWORK	JRD

U.S. ARMY ENGINEER DISTRICT, BALTIMORE
CORPS OF ENGINEERS
BALTIMORE, MARYLAND

ABERDEEN PROVING GROUND MARYLAND

ENLISTED BARRACKS PHASE IV
BARRACKS BLDG.
ENLARGED MECH. RM.
PLAN AND SECTIONS

DRAWING NUMBER: F-721-90-12
PLATE: 121

SCALE: AS SHOWN | DATE: 5 FEB. 1987 | SHEET M-5

41826