NOTE:
FOR NORTH ARROW SEE SITE DRAWINGS

NOTES:
1. SEE RISER DIAGRAM ON SHEET P-4 AND TOILET RM. PLAN, SHEET P-1, FOR PIPE SIZES NOT SHOWN.

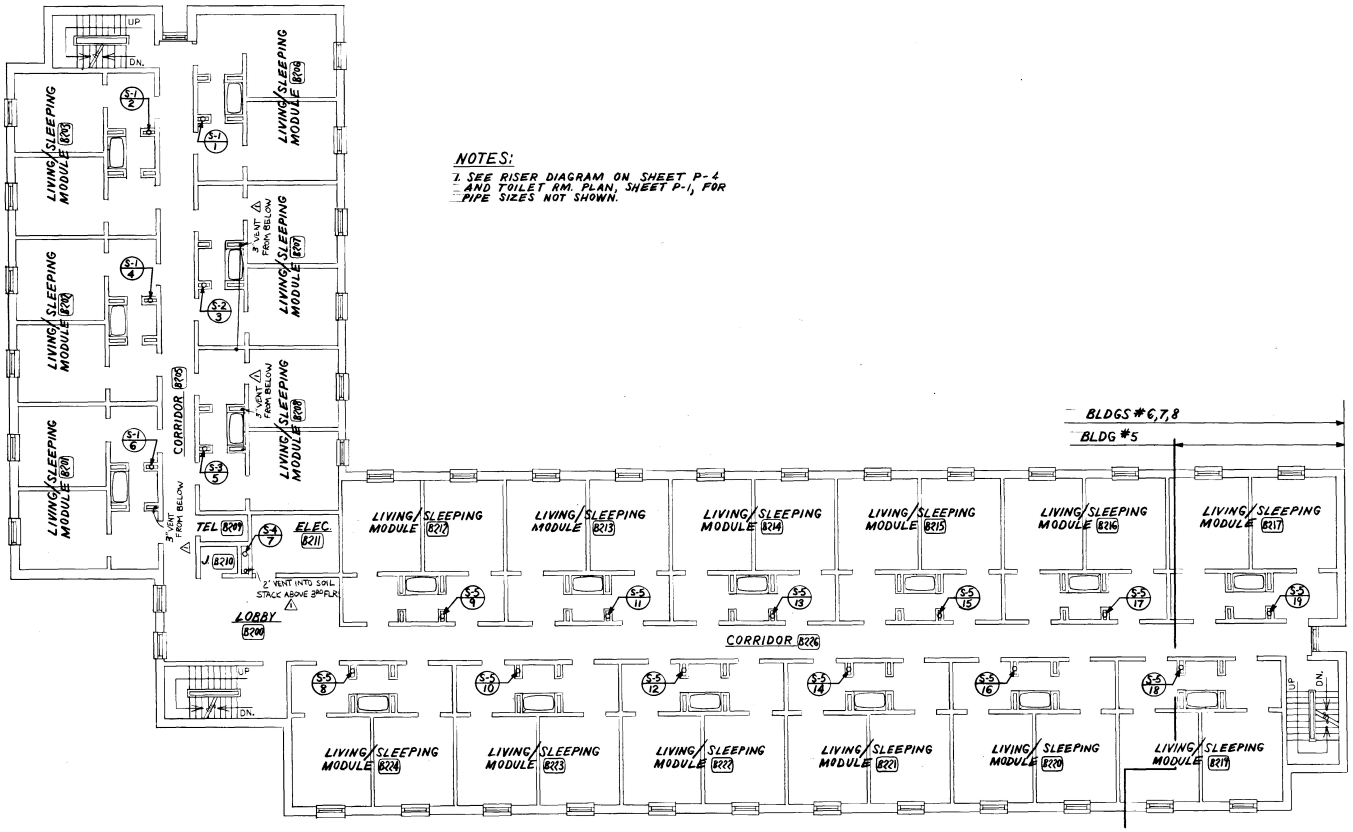

DRAIN WASTE & VENT PIPING
SECOND FLOOR PLAN
SCALE: 1/8 = 1'-0"

SCALE: 1/8 IN.=1 FT.
4 0 4 8 12 16 20

REV	DATE	DESCRIPTION	BY
1	MAY 90	REVISED AS BUILT	

U.S. ARMY ENGINEER DISTRICT, BALTIMORE
CORPS OF ENGINEERS
BALTIMORE, MARYLAND

ABERDEEN PROVING GROUND MARYLAND

ENLISTED BARRACKS PHASE IV
BARRACKS BLDG.
SECOND FLOOR, DRAIN, WASTE & VENT PIPING

DRAWING NUMBER	PLATE
F-721-90-12	149

SCALE: AS SHOWN | DATE: 5 FEB. 1987 | SHEET P-2

41654