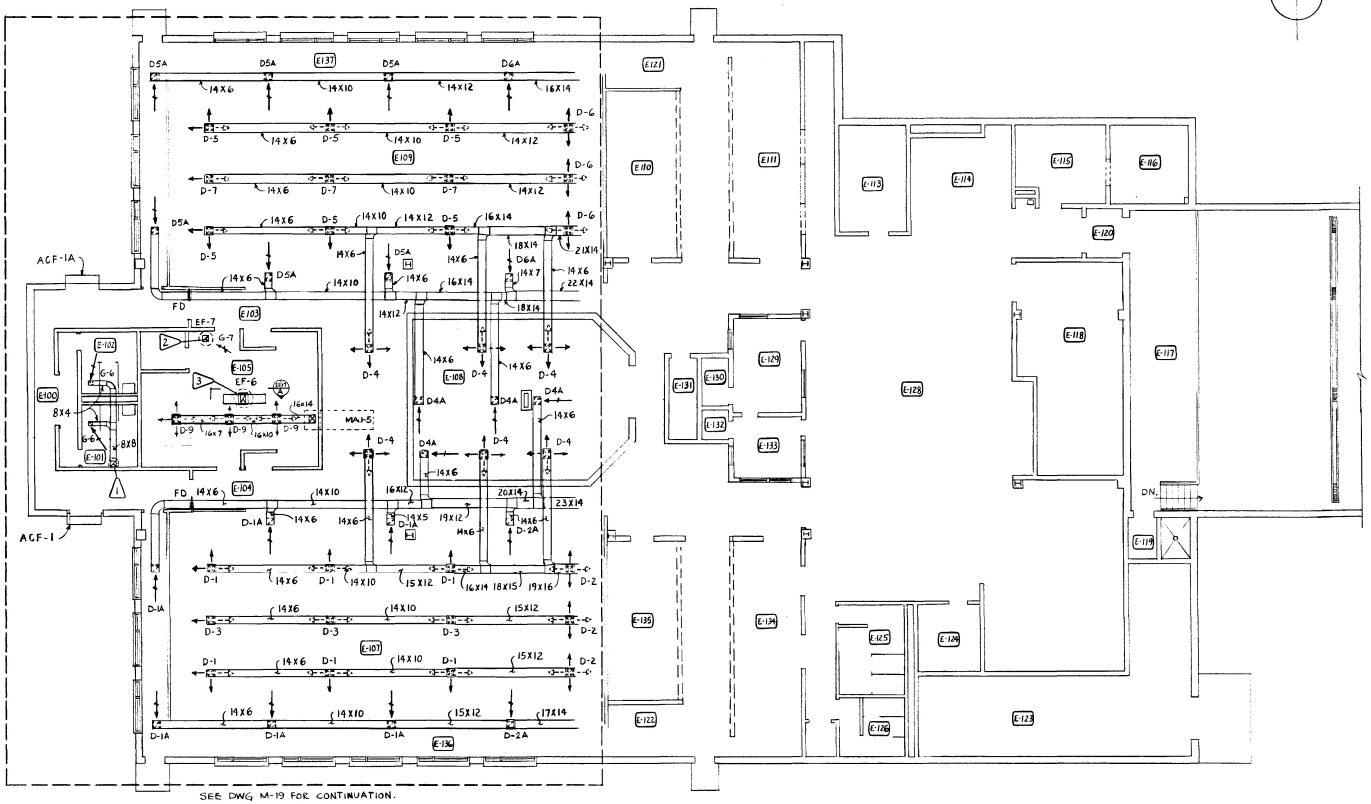


HVAC PLAN
SCALE 1/8" = 1'0"

SCALE: 1/8 IN.=1 FT.
4 0 4 8 12 16 20

| REV | DATE | DESCRIPTION | BY |
|---|---|---|---|
| | MAY 90 | AS BUILT | |

U.S. ARMY ENGINEER DISTRICT, BALTIMORE
CORPS OF ENGINEERS
BALTIMORE, MARYLAND

ABERDEEN PROVING GROUND MARYLAND

ENLISTED BARRACKS PHASE IV
DINING FACILITY
HVAC PLAN

DRAWING NUMBER F-721-90-12
PLATE 133

SCALE: AS SHOWN DATE: 5 FEB 1987 SHEET M-17

41838