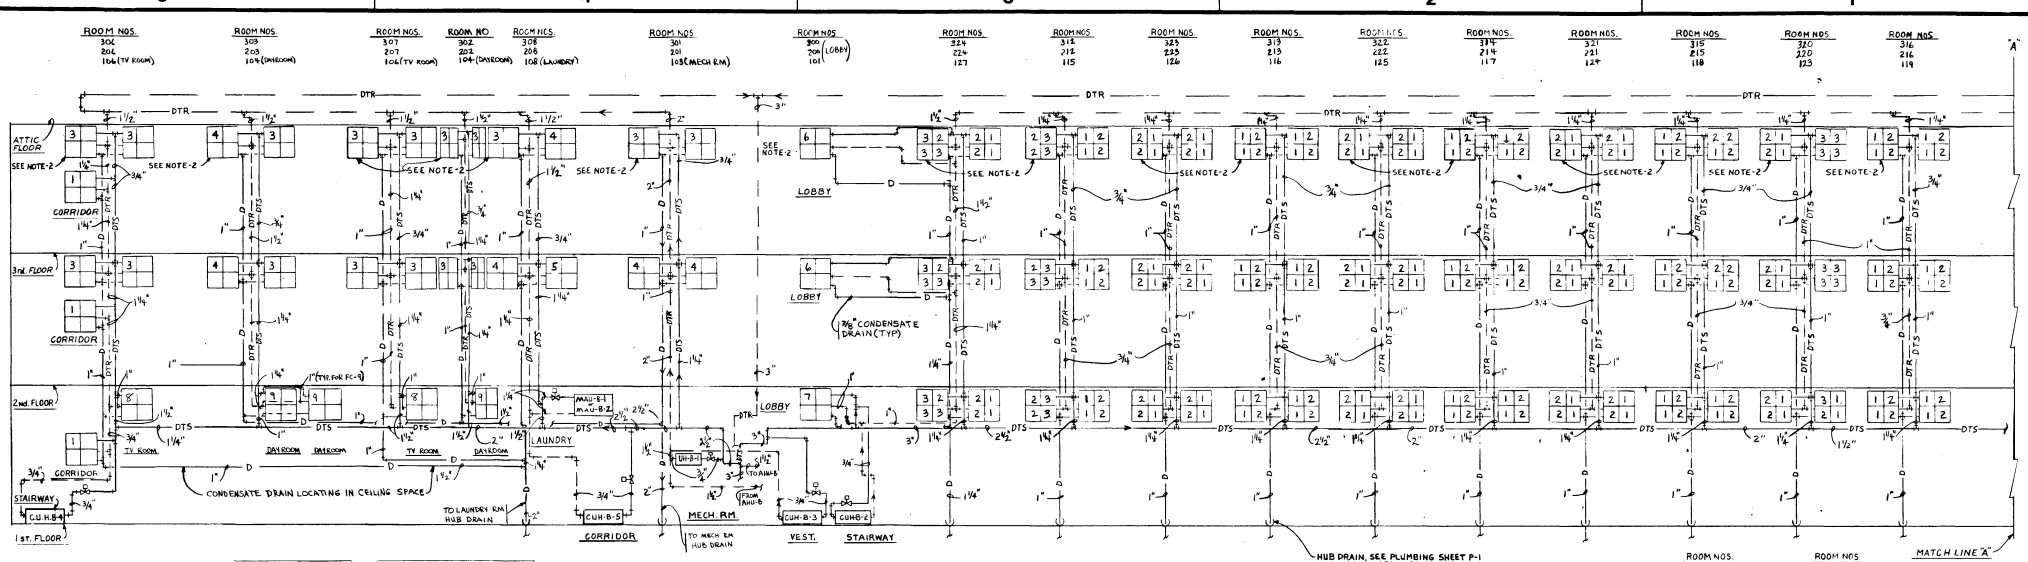

FAN COIL PIPING RISER DIAGRAM - BARRACKS

N. T. S.

NOTES:

1. IF ONLY ONE F.C. DESIGNATION IS INDICATED IN THE BLOCKS THEN ALL BARRACKS BUILDING FOR THAT ROOM USE THE SAME F.C. NUMBER.
2. THESE F.C. UNITS TO BE PROVIDED WITH THREE-WAY VALVE OTHERWISE TWO-WAY VALVES WILL BE PROVIDED.
3. THE FOLLOWING LEGEND APPLIES TO THIS RISER DIAGRAM:

FAN COIL NUMBER BARRACKS 5 — FAN COIL NUMBER BARRACKS #6
FAN COIL NUMBER BARRACKS #7 — FAN COIL NUMBER BARRACKS #8

4. ALL DTS AND DTR PIPING TO INDIVIDUAL F.C. UNITS SHALL BE 3/4" UNLESS OTHERWISE INDICATED.

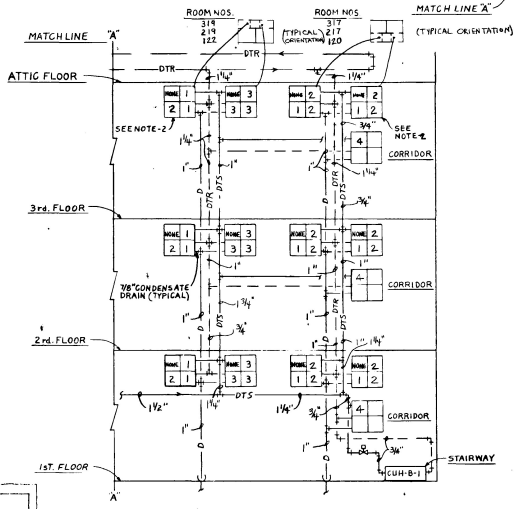

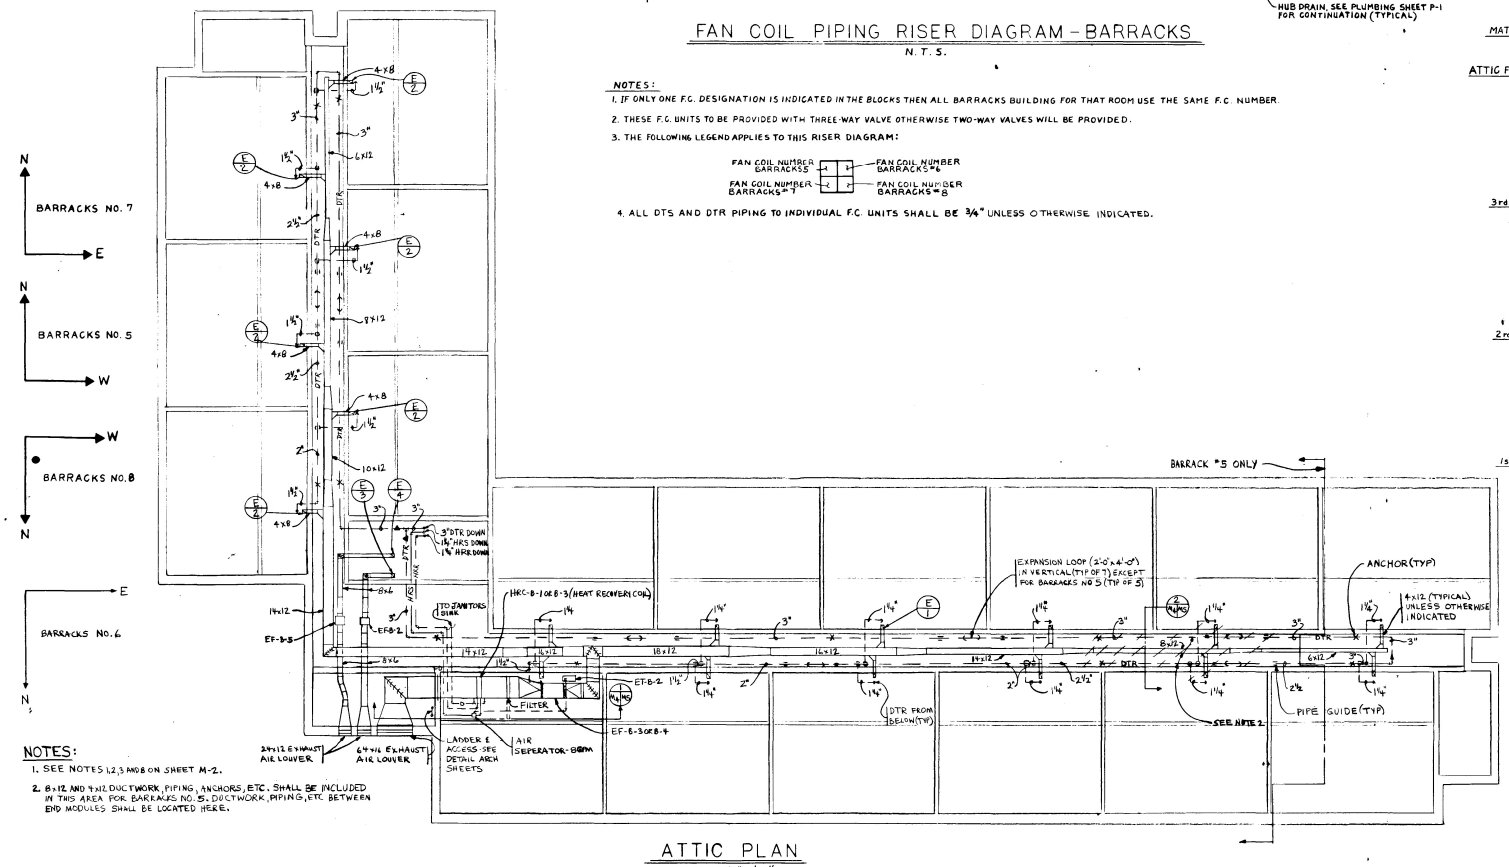

NOTES:

1. SEE NOTES 1,2,3 AND 8 ON SHEET M-2.
2. 8x12 AND 4x12 DUCTWORK, PIPING, ANCHORS, ETC. SHALL BE INCLUDED IN THIS AREA FOR BARRACKS NO. 5. DUCTWORK, PIPING, ETC BETWEEN END MODULES SHALL BE LOCATED HERE.

ATTIC PLAN

SCALE: 1/8"=1'-0"

REV	DATE	DESCRIPTION	BY
	MAY 90	AS BUILT	

US Army Corps of Engineers

U.S. ARMY ENGINEER DISTRICT, BALTIMORE
CORPS OF ENGINEERS
BALTIMORE, MARYLAND

ABERDEEN PROVING GROUND — MARYLAND

ENLISTED BARRACKS PHASE IV
BARRACKS BLDG.

ATTIC FLOOR PLAN
AND FAN COIL RISER

DRAWING NUMBER: F-721-90-12
PLATE: 120

SCALE: AS SHOWN | DATE: 5 FEB. 1987 | SHEET M-4

41825