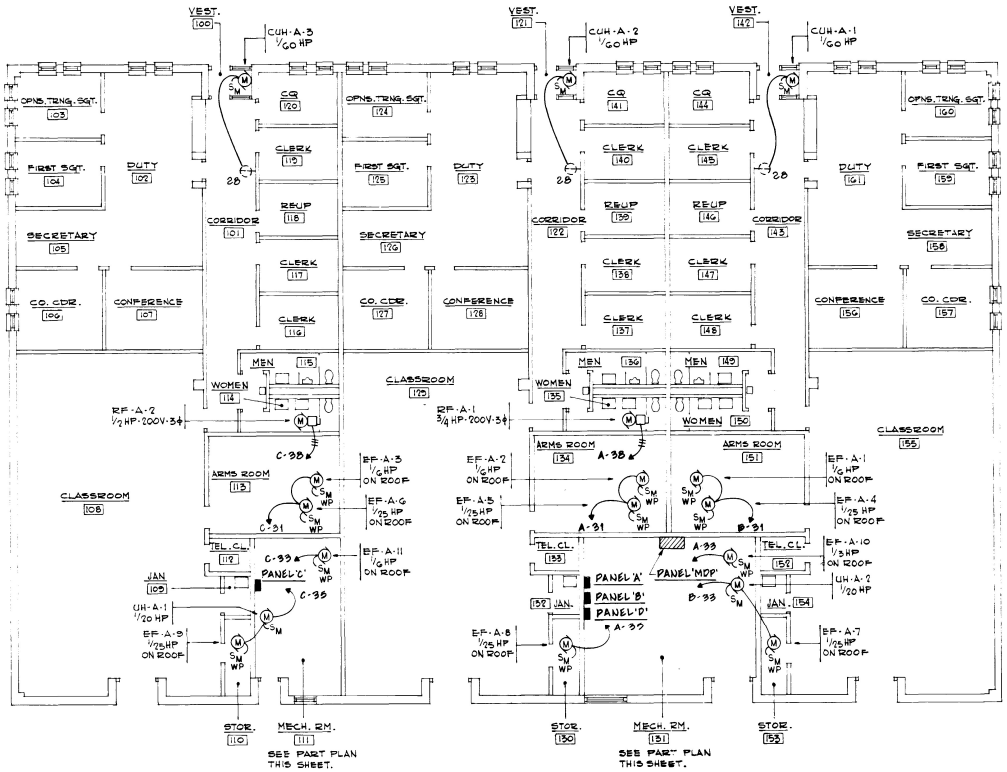

FLOOR PLAN - POWER

SCALE : 1/8"=1'-0"

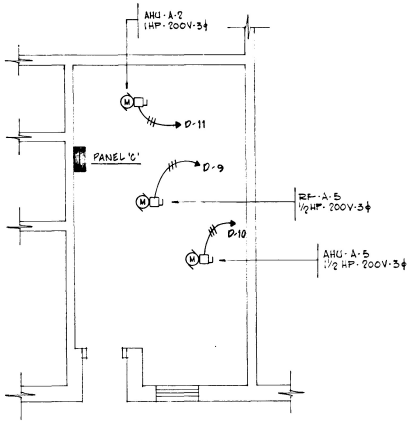

PART PLAN - MECHANICAL ROOM [111] - POWER

SCALE : 1/4"=1'-0"

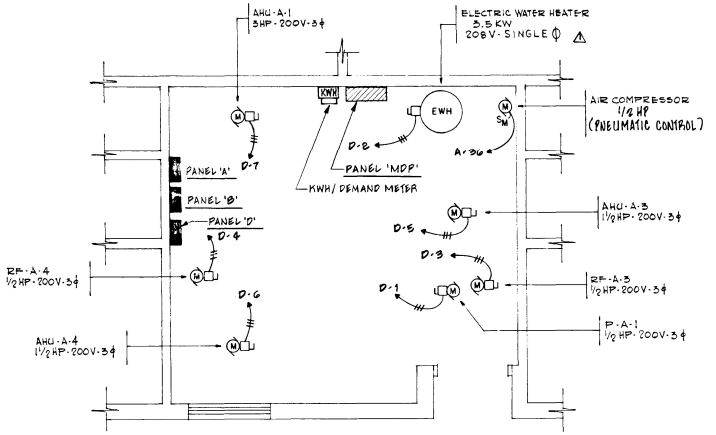

PART PLAN - MECHANICAL ROOM [131] - POWER

SCALE : 1/4"=1'-0"

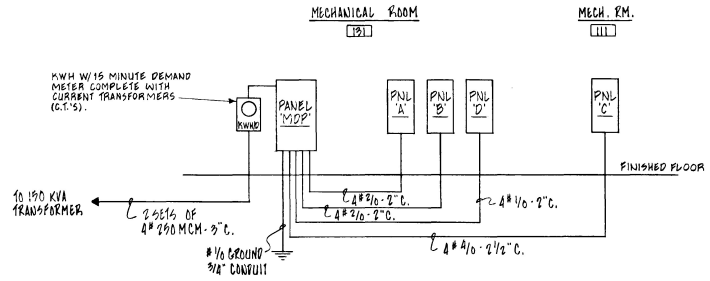

POWER RISER

NOT TO SCALE

N

GRAPHIC SCALES

SCALE: 1/8 IN.= 1 FT.

0 4 8 12 16 20

SCALE: 1/4 IN.= 1 FT.

4 3 2 1 0 4 8

REV	DATE	DESCRIPTION	BY
2	MAY 90	REVISED AS BUILT	
1	12 JAN 89	REVISED PER MOD P00007	

US Army Corps of Engineers

U.S. ARMY ENGINEER DISTRICT, BALTIMORE
CORPS OF ENGINEERS
BALTIMORE, MARYLAND

ABERDEEN PROVING GROUND MARYLAND

ENLISTED BARRACKS PHASE IV
ADMIN. & SUPPLY BLDG.

FLOOR PLAN
POWER AND POWER RISER

DRAWING NUMBER F-721-90-12

PLATE 188

SCALE: AS SHOWN DATE: 5 FEB. 1987 SHEET E-15

41892