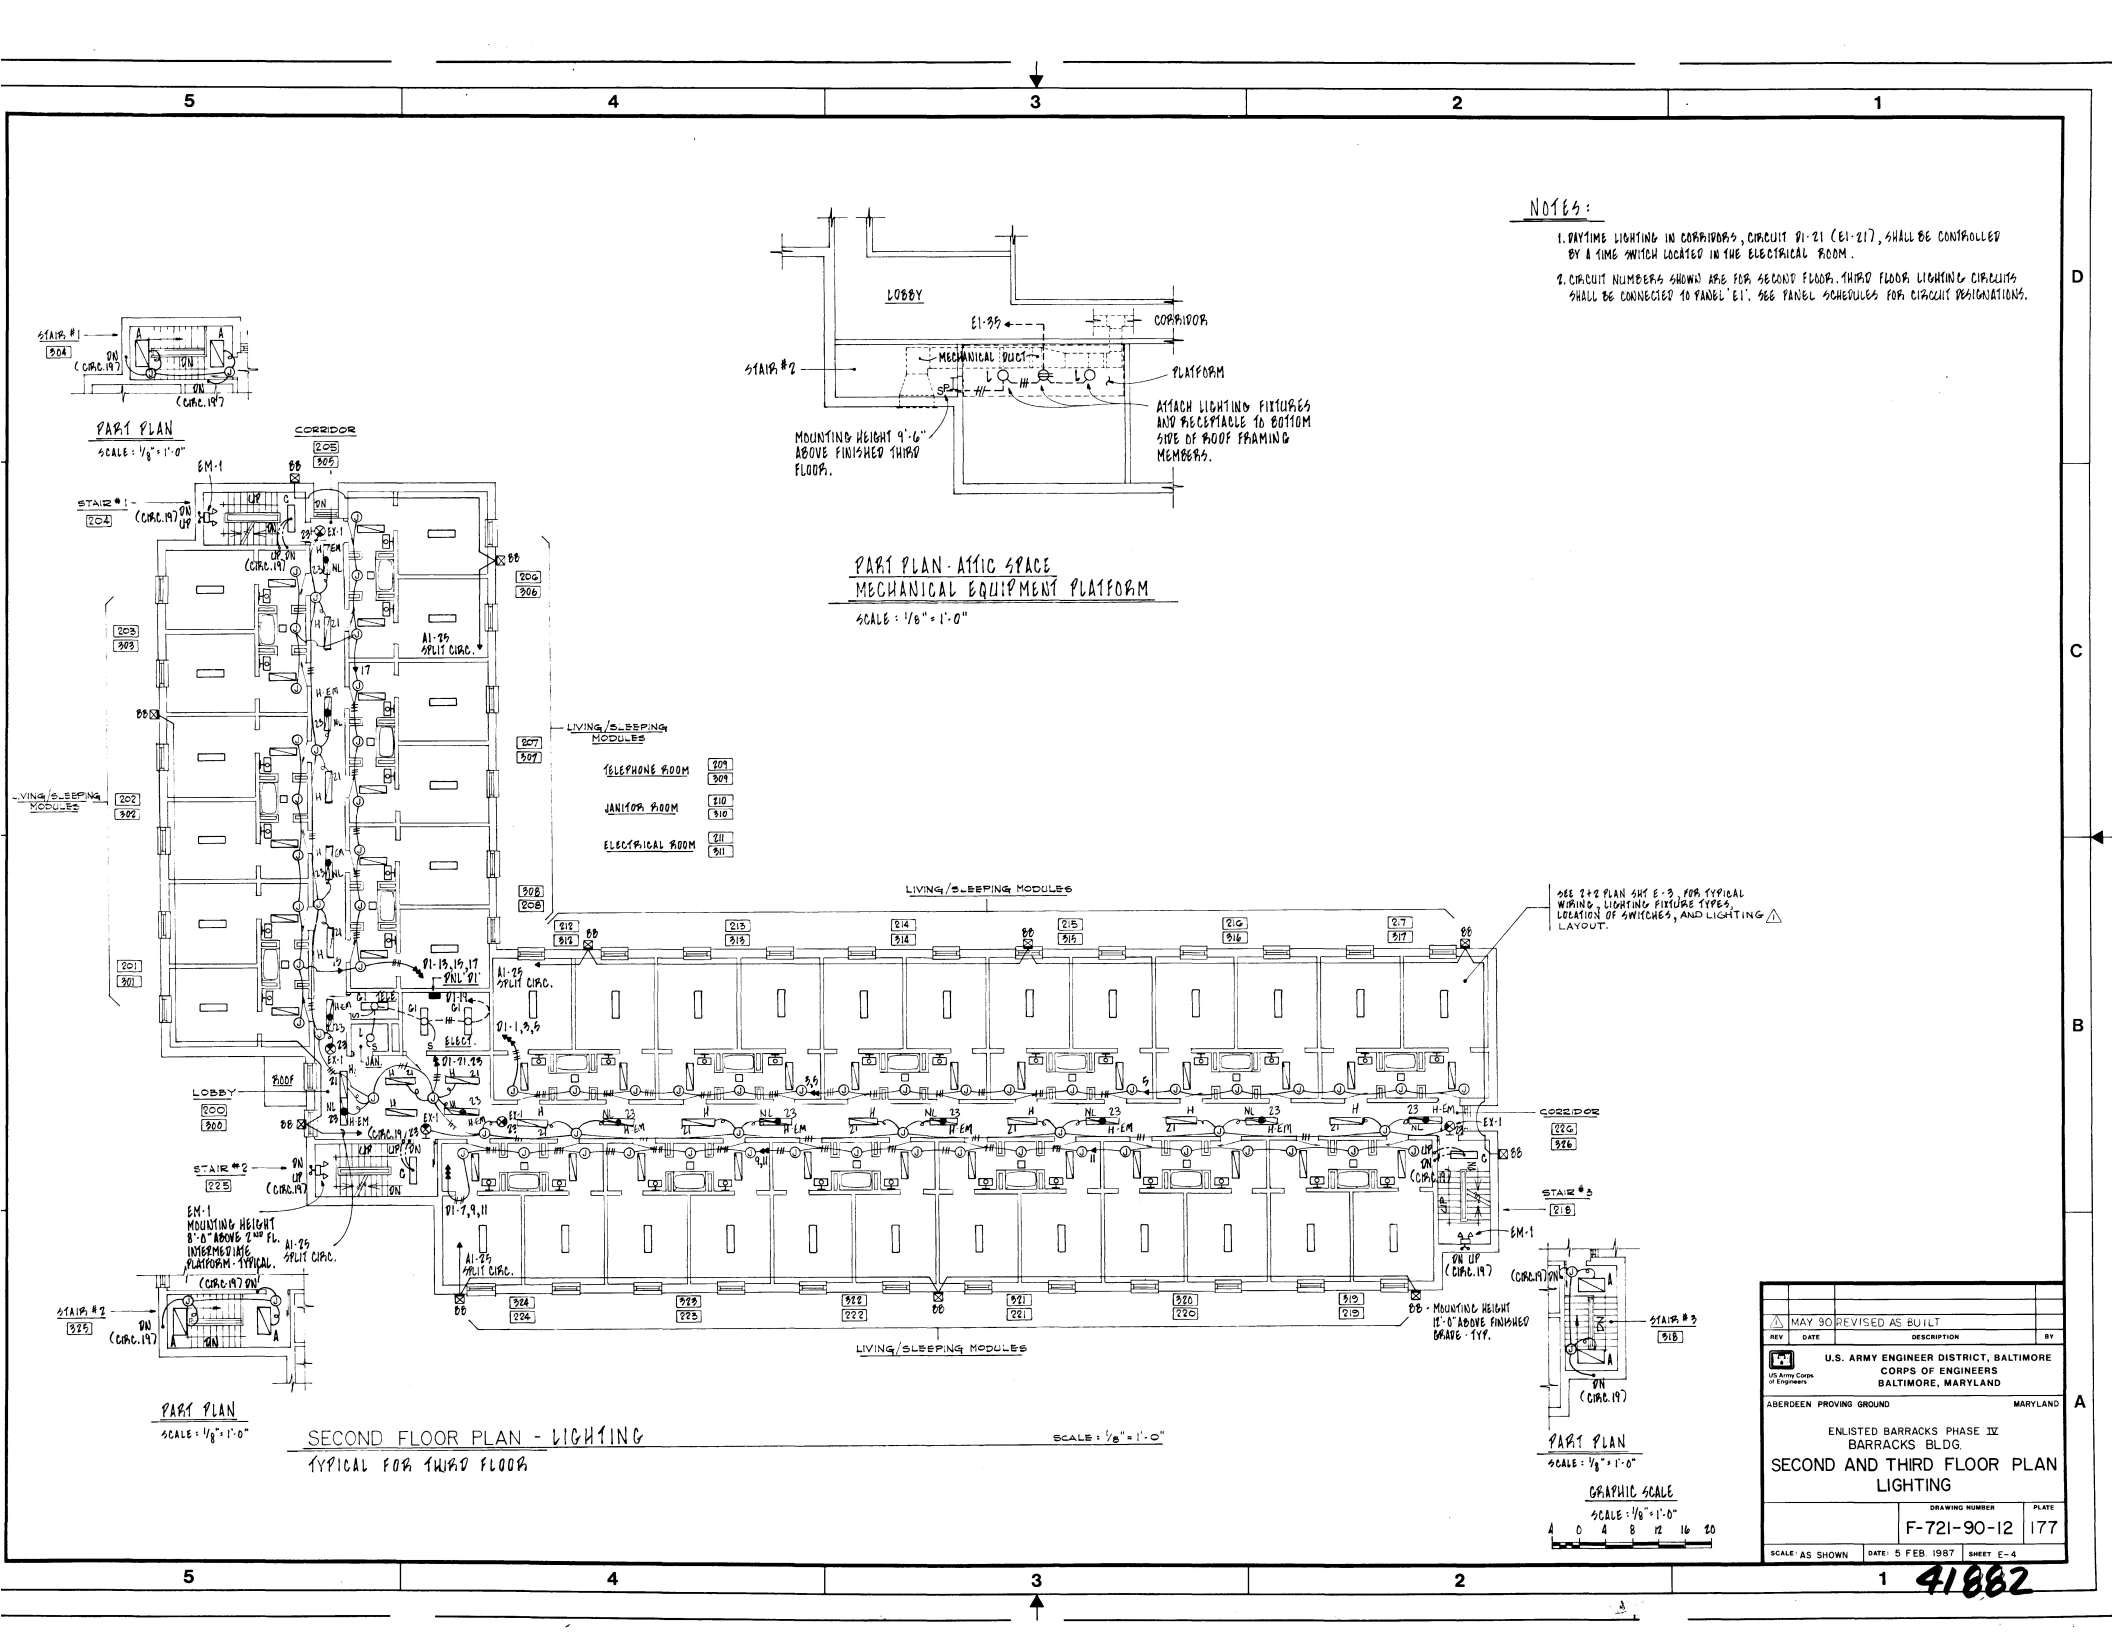
NOTES:
1. DAYTIME LIGHTING IN CORRIDORS, CIRCUIT 91-21 (E1-217), SHALL BE CONTROLLED BY A TIME SWITCH LOCATED IN THE ELECTRICAL ROOM.
2. CIRCUIT NUMBERS SHOWN ARE FOR SECOND FLOOR. THIRD FLOOR LIGHTING CIRCUITS SHALL BE CONNECTED TO PANEL 'E1'. SEE PANEL SCHEDULES FOR CIRCUIT DESIGNATIONS.
LOBBY
CORRIDOR
E1-35
MECHANICAL DUCT
STAIR #2
PLATFORM
ATTACH LIGHTING FIXTURES AND RECEPTACLE TO BOTTOM SIDE OF ROOF FRAMING MEMBERS.
MOUNTING HEIGHT 9'-6" ABOVE FINISHED THIRD FLOOR.
PART PLAN - ATTIC SPACE
MECHANICAL EQUIPMENT PLATFORM
SCALE: 1/8" = 1'-0"
STAIR #1
PART PLAN
SCALE: 1/8" = 1'-0"
CORRIDOR
LIVING/SLEEPING MODULES
TELEPHONE ROOM
JANITOR ROOM
ELECTRICAL ROOM
LOBBY
ROOF
ELECT.
JAN.
STAIR #2
EM-1 MOUNTING HEIGHT 8'-0" ABOVE 2ND FL. INTERMEDIATE PLATFORM - TYPICAL.
A1-25 SPLIT CIRC.
P1-13,15,17 PNL "P1"
P1-1,3,5
P1-7,9,11
P1-21,23
MOUNTING HEIGHT 12'-0" ABOVE FINISHED GRADE - TYP.
SEE 7+2 PLAN SHT E-3, FOR TYPICAL WIRING, LIGHTING FIXTURE TYPES, LOCATION OF SWITCHES, AND LIGHTING LAYOUT.
STAIR #3
PART PLAN
SCALE: 1/8" = 1'-0"
GRAPHIC SCALE
SCALE: 1/8" = 1'-0"
SECOND FLOOR PLAN - LIGHTING
TYPICAL FOR THIRD FLOOR
SCALE: 1/8" = 1'-0"
MAY 90 REVISED AS BUILT
U.S. ARMY ENGINEER DISTRICT, BALTIMORE
CORPS OF ENGINEERS
BALTIMORE, MARYLAND
ABERDEEN PROVING GROUND
MARYLAND
ENLISTED BARRACKS PHASE IV
BARRACKS BLDG.
SECOND AND THIRD FLOOR PLAN
LIGHTING
DRAWING NUMBER F-721-90-12
PLATE 177
SCALE: AS SHOWN
DATE: 5 FEB. 1987
SHEET E-4
41882