NOTES:

1. SEE SHEET ES-3 FOR 'GENERAL NOTES', 'DRAWING NOTES' AND 'SITE LEGEND.'

1. Provide and install three (3) 3-way splices in 15 the KVA U.G. power lines in lieu of in-line splices, at the existing electrical manhole located approximately 80 feet northwest of Phase I Barracks Building No. B-1. At the same location an additional forty-eight (48) L.F. of duct bank is also required for connection to existing U.G. electrical duct bank.

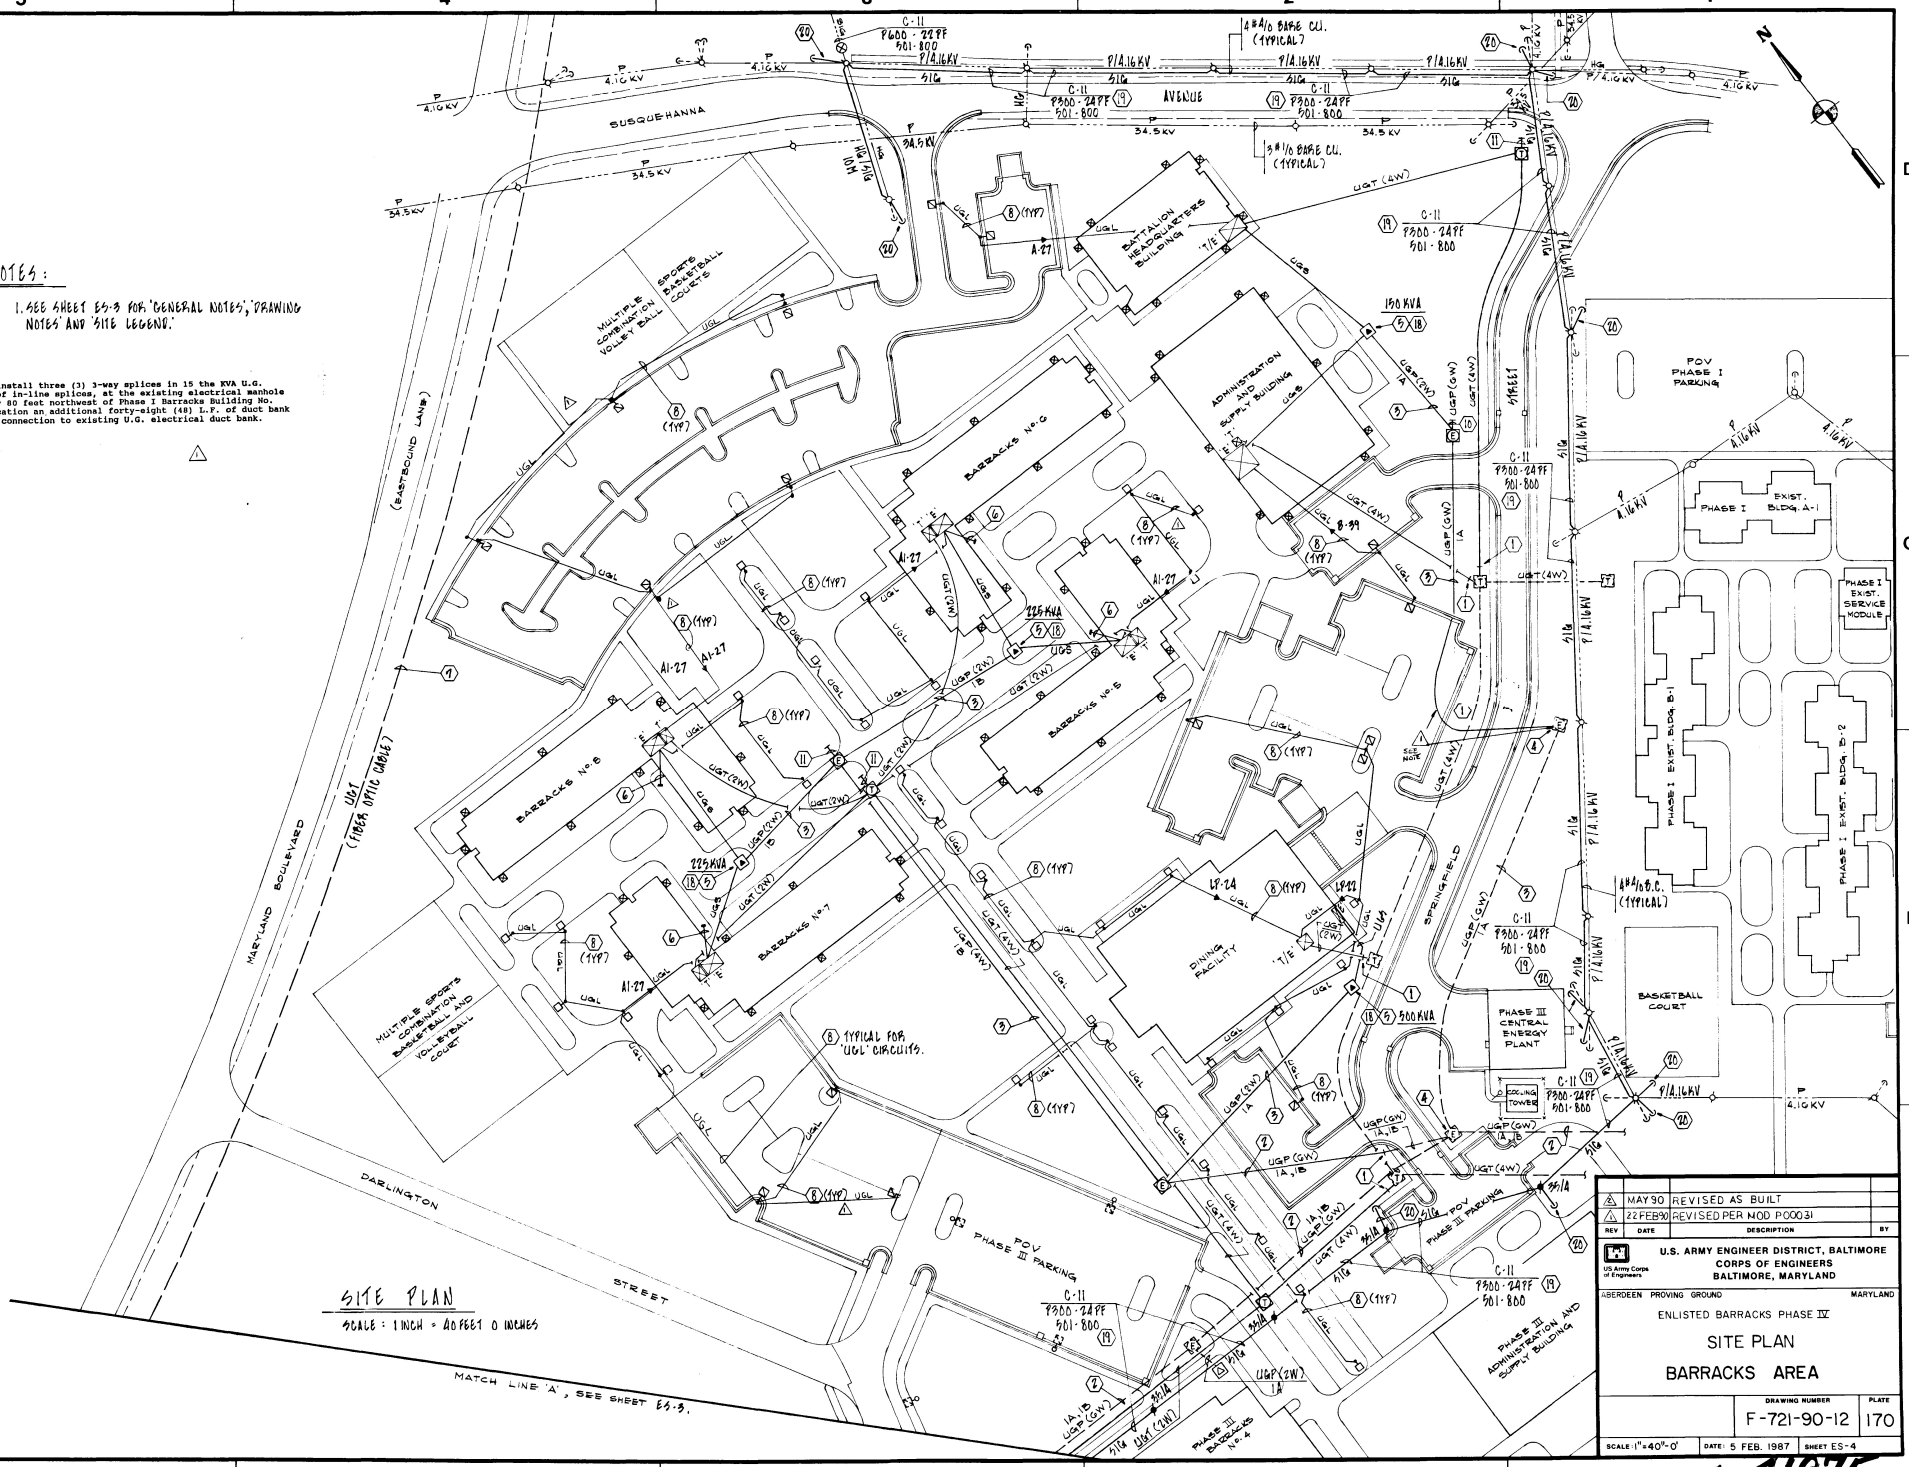

SITE PLAN

SCALE: 1 INCH = 40 FEET 0 INCHES

REV	DATE	DESCRIPTION	BY
2	MAY 90	REVISED AS BUILT	
1	22 FEB 90	REVISED PER MOD P00031	

US Army Corps of Engineers

U.S. ARMY ENGINEER DISTRICT, BALTIMORE
CORPS OF ENGINEERS
BALTIMORE, MARYLAND

ABERDEEN PROVING GROUND MARYLAND

ENLISTED BARRACKS PHASE IV

SITE PLAN

BARRACKS AREA

DRAWING NUMBER F-721-90-12 PLATE 170

SCALE 1"=40'-0" DATE: 5 FEB. 1987 SHEET ES-4

41875