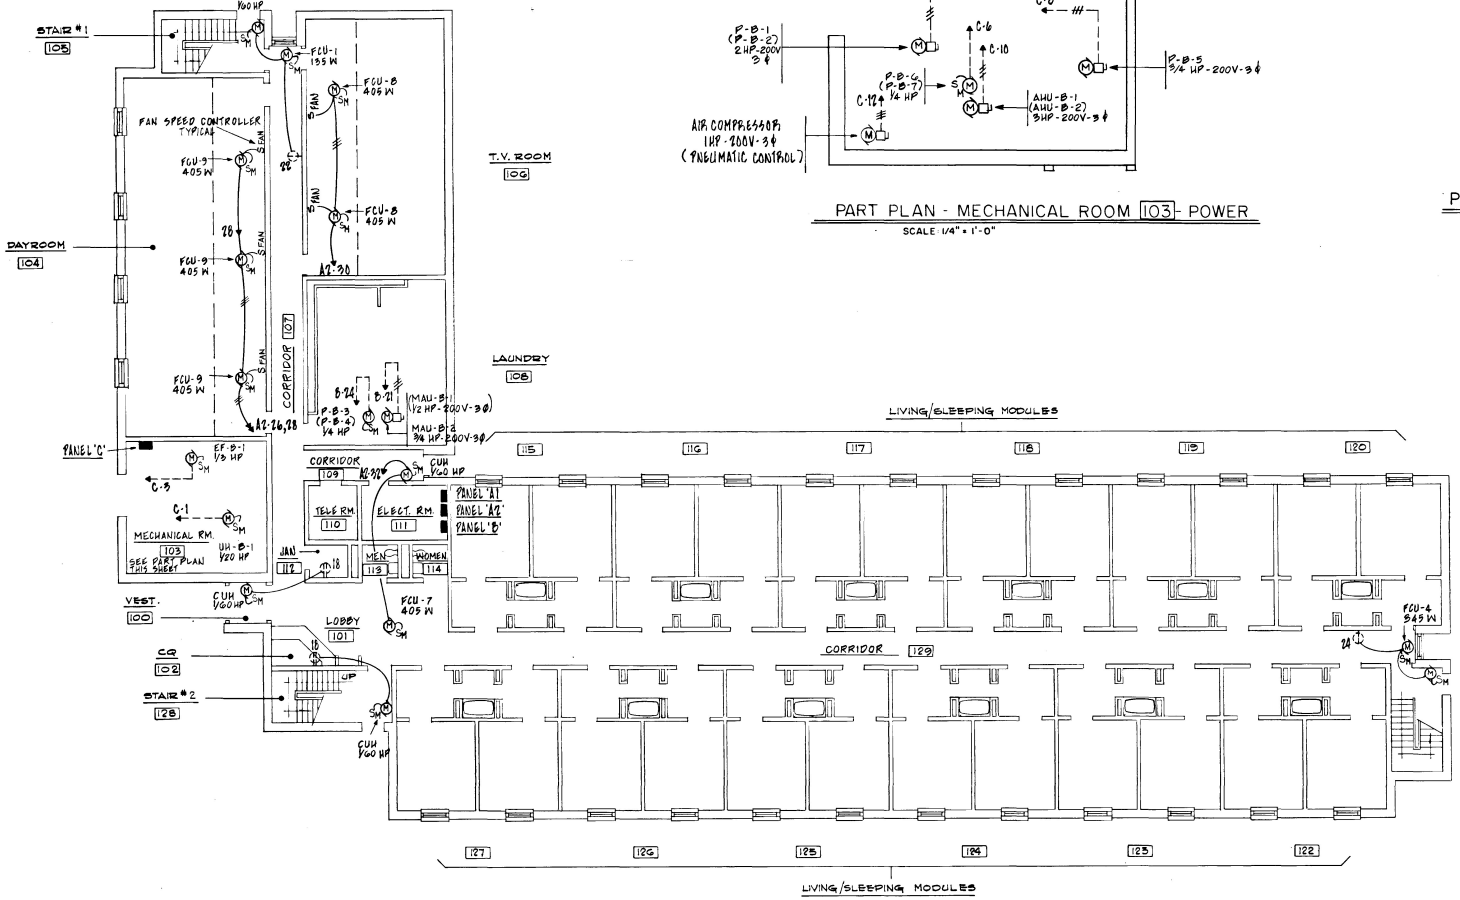


FIRST FLOOR PLAN - POWER

SCALE: 1/8" = 1'-0"

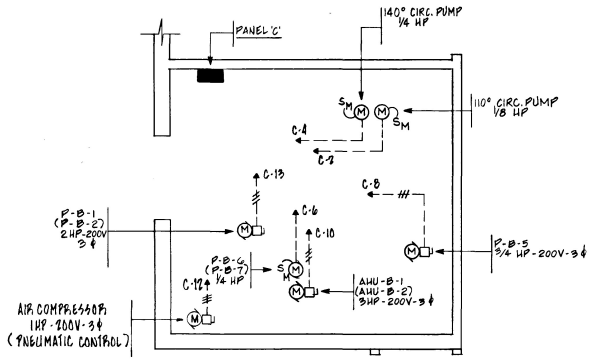


PART PLAN - MECHANICAL ROOM 103 - POWER

SCALE: 1/4" = 1'-0"

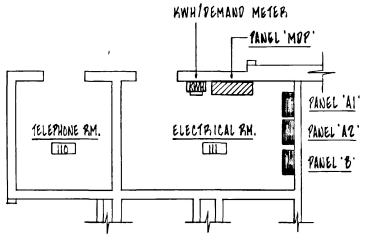


PART PLAN - POWER

SCALE: 1/4" = 1'-0"

GRAPHIC SCALES

SCALE: 1/8 IN. = 1 FT

SCALE: 1/4 IN. = 1 FT

| REV | DATE | DESCRIPTION | BY |
|---|---|---|---|
| | | | |
| | | | |
| | | | |
| | MAY 90 | AS BUILT | |

US Army Corps of Engineers

U.S. ARMY ENGINEER DISTRICT, BALTIMORE
CORPS OF ENGINEERS
BALTIMORE, MARYLAND

ABERDEEN PROVING GROUND MARYLAND

ENLISTED BARRACKS PHASE IV
BARRACKS BLDG.
FIRST FLOOR PLAN
POWER

DRAWING NUMBER: F-721-90-12
PLATE: 180

SCALE: AS SHOWN | DATE: 5 FEB. 1987 | SHEET E-7

41885