NOTES:

1. SEE SHEET E-10 FOR THE FOLLOWING SYSTEM NOTES:
   a. PUBLIC ADDRESS
   b. ROOF MONITOR
   c. FIRE ALARM

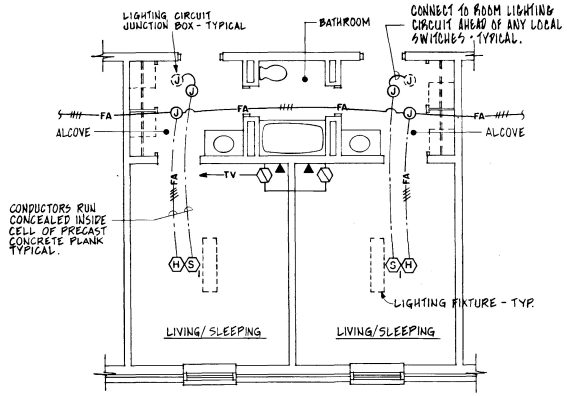

TYPICAL 2+2 ROOM SIGNAL PLAN - FIRST FLOOR

SCALE: 1/4" = 1'-0"

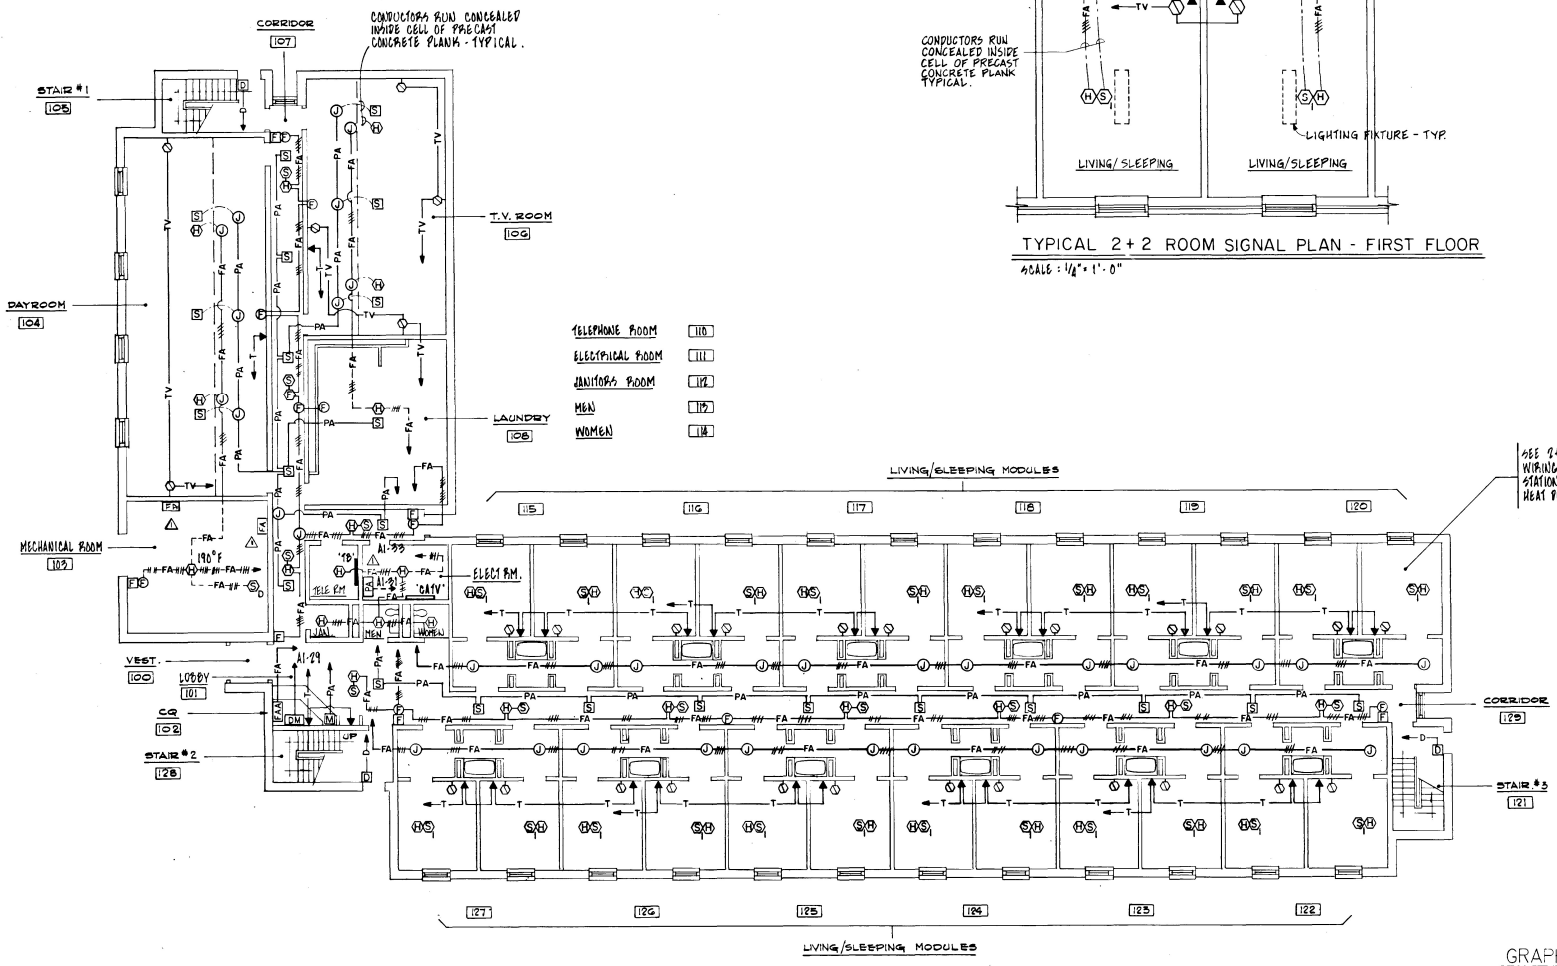

FIRST FLOOR PLAN - SIGNAL

SCALE: 1/8" = 1'-0"

GRAPHIC SCALES

SCALE: 1/8 IN = 1 FT.

SCALE: 1/4 IN. = 1 FT.

REV	DATE	DESCRIPTION	BY
2	MAY 90	REVISED AS BUILT	
1	5 JUNE 87	MECH. RM FS	J.D.D

US Army Corps of Engineers

U.S. ARMY ENGINEER DISTRICT, BALTIMORE
CORPS OF ENGINEERS
BALTIMORE, MARYLAND

ABERDEEN PROVING GROUND MARYLAND

ENLISTED BARRACKS PHASE IV
BARRACKS BLDG.
FIRST FLOOR PLAN
SIGNAL

DRAWING NUMBER F-721-90-12 PLATE 181

SCALE: AS SHOWN DATE: 5 FEB. 1987 SHEET E-8

41886