PUBLIC ADDRESS NOTES:

1. CONTROL UNIT AT C.Q. COUNTER SHALL INCLUDE ZONE SELECTION SWITCHES AS FOLLOWS:
   - ZONE 1 - ALL CALL
   - ZONE 2 - FIRST FLOOR
   - ZONE 3 - SECOND FLOOR
   - ZONE 4 - THIRD FLOOR

DOOR MONITOR NOTES:

1. ANNUNCIATOR PANEL AT C.Q. COUNTER SHALL CONTAIN THE FOLLOWING:
   - a. 'ON/OFF' SWITCH WITH POWER 'ON' LIGHT,
   - b. CONTROL TRANSFORMER,
   - C. ALARM BUZZER WITH SILENCE SWITCH,
   - d. THREE INDICATOR LIGHTS LABELED -
     - LONG WING STAIRWELL
     - CENTER STAIRWELL
     - SHORT WING STAIRWELL

FIRE ALARM NOTES:

1. COMBINATION TYPE SMOKE/HEAT DETECTORS MAYBE USED IN PLACE OF THE TWO SEPARATE DETECTORS SHOWN.
2. ANNUNCIATOR PANEL AT C.Q. COUNTER SHALL DISPLAY THE FOLLOWING:
   - ZONE 1 - FIRST FLOOR, LONG WING
   - ZONE 2 - FIRST FLOOR, SHORT WING
   - ZONE 3 - SECOND FLOOR, LONG WING
   - ZONE 4 - SECOND FLOOR, SHORT WING
   - ZONE 5 - THIRD FLOOR, LONG WING
   - ZONE 6 - THIRD FLOOR, SHORT WING
   - ZONE 7 - ATTIC
   - ZONE 8 - H.V.A.C. DUCT, MECHANICAL ROOM
   - ZONE 9 THRU 12 - SPARE
   - POWER 'ON'
   - TROUBLE
3. THE SINGLE STATION TYPE SMOKE DETECTORS SHOWN IN THE LIVING/SLEEPING ROOMS SHALL BE CONNECTED TO THE ROOM LIGHTING CIRCUIT AS INDICATED AND SHALL ACTIVATE ITS OWN INTERNAL HORN UPON ALARM, IN THAT ROOM ONLY. ALL OTHER DEVICES SHOWN SHALL BE CONNECTED TO THE BUILDING FIRE ALARM SYSTEM.
4. THE BUILDING CONTROL PANEL SHALL BE LOCATED ON THE FIRST FLOOR. △ AUXILARY PANELS MAYBE PROVIDED ON OTHER FLOORS (ELECTRICAL RMS). IF NECESSARY.

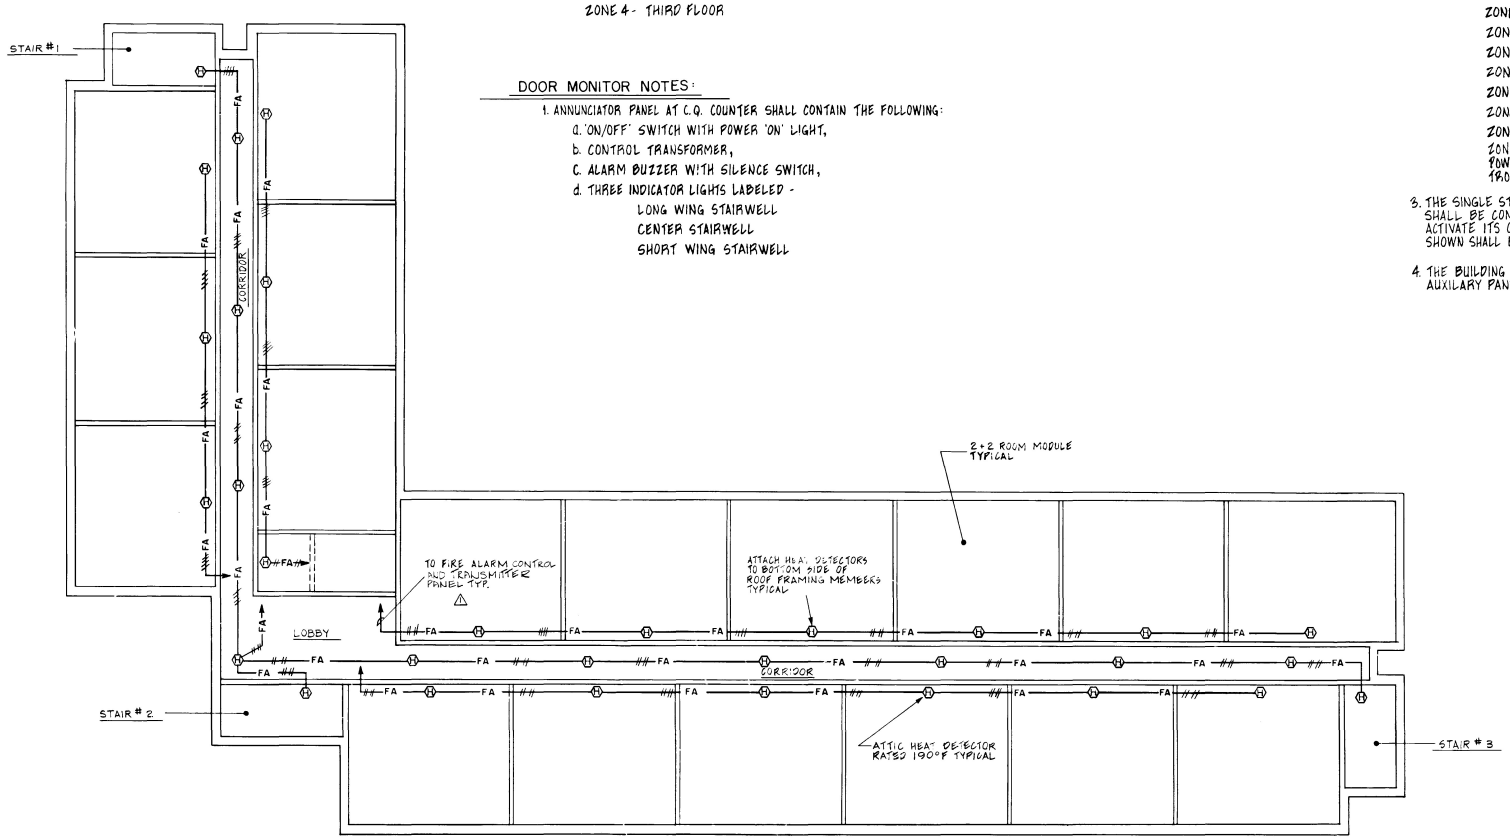

ATTIC PLAN - SIGNAL

SCALE: 1/8" = 1'-0"

GRAPHIC SCALES

SCALE: 1/8 IN. = 1 FT.

4 0 4 8 12 16 20

REV	DATE	DESCRIPTION	BY
△	MAY 90	REVISED AS BUILT	
△	5 JULY 87	ATTIC PLAN, FIRE ALARM NOTE 4	J.P.D.

U.S. ARMY ENGINEER DISTRICT, BALTIMORE
CORPS OF ENGINEERS
BALTIMORE, MARYLAND

ABERDEEN PROVING GROUND MARYLAND

ENLISTED BARRACKS PHASE IV
BARRACKS BLDG.

ATTIC PLAN AND NOTES-SIGNAL

DRAWING NUMBER F-721-90-12 | PLATE 183

SCALE: AS SHOWN | DATE: 5 FEB. 1987 | SHEET E-10

41686