NOTES:

1. CIRCUIT NUMBERS SHOWN ARE FOR SECOND FLOOR. THIRD FLOOR CIRCUITS SHALL BE CONNECTED TO PANELS 'E1' AND 'E-2'. SEE PANEL SCHEDULES FOR CIRCUIT DESIGNATIONS.

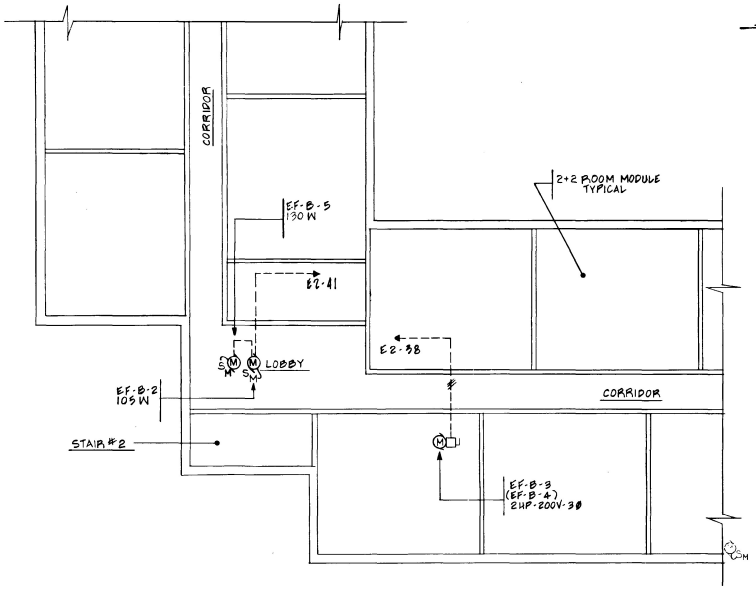

PART PLAN - ATTIC - POWER

SCALE: 1/8" = 1'-0"

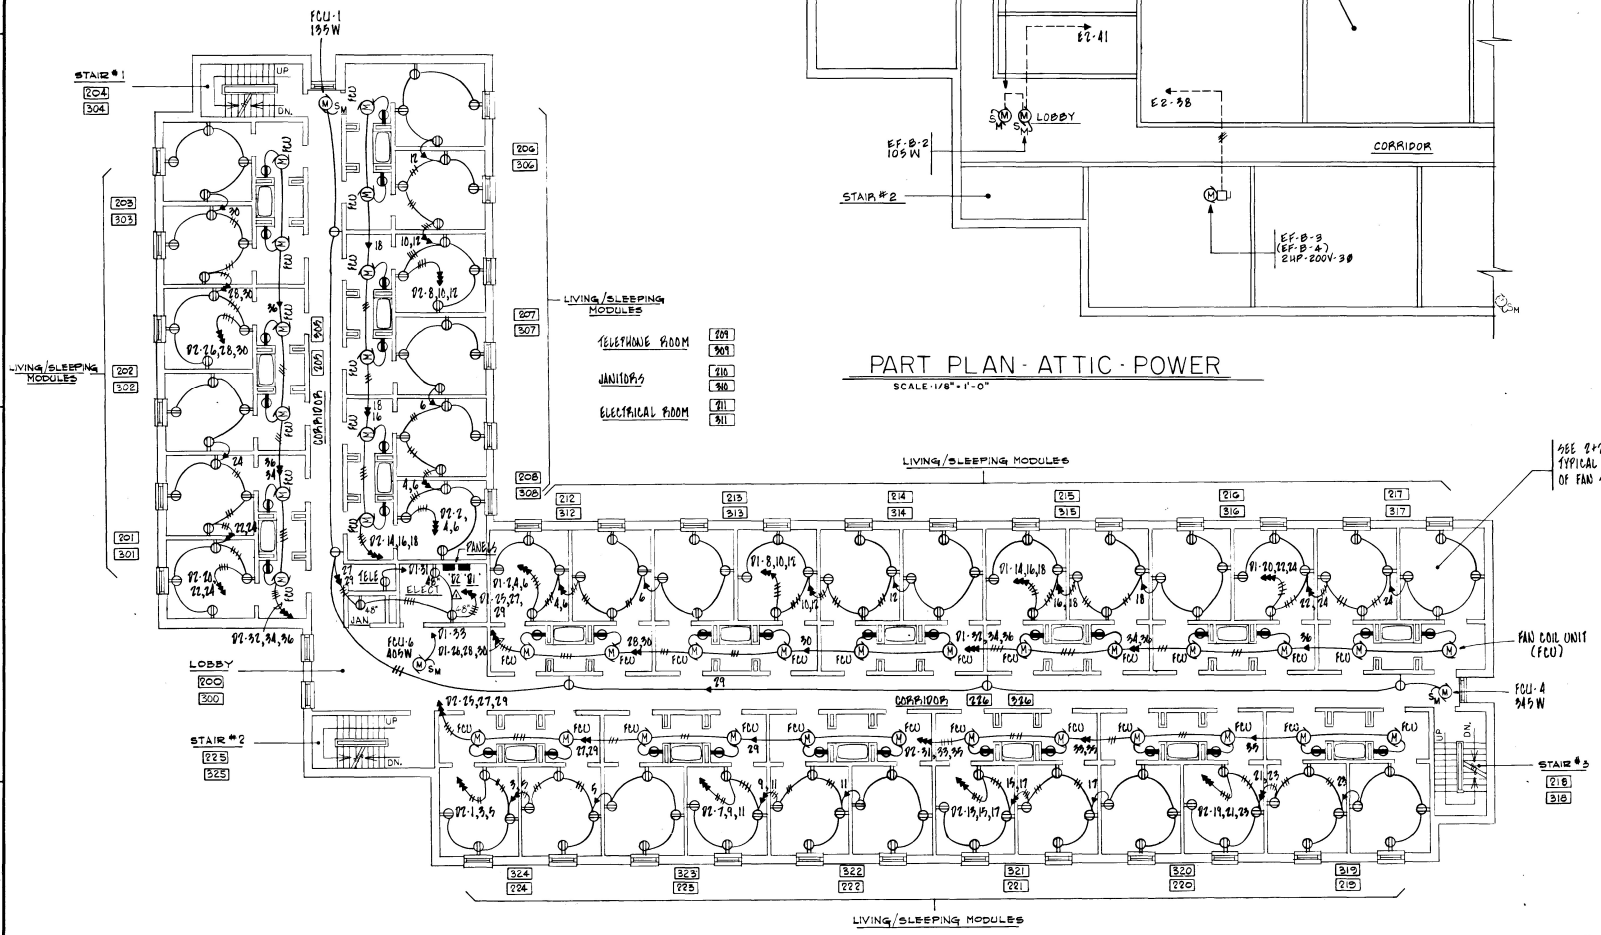

SEE 2+2 PLAN SHEET E-5 FOR TYPICAL WIRING AND LOCATION OF FAN SPEED CONTROLLER.

SECOND FLOOR PLAN - RECEPTACLES AND POWER

SCALE: 1/8" = 1'-0"

TYPICAL FOR THIRD FLOOR

GRAPHIC SCALES

SCALE: 1/8 IN. = 1 FT.

4 0 4 8 12 16 20

REV	DATE	DESCRIPTION	BY
1	MAY 90	REVISED AS BUILT	

US Army Corps of Engineers

U.S. ARMY ENGINEER DISTRICT, BALTIMORE
CORPS OF ENGINEERS
BALTIMORE, MARYLAND

ABERDEEN PROVING GROUND MARYLAND

ENLISTED BARRACKS PHASE IV
BARRACKS BLDG.

SECOND AND THIRD FLOOR PLAN
RECEP. AND POWER/PART. PLAN
ATTIC POWER

DRAWING NUMBER F-721-90-12 PLATE 179

SCALE: AS SHOWN DATE: 5 FEB. 1987 SHEET E-6

41884