NOTES

1. BUILDING "A" PLAN IS OPPOSITE HAND & CORRESPONDS TO BUILDING NUMBER 5 - SEE SITE PLAN SHEET C3.
2. BUILDING "B" PLAN IS OPPOSITE HAND. BUILDINGS "B" "C" & "D" CORRESPOND TO BUILDING NUMBERS 6, 7 & 8 - SEE SITE PLAN SHEET C3.
3. PROVIDE CEILING ACCESS PANELS. SEE MECHANICAL DRAWINGS FOR NUMBER AND LOCATION. SIZE TO BE DETERMINED TO SUIT USE AND LOCATION.

LEGEND

- 2' x 4' ACOUSTICAL TILE
- 2' x 4' RECESSED LIGHT FIXTURE
- 1' x 4' " " "
- SUPPLY AIR
- RETURN AIR
- 12" X 12" RECESSED LIGHT FIXTURE
- 2' x 2' ACOUSTICAL TILE

NOTE
VERIFY ALL MECH. & ELEC. WORK PENETRATING CEILINGS, SEE MECH. & ELEC. DWGS.

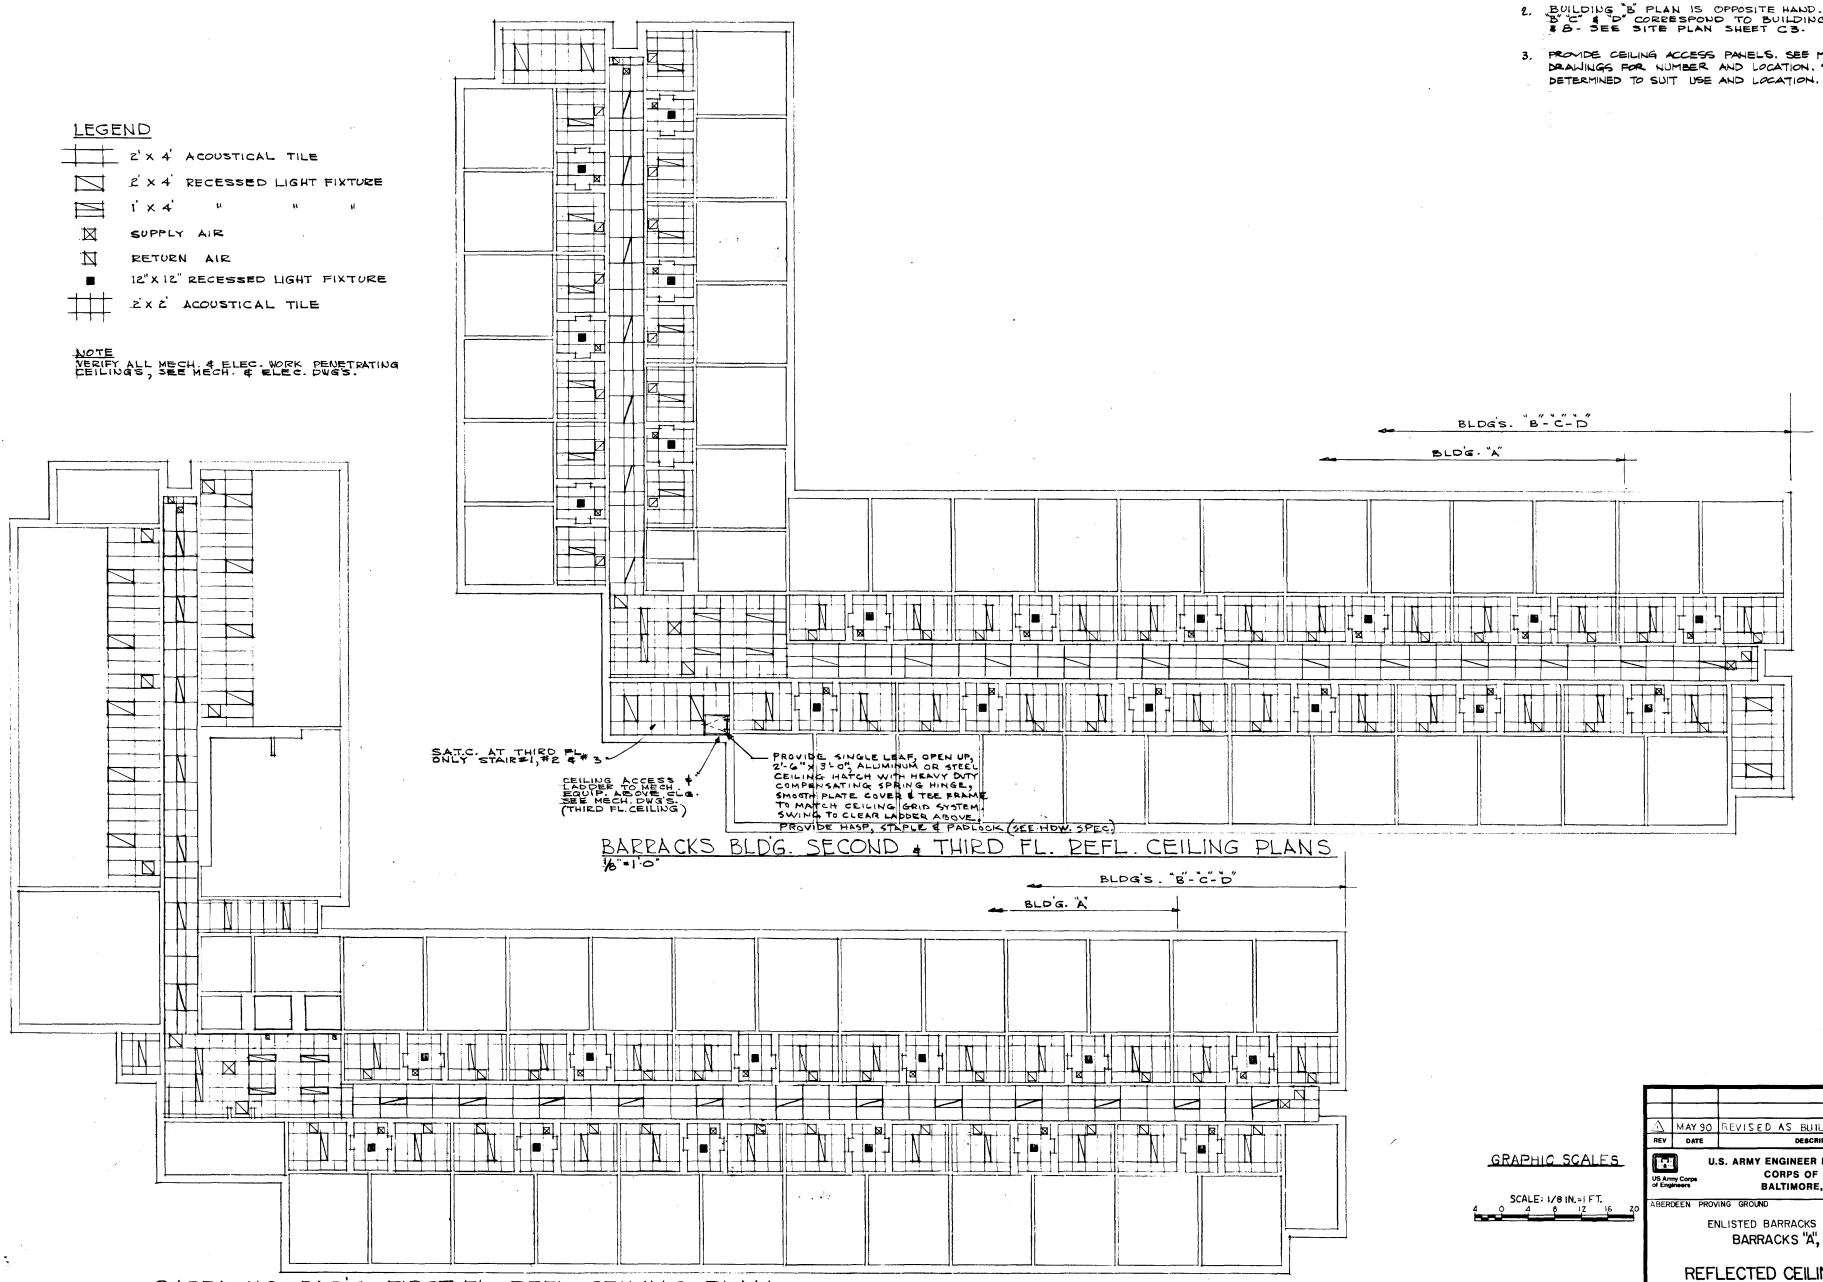

BARRACKS BLDG. SECOND & THIRD FL. REFL. CEILING PLANS
1/8" = 1'-0"

BARRACKS BLDG. FIRST FL. REFL. CEILING PLAN
1/8" = 1'-0"

GRAPHIC SCALES
SCALE: 1/8 IN. = 1 FT.
4 0 4 8 12 16 20

REV	DATE	DESCRIPTION	BY
1	MAY 90	REVISED AS BUILT	

US Army Corps of Engineers
U.S. ARMY ENGINEER DISTRICT, BALTIMORE
CORPS OF ENGINEERS
BALTIMORE, MARYLAND

ABERDEEN PROVING GROUND MARYLAND

ENLISTED BARRACKS PHASE IV
BARRACKS "A", "B", "C" & "D"

REFLECTED CEILING PLAN

DRAWING NUMBER F-721-90-12
PLATE 55
SCALE: AS SHOWN
DATE: 5 FEB 1987
SHEET A-9

41760