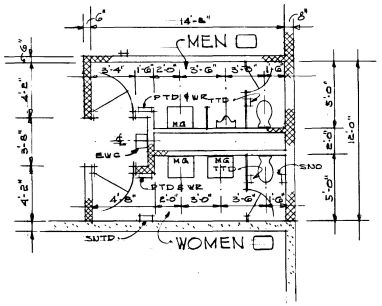

(18/31) ADMIN. & SUPPLY BLD'G. 1/4"=1'-0"
MEN — F115, F136 & F149
WOMEN — F114, F135 & F150

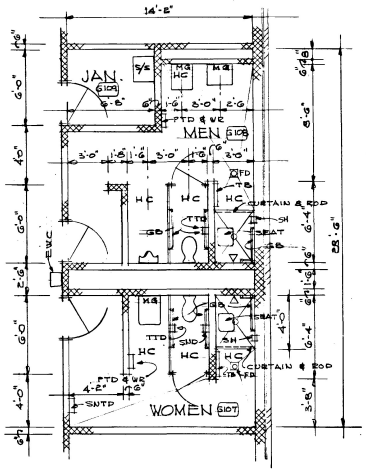

(22/31) BATTALION HQ. BLD'G. 1/4"=1'-0"
HANDICAPPED FACILITIES

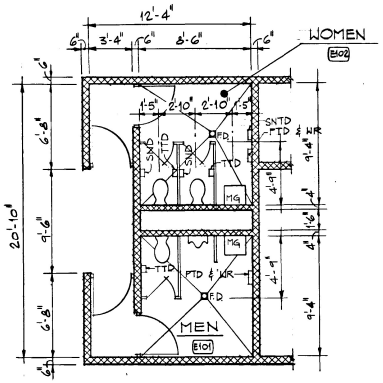

(10/31) DINING FAC. BLD'G. 1/4"=1'-0"

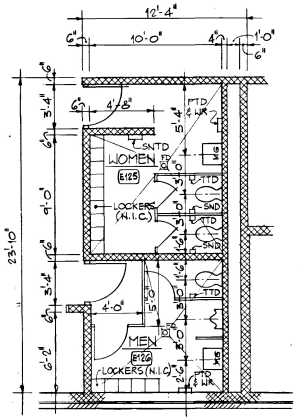

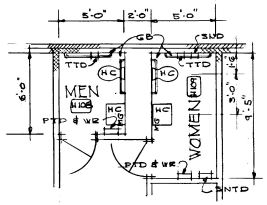

(26/31) RED CROSS BLD'G. 1/4"=1'-0"
HANDICAPPED FACILITIES

NOTE
DEPRESS ALL CONCRETE FLOOR SLABS 1½" FOR CERAMIC TILE IN MEN & WOMEN TOILET ROOMS, ALL BUILDINGS, EXCEPT RED CROSS BLDG., CLOTHING STORE BLDG. & BARRACKS BLDG'S. A, B, C, D.

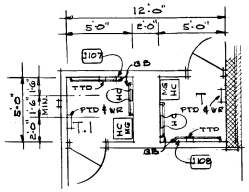

(28/31) CLOTHING STORE BLD'G. 1/4"=1'-0"
HANDICAPPED FACILITIES

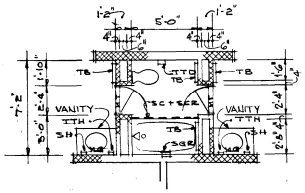

(31/31) BARRACKS BLD'G. 1/4"=1'-0"
1,2,3,4 & 5 — THIRD FLOOR ALL BLD'G'S. A, B, C, & D — SEE FLOOR PLANS FOR ROOM NUMBERS

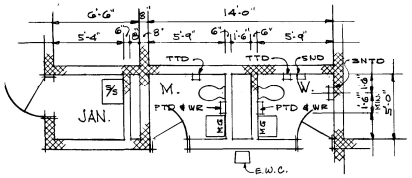

(31/31) BARRACKS BLD'G. 1/4"=1'-0"
(1/5) FIRST FLOOR ALL BLD'G'S.

ROOM #:

JAN.	A112	B112	C112	& D112
MEN	A113	B113	C113	& D113
WOMEN	A114	B114	C114	& D114

JAN. ONLY SECOND & THIRD FLOORS ALL BLDG'S.

JAN.	A210	B210	C210	& D210
	A310	B310	C310	& D310

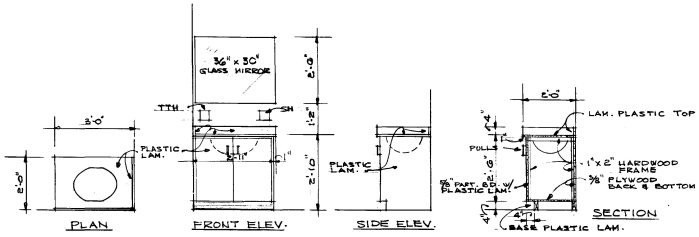

VANITY DETAILS 1/2"=1'-0"

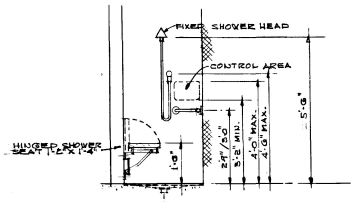

H.C. SHOWER DETAIL 1/2"=1'-0"

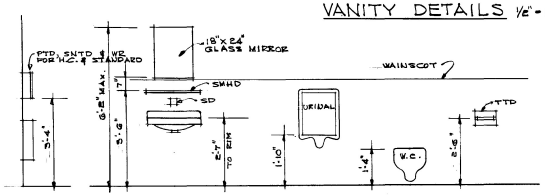

STANDARD FIXTURES

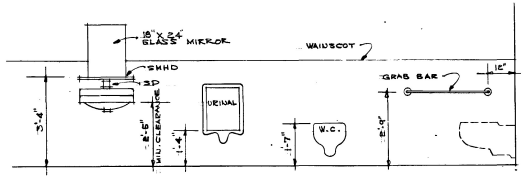

HANDICAPPED FIXTURES

TYPICAL FIXTURE HEIGHTS 1/2"=1'-0"

TOIL. & JAN. ACCESSORIES

ABB & REV	ITEMS
TTD	TOILET TISSUE DISPENSER.
PTD	PAPER TOWEL DISPENSER.
WR	WASTE RECEPTACLE
SND	SANITARY NAPKIN & TAMPON DISPOSER
SNTD	SANITARY NAPKIN & TAMPON DISPENSER
HC	HANDICAP
TB	TOWEL BAR
SGR	SOAP GRAB BAR
SH	SOAP HOLDER
SC	SHOWER CURTAIN
SCR	SHOWER CURTAIN ROD
TTH	TOOTHBRUSH & TUMBLER HOLDER
SMHD	SHELF, METAL, HEAVYDUTY
SD	SOAP DISPENSER
EWC	ELECTRIC WATER COOLER
GB	GRAB BAR
MG	MIRROR, GLASS

GRAPHIC SCALES
SCALE: 1/2 IN. = 1 FT
SCALE: 1/4 IN. = 1 FT.

REV	DATE	DESCRIPTION	BY
	MAY 90	AS BUILT	

US Army Corps of Engineers
U.S. ARMY ENGINEER DISTRICT, BALTIMORE
CORPS OF ENGINEERS
BALTIMORE, MARYLAND
ABERDEEN PROVING GROUND MARYLAND

ENLISTED BARRACKS PHASE IV

TOILET PLANS & DETAILS

DRAWING NUMBER F-721-90-12
PLATE 78
SCALE: AS SHOWN
DATE: 5 FEB. 1987
SHEET A-31

41763