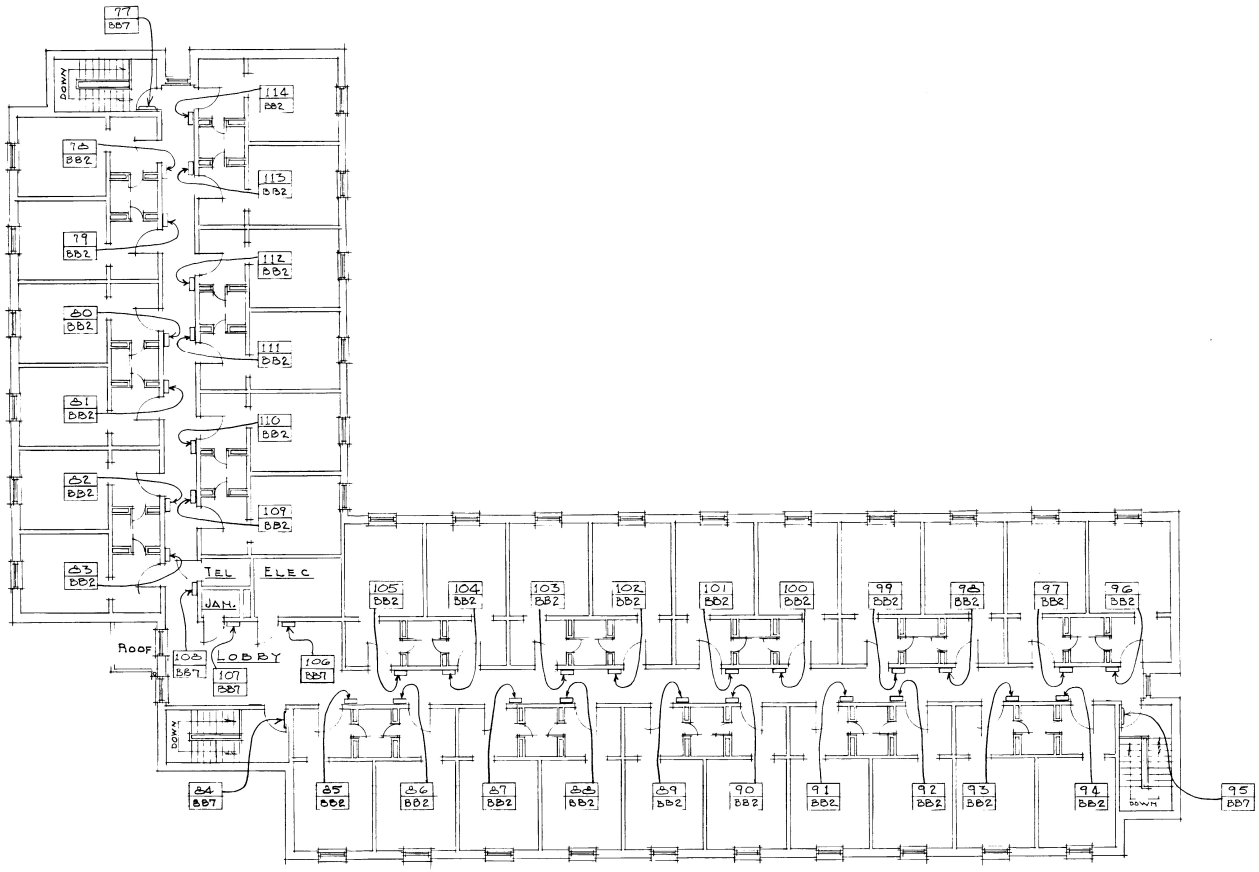

THIRD FLOOR PLAN
42 MODULES

NOTE

REFER TO SPECIFICATION SECTION 10440 FOR SIGNAGE SCHEDULE.

REV	DATE	DESCRIPTION	BY
	MAY 90	AS BUILT	

US Army Corps of Engineers

U.S. ARMY ENGINEER DISTRICT, BALTIMORE
CORPS OF ENGINEERS
BALTIMORE, MARYLAND

ABERDEEN PROVING GROUND MARYLAND

ENLISTED BARRACKS PHASE IV
BUILDING "A"

SIGNAGE LAYOUT

DRAWING NUMBER F-721-90-12 PLATE 93

SCALE: NO SCALE DATE: 5 FEB. 1987 SHEET A-46

41798