NOTES

1. TOILET DETAILS SEE SHEET A-31.
2. DEPRESS SLAB 2" TO RECEIVE QUARRY TILE.
3. ALL EXPOSED CORNERS OF GLAZED STRUCTURAL UNITS, CMU AND COLUMNS TO BE PROVIDED WITH METAL GUARDS EXTENDING 5'-0" ABOVE THE TOP OF COVE BASE.
   METAL GUARDS SHALL BE STAINLESS STEEL.
4. SLOPE FINISH FLOOR TO FLOOR DRAINS WHERE DRAINS ARE INDICATED - SEE PLUMBING DRAWINGS.
5. INSTALL BRACING IN ACCORDANCE WITH PARTITION BRACING DETAIL PLATE "115".
6. INSTALL BRACING IN ACCORDANCE WITH PARTITION BRACING DETAIL PLATE "116".

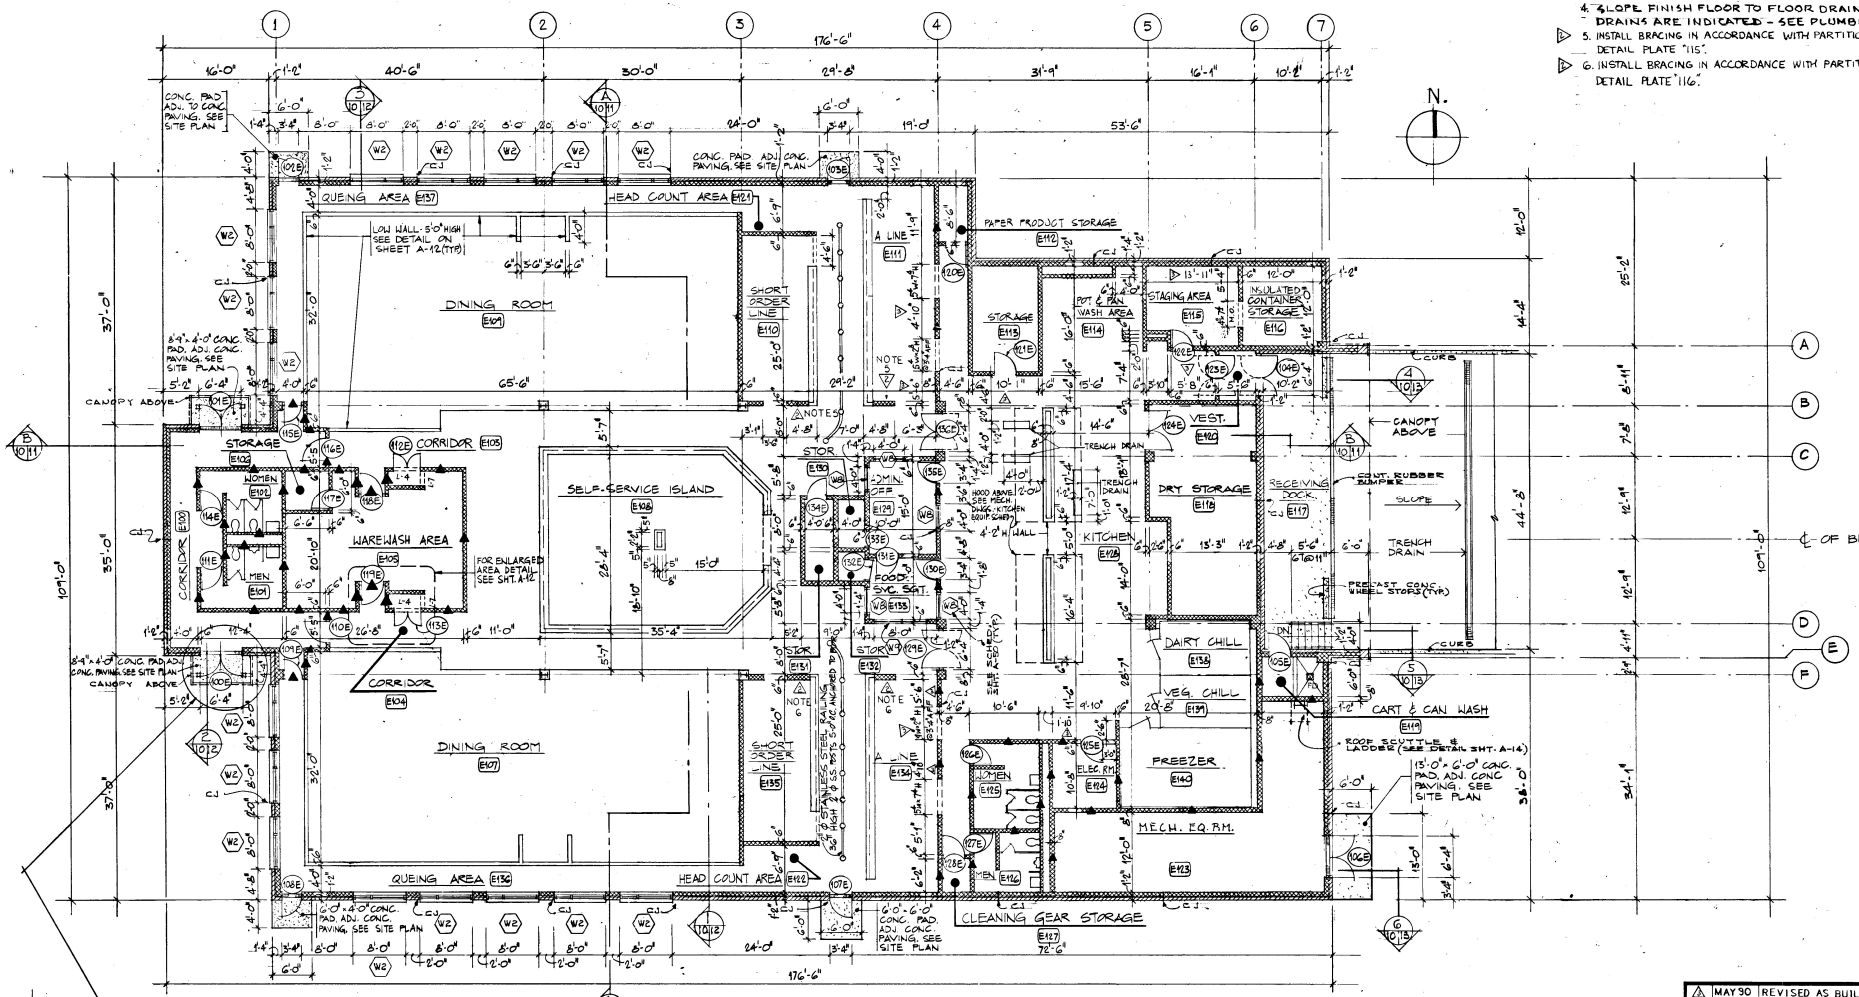

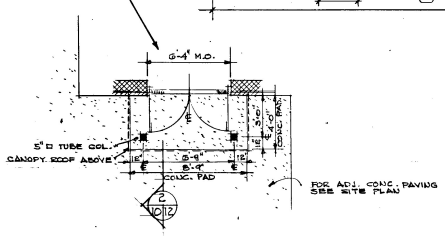

ENLARGED PLAN ENT. TO CORR E100
OPPOSITE ENT. SIMILAR 1/4"=1'-0"

FLOOR PLAN

SCALE 1/8" = 1'-0"

LEGEND

	BRICK	
	C.M.U.	
CORRIDOR E100		1 HR. FIRE RATED WALLS.
STORAGE E106 E130 E131 E132 E112		1 HR. FIRE RATED WALLS & CEILING.
PAPER PRODUCT STOR. E112		1 HR. FIRE RATED WALLS.
CLEANING GEAR STORAGE E127		1 HR. FIRE RATED WALLS & CEILING.
DRY STORAGE E118		1 HR. FIRE RATED WALLS & CEILING.
▲	C.M.U. FLOOR TO ROOF	

ALL OTHER WALLS FLOOR TO CEILING + 8".

GRAPHIC SCALES

SCALE: 1/8 IN. = 1 FT.
4 0 4 8 12 16 20

SCALE: 1/4 IN. = 1 FT
4 3 2 1 0 4 8

REV	DATE	DESCRIPTION	BY
3	MAY 90	REVISED AS BUILT	
2	8 JULY 89	REVISED PER MOD P00020	
1	5 JUNE 87	ADD BLDG TO STORAGE IN LEGEND	JDD

US Army Corps of Engineers

U.S. ARMY ENGINEER DISTRICT, BALTIMORE
CORPS OF ENGINEERS
BALTIMORE, MARYLAND

ABERDEEN PROVING GROUND MARYLAND

ENLISTED BARRACKS PHASE IV
DINING FACILITY, BLDG. "E"

FLOOR PLAN

DRAWING NUMBER	PLATE
F-721-90-12	56

SCALE: 1/8" = 1'-0" DATE: 5 FEB. 1987 SHEET A-10

41761