DOOR SCHEDULE

BARRACKS "B,C,&D" - 48 MODULE

DOOR NUM.	TYPE	WD.	SIZE HT.	THCK.	MATER.	FRAME HEAD	FRAME JAMB	THRSHLD	FIRE RATING	LOUVER SIZE	GLAZING SIZE	LINTEL NO.	HRDWRE. SET	REMARKS
00B,C&D	A	(2)3'0"	7'2"	1-3/4"	H.M.	H-1*	J-1	T-1	---	---	24"x36"	L-2	HW-1B,C,&D	*USE TEMPERED SAFETY GLASS FOR TRANSOM
01B,C&D	B	(2)3'0"	7'2"	1-3/4"	H.M.	H-2	J-3	T-1	---	---	---	L-5	HW-8B,C,&D	
02B,C&D	D	3'0"	7'2"	1-3/4"	H.M.	H-2	J-3	T-1	---	---	---	L-1	HW-3B,C,&D	
03B,C&D	D	3'0"	7'2"	1-3/4"	H.M.	H-2	J-4	T-1	---	---	---	L-1	HW-3B,C,&D	
04B,C&D	D	3'0"	7'2"	1-3/4"	H.M.	H-2	J-3	T-1	---	---	---	L-1	HW-3B,C,&D	
05B,C&D	D	3'0"	7'2"	1-3/4"	H.M.	H-2	J-3	T-1	---	---	---	L-1	HW-3B,C,&D	
06B,C&D	A	(2)3'0"	7'2"	1-3/4"	H.M.	H-3*	J-2	---	---	---	24"x36"	L-5	HW-2B,C,&D	*USE TEMPERED SAFETY GLASS FOR TRANSOM
07B,C&D	E	3'0"	7'2"	1-3/4"	H.M.	H-4	J-5	---	20	---	6"x16"	L-4	HW-7B,C,&D	
08B,C&D	E	3'0"	7'2"	1-3/4"	H.M.	H-4	J-5	---	20	---	6"x16"	L-4	HW-7B,C,&D	
09B,C&D	E	3'0"	7'2"	1-3/4"	H.M.	H-4	J-5	---	60	---	6"x16"	L-4	HW-4B,C,&D	
10B,C&D	E	3'0"	7'2"	1-3/4"	H.M.	H-4	J-5	---	20	---	6"x16"	L-4	HW-7B,C,&D	
11B,C&D	E	3'0"	7'2"	1-3/4"	H.M.	H-4	J-5	---	20	---	6"x16"	L-4	HW-7B,C,&D	
12B,C&D	D	3'0"	7'2"	1-3/4"	H.M.	H-4	J-5	T-3	45	---	---	L-4	HW-7B,C,&D	
13B,C&D	D	3'0"	7'2"	1-3/4"	H.M.	H-4	J-5	T-3	20	---	---	L-7	HW-10B,C,&D	
14B,C&D	D	3'0"	7'2"	1-3/4"	H.M.	H-4	J-5	T-3	20	---	---	L-7	HW-10B,C,&D	
15B,C&D	D	3'0"	7'2"	1-3/4"	H.M.	H-4	J-5	T-3	45	---	---	L-4	HW-10B,C,&D	
16B,C&D	D	3'0"	7'2"	1-3/4"	H.M.	H-4	J-5	T-4	20	---	---	L-4	HW-9B,C,&D	
17B,C&D	D	3'0"	7'2"	1-3/4"	H.M.	H-4	J-5	T-4	20	---	---	L-4	HW-9B,C,&D	
18B,C&D	D	3'0"	7'2"	1-3/4"	H.M.	H-4	J-5	---	20	---	---	L-4	HW-5B,C,&D	
19B,C&D	D	2'4"	7'2"	1-3/4"	H.M.	H-4	J-6	T-2	---	---	---	L-7	HW-6B,C,&D	
20B,C&D	D	2'4"	7'2"	1-3/4"	H.M.	H-4	J-6	T-2	---	---	---	L-7	HW-6B,C,&D	
21B,C&D	D	3'0"	7'2"	1-3/4"	H.M.	H-4	J-5	---	20	---	---	L-4	HW-5B,C,&D	
22B,C&D	D	3'0"	7'2"	1-3/4"	H.M.	H-4	J-5	---	20	---	---	L-4	HW-5B,C,&D	
23B,C&D	D	2'4"	7'2"	1-3/4"	H.M.	H-4	J-6	T-2	---	---	---	L-7	HW-6B,C,&D	
24B,C&D	D	2'4"	7'2"	1-3/4"	H.M.	H-4	J-6	T-2	---	---	---	L-7	HW-6B,C,&D	
25B,C&D	D	3'0"	7'2"	1-3/4"	H.M.	H-4	J-5	---	20	---	---	L-4	HW-5B,C,&D	
26B,C&D	D	3'0"	7'2"	1-3/4"	H.M.	H-4	J-5	---	20	---	---	L-4	HW-5B,C,&D	
27B,C&D	D	2'4"	7'2"	1-3/4"	H.M.	H-4	J-6	T-2	---	---	---	L-7	HW-6B,C,&D	
28B,C&D	D	2'4"	7'2"	1-3/4"	H.M.	H-4	J-6	T-2	---	---	---	L-7	HW-6B,C,&D	
29B,C&D	D	3'0"	7'2"	1-3/4"	H.M.	H-4	J-5	---	20	---	---	L-4	HW-5B,C,&D	
30B,C&D	D	3'0"	7'2"	1-3/4"	H.M.	H-4	J-5	---	20	---	---	L-4	HW-5B,C,&D	
31B,C&D	D	2'4"	7'2"	1-3/4"	H.M.	H-4	J-6	T-2	---	---	---	L-7	HW-6B,C,&D	
32B,C&D	D	2'4"	7'2"	1-3/4"	H.M.	H-4	J-6	T-2	---	---	---	L-7	HW-6B,C,&D	
33B,C&D	D	3'0"	7'2"	1-3/4"	H.M.	H-4	J-5	---	20	---	---	L-4	HW-5B,C,&D	
34B,C&D	D	3'0"	7'2"	1-3/4"	H.M.	H-4	J-5	---	20	---	---	L-4	HW-5B,C,&D	
35B,C&D	D	2'4"	7'2"	1-3/4"	H.M.	H-4	J-6	T-2	---	---	---	L-7	HW-6B,C,&D	
36B,C&D	D	2'4"	7'2"	1-3/4"	H.M.	H-4	J-6	T-2	---	---	---	L-7	HW-6B,C,&D	
37B,C&D	D	3'0"	7'2"	1-3/4"	H.M.	H-4	J-5	---	20	---	---	L-4	HW-5B,C,&D	
38B,C&D	D	3'0"	7'2"	1-3/4"	H.M.	H-4	J-5	---	20	---	---	L-4	HW-5B,C,&D	
39B,C&D	D	2'4"	7'2"	1-3/4"	H.M.	H-4	J-6	T-2	---	---	---	L-7	HW-6B,C,&D	
40B,C&D	D	2'4"	7'2"	1-3/4"	H.M.	H-4	J-6	T-2	---	---	---	L-7	HW-6B,C,&D	
41B,C&D	D	3'0"	7'2"	1-3/4"	H.M.	H-4	J-5	---	20	---	---	L-4	HW-5B,C,&D	
42B,C&D	E	3'0"	7'2"	1-3/4"	H.M.	H-4	J-5	---	60	---	6"x16"	L-4	HW-4B,C,&D	
43B,C&D	D	3'0"	7'2"	1-3/4"	H.M.	H-4	J-5	---	20	---	---	L-4	HW-5B,C,&D	
44B,C&D	D	2'4"	7'2"	1-3/4"	H.M.	H-4	J-6	T-2	---	---	---	L-7	HW-6B,C,&D	
45B,C&D	D	2'4"	7'2"	1-3/4"	H.M.	H-4	J-6	T-2	---	---	---	L-7	HW-6B,C,&D	
46B,C&D	D	3'0"	7'2"	1-3/4"	H.M.	H-4	J-5	---	20	---	---	L-4	HW-5B,C,&D	
47B,C&D	D	3'0"	7'2"	1-3/4"	H.M.	H-4	J-5	---	20	---	---	L-4	HW-5B,C,&D	
48B,C&D	D	2'4"	7'2"	1-3/4"	H.M.	H-4	J-6	T-2	---	---	---	L-7	HW-6B,C,&D	
49B,C&D	D	2'4"	7'2"	1-3/4"	H.M.	H-4	J-6	T-2	---	---	---	L-7	HW-6B,C,&D	
50B,C&D	D	3'0"	7'2"	1-3/4"	H.M.	H-4	J-5	---	20	---	---	L-4	HW-5B,C,&D	
51B,C&D	D	3'0"	7'2"	1-3/4"	H.M.	H-4	J-5	---	20	---	---	L-4	HW-5B,C,&D	
52B,C&D	D	2'4"	7'2"	1-3/4"	H.M.	H-4	J-6	T-2	---	---	---	L-7	HW-6B,C,&D	
53B,C&D	D	2'4"	7'2"	1-3/4"	H.M.	H-4	J-6	T-2	---	---	---	L-7	HW-6B,C,&D	
54B,C&D	D	3'0"	7'2"	1-3/4"	H.M.	H-4	J-5	---	20	---	---	L-4	HW-5B,C,&D	
55B,C&D	D	3'0"	7'2"	1-3/4"	H.M.	H-4	J-5	---	20	---	---	L-4	HW-5B,C,&D	
56B,C&D	D	2'4"	7'2"	1-3/4"	H.M.	H-4	J-6	T-2	---	---	---	L-7	HW-6B,C,&D	
57B,C&D	D	2'4"	7'2"	1-3/4"	H.M.	H-4	J-6	T-2	---	---	---	L-7	HW-6B,C,&D	
58B,C&D	D	3'0"	7'2"	1-3/4"	H.M.	H-4	J-5	---	20	---	---	L-4	HW-5B,C,&D	
59B,C&D	D	3'0"	7'2"	1-3/4"	H.M.	H-4	J-5	---	20	---	---	L-4	HW-5B,C,&D	
60B,C&D	D	2'4"	7'2"	1-3/4"	H.M.	H-4	J-6	T-2	---	---	---	L-7	HW-6B,C,&D	
61B,C&D	D	2'4"	7'2"	1-3/4"	H.M.	H-4	J-6	T-2	---	---	---	L-7	HW-6B,C,&D	
62B,C&D	D	3'0"	7'2"	1-3/4"	H.M.	H-4	J-5	---	20	---	---	L-4	HW-5B,C,&D	
63B,C&D	D	3'0"	7'2"	1-3/4"	H.M.	H-4	J-5	---	20	---	---	L-4	HW-5B,C,&D	
64B,C&D	D	2'4"	7'2"	1-3/4"	H.M.	H-4	J-6	T-2	---	---	---	L-7	HW-6B,C,&D	
65B,C&D	D	2'4"	7'2"	1-3/4"	H.M.	H-4	J-6	T-2	---	---	---	L-7	HW-6B,C,&D	
66B,C&D	D	3'0"	7'2"	1-3/4"	H.M.	H-4	J-5	---	20	---	---	L-4	HW-5B,C,&D	
67B,C&D	E	3'0"	7'2"	1-3/4"	H.M.	H-4	J-5	---	60	---	6"x16"	L-4	HW-4B,C,&D	
68B,C&D	D	2'4"	7'2"	1-3/4"	H.M.	H-4	J-5	---	---	---	---	L-7	HW-11B,C,&D	
69B,C&D	D	2'4"	7'2"	1-3/4"	H.M.	H-4	J-5	---	---	---	---	L-7	HW-11B,C,&D	

: THIRD FLOOR DOOR NUMBERS ARE IDENTICAL TO SECOND FLOOR

DOOR NUM.	TYPE	WD.	SIZE HT.	THCK.	MATER.	FRAME HEAD	FRAME JAMB	THRSHLD	FIRE RATING	LOUVER SIZE	GLAZING SIZE	LINTEL NO.	HRDWRE. SET	REMARKS
300B,C&D	D	3'0"	7'2"	1-3/4"	H.M.	H-4	J-5	---	20	---	---	L-4	HW-5B,C,&D	
301B,C&D	D	2'4"	7'2"	1-3/4"	H.M.	H-4	J-6	T-2	---	---	---	L-7	HW-6B,C,&D	
302B,C&D	D	2'4"	7'2"	1-3/4"	H.M.	H-4	J-6	T-2	---	---	---	L-7	HW-6B,C,&D	
303B,C&D	D	3'0"	7'2"	1-3/4"	H.M.	H-4	J-5	---	20	---	---	L-4	HW-5B,C,&D	
204&304B,C&D	D	3'0"	7'2"	1-3/4"	H.M.	H-4	J-5	---	20	---	---	L-4	HW-5B,C,&D	
205&305B,C&D	D	2'4"	7'2"	1-3/4"	H.M.	H-4	J-6	T-2	---	---	---	L-7	HW-6B,C,&D	
206&306B,C&D	D	2'4"	7'2"	1-3/4"	H.M.	H-4	J-6	T-2	---	---	---	L-7	HW-6B,C,&D	
207&307B,C&D	D	3'0"	7'2"	1-3/4"	H.M.	H-4	J-5	---	20	---	---	L-4	HW-5B,C,&D	
208&308B,C&D	D	3'0"	7'2"	1-3/4"	H.M.	H-4	J-5	---	20	---	---	L-4	HW-5B,C,&D	
209&309B,C&D	D	2'4"	7'2"	1-3/4"	H.M.	H-4	J-6	T-2	---	---	---	L-7	HW-6B,C,&D	
210&310B,C&D	D	2'4"	7'2"	1-3/4"	H.M.	H-4	J-6	T-2	---	---	---	L-7	HW-6B,C,&D	
211&311B,C&D	D	3'0"	7'2"	1-3/4"	H.M.	H-4	J-5	---	20	---	---	L-4	HW-5B,C,&D	
212&312B,C&D	E	3'0"	7'2"	1-3/4"	H.M.	H-4	J-5	---	60	---	6"x16"	L-4	HW-4B,C,&D	
213&313B,C&D	D	3'0"	7'2"	1-3/4"	H.M.	H-4	J-5	---	20	---	---	L-4	HW-5B,C,&D	
214&314B,C&D	D	2'4"	7'2"	1-3/4"	H.M.	H-4	J-6	T-2	---	---	---	L-7	HW-6B,C,&D	
215&315B,C&D	D	2'4"	7'2"	1-3/4"	H.M.	H-4	J-6	T-2	---	---	---	L-7	HW-6B,C,&D	
216&316B,C&D	D	3'0"	7'2"	1-3/4"	H.M.	H-4	J-5	---	20	---	---	L-4	HW-5B,C,&D	
217&317B,C&D	D	3'0"	7'2"	1-3/4"	H.M.	H-4	J-5	---	20	---	---	L-4	HW-5B,C,&D	
218&318B,C&D	D	2'4"	7'2"	1-3/4"	H.M.	H-4	J-6	T-2	---	---	---	L-7	HW-6B,C,&D	
219&319B,C&D	D	2'4"	7'2"	1-3/4"	H.M.	H-4	J-6	T-2	---	---	---	L-7	HW-6B,C,&D	
220&320B,C&D	D	3'0"	7'2"	1-3/4"	H.M.	H-4	J-5	---	20	---	---	L-4	HW-5B,C,&D	
221&321B,C&D	D	3'0"	7'2"	1-3/4"	H.M.	H-4	J-5	---	20	---	---	L-4	HW-5B,C,&D	
222&322B,C&D	D	2'4"	7'2"	1-3/4"	H.M.	H-4	J-6	T-2	---	---	---	L-7	HW-6B,C,&D	
223&323B,C&D	D	2'4"	7'2"	1-3/4"	H.M.	H-4	J-6	T-2	---	---	---	L-7	HW-6B,C,&D	
224&324B,C&D	D	3'0"	7'2"	1-3/4"	H.M.	H-4	J-5	---	20	---	---	L-4	HW-5B,C,&D	
225&325B,C&D	D	3'0"	7'2"	1-3/4"	H.M.	H-4	J-5	T-3	20	---	---	L-4	HW-10B,C,&D	
226&326B,C&D	D	3'0"	7'2"	1-3/4"	H.M.	H-4	J-5	T-3	45	---	---	L-4	HW-10B,C,&D	
227&327B,C&D	D	3'0"	7'2"	1-3/4"	H.M.	H-4	J-5	T-3	20	---	---	L-4	HW-10B,C,&D	
228&328B,C&D	D	3'0"	7'2"	1-3/4"	H.M.	H-4	J-5	---	20	---	---	L-4	HW-5B,C,&D	
229&329B,C&D	D	2'4"	7'2"	1-3/4"	H.M.	H-4	J-6	T-2	---	---	---	L-7	HW-6B,C,&D	
230&330B,C&D	D	2'4"	7'2"	1-3/4"	H.M.	H-4	J-6	T-2	---	---	---	L-7	HW-6B,C,&D	
231&331B,C&D	D	3'0"	7'2"	1-3/4"	H.M.	H-4	J-5	---	20	---	---	L-4	HW-5B,C,&D	
232&332B,C&D	D	3'0"	7'2"	1-3/4"	H.M.	H-4	J-5	---	20	---	---	L-4	HW-5B,C,&D	
233&333B,C&D	D	2'4"	7'2"	1-3/4"	H.M.	H-4	J-6	T-2	---	---	---	L-7	HW-6B,C,&D	
234&334B,C&D	D	2'4"	7'2"	1-3/4"	H.M.	H-4	J-6	T-2	---	---	---	L-7	HW-6B,C,&D	
235&335B,C&D	D	3'0"	7'2"	1-3/4"	H.M.	H-4	J-5	---	20	---	---	L-4	HW-5B,C,&D	
236&336B,C&D	D	3'0"	7'2"	1-3/4"	H.M.	H-4	J-5	---	20	---	---	L-4	HW-5B,C,&D	
237&337B,C&D	D	2'4"	7'2"	1-3/4"	H.M.	H-4	J-6	T-2	---	---	---	L-7	HW-6B,C,&D	
238&338B,C&D	D	2'4"	7'2"	1-3/4"	H.M.	H-4	J-6	T-2	---	---	---	L-7	HW-6B,C,&D	
239&339B,C&D	D	3'0"	7'2"	1-3/4"	H.M.	H-4	J-5	---	20	---	---	L-4	HW-5B,C,&D	
240&340B,C&D	D	3'0"	7'2"	1-3/4"	H.M.	H-4	J-5	---	20	---	---	L-4	HW-5B,C,&D	
241&341B,C&D	D	2'4"	7'2"	1-3/4"	H.M.	H-4	J-6	T-2	---	---	---	L-7	HW-6B,C,&D	
242&342B,C&D	D	2'4"	7'2"	1-3/4"	H.M.	H-4	J-6	T-2	---	---	---	L-7	HW-6B,C,&D	
243&343B,C&D	D	3'0"	7'2"	1-3/4"	H.M.	H-4	J-5	---	20	---	---	L-4	HW-5B,C,&D	
244&344B,C&D	D	3'0"	7'2"	1-3/4"	H.M.	H-4	J-5	---	20	---	---	L-4	HW-5B,C,&D	
245&345B,C&D	D	2'4"	7'2"	1-3/4"	H.M.	H-4	J-6	T-2	---	---	---	L-7	HW-6B,C,&D	
246&346B,C&D	D	2'4"	7'2"	1-3/4"	H.M.	H-4	J-6	T-2	---	---	---	L-7	HW-6B,C,&D	
247&347B,C&D	D	3'0"	7'2"	1-3/4"	H.M.	H-4	J-5	---	20	---	---	L-4	HW-5B,C,&D	
248&348B,C&D	D	3'0"	7'2"	1-3/4"	H.M.	H-4	J-5	---	20	---	---	L-4	HW-5B,C,&D	
249&349B,C&D	D	2'4"	7'2"	1-3/4"	H.M.	H-4	J-6	T-2	---	---	---	L-7	HW-6B,C,&D	
250&350B,C&D	D	2'4"	7'2"	1-3/4"	H.M.	H-4	J-6	T-2	---	---	---	L-7	HW-6B,C,&D	
251&351B,C&D	D	3'0"	7'2"	1-3/4"	H.M.	H-4	J-5	---	20	---	---	L-4	HW-5B,C,&D	
252&352B,C&D	E	3'0"	7'2"	1-3/4"	H.M.	H-4	J-5	---	60	---	6"x16"	L-4	HW-4B,C,&D	
253&353B,C&D	D	3'0"	7'2"	1-3/4"	H.M.	H-4	J-5	---	20	---	---	L-4	HW-5B,C,&D	
254&354B,C&D	D	2'4"	7'2"	1-3/4"	H.M.	H-4	J-6	T-2	---	---	---	L-7	HW-6B,C,&D	
255&355B,C&D	D	2'4"	7'2"	1-3/4"	H.M.	H-4	J-6	T-2	---	---	---	L-7	HW-6B,C,&D	
256&356B,C&D	D	3'0"	7'2"	1-3/4"	H.M.	H-4	J-5	---	20	---	---	L-4	HW-5B,C,&D	
257&357B,C&D	D	3'0"	7'2"	1-3/4"	H.M.	H-4	J-5	---	20	---	---	L-4	HW-5B,C,&D	
258&358B,C&D	D	2'4"	7'2"	1-3/4"	H.M.	H-4	J-6	T-2	---	---	---	L-7	HW-6B,C,&D	
259&359B,C&D	D	2'4"	7'2"	1-3/4"	H.M.	H-4	J-6	T-2	---	---	---	L-7	HW-6B,C,&D	
260&360B,C&D	D	3'0"	7'2"	1-3/4"	H.M.	H-4	J-5	---	20	---	---	L-4	HW-5B,C,&D	
261&361B,C&D	D	3'0"	7'2"	1-3/4"	H.M.	H-4	J-5	---	20	---	---	L-4	HW-5B,C,&D	
262&362B,C&D	D	2'4"	7'2"	1-3/4"	H.M.	H-4	J-6	T-2	---	---	---	L-7	HW-6B,C,&D	
263&363B,C&D	D	2'4"	7'2"	1-3/4"	H.M.	H-4	J-6	T-2	---	---	---	L-7	HW-6B,C,&D	
264&364B,C&D	D	3'0"	7'2"	1-3/4"	H.M.	H-4	J-5	---	20	---	---	L-4	HW-5B,C,&D	
265&365B,C&D	D	3'0"	7'2"	1-3/4"	H.M.	H-4	J-5	---	20	---	---	L-4	HW-5B,C,&D	
266&366B,C&D	D	2'4"	7'2"	1-3/4"	H.M.	H-4	J-6	T-2	---	---	---	L-7	HW-6B,C,&D	
267&367B,C&D	D	2'4"	7'2"	1-3/4"	H.M.	H-4	J-6	T-2	---	---	---	L-7	HW-6B,C,&D	
268&368B,C&D	D	3'0"	7'2"	1-3/4"	H.M.	H-4	J-5	---	20	---	---	L-4	HW-5B,C,&D	
269&369B,C&D	D	3'0"	7'2"	1-3/4"	H.M.	H-4	J-5	---	20	---	---	L-4	HW-5B,C,&D	
270&370B,C&D	D	2'4"	7'2"	1-3/4"	H.M.	H-4	J-6	T-2	---	---	---	L-7	HW-6B,C,&D	
271&371B,C&D	D	2'4"	7'2"	1-3/4"	H.M.	H-4	J-6	T-2	---	---	---	L-7	HW-6B,C,&D	
272&372B,C&D	D	3'0"	7'2"	1-3/4"	H.M.	H-4	J-5	---	20	---	---	L-4	HW-5B,C,&D	
273&373B,C&D	D	3'0"	7'2"	1-3/4"	H.M.	H-4	J-5	---	20	---	---	L-4	HW-5B,C,&D	
274&374B,C&D	D	2'4"	7'2"	1-3/4"	H.M.	H-4	J-6	T-2	---	---	---	L-7	HW-6B,C,&D	
275&375B,C&D	D	2'4"	7'2"	1-3/4"	H.M.	H-4	J-6	T-2	---	---	---	L-7	HW-6B,C,&D	
276&376B,C&D	D	3'0"	7'2"	1-3/4"	H.M.	H-4	J-5	---	20	---	---	L-4	HW-5B,C,&D	
277&377B,C&D	E	3'0"	7'2"	1-3/4"	H.M.	H-4	J-5	---	60	---	6"x16"	L-4	HW-4B,C,&D	
400B,C&D	D	2'6"	3'10"	1-3/4"	H.M.	H-4	J-5	---	60	---	---	L-7	HW-12B,C,&D	ATTIC DOOR IN STAIR #2

DOOR TYPES

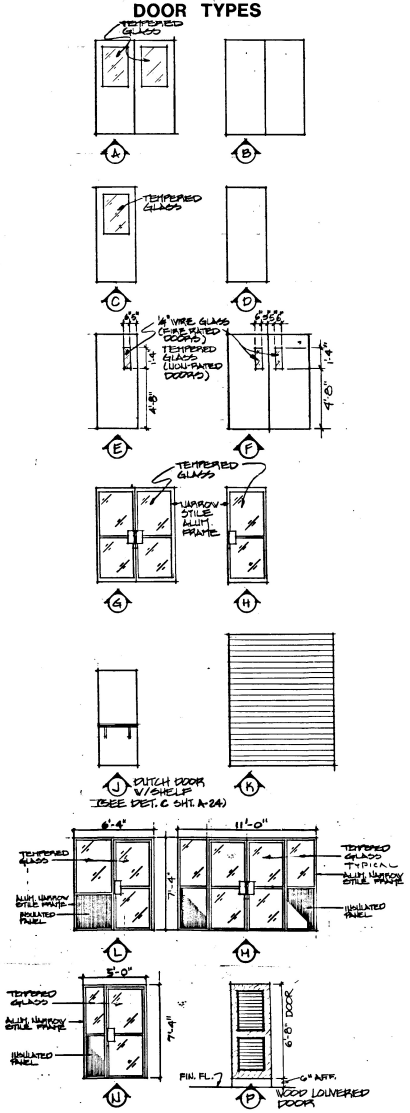

REV	DATE	DESCRIPTION	BY
2	MAY '90	REVISED AS BUILT	
1	24 FEB 89	REVISED PER MOD 00008	

US Army Corps of Engineers

U.S. ARMY ENGINEER DISTRICT, BALTIMORE
CORPS OF ENGINEERS
BALTIMORE, MARYLAND

ABERDEEN PROVING GROUND MARYLAND

ENLISTED BARRACKS PHASE IV

DOOR SCHEDULE

DRAWING NUMBER F-721-90-12 | PLATE 81

SCALE: AS SHOWN | DATE: 5 FEB 1987 | SHEET A-34

41786