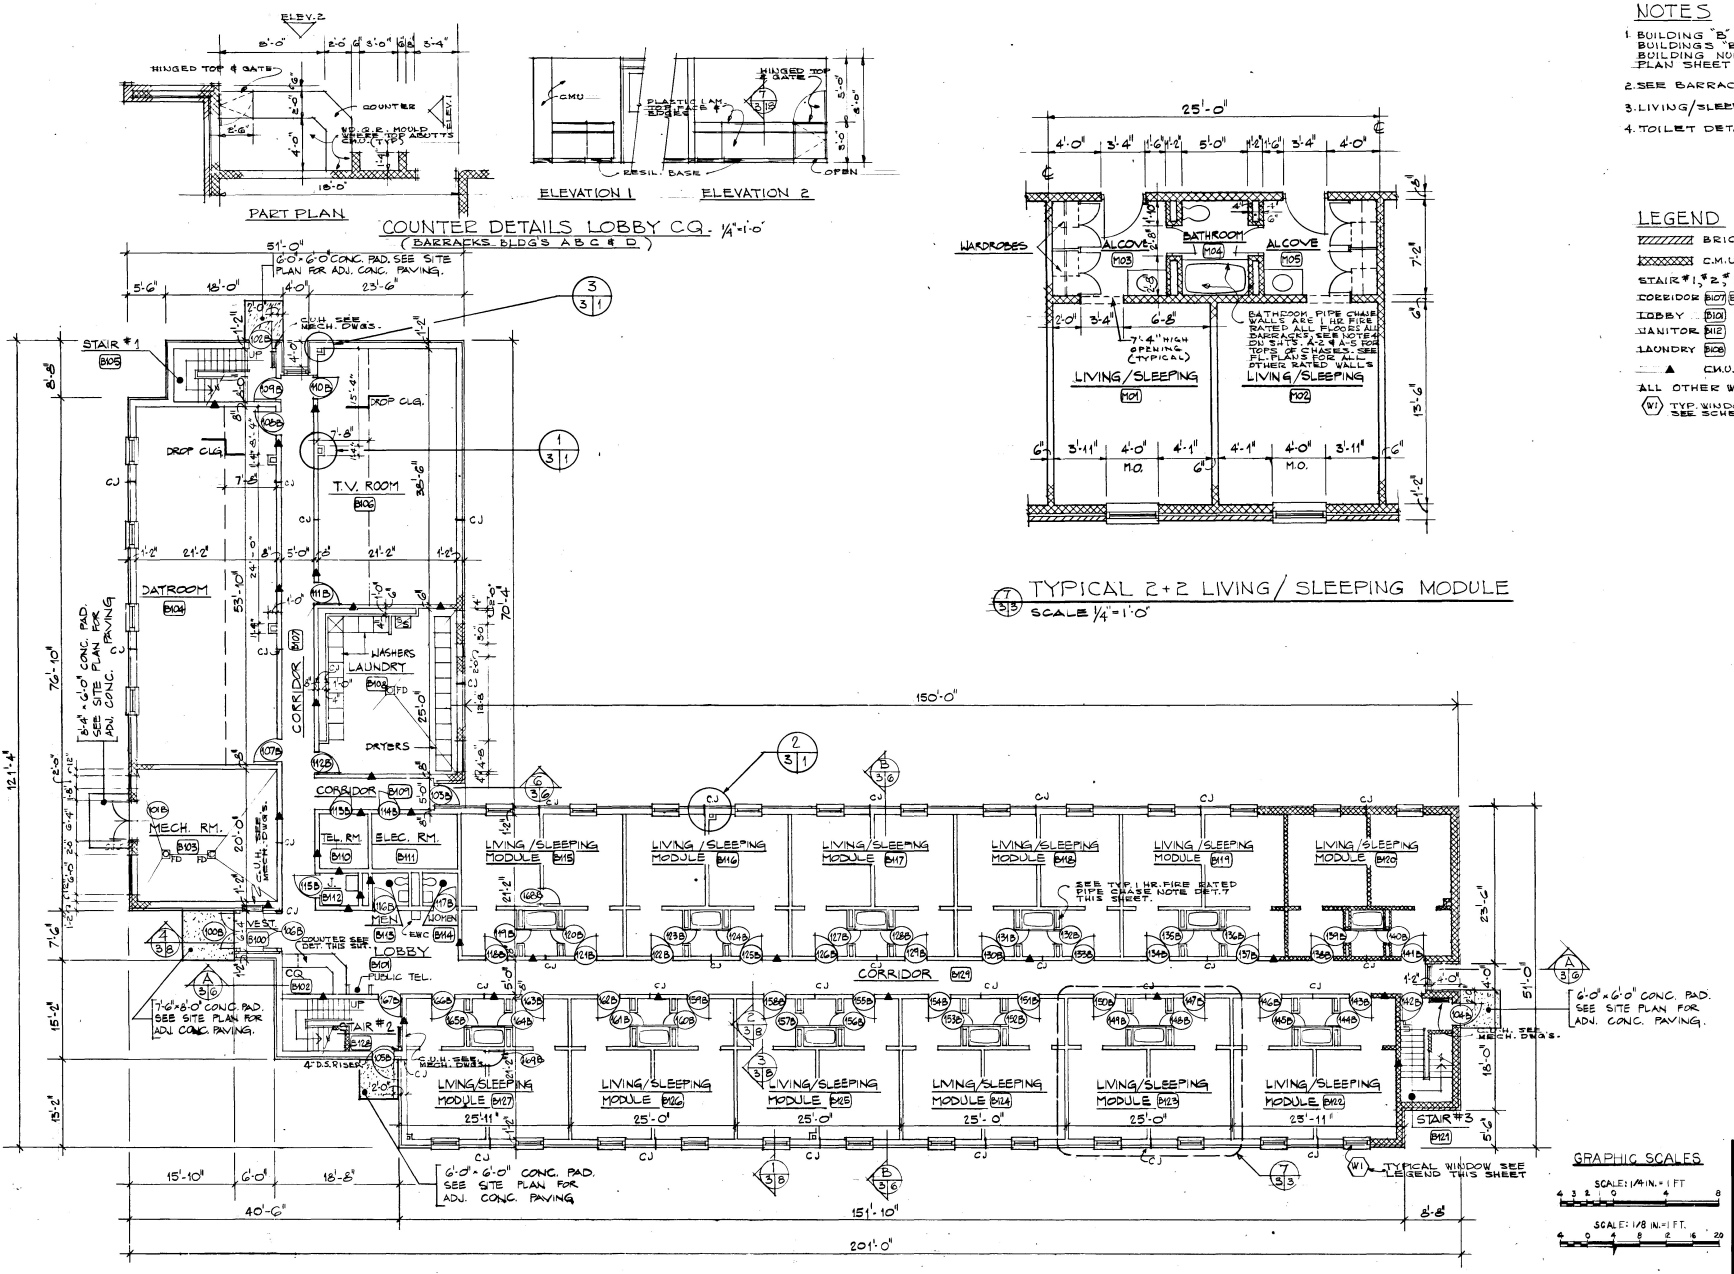

TYPICAL 2+2 LIVING/SLEEPING MODULE
SCALE 1/4"=1'-0"

FIRST FLOOR PLAN - BARRACKS BLDGS. "B", "C" & "D" (48 MODULES EACH BLDG.)
SCALE 1/8" = 1'-0"

NOTES

1. BUILDING "B" PLAN IS OPPOSITE HAND. BUILDINGS "B", "C" & "D" CORRESPOND TO BUILDING NUMBERS 6, 7 & 8 - SEE SITE PLAN SHEET C3.
2. SEE BARRACKS STAIR DETAILS ON SHT. A-30
3. LIVING/SLEEPING MODULE DETAIL SEE THIS SHT.
4. TOILET DETAILS SEE SHT. A-31.

LEGEND

- BRICK
- C.M.U.
- STAIR #1, #2, #3 B105 B128 B121 1 HR. FIRE RATED WALLS.
- CORRIDOR B107 B109 B129 1 HR. FIRE RATED WALLS.
- LOBBY B101 1 HR. FIRE RATED WALLS.
- JANITOR B112 " " " "
- LAUNDRY B108 " " " "
- ▲ C.M.U. FLOOR TO FLOOR ABOVE, FIRE RATED.

ALL OTHER WALLS C.M.U. FLOOR TO FLOOR ABOVE.

(W1) TYP. WINDOW THIS PLAN UNLESS OTHERWISE NOTED, SEE SCHEDULE SHT. A-50.

REV	DATE	DESCRIPTION	BY
	MAY 90	AS BUILT	

U.S. ARMY ENGINEER DISTRICT, BALTIMORE
CORPS OF ENGINEERS
BALTIMORE, MARYLAND

ABERDEEN PROVING GROUND MARYLAND

ENLISTED BARRACKS PHASE IV
BARRACKS "B", "C" & "D"

FIRST FLOOR PLAN

DRAWING NUMBER F-721-90-12 PLATE 49

SCALE: AS SHOWN DATE: 5 FEB 1987 SHEET A-3

41754