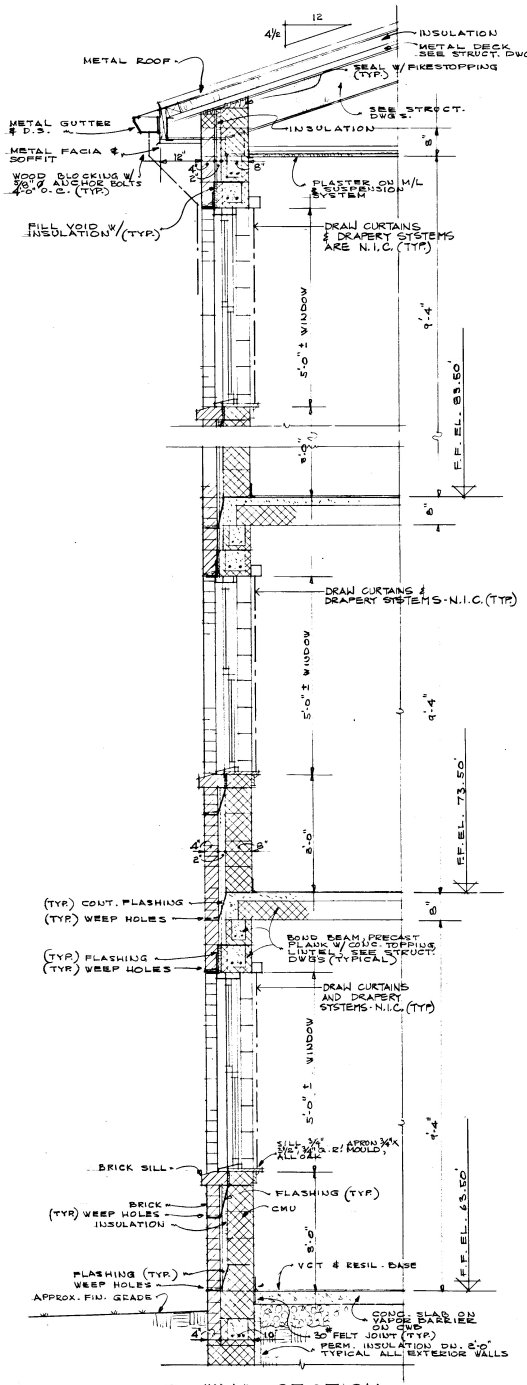

1,2,3,4, & 5 — 1/8 WALL SECTION 3/4"=1'-0"

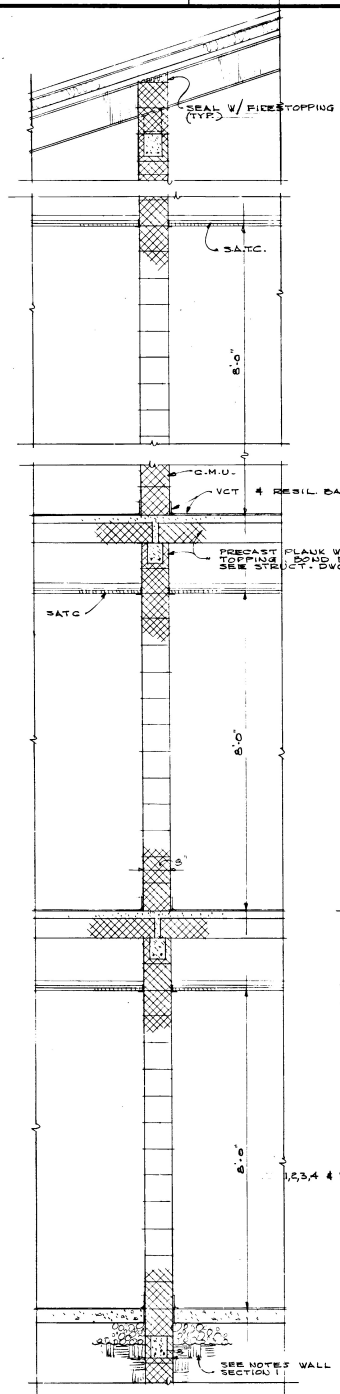

1,2,3,4 & 5 — 2/8 WALL SECTION 3/4"=1'-0"

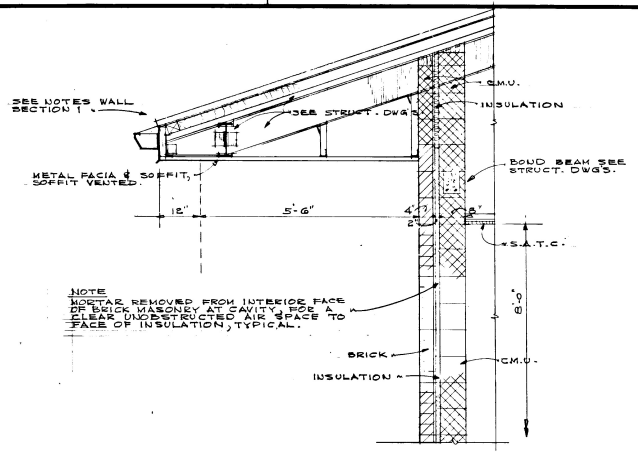

5/2&8/5 PART WALL SECTION 3/4"=1'-0"

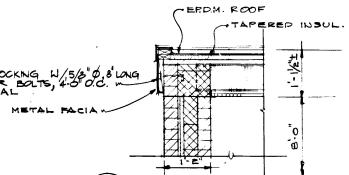

7/4&8/8 DETAIL OF SIDE FASCIA 3/4"=1'-0"

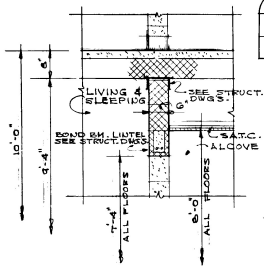

3/8 PART WALL SECTION 3/4"=1'-0"

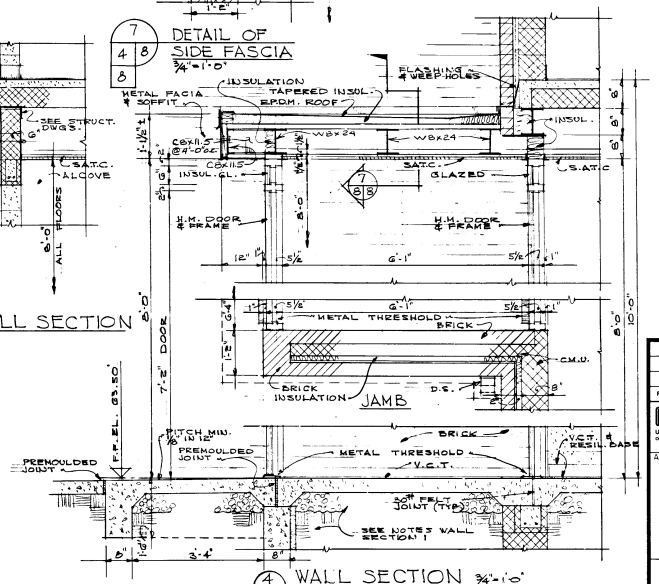

4/1&8/3 WALL SECTION 3/4"=1'-0"

GRAPHIC SCALES

SCALE: 3/4 IN. = 1 FT.

1 0 1 2 3

REV	DATE	DESCRIPTION	BY
	MAY 90	AS BUILT	

US Army Corps of Engineers

U.S. ARMY ENGINEER DISTRICT, BALTIMORE
CORPS OF ENGINEERS
BALTIMORE, MARYLAND

ABERDEEN PROVING GROUND MARYLAND

ENLISTED BARRACKS PHASE IV
BARRACKS "A", "B", "C" & "D"

WALL SECTIONS

DRAWING NUMBER F-721-90-12 PLATE 54

SCALE: AS SHOWN DATE: 5 FEB 1987 SHEET A-8

41759