TILE = 2095.9425

CARPET = 329.9167

BR = 166.6389

FLOOR PLAN BLDG. 4111

SCALE: _"=1'-0"

[redacted]

Total- 2592

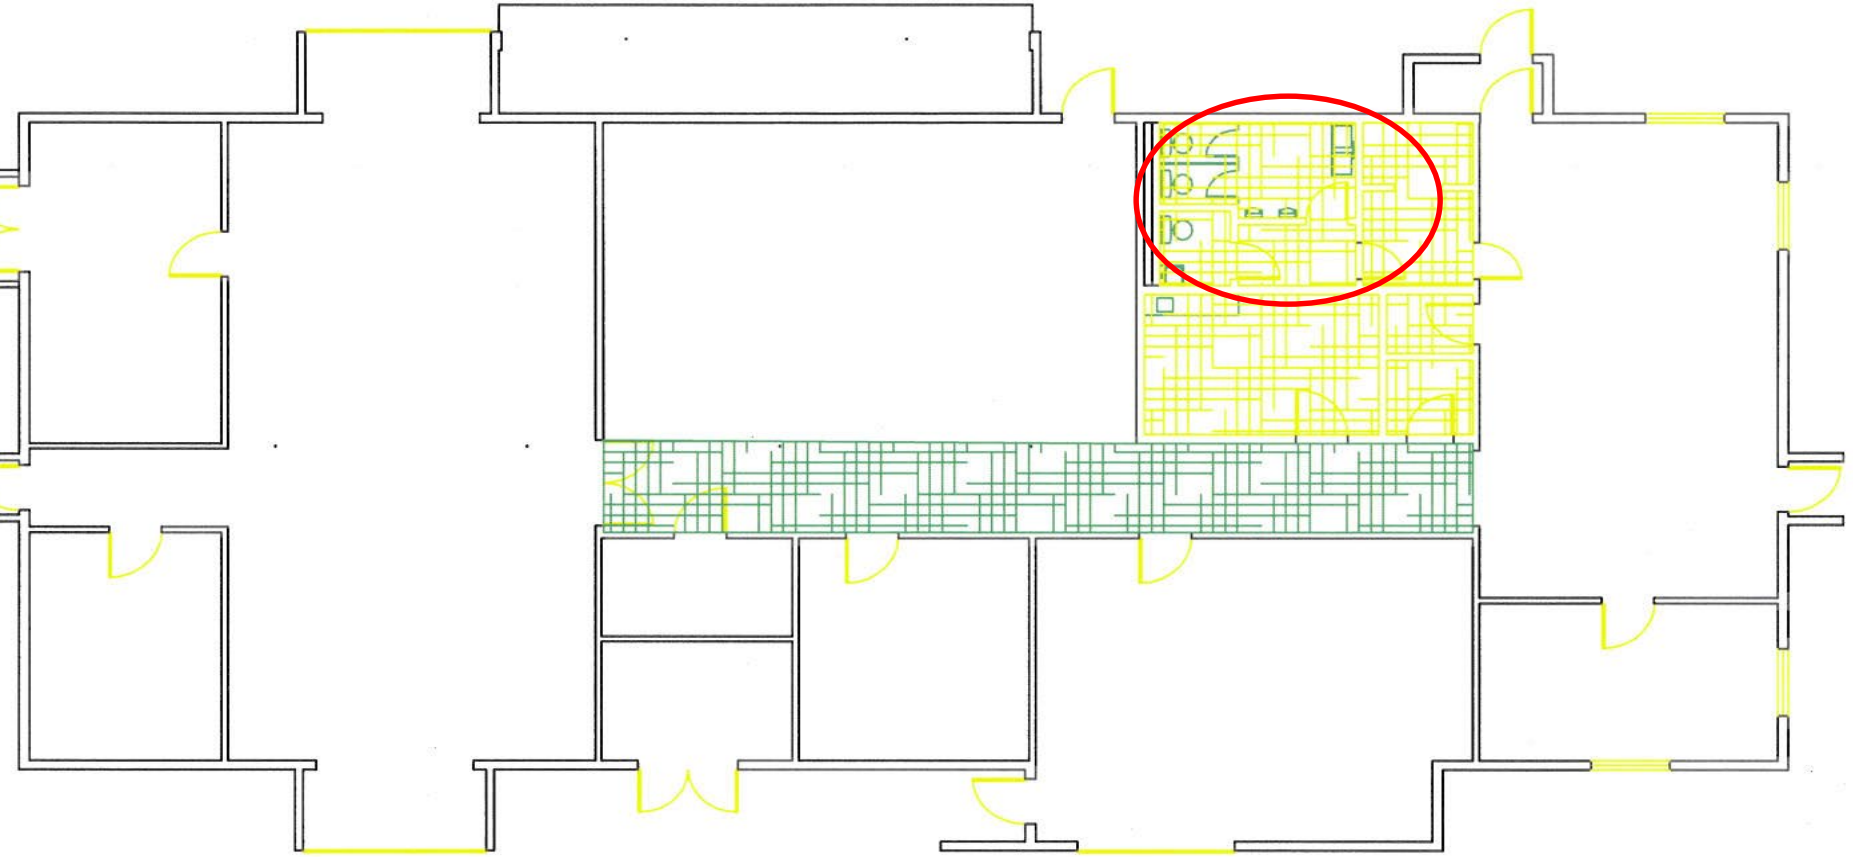

FLOOR PLAN BLDG. 4112

BR 125
Carpet 290
Tile 863

TILE 16388.03 SQ FT

CARPET 12586.44 SQ FT

BR 1414 SQ FT

TOTAL 30388.47

Bldg 4276

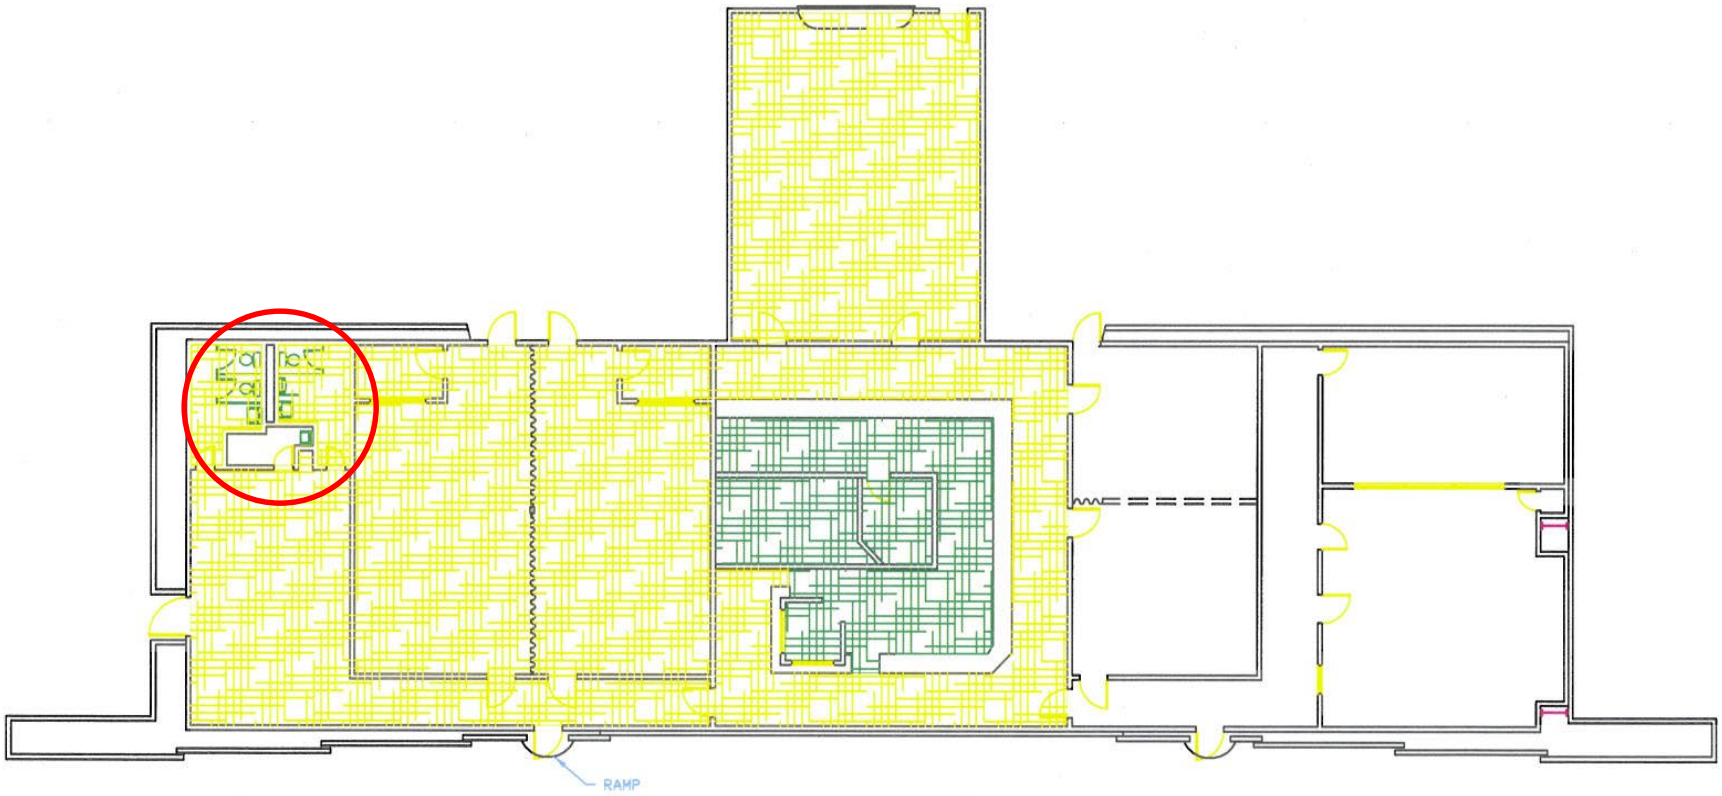

RECORD DRAWING BLDG. 4218
SCALE: 1/8" = 1'-0"

BR 406
CARPET 623
TILE 5638

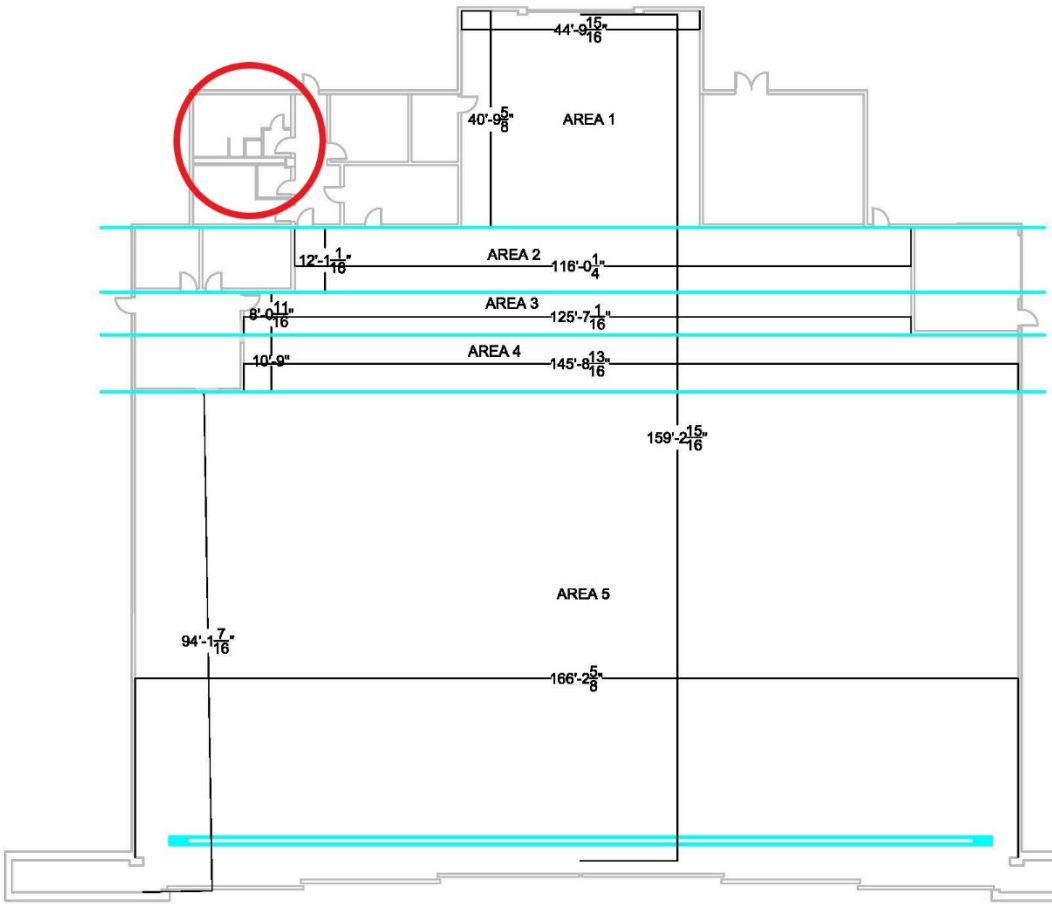

HANGER 4225

OVERALL FLOOR PLAN

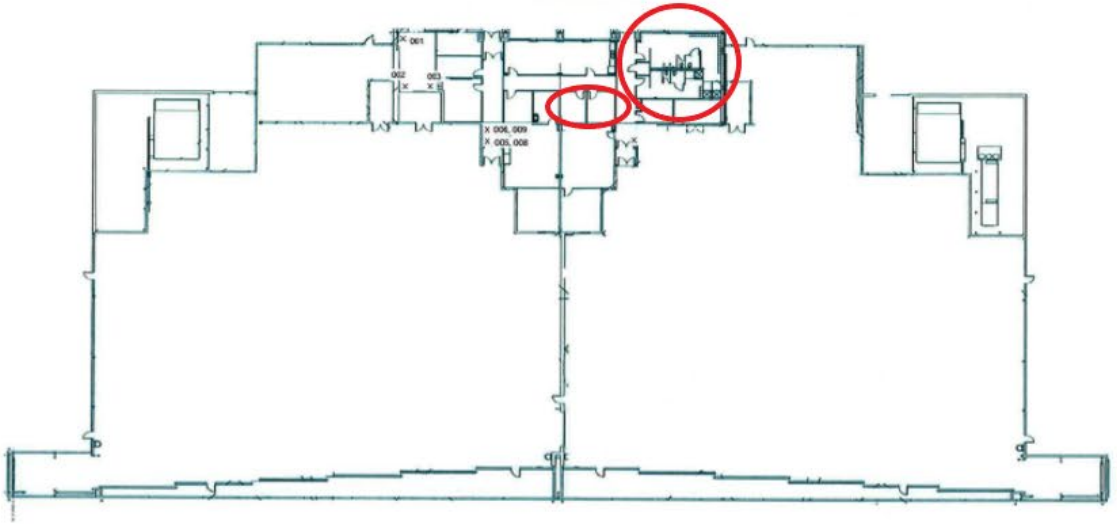

B-4230

BR 596 SqFt
Carpet 874 SqFt

BR 297

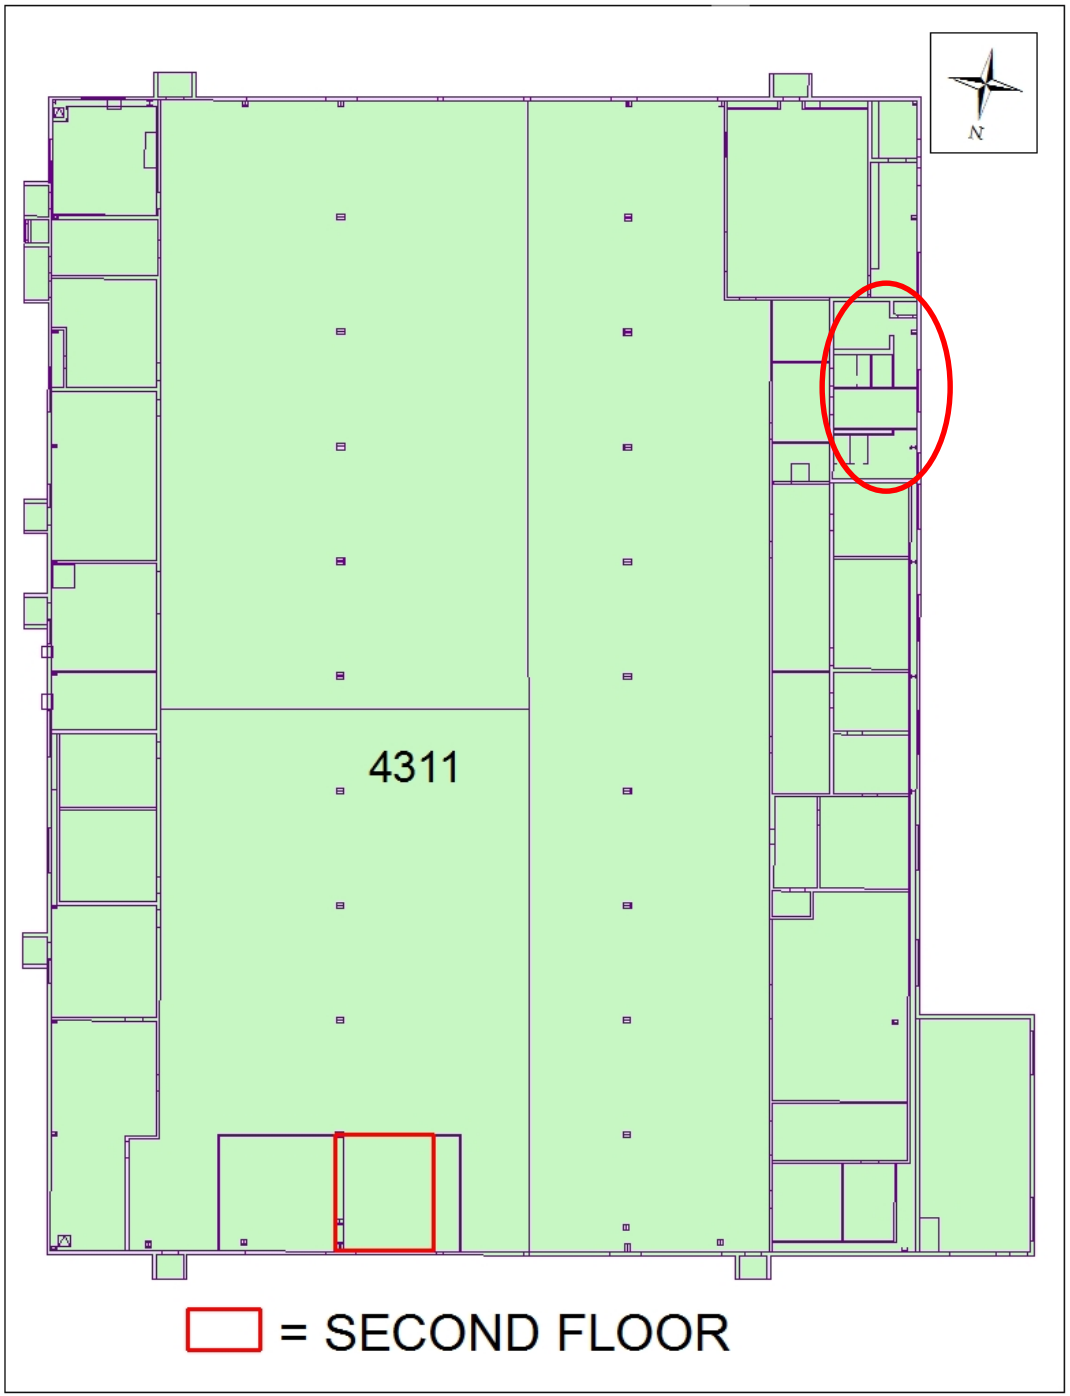

Building 4314 Command Section

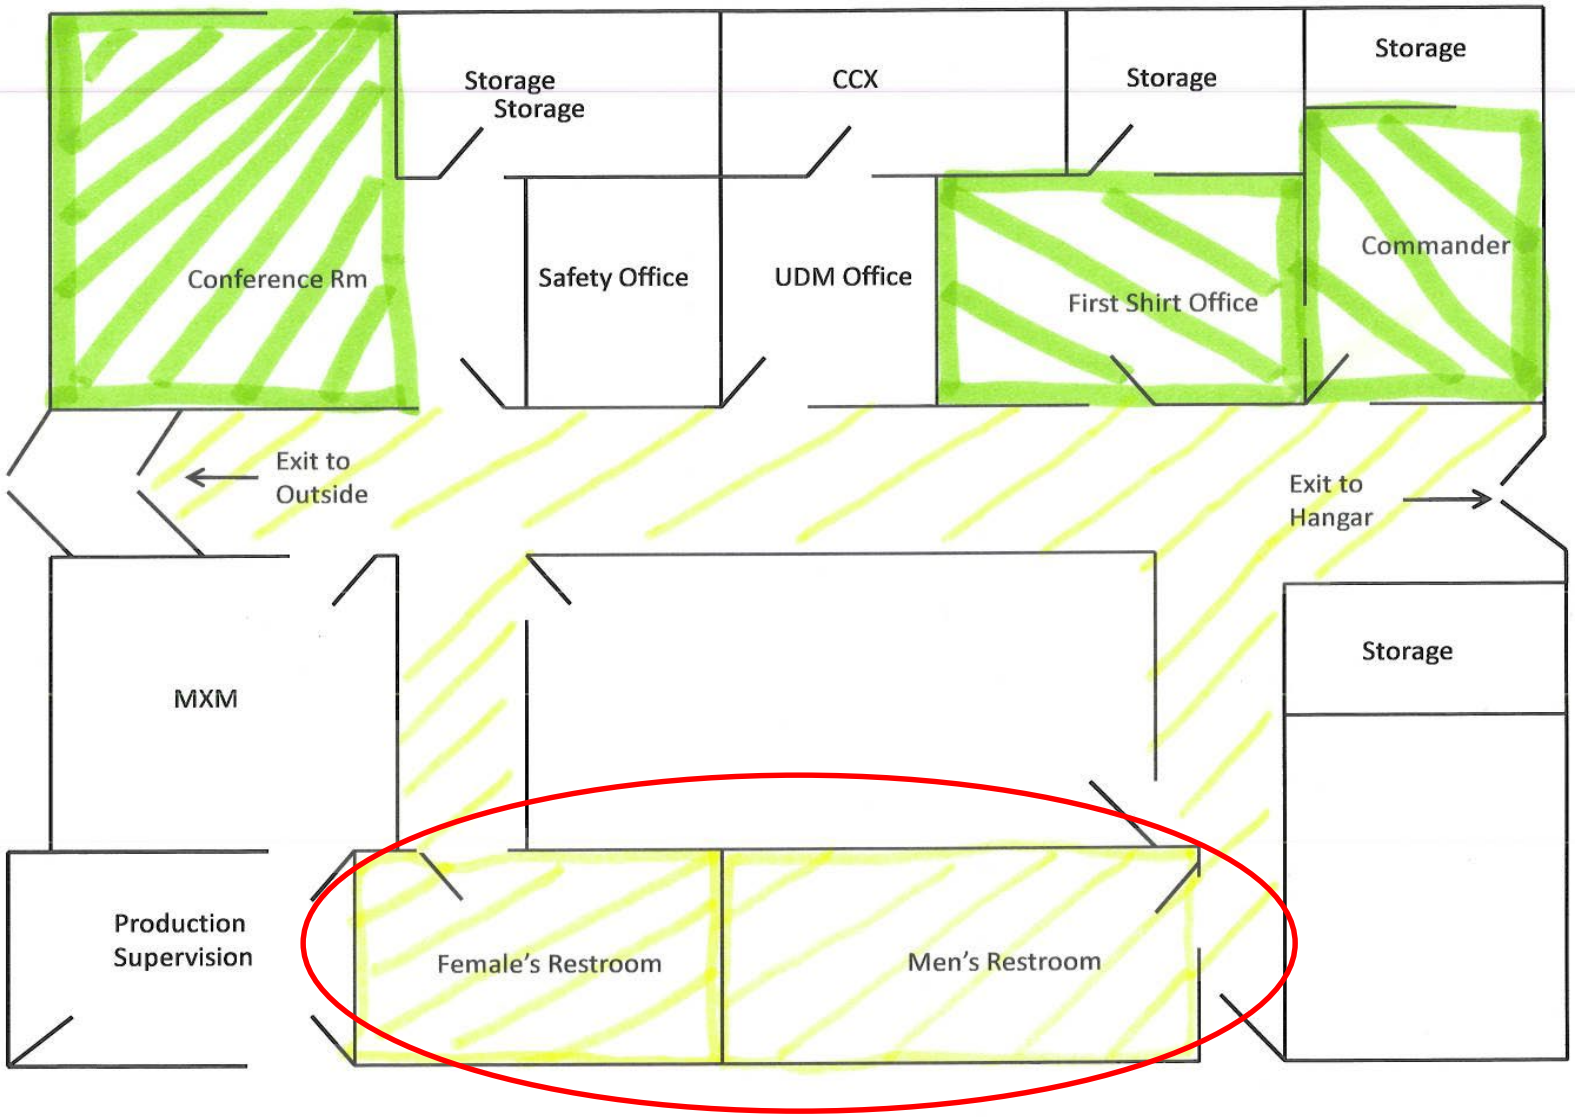

BR 1266
CARPET 1098
TILE 989

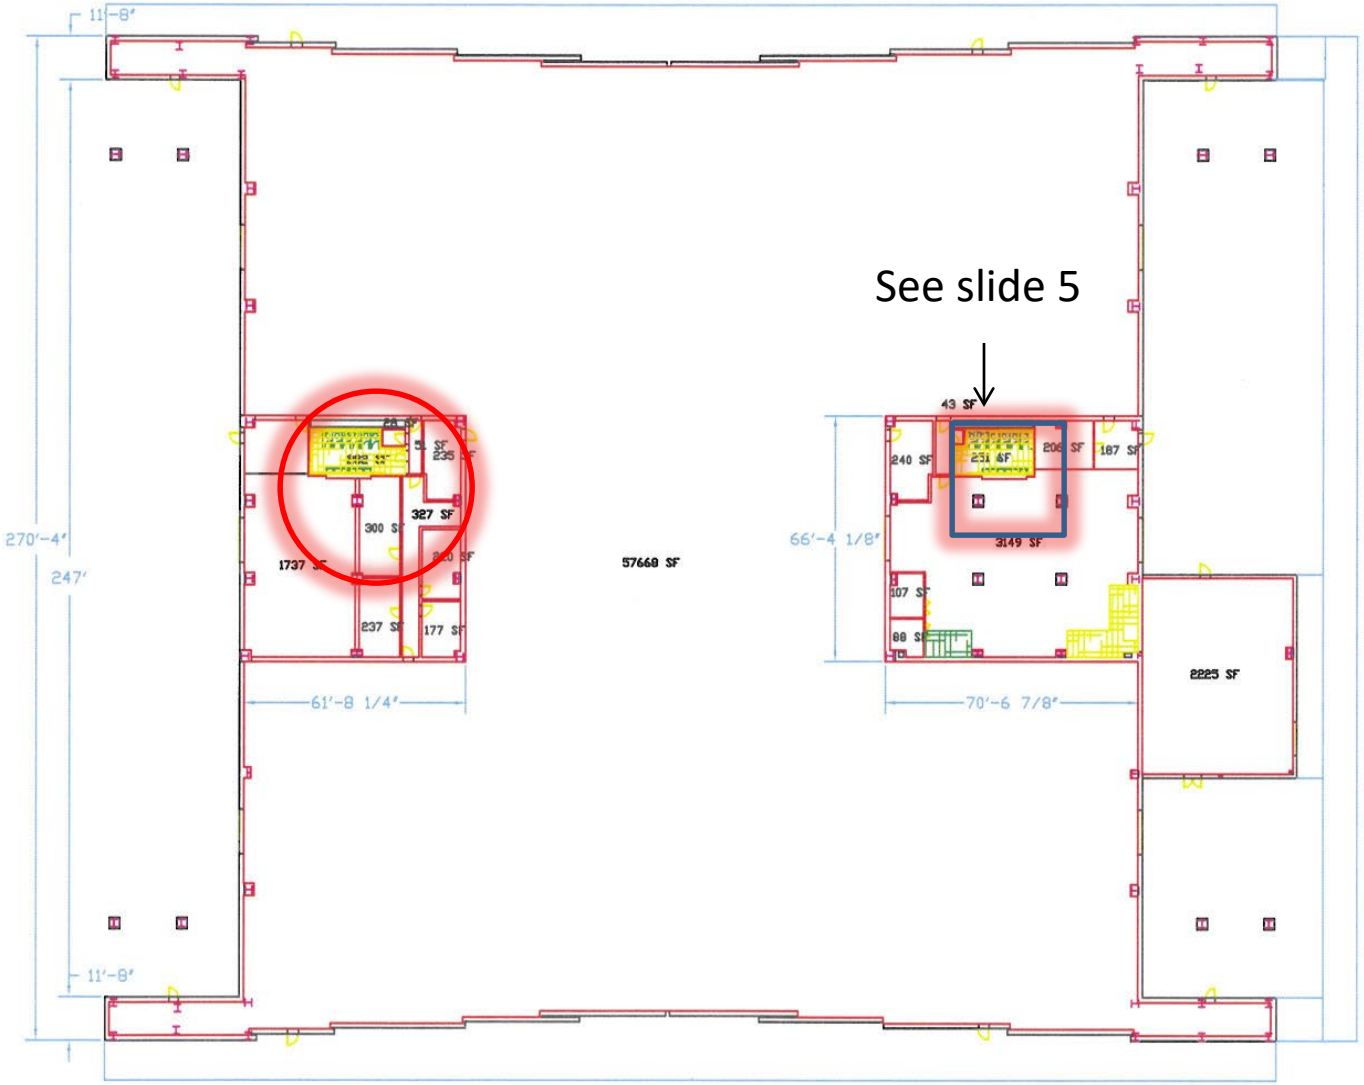

FLOOR PLAN BUILDING 4314

SCALE : 1/16"=1'-0"

NORTH

BR 305
CARPET 2026
TILE 947

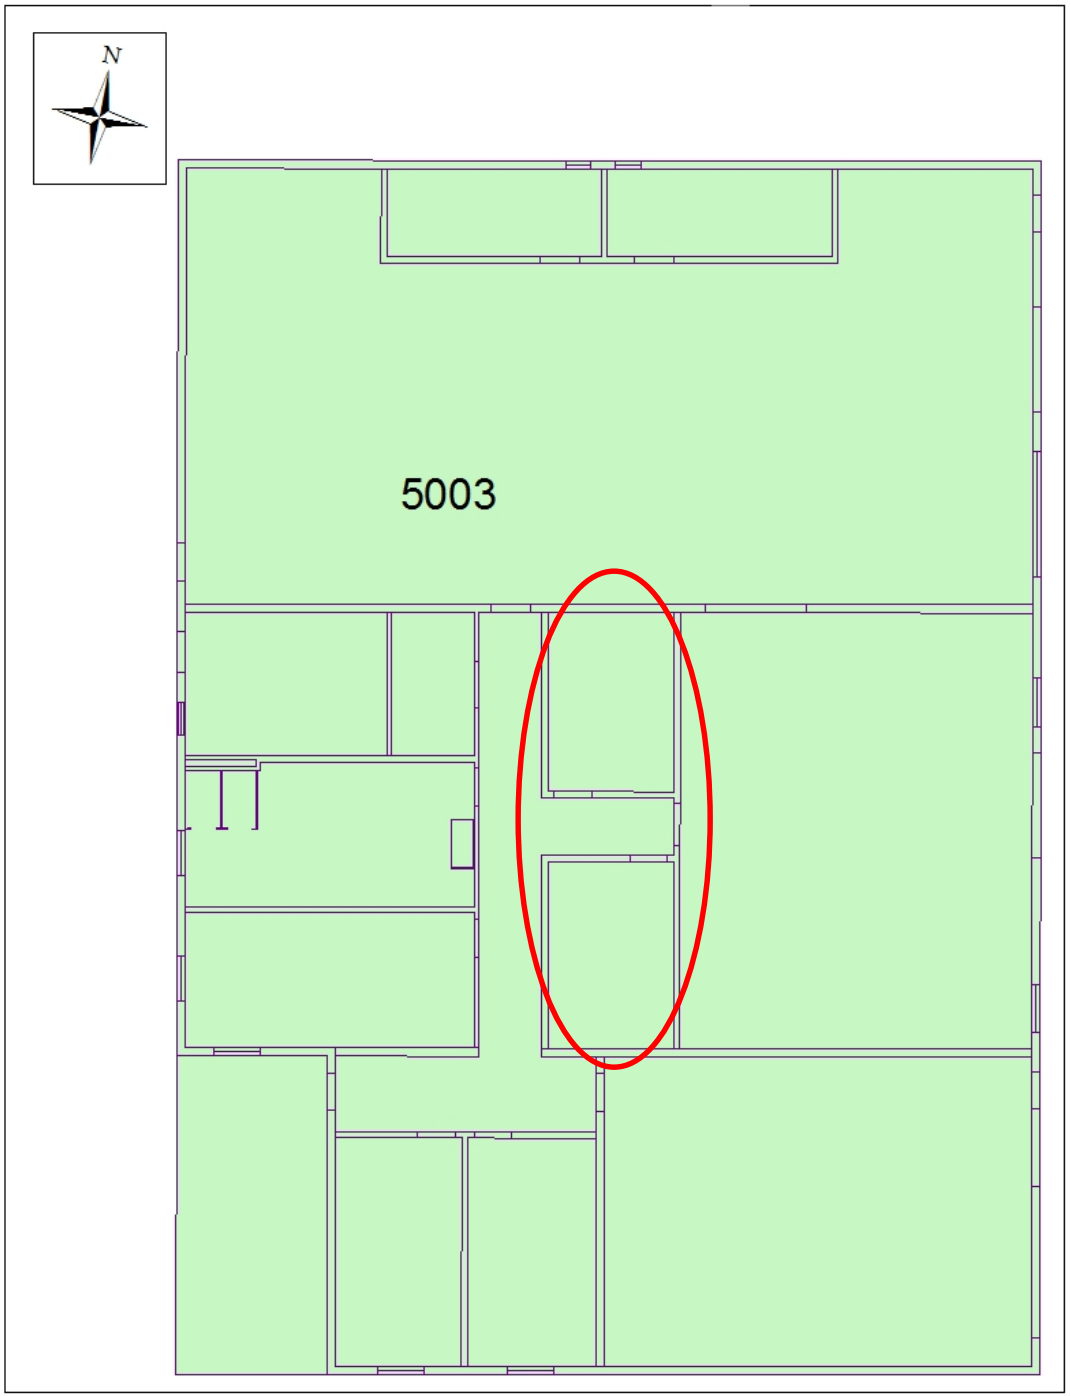

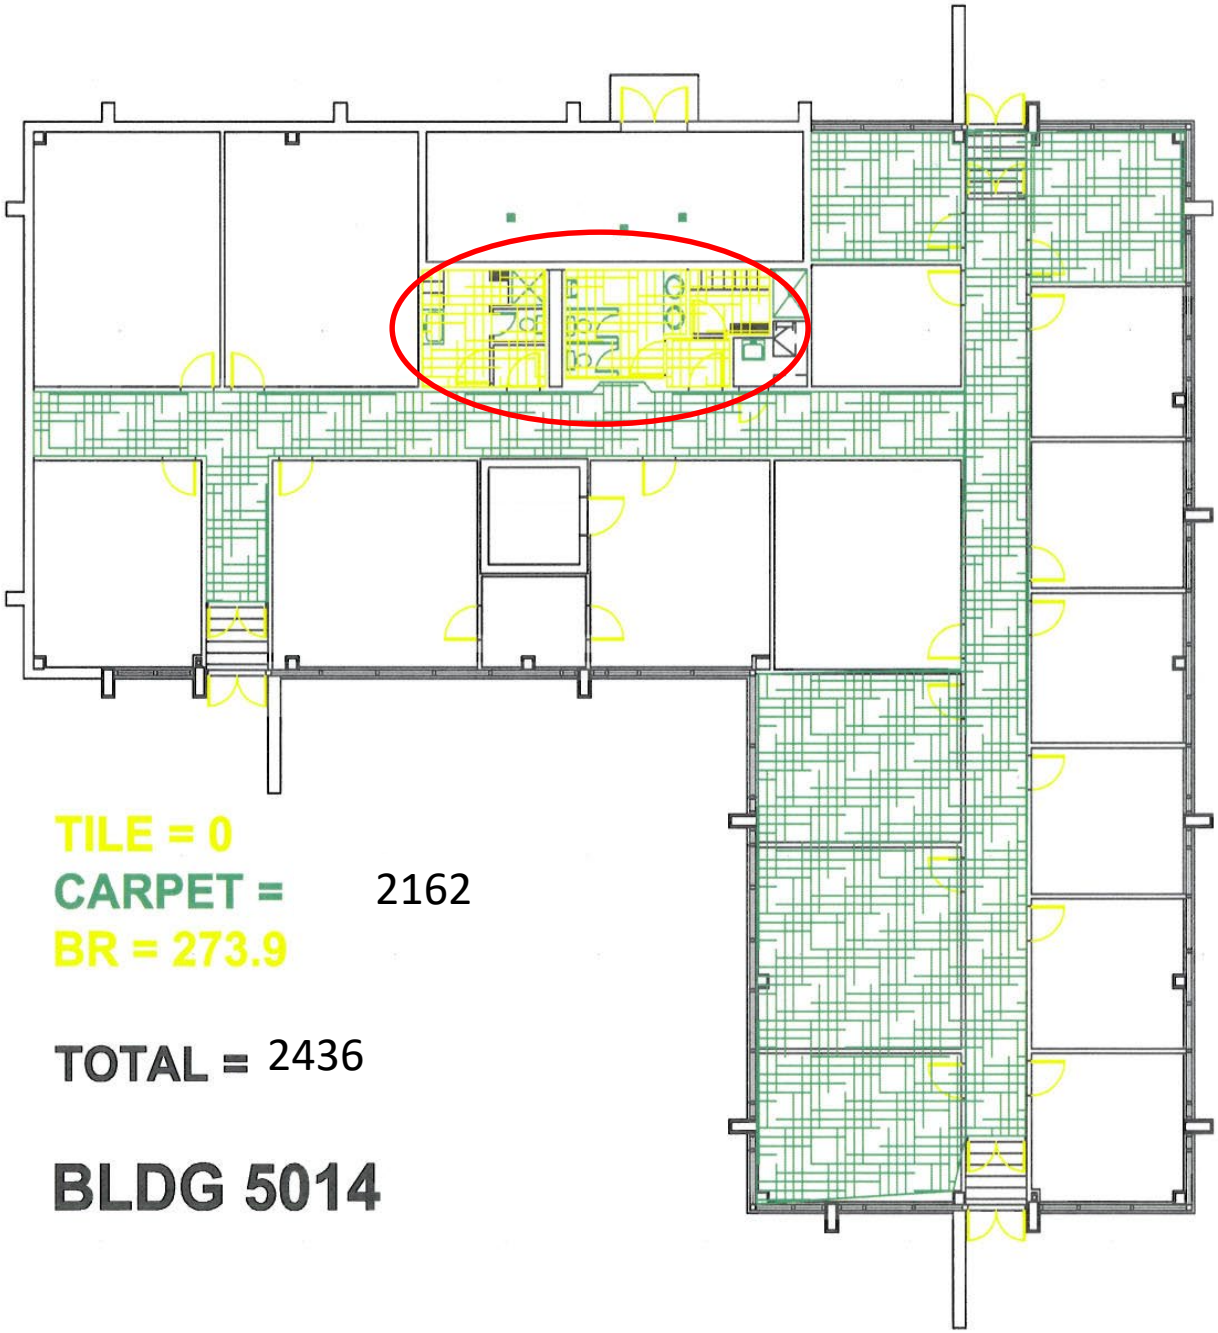

TILE = 0

CARPET = 2162

BR = 273.9

TOTAL = 2436

BLDG 5014

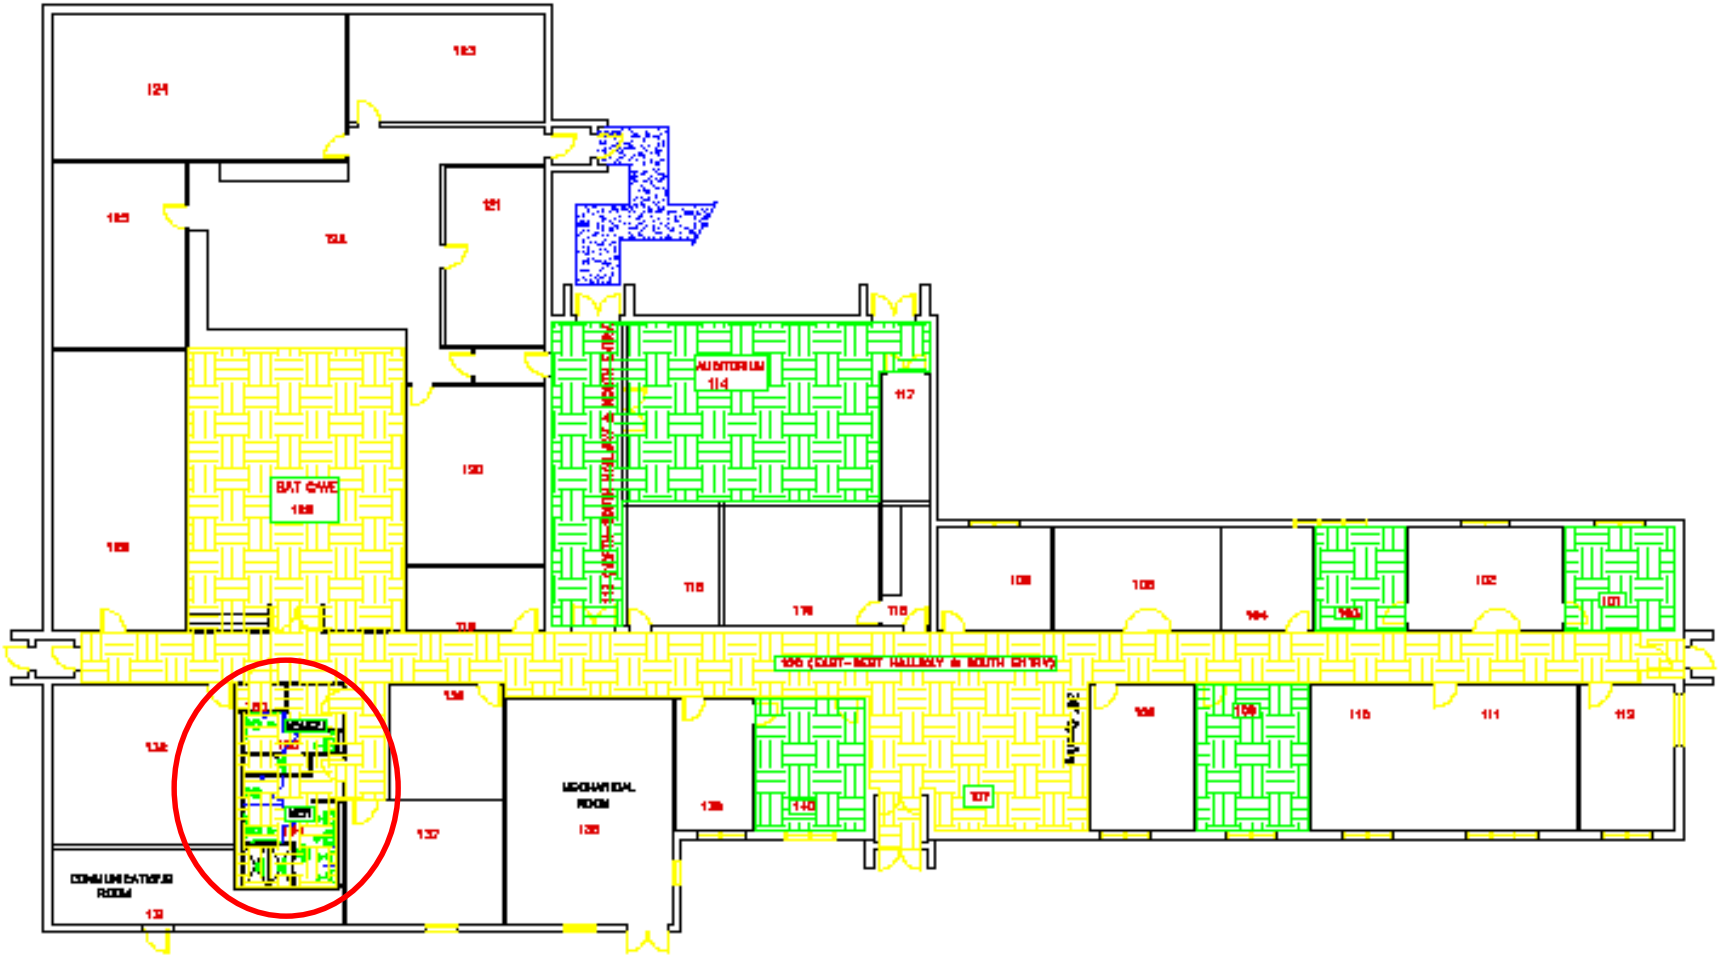

FLOOR PLAN BUILDING 5015

SCALE : 1/8" = 1'

BR 263
CARPET 2086
TILE 3035

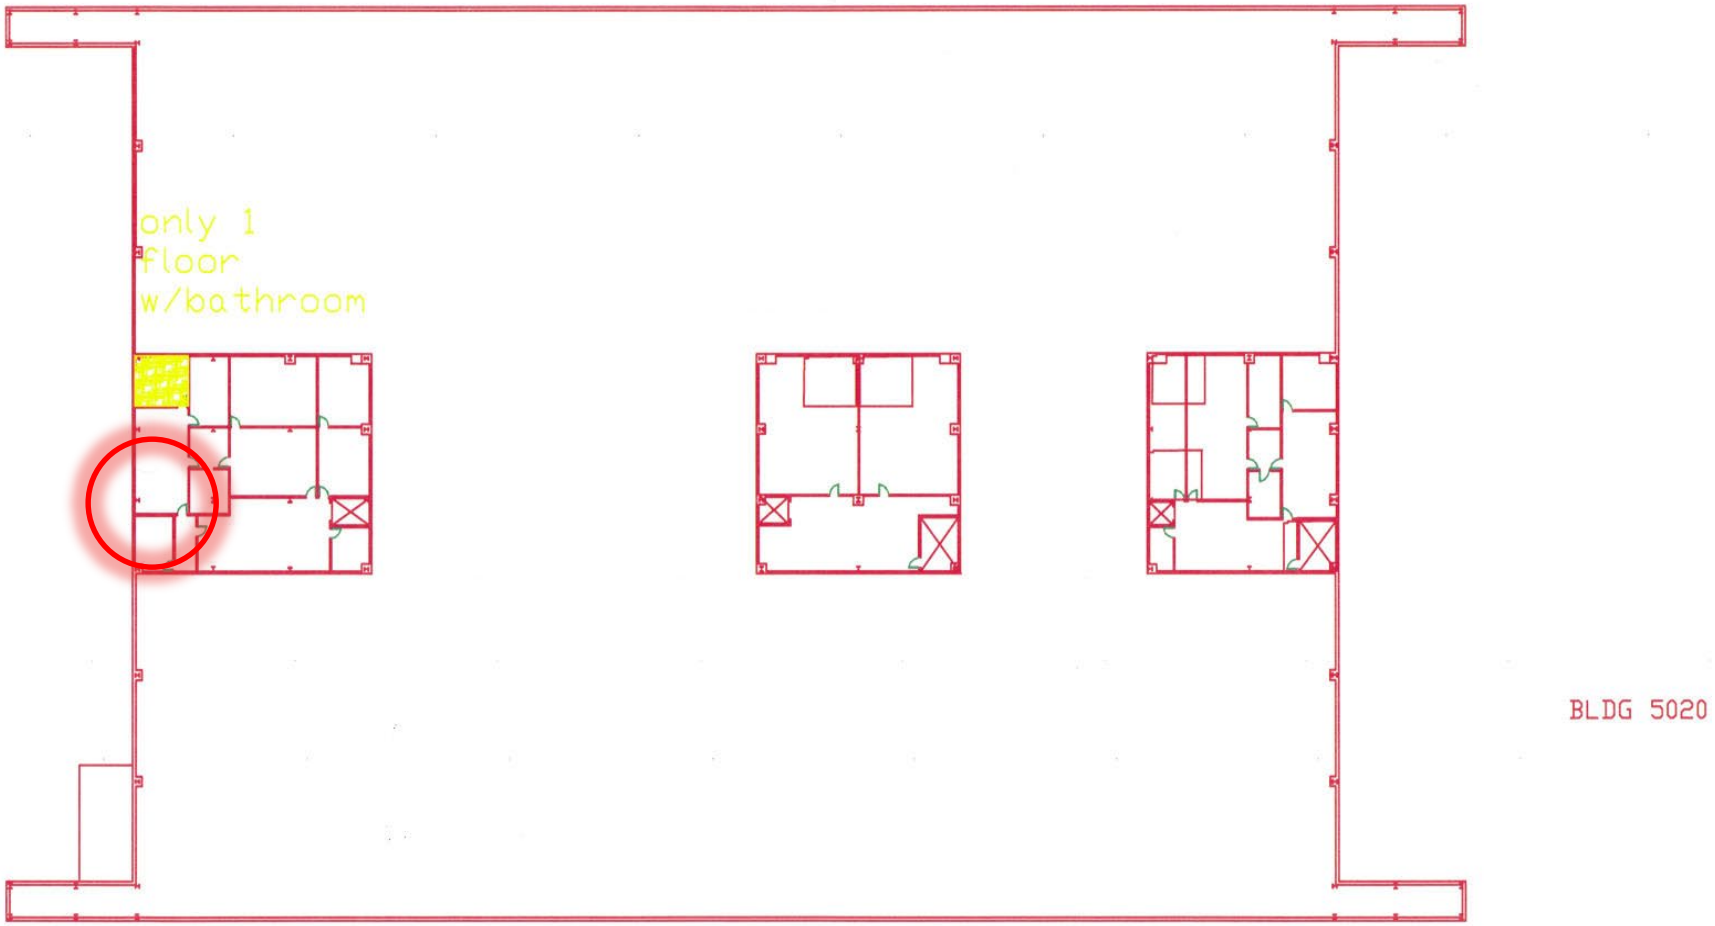

BR 1567
CARPET 1112

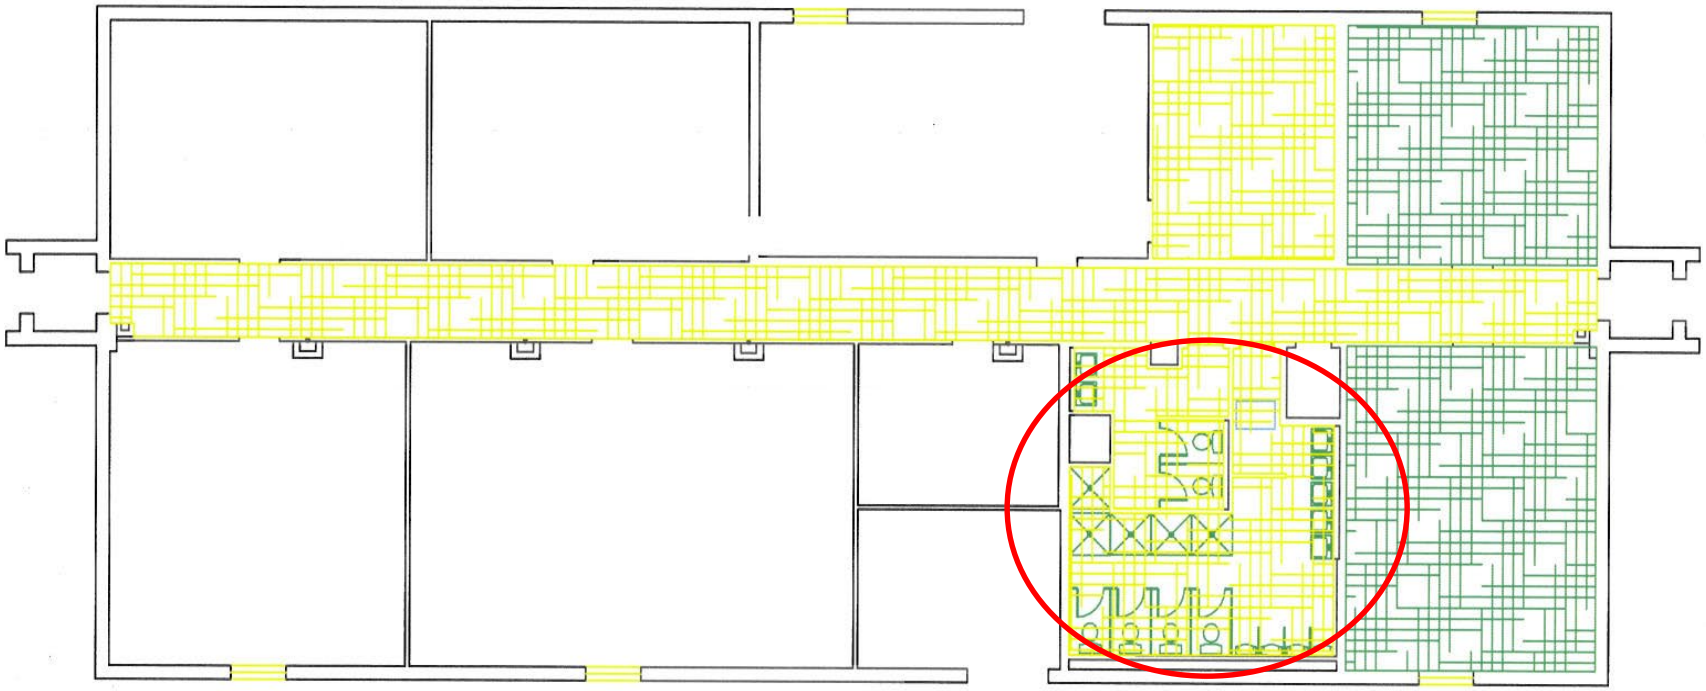

BLDG 5101

TILE = 796.4675

CARPET = 743.0927

BR 380.2975

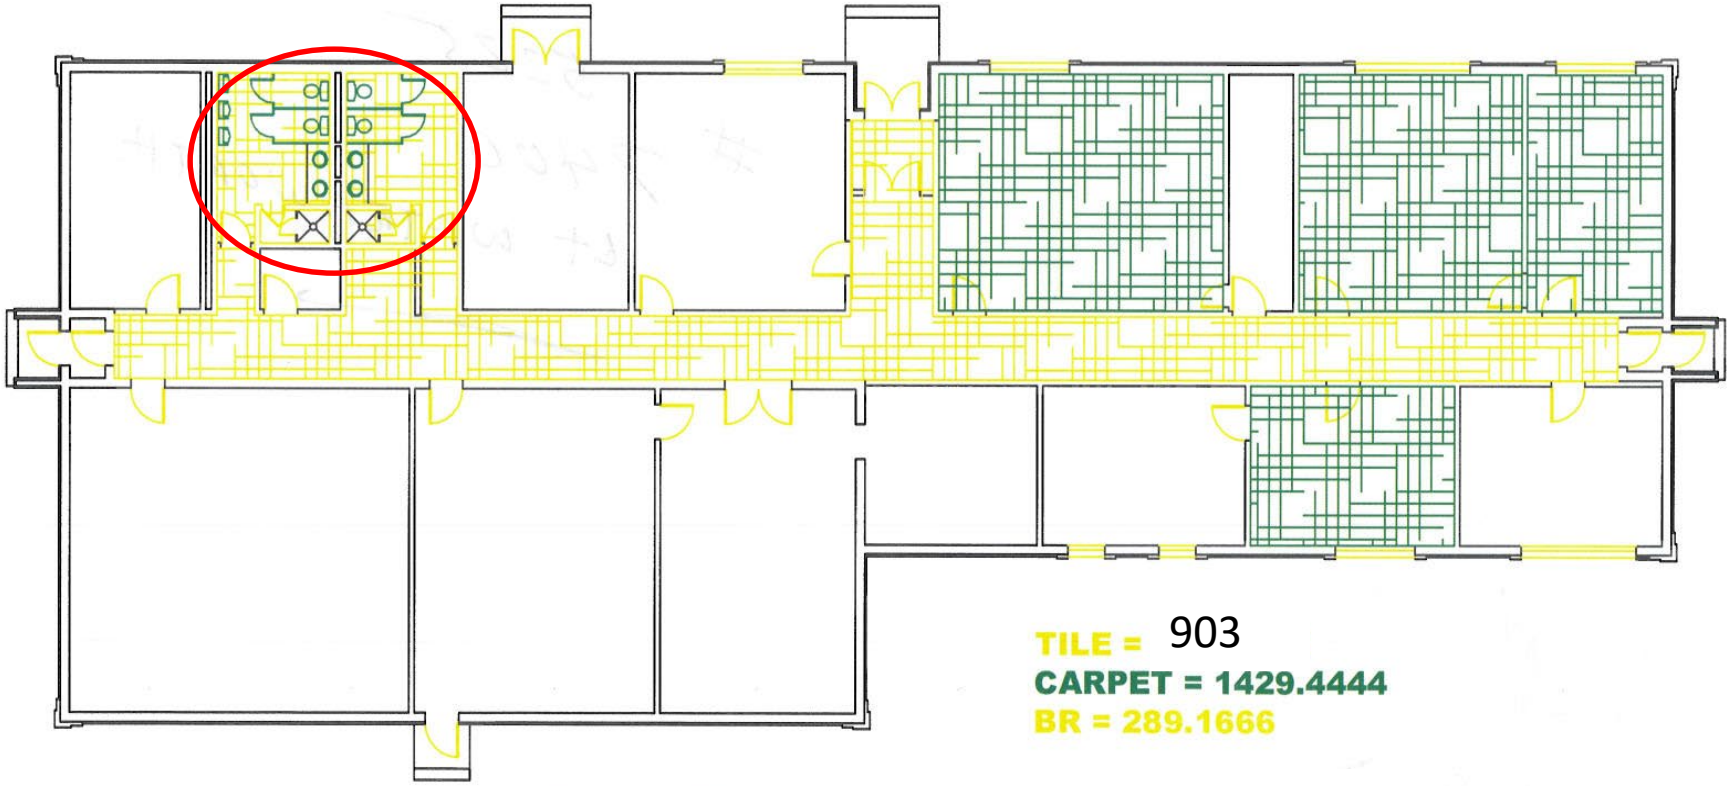

BLDG 5102

CMS

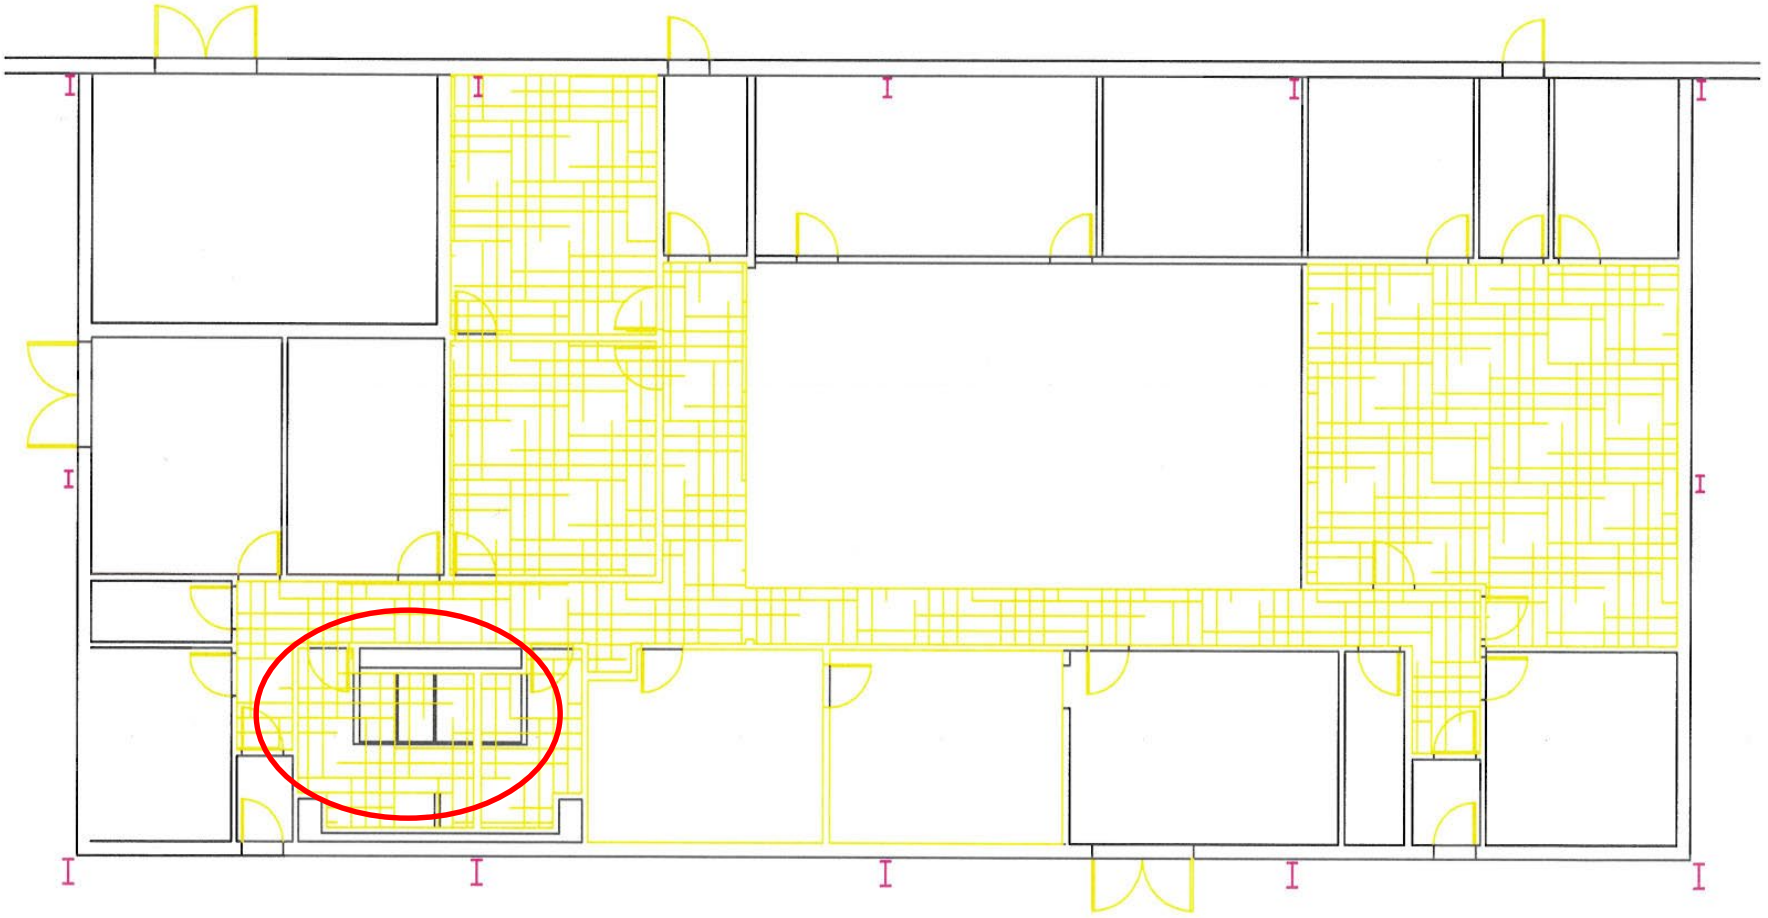

BR 454

TILE 1755

BLDG 5110

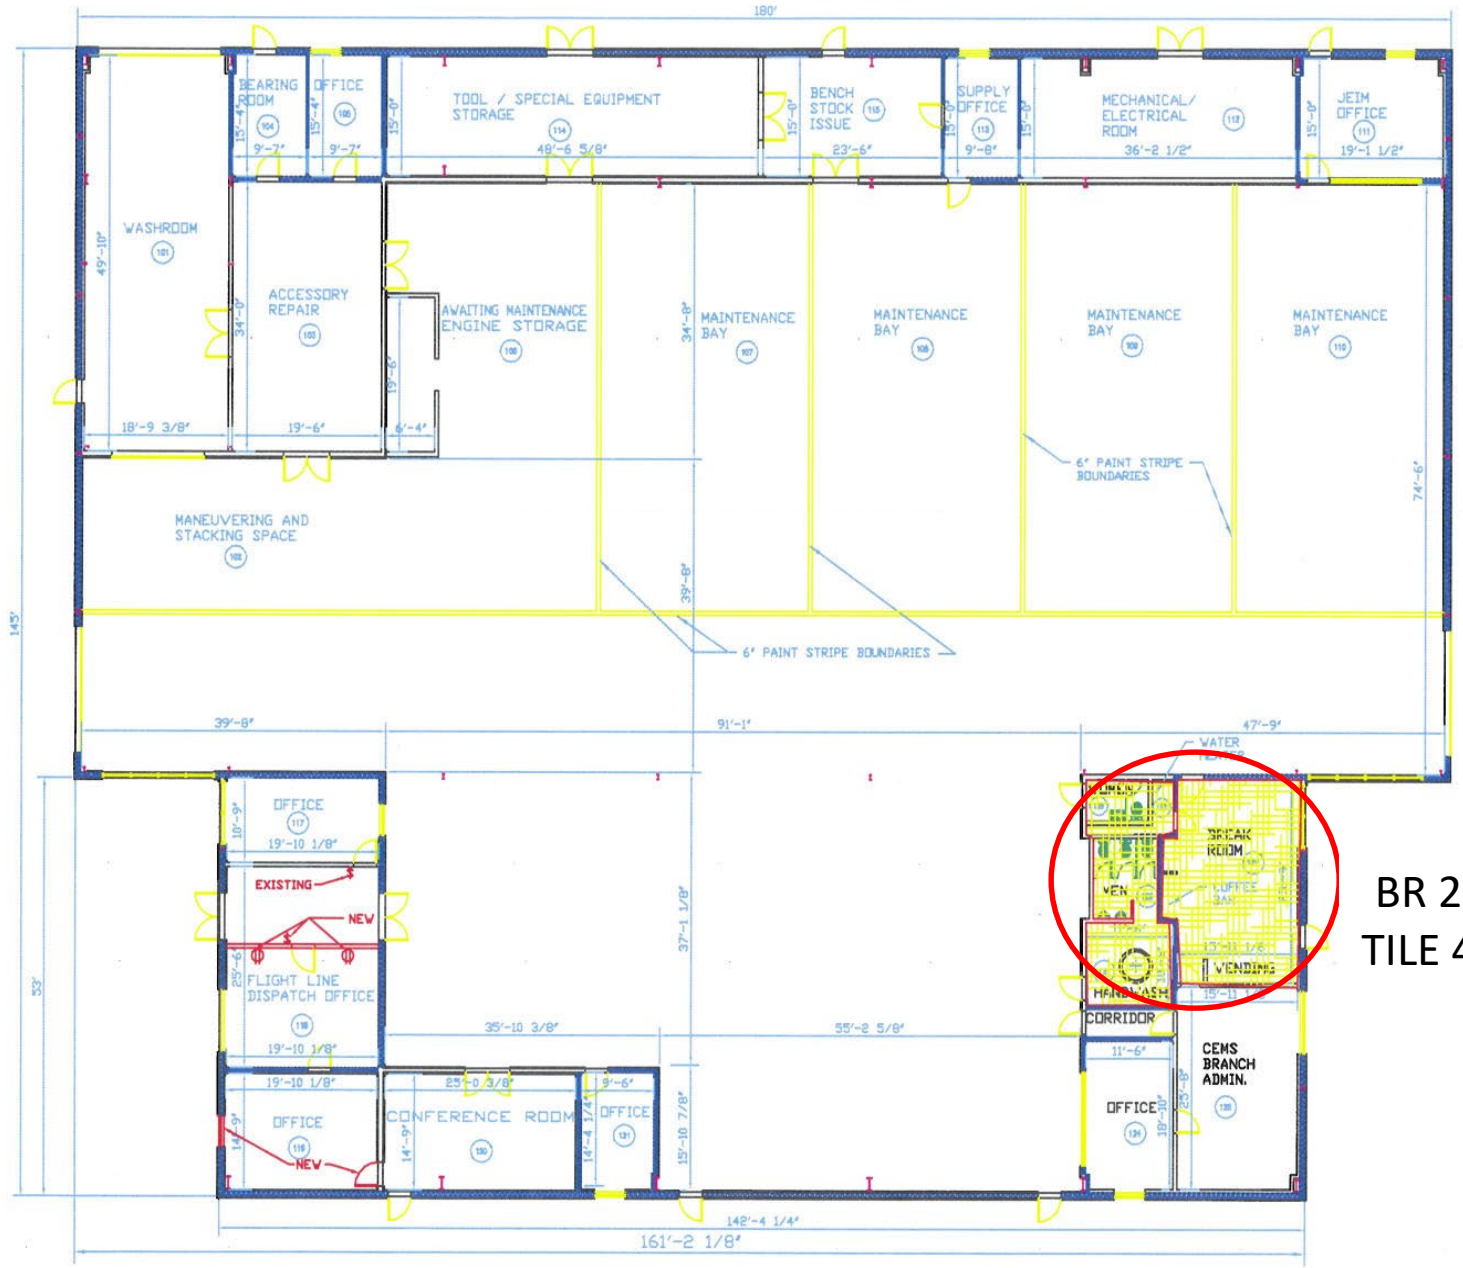

FLOOR PLAN BUILDING 5111

SCALE: 1/8" = 1'-0"

BR 255
TILE 433

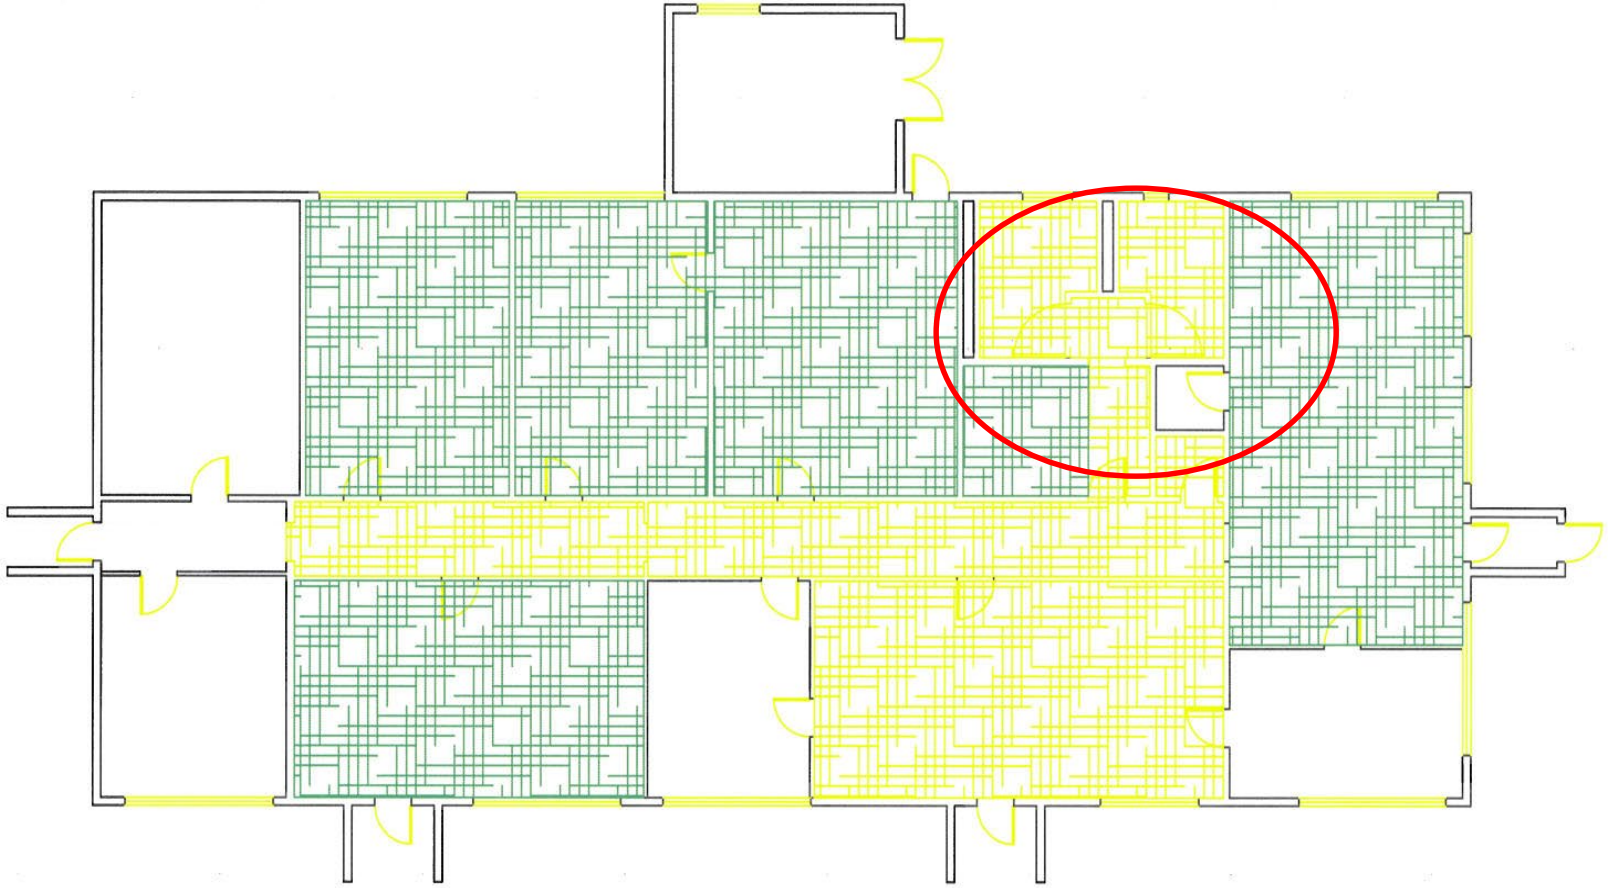

BLDG 5115

BR 216
CARPET 1486
TILE 510

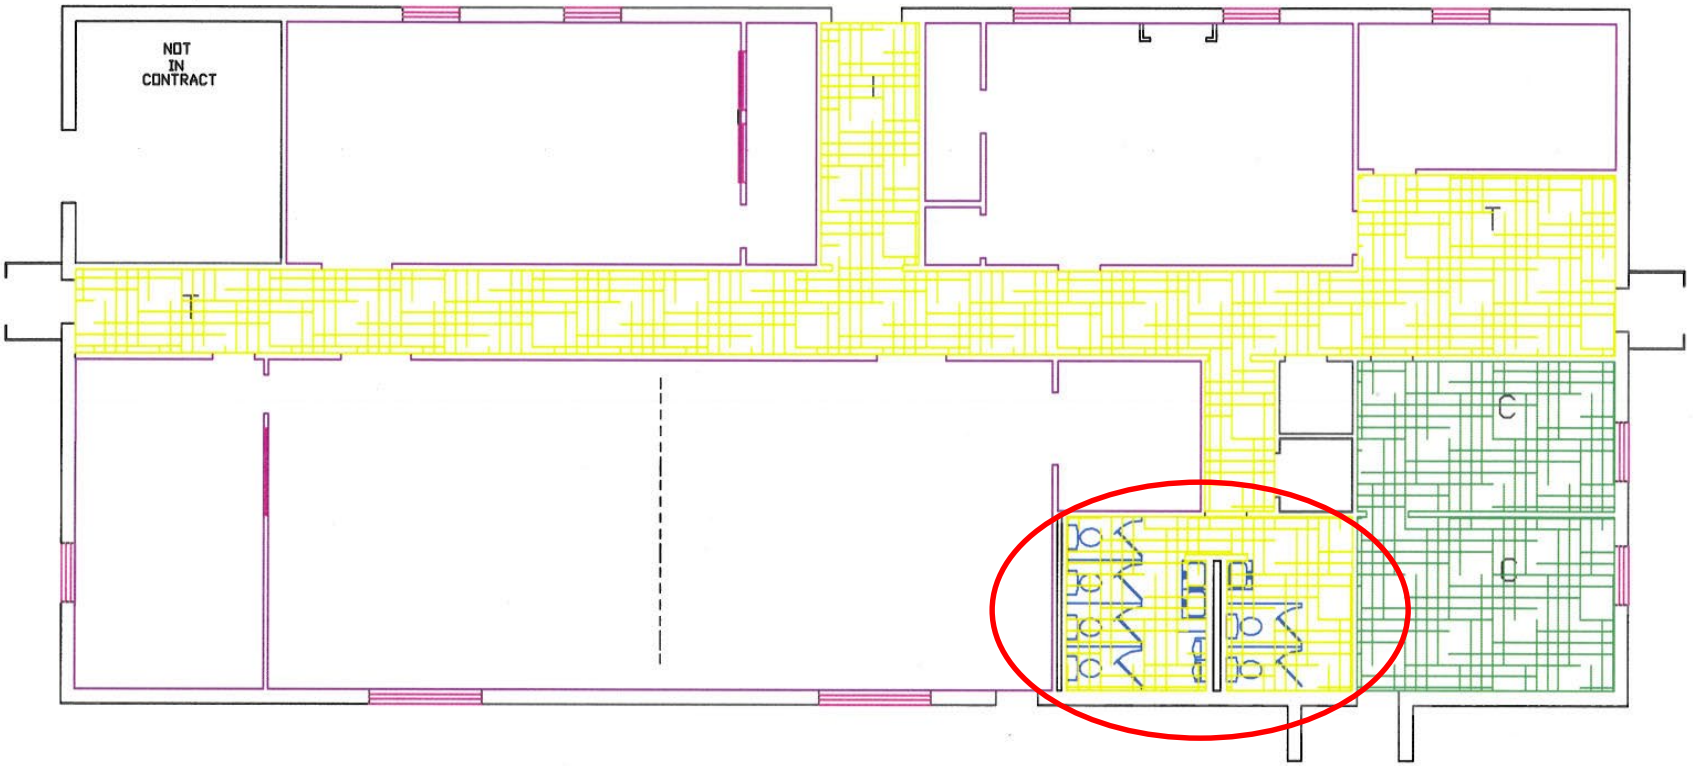

B5201

Tile = 928.3641

Carpet = 415.9208

BR = 230.6293

Total = 1574.9142

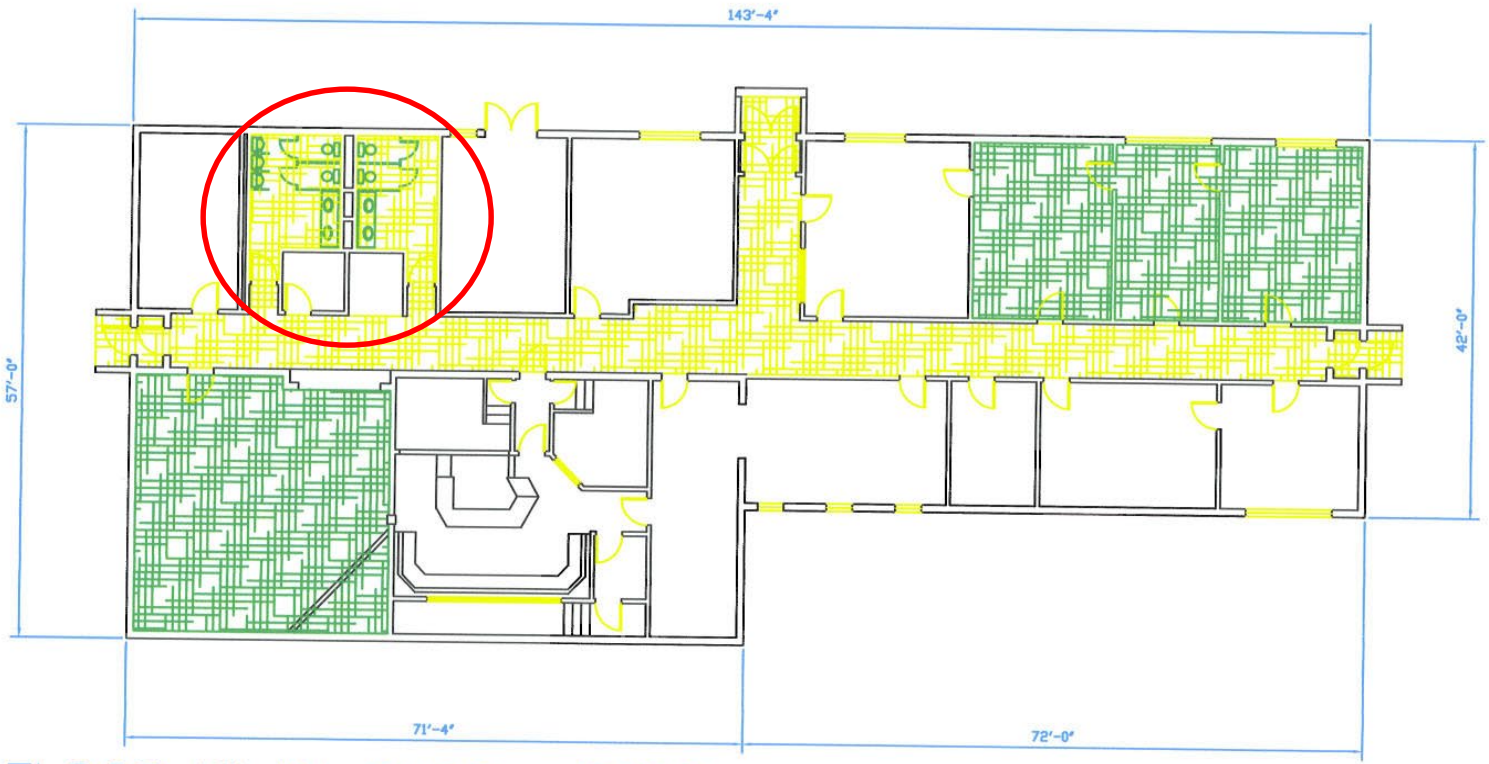

FLOOR PLAN BLDG. 5202

SCALE: _"=1'-0"

BR 273
CARPET 858
TILE 1112

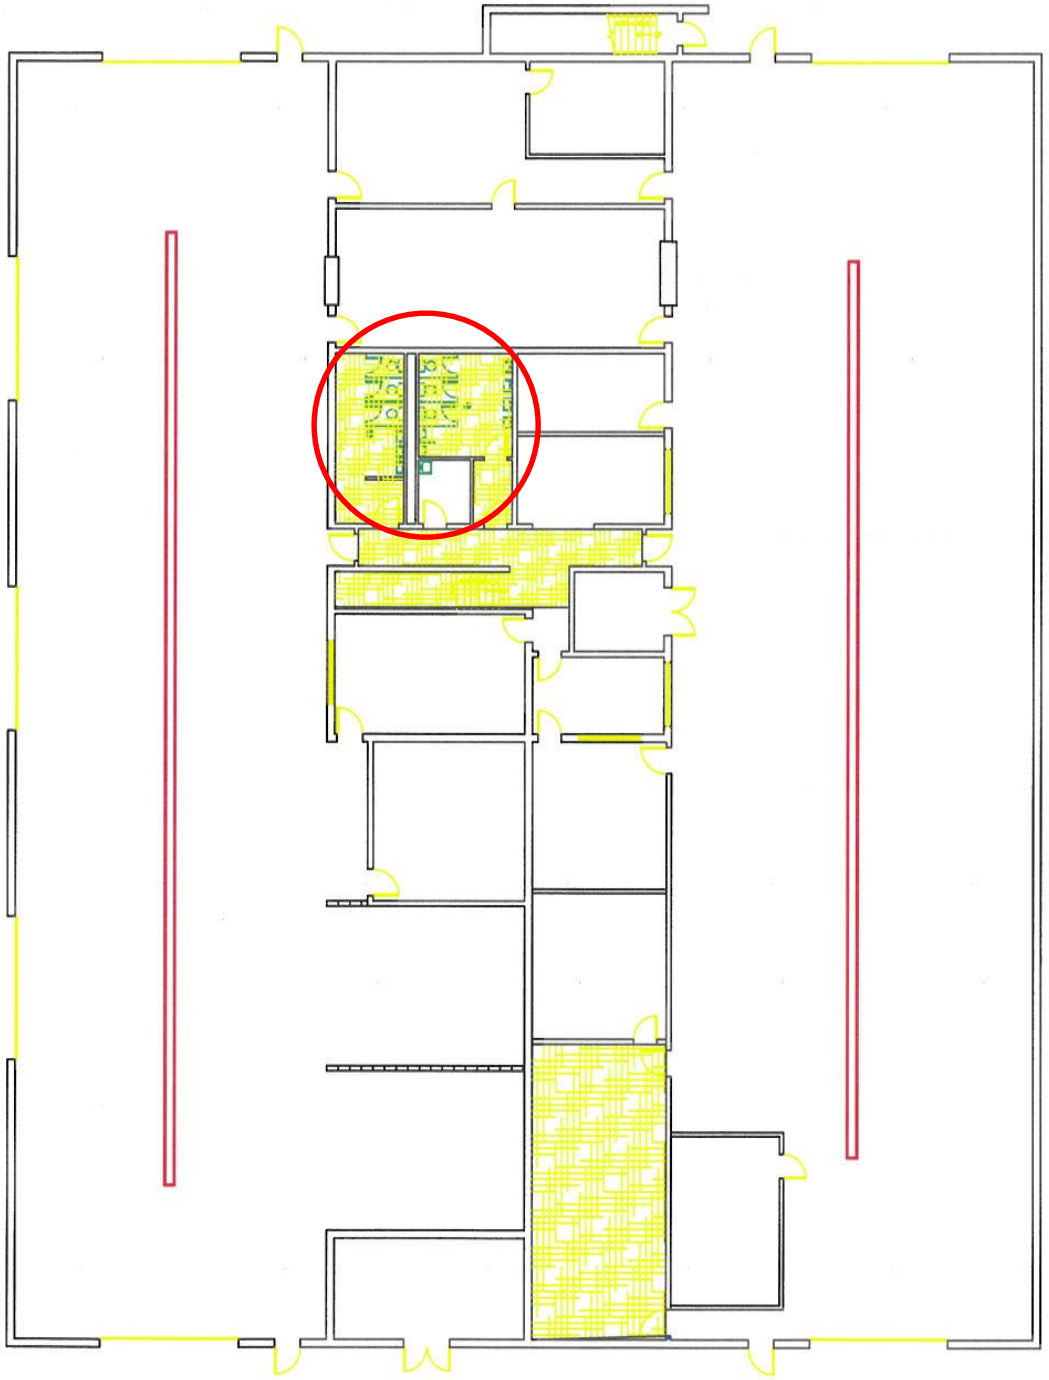

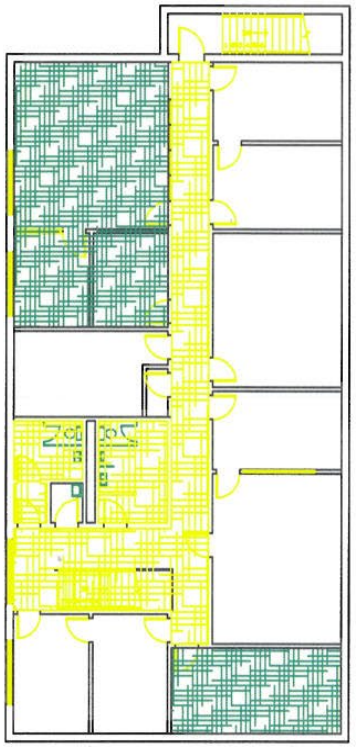

SECOND FLOOR PLAN

CARPET : 903
TILE : 1510
BR : 593

TOTAL : 3006

BLDG 5204

FIRST FLOOR PLAN

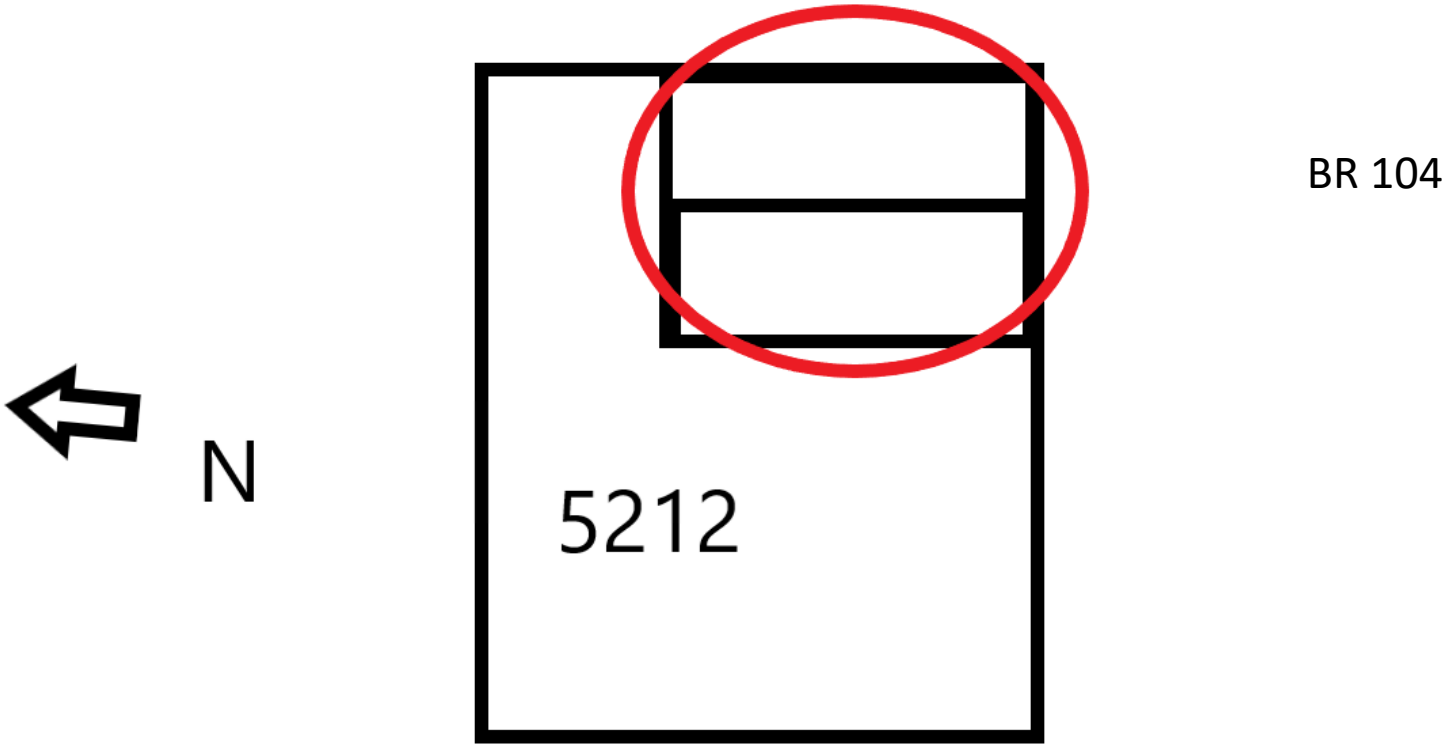
N
5212
BR 104

BR 1330
CARPET 4179
TILE 3122

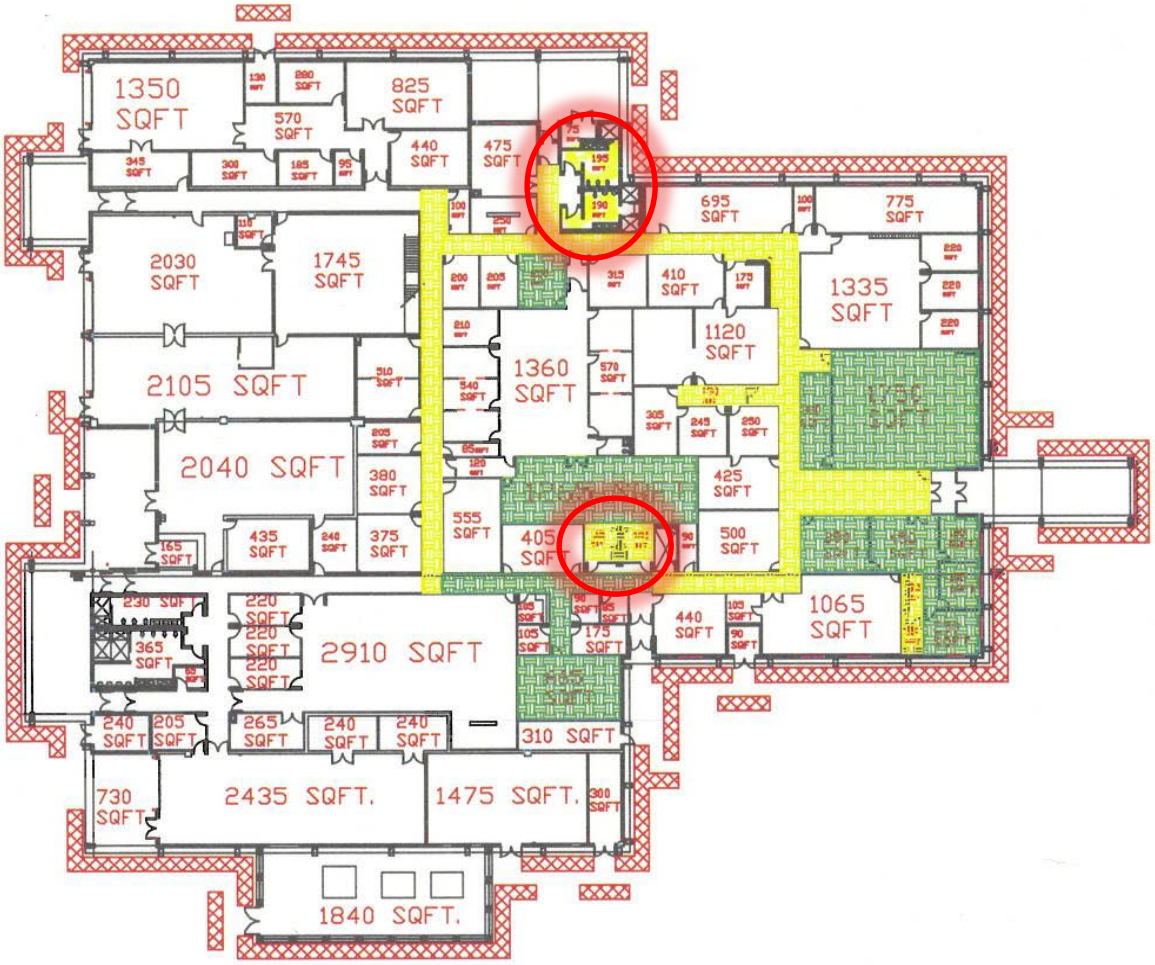

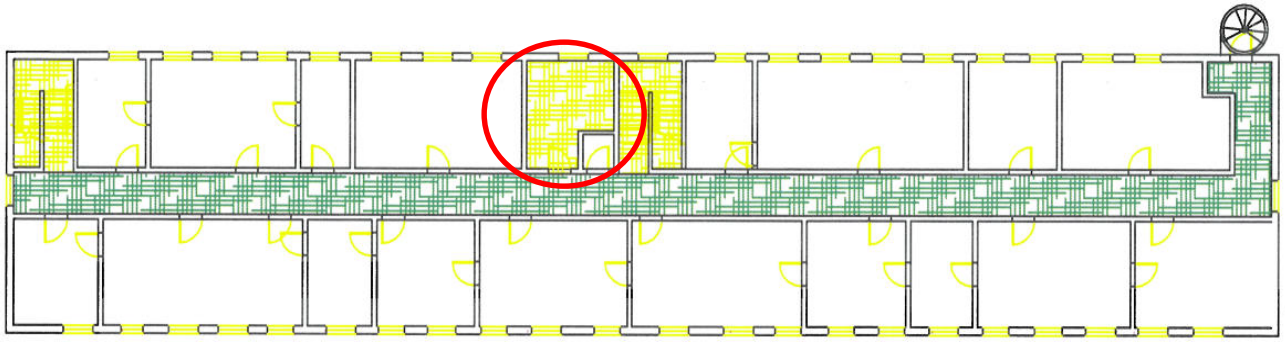

SECOND FLOOR BLDG. 6015

LEVEL 2: BASIC
TILE = 225
CARPET = 994
BR = 143

TOTAL = 1362

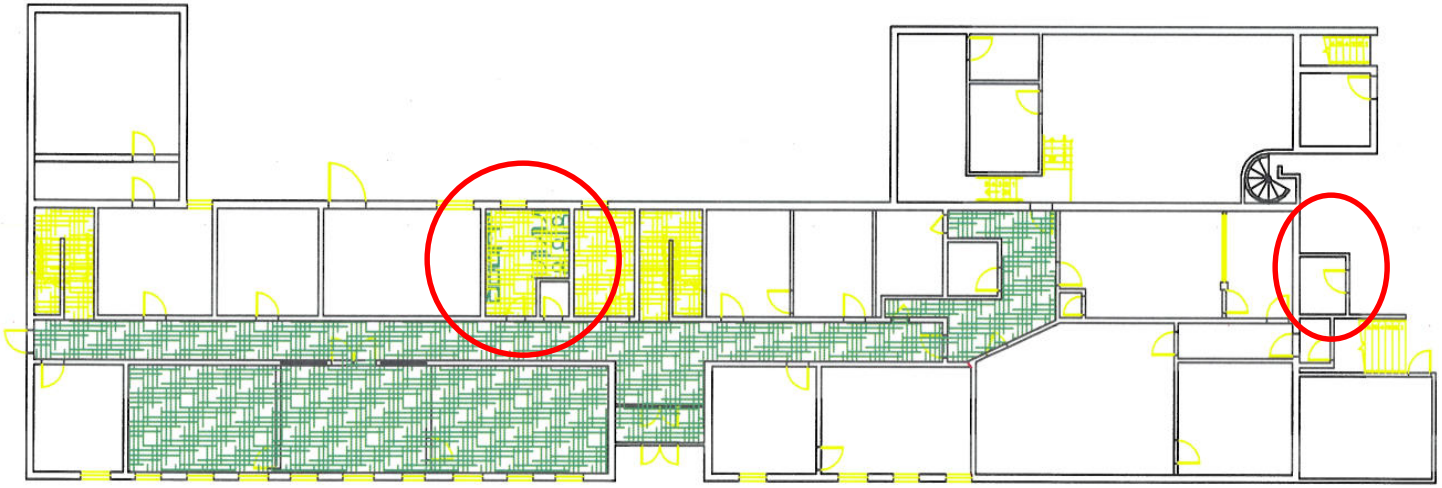

FIRST FLOOR BLDG. 6015

LEVEL 1: PRESTIGE
CARPET = 1896
BR = 250

TOTAL = 2146

Under RENOVATION,
Will be added when
complete

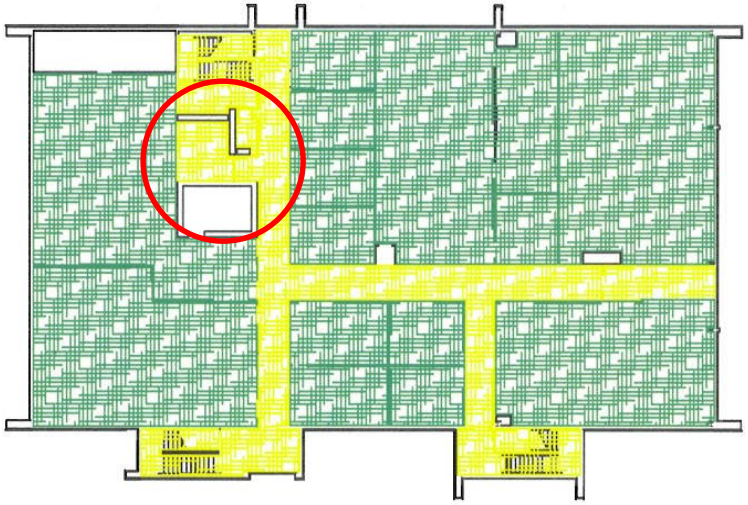

FLOOR PLAN BLDG. 6030 A
2ND FLOOR

Tile total = 1495.18
Carpet = 2758.34
BR = 191.60

Total = 4445.12

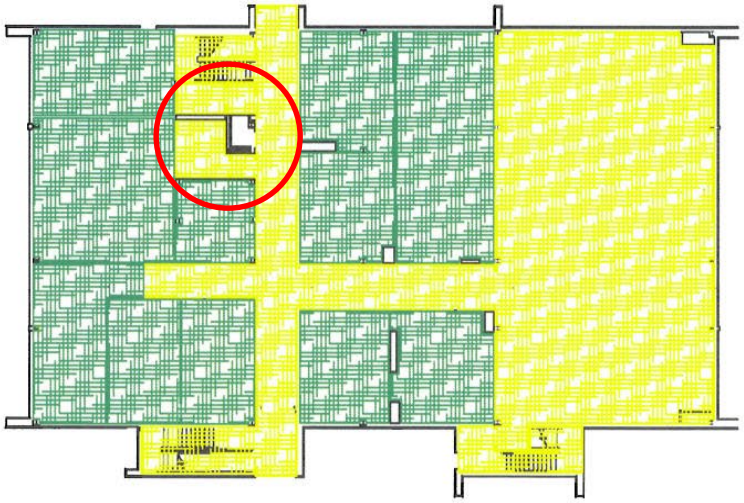

FLOOR PLAN BLDG. 6030 A
IST FLOOR

Tile total =3951.62
Carpet = 4445.4028
BR = 596.41

Total = 8993.4328

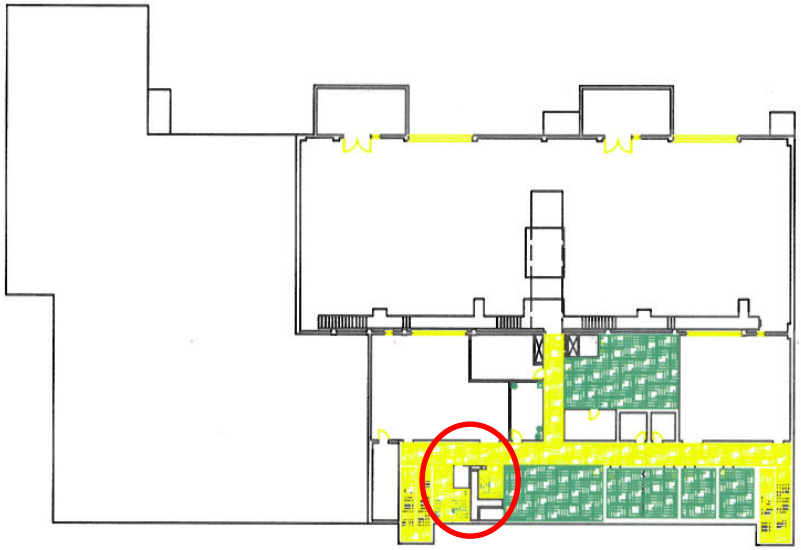

SECOND FLOOR
FLOOR PLAN BLDG. 6030B
SCALE: 1/8" = 1'-0"

Tile total = 1203.4409
Carpet = 1670.0197
BR = 191.1783

Total = 3064.6389

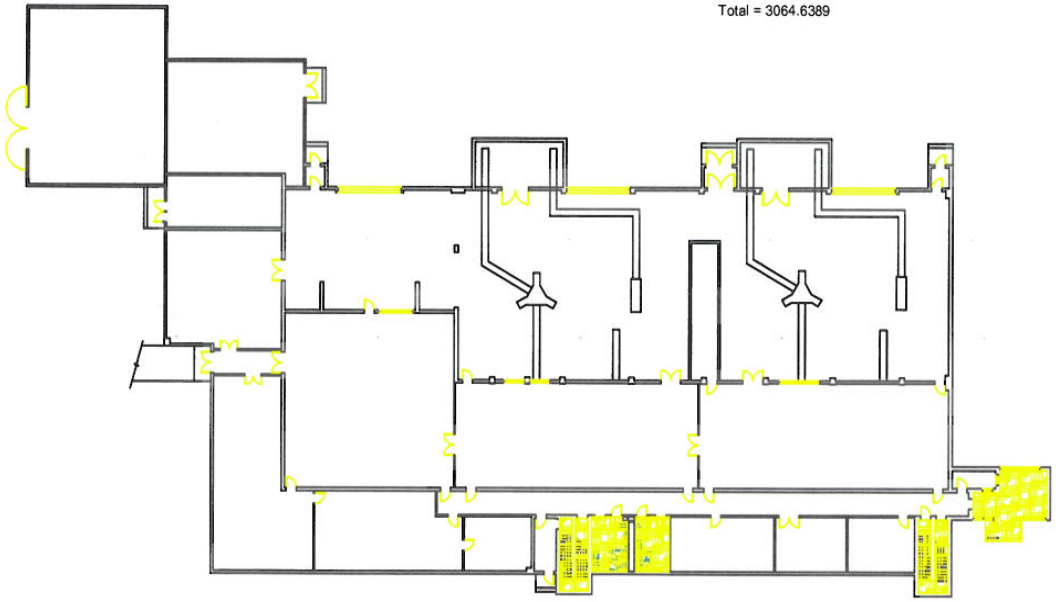

FIRST FLOOR
FLOOR PLAN BLDG. 6030B
SCALE: 1/8" = 1'-0"

Tile = 650.15
BR = 314.29
Carpet = 0
Total = 964.44

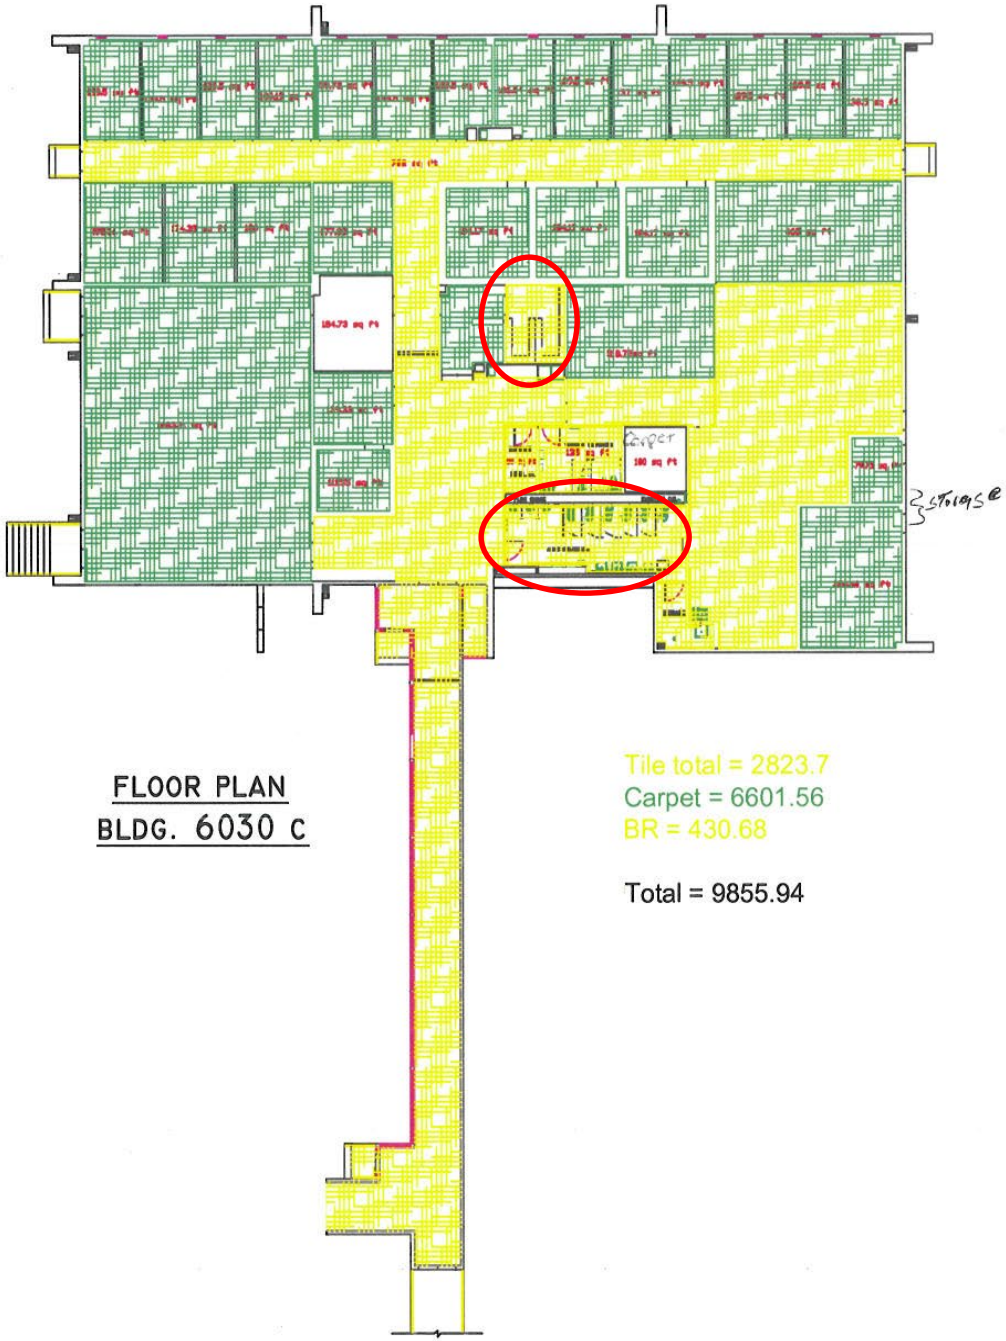

FLOOR PLAN
BLDG. 6030 C

Tile total = 2823.7
Carpet = 6601.56
BR = 430.68

Total = 9855.94

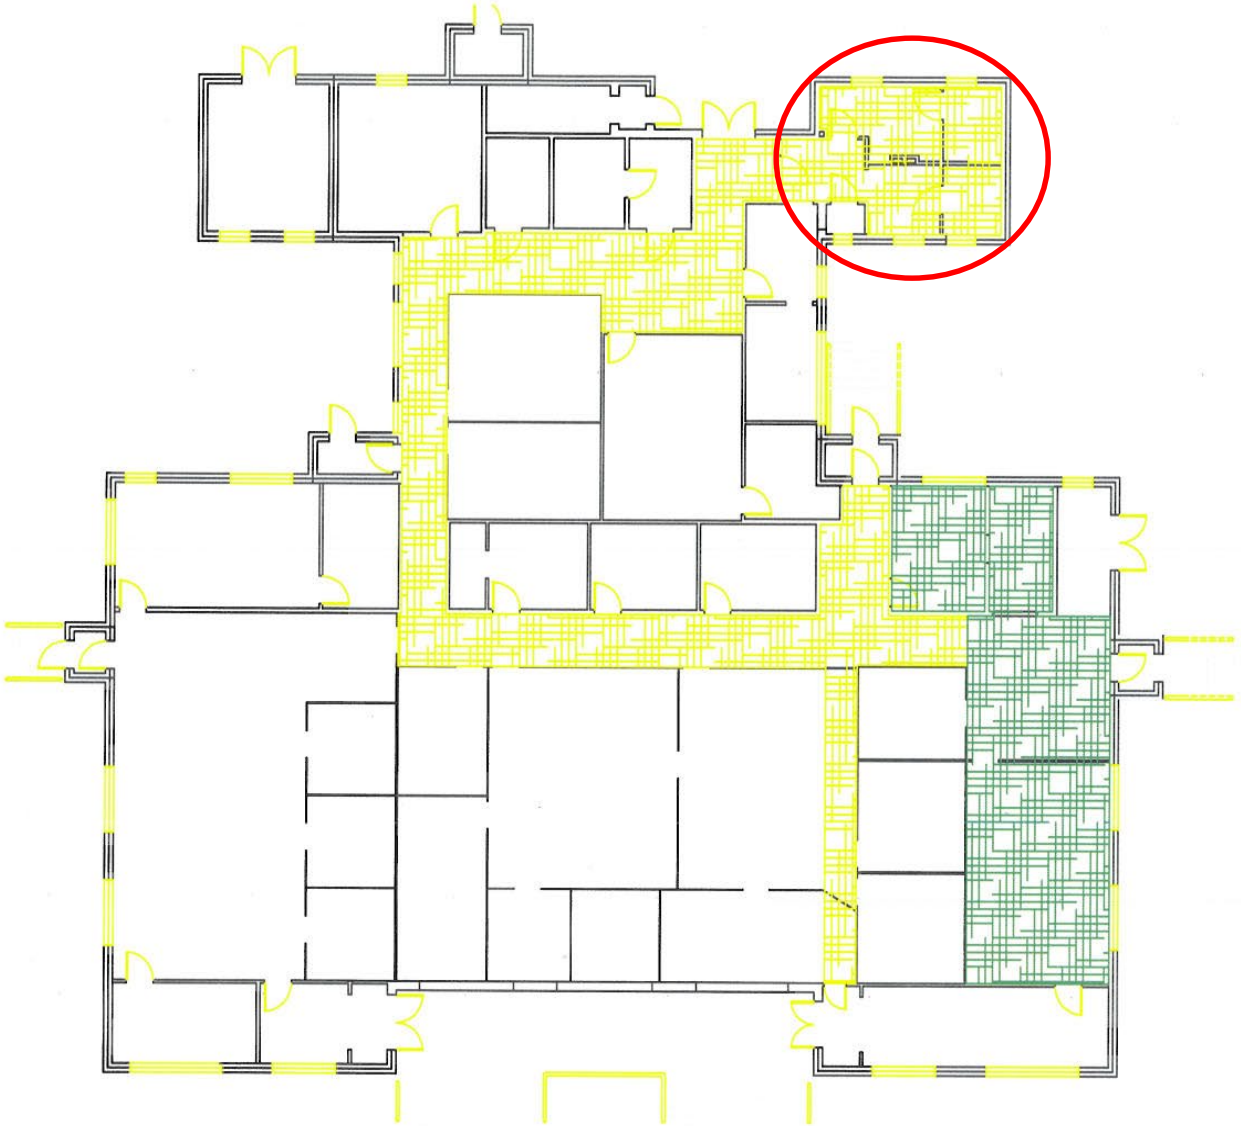

TILE = 1130.5590
CARPET = 873.4391
BR = 328.5278

TOTAL = 2332.5259

FLOOR PLAN BLDG 6117
SCALE: _"=1'-0"

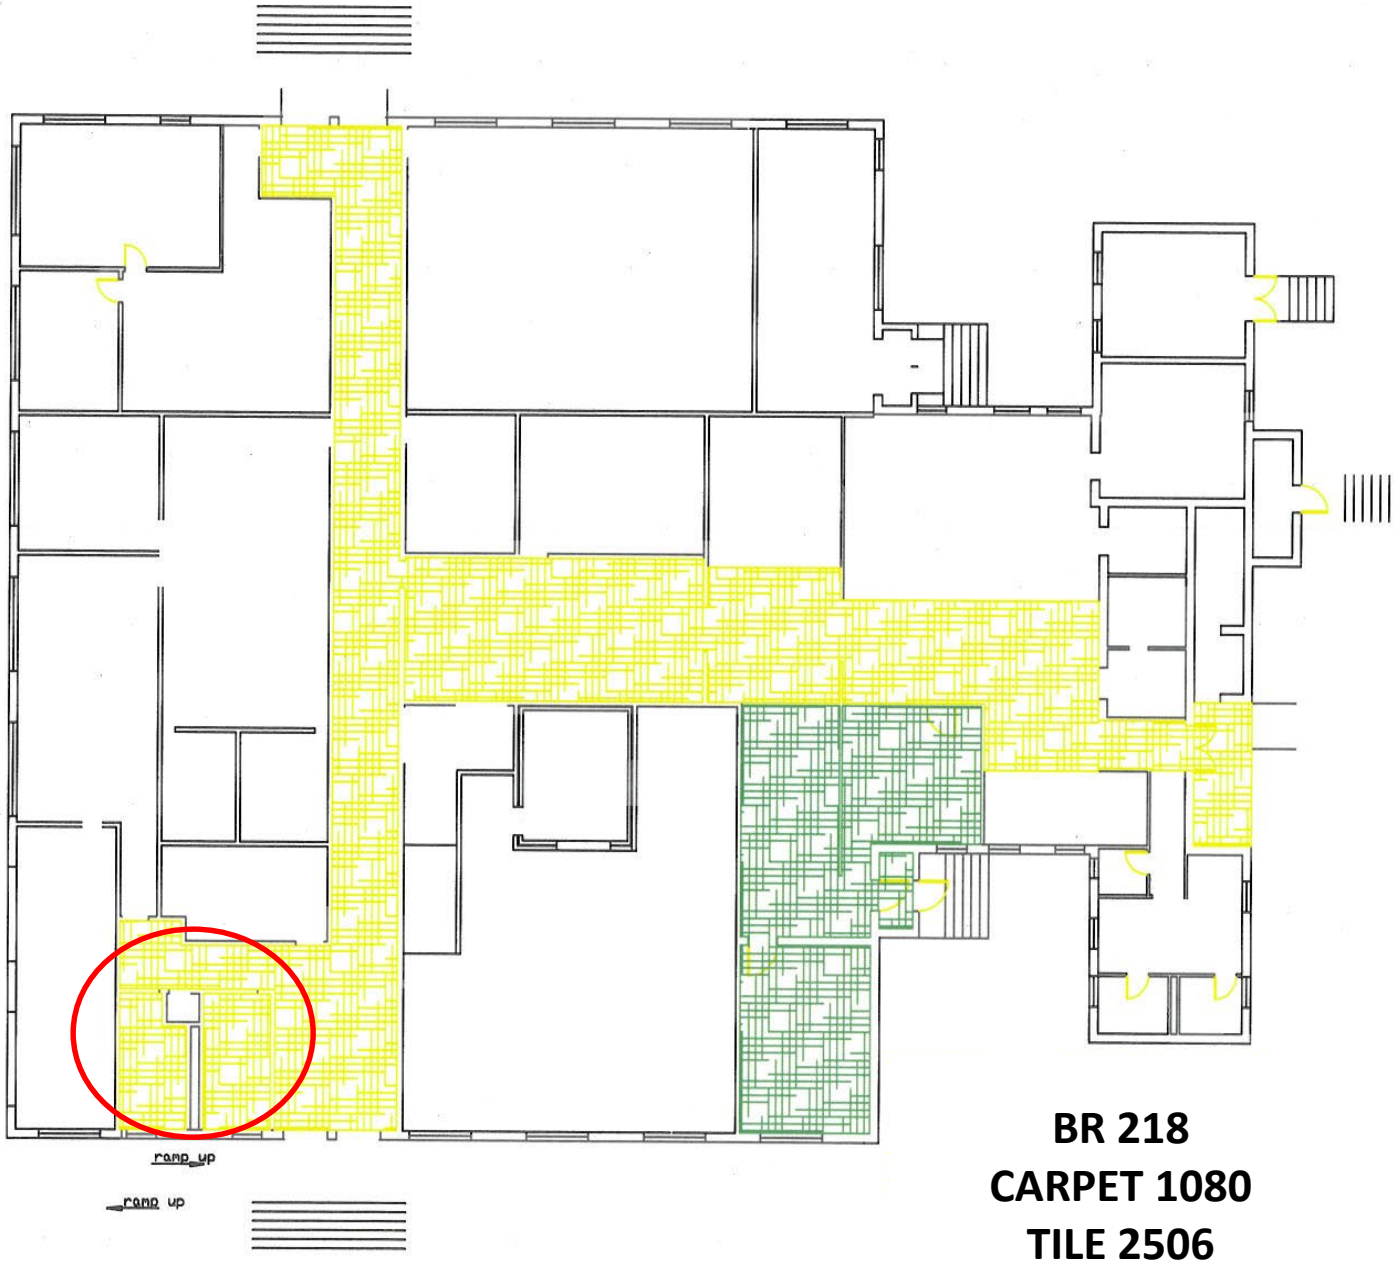

BR 218
CARPET 1080
TILE 2506

BLDG 6122

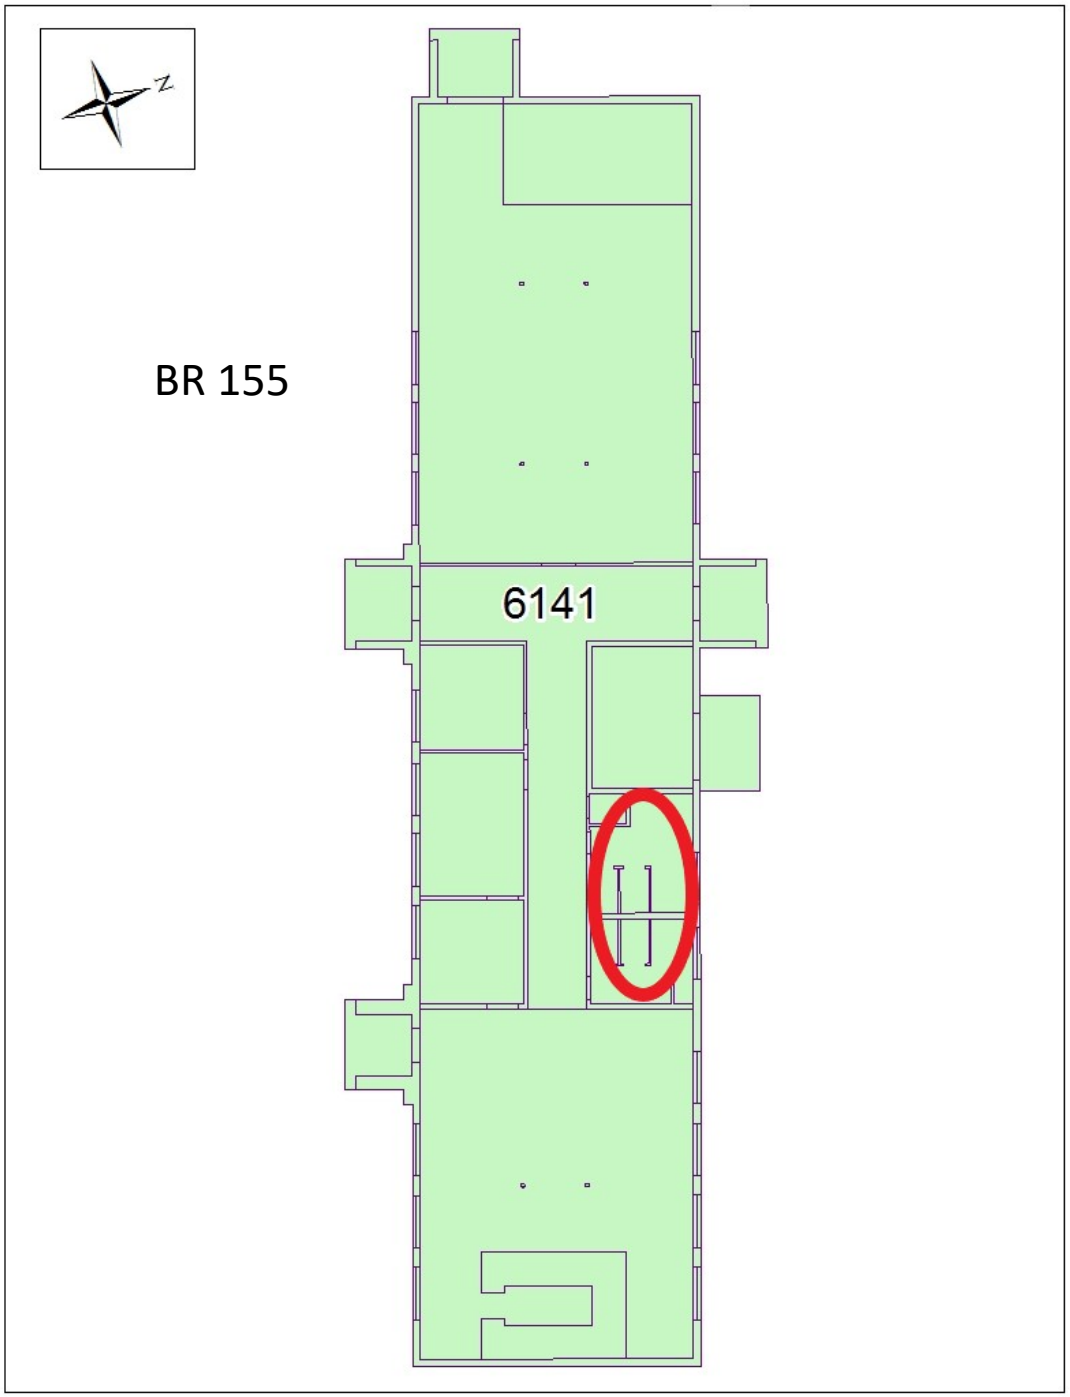
BR 155
6141

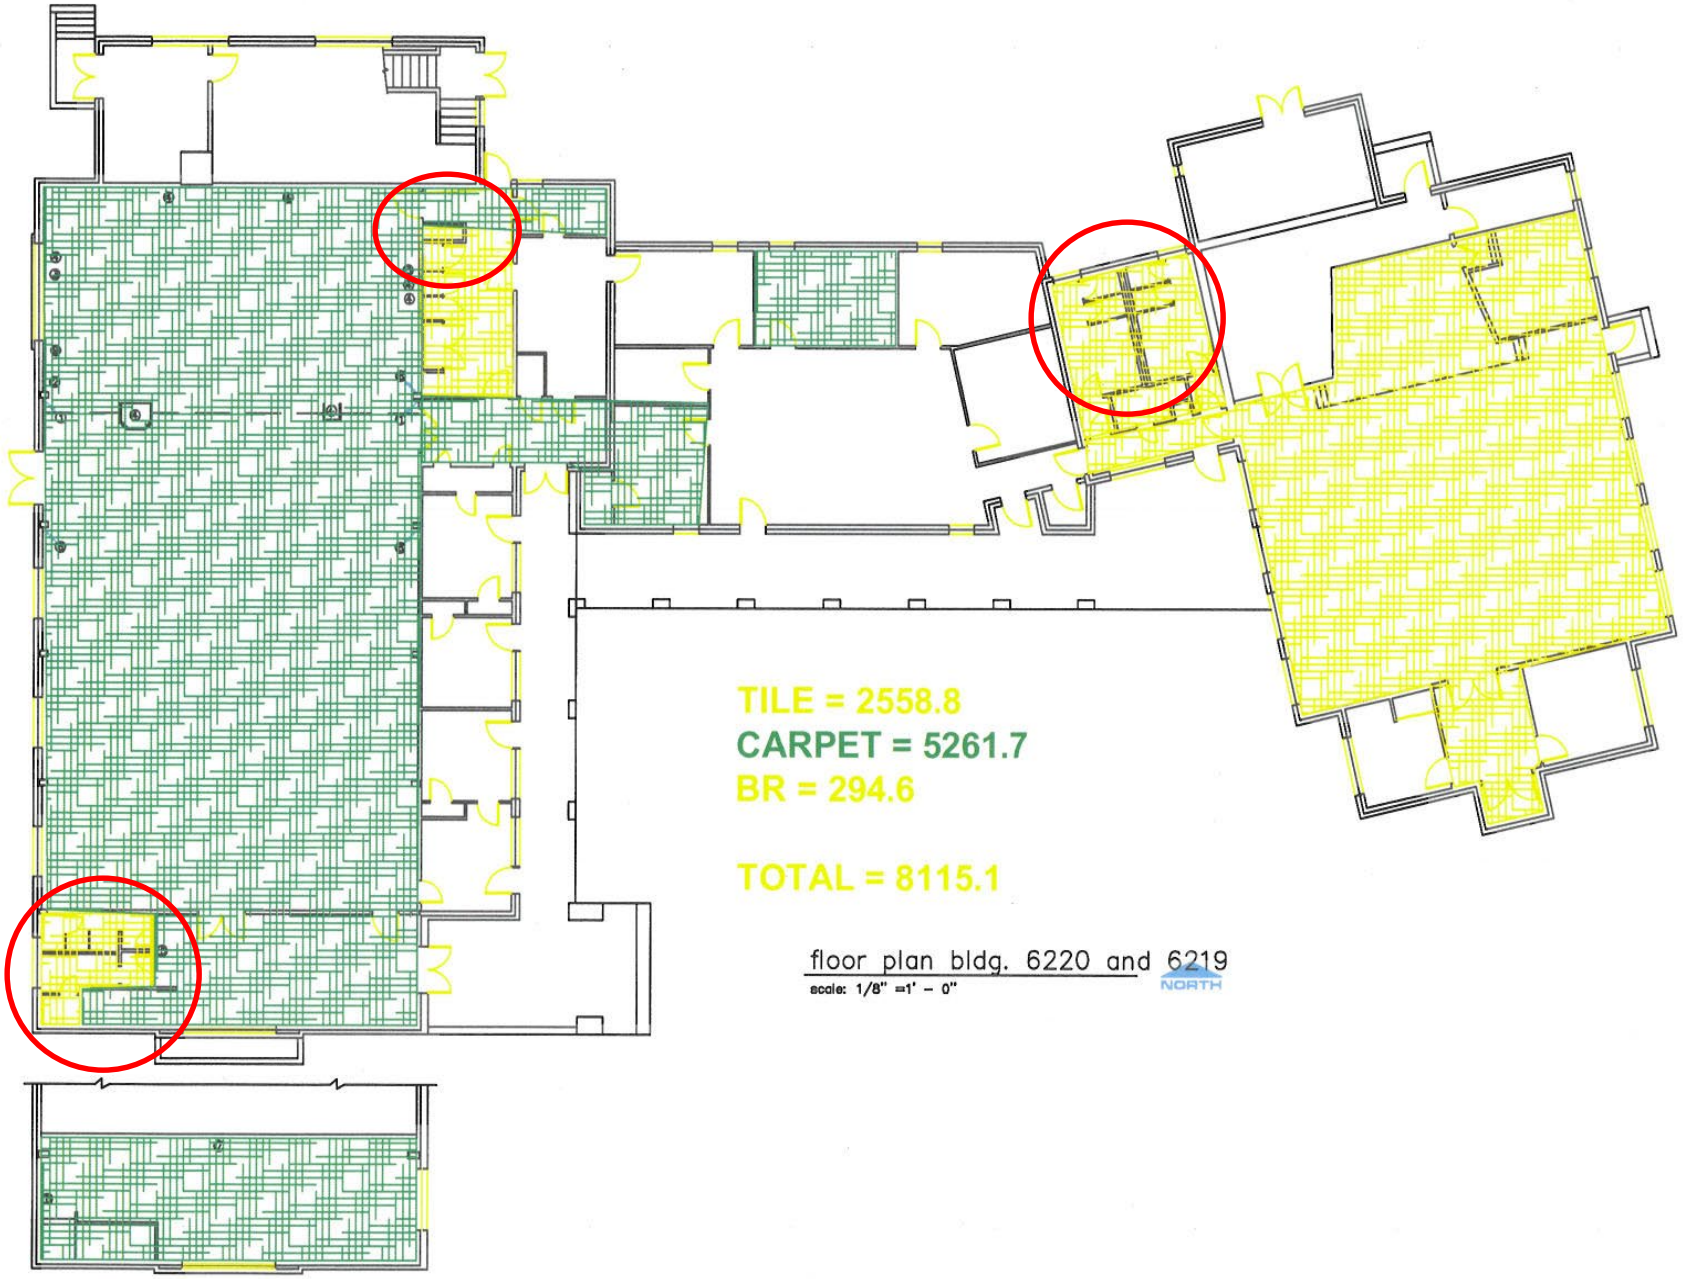
TILE = 2558.8
CARPET = 5261.7
BR = 294.6
TOTAL = 8115.1
floor plan bldg. 6220 and 6219
scale: 1/8" =1' - 0"
NORTH

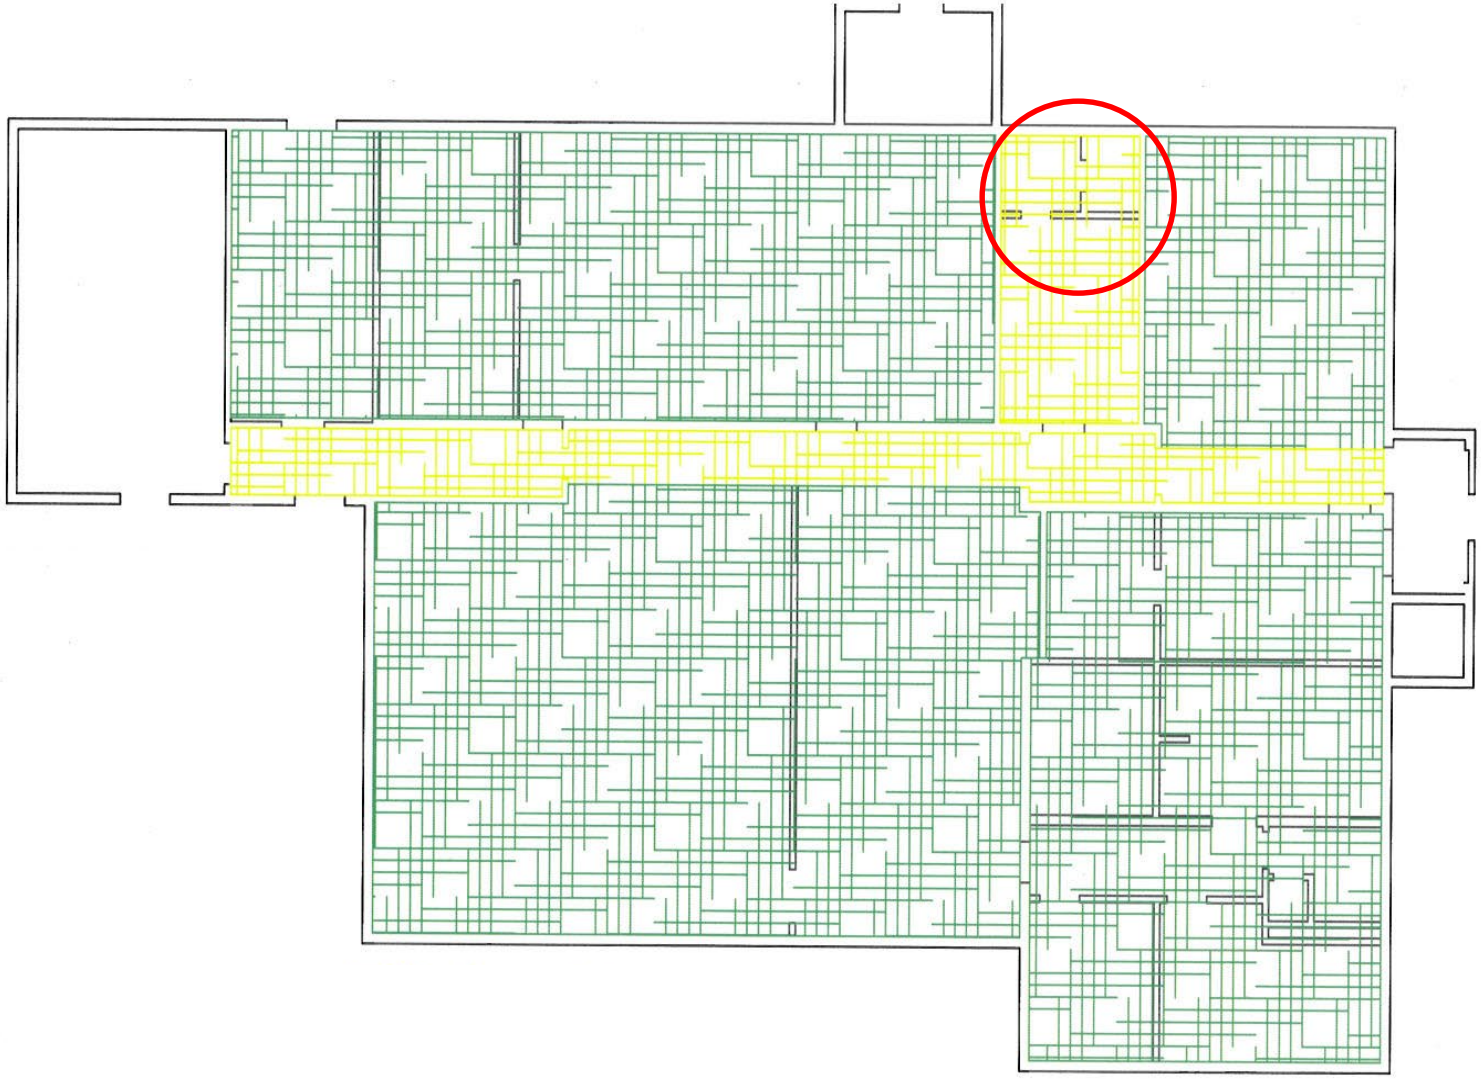

BR 172
CARPET 3383
TILE 297

FLOOR PLAN
BLDG 6222

SCALE: 1/4" - 1'-0"

BR 240
CARPET 2728

7401

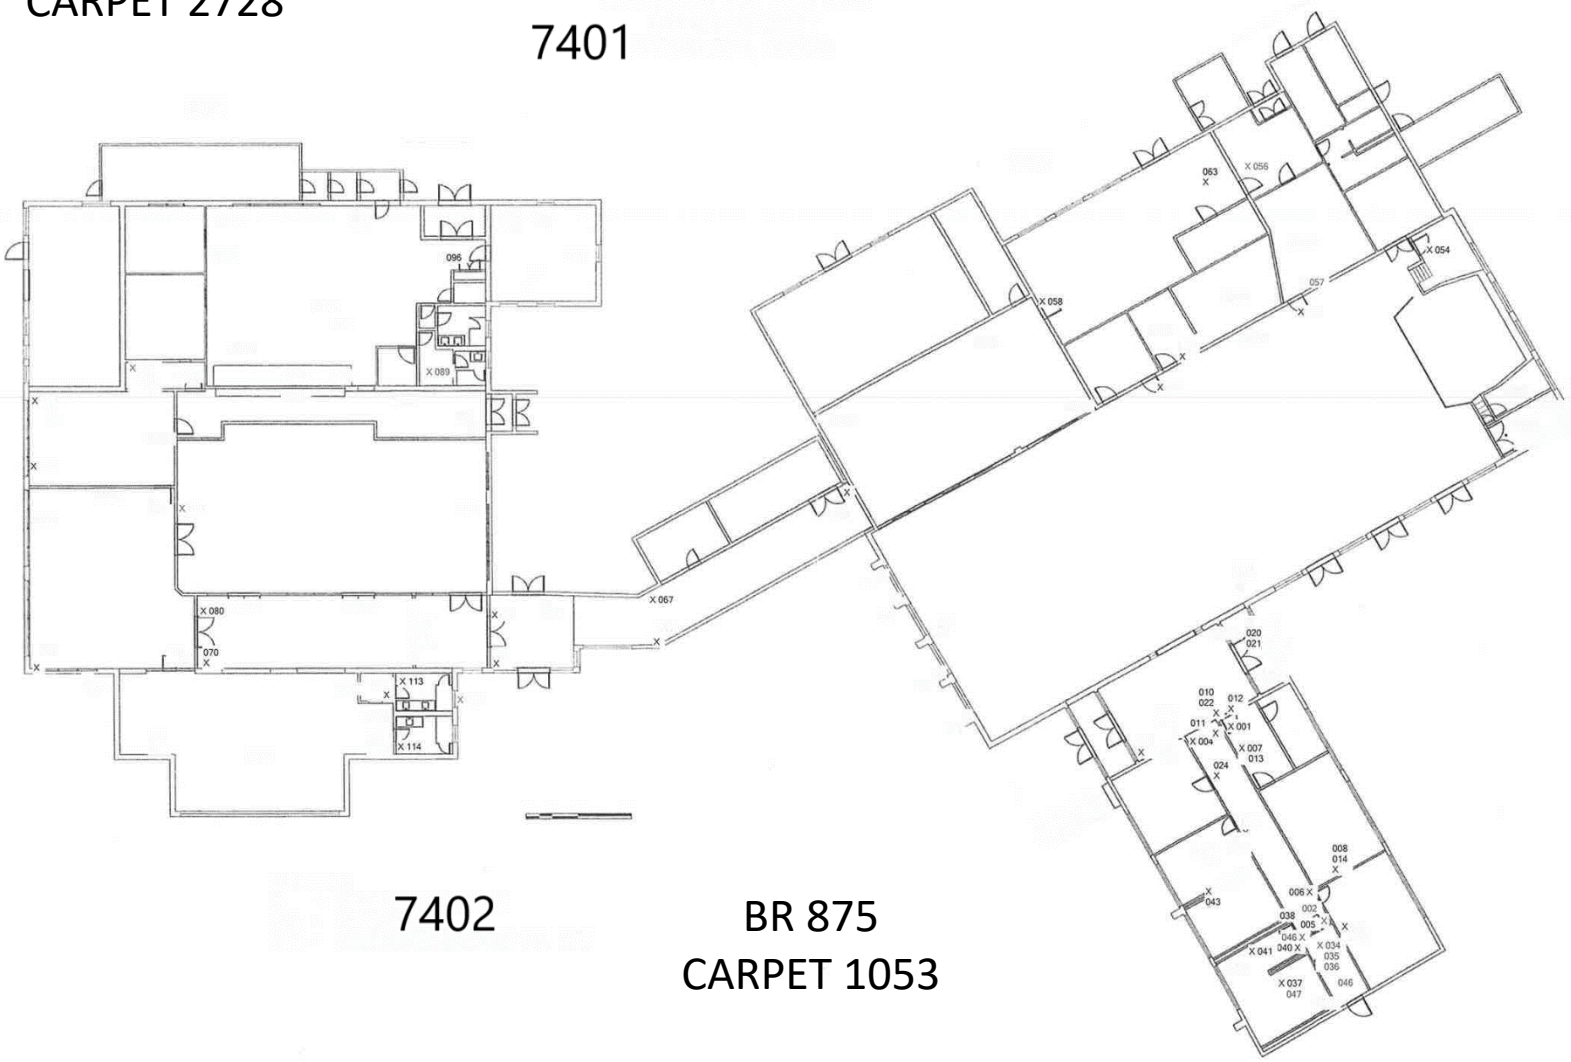

7402

BR 875
CARPET 1053

BR 287
CARPET 1975
TILE 2770

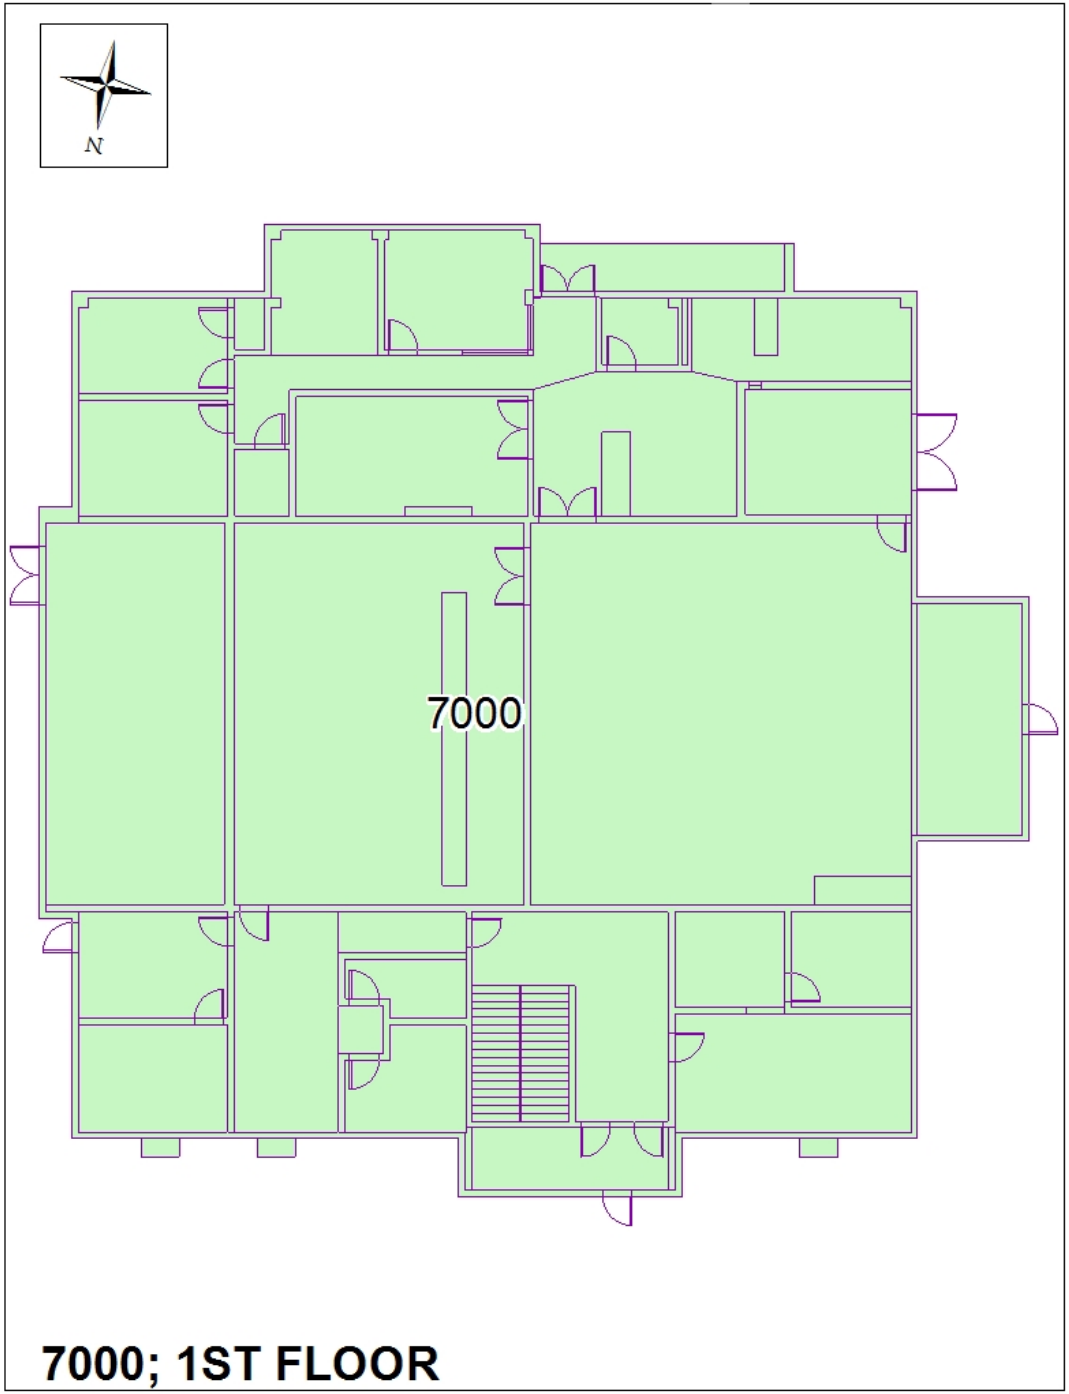

BR 757
CARPET 1706
TILE 621

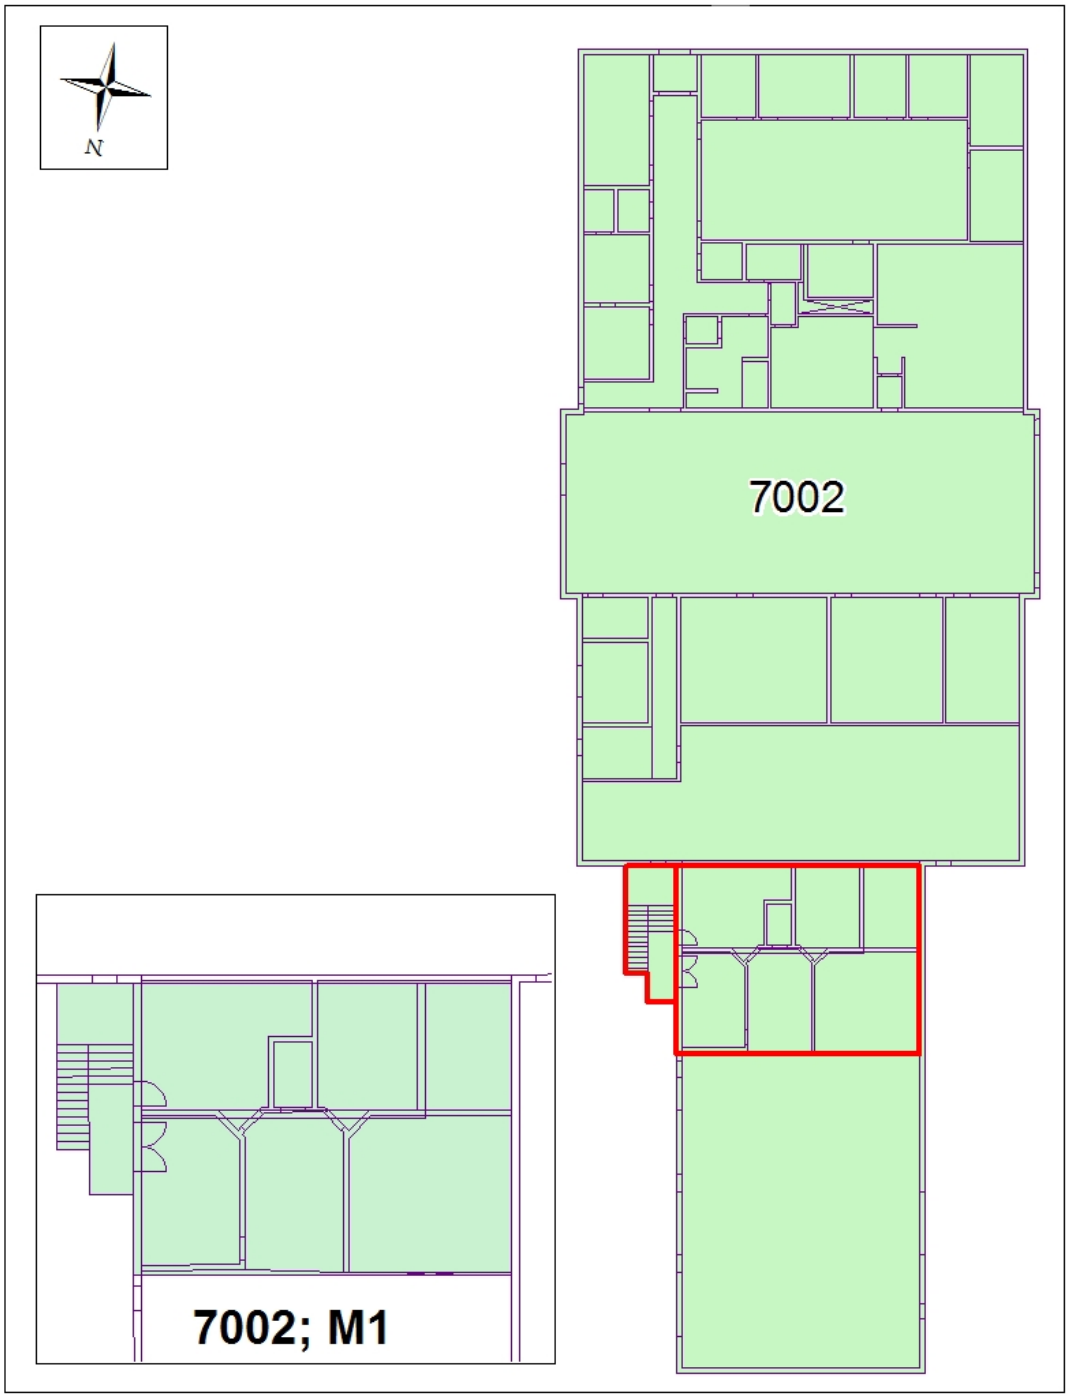

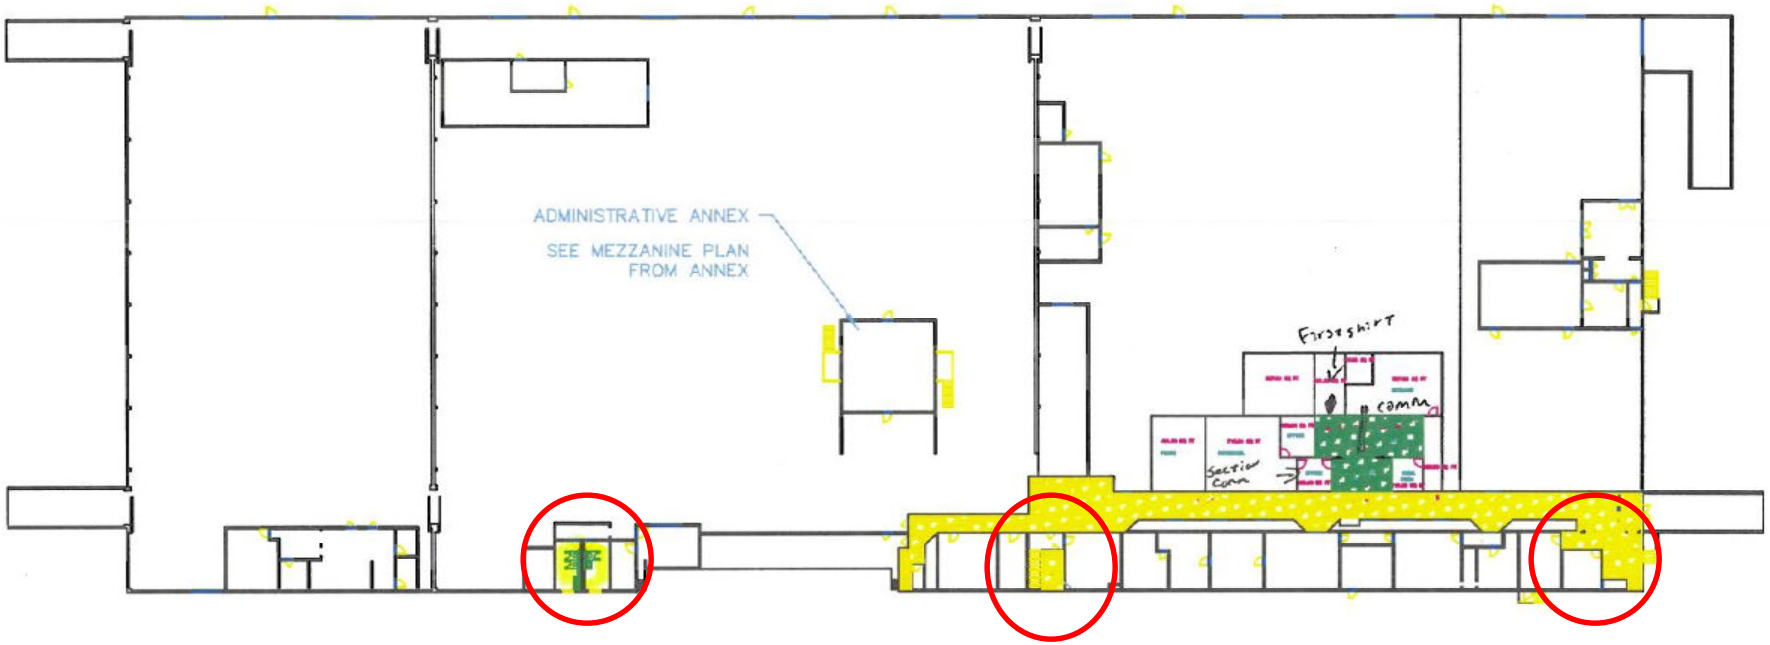

BR 816
CARPET 1321
TILE 2816

FLOOR PLAN BLDG 7004

SCALE: 1/32"=1'-0"

696-5841

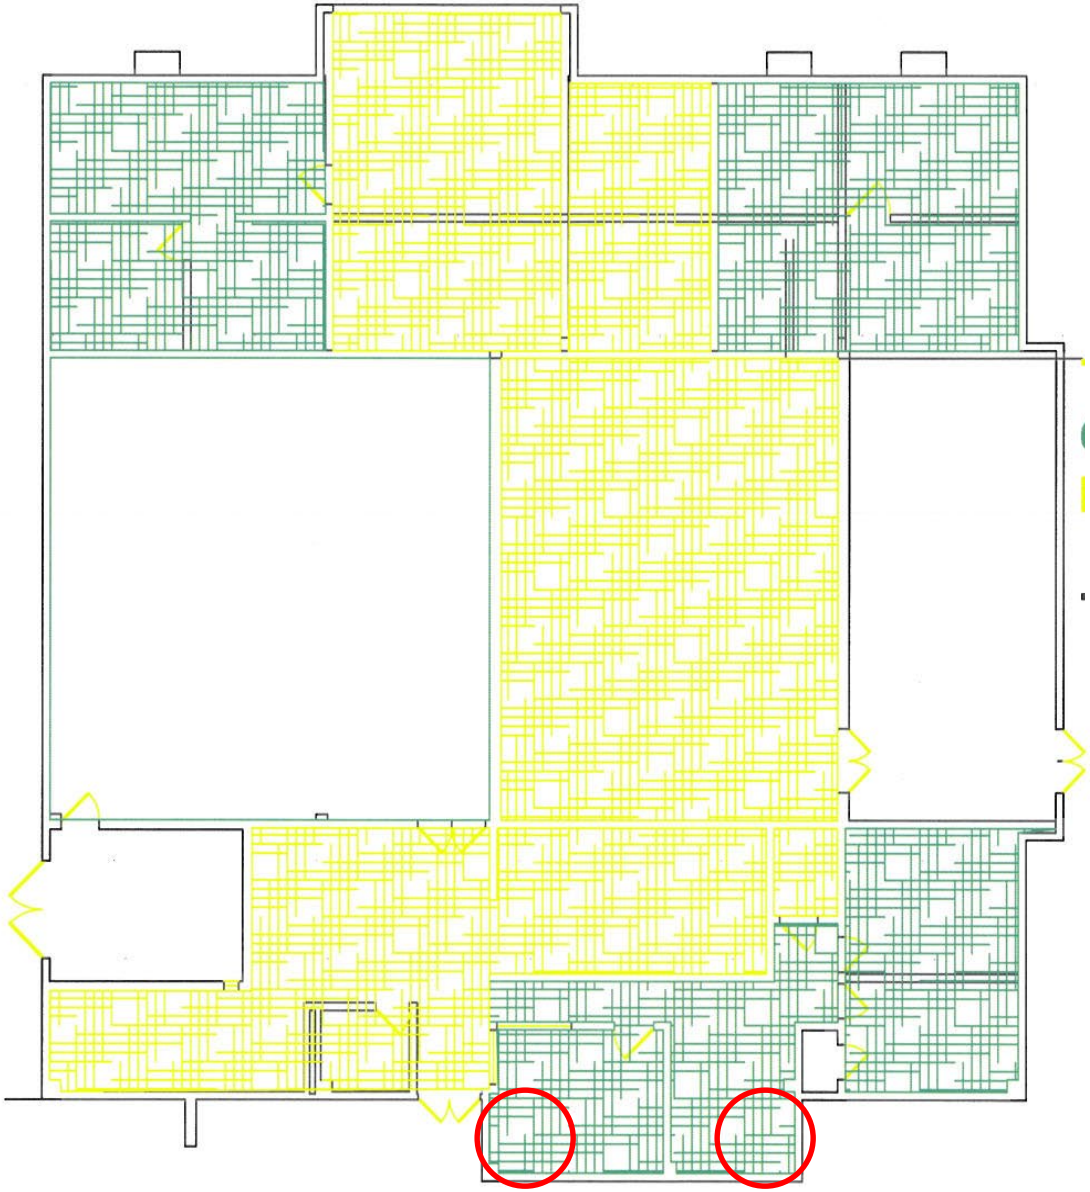

FLOOR PLAN – BUILDING 7000

BR 817
CARPET 1873
TILE 1886

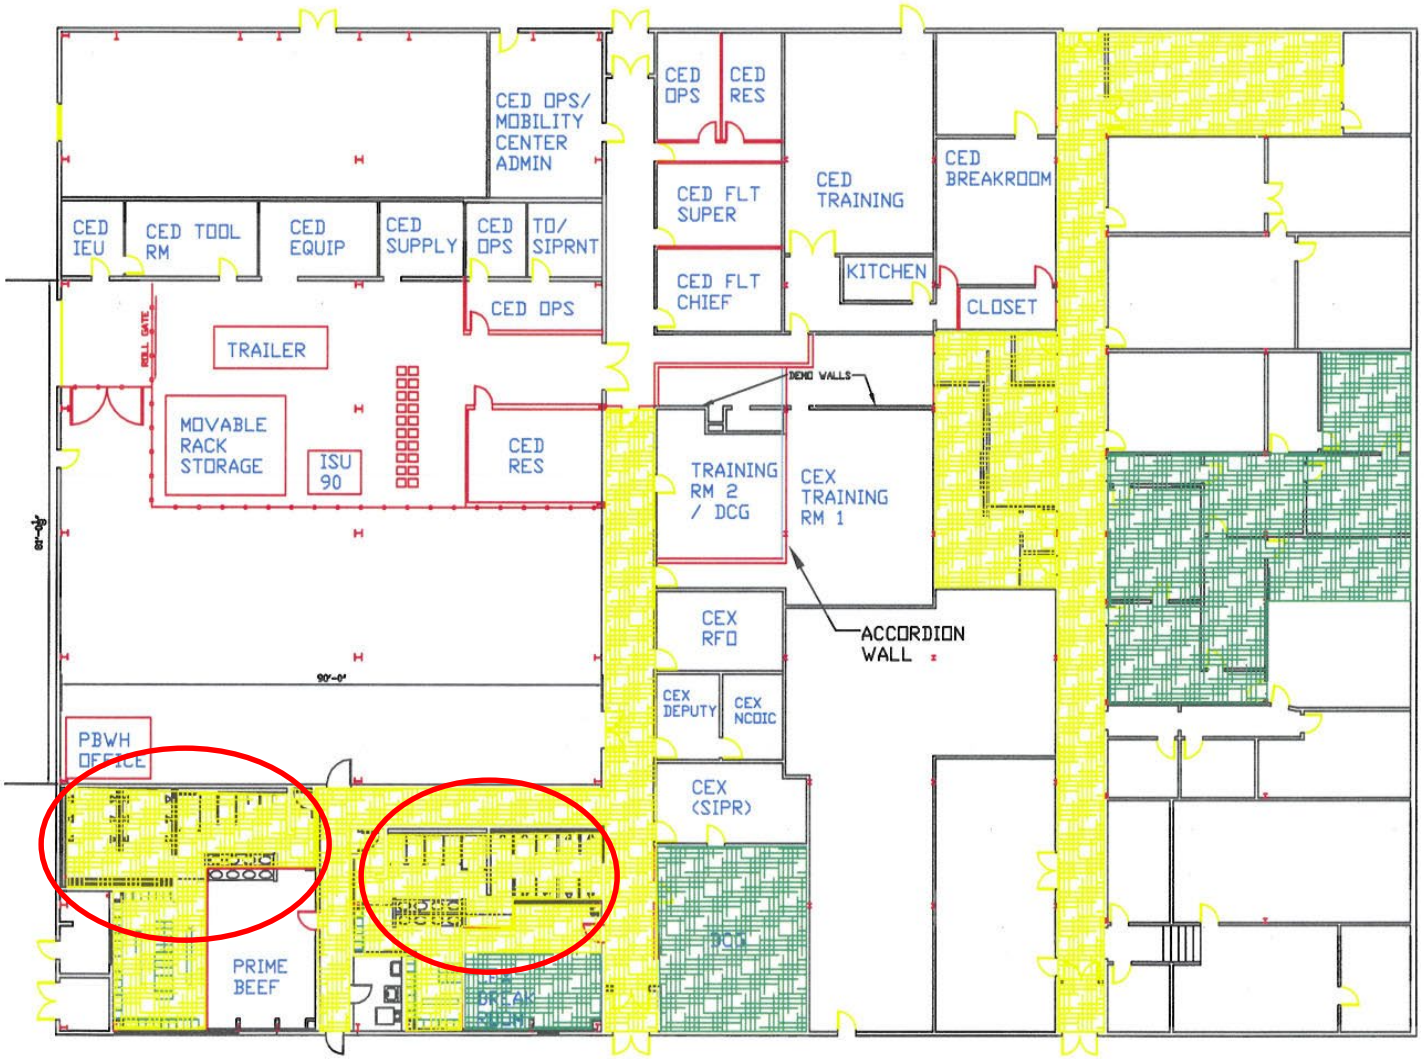

TILE = 1886.3
CARPET = 1872.53
BR = 816.7

TOTAL = 4575.53

BLDG 7007B

TILE = 1292.1
CARPET = 1007.87
BR = 1803.05
TOTAL = 4103.02

BLDG 7007A

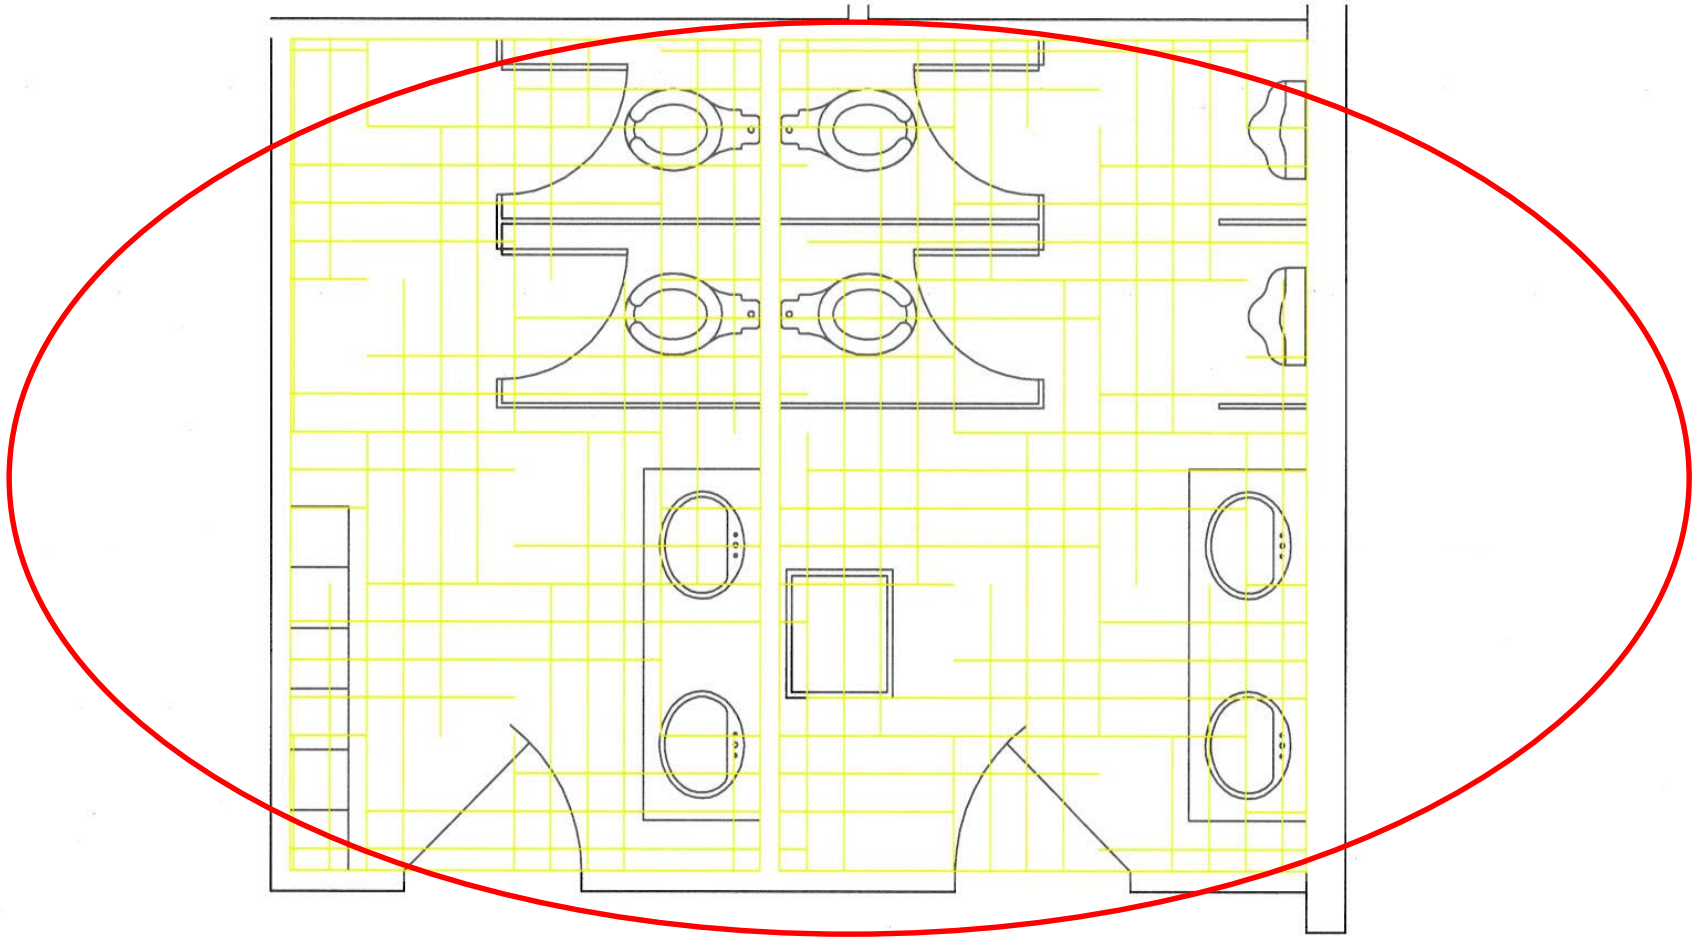

BLDG 7008

BR = 233

FLOOR PLAN BLDG 7008

SCALE: 1/16"= 1'-0"

TILE = 1700
CARPET = 1989
BR = 349

TOTAL = 4038

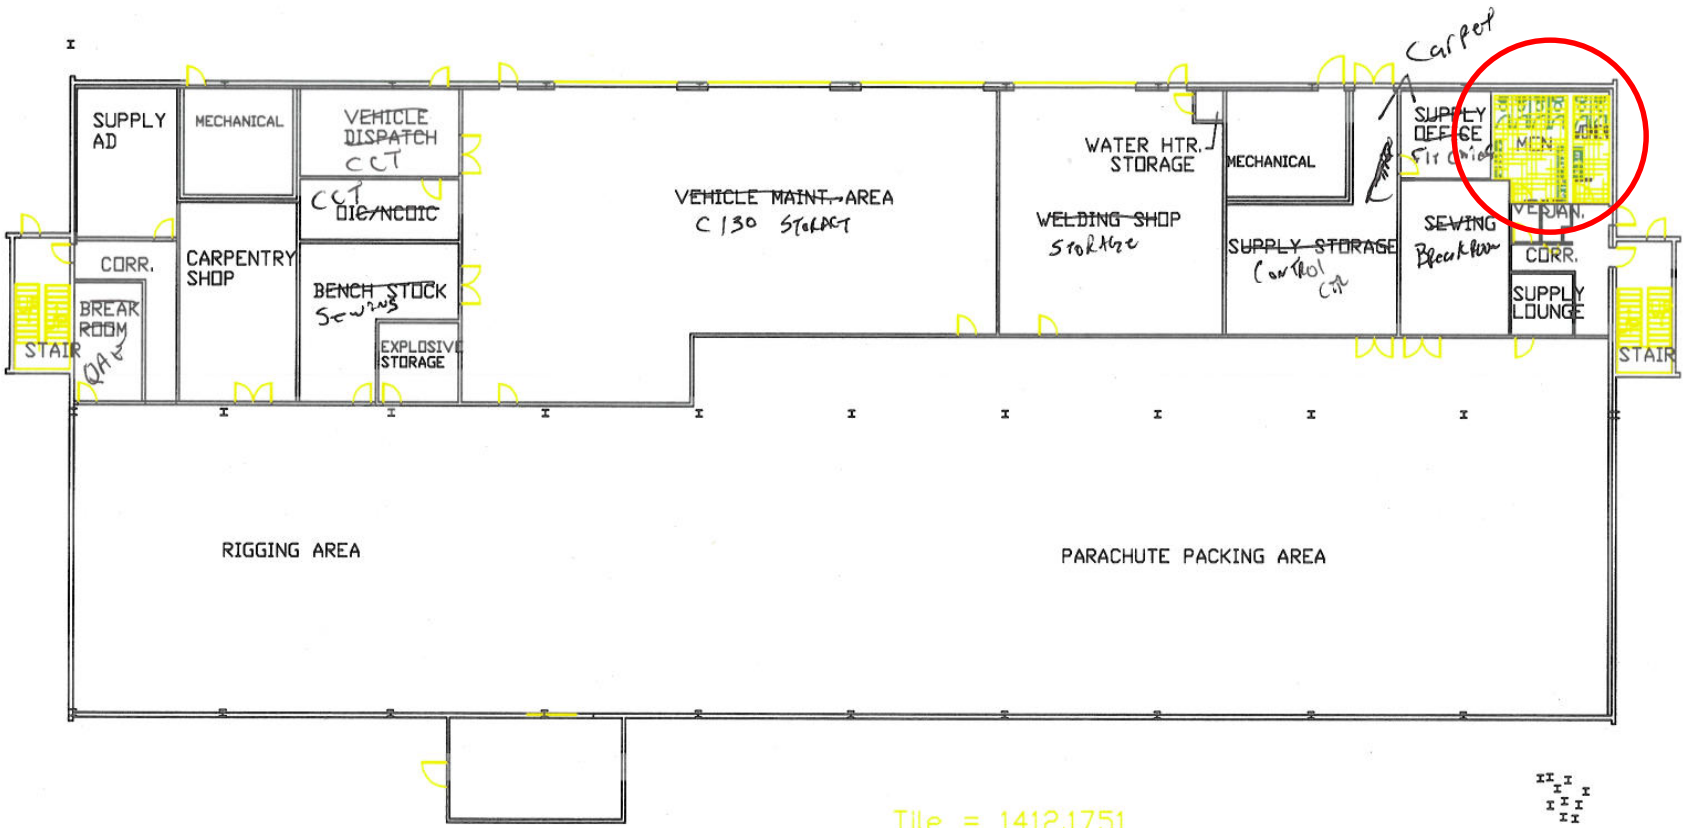

FIRST FLOOR PLAN
BLDG. 7040

SCALE: 3/32" = 1'-0"

Tile = 1412.1751
Carpet = 998.3585
BR = 578.6111

Total = 2989.1448

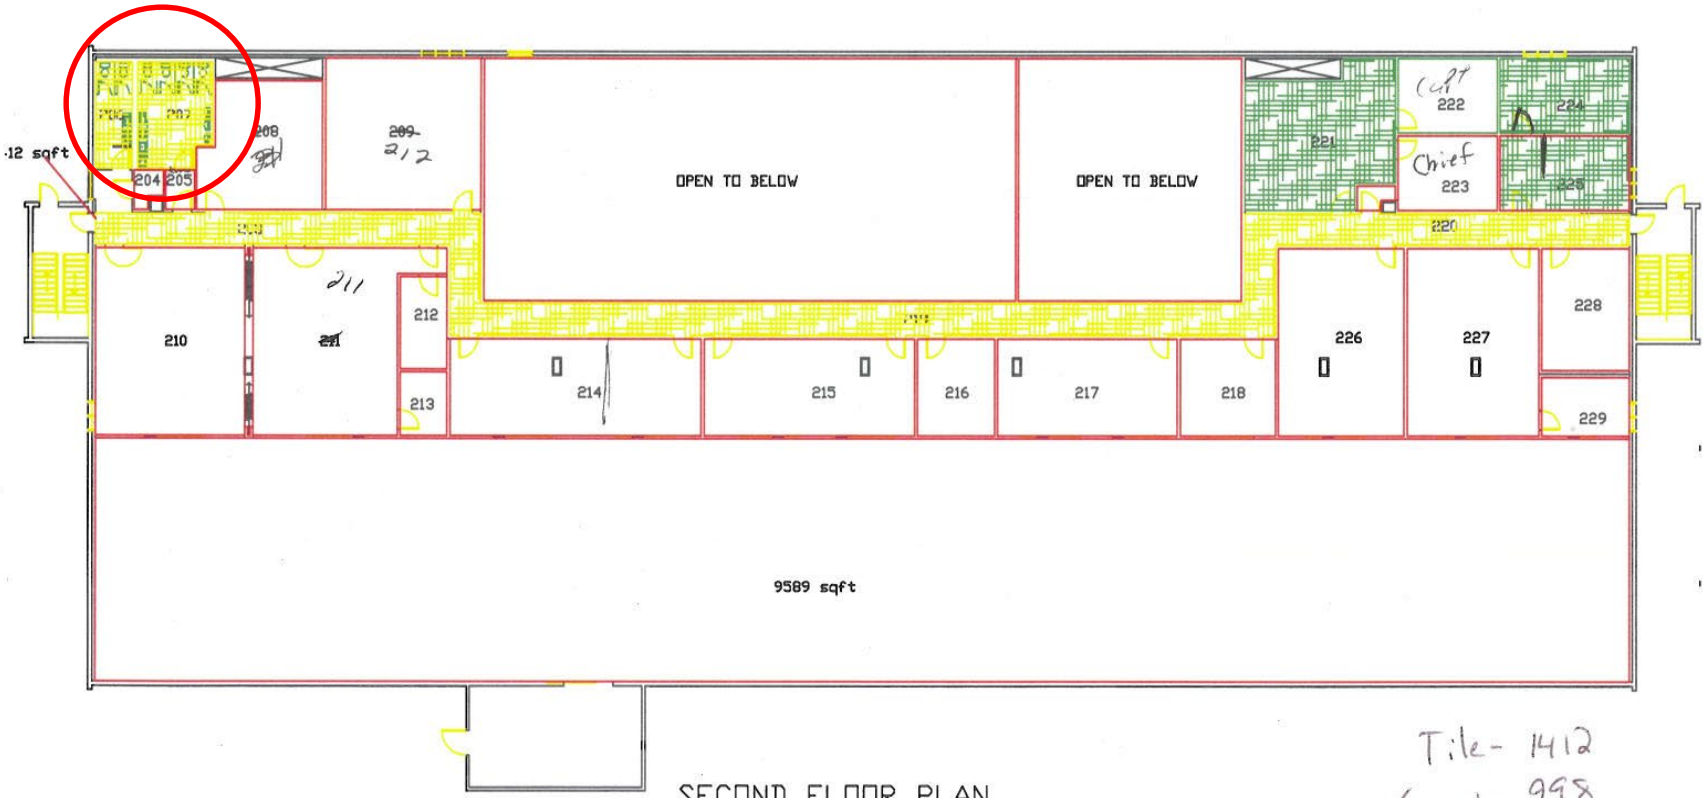

SECOND FLOOR PLAN
BLDG. 7040

Tile- 1412
Carpet- 998
BR- 579

Total - 2989

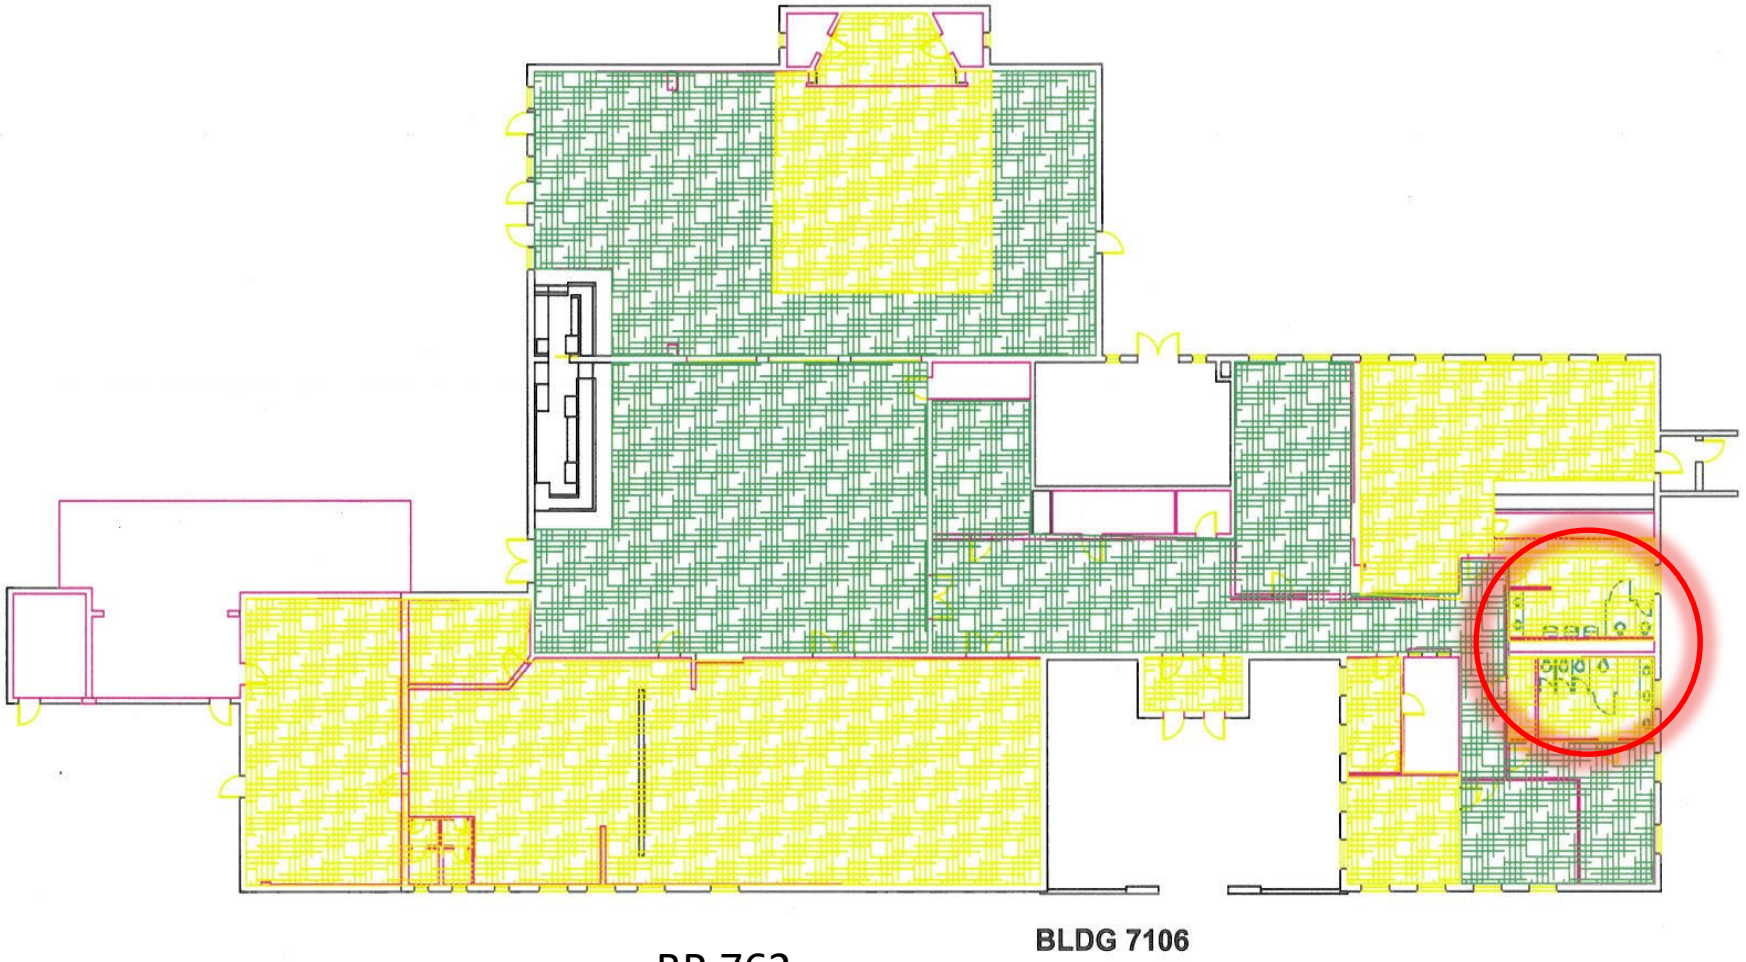

BR 762
CARPET 4607
TILE 2209

BR 226
TILE 1000

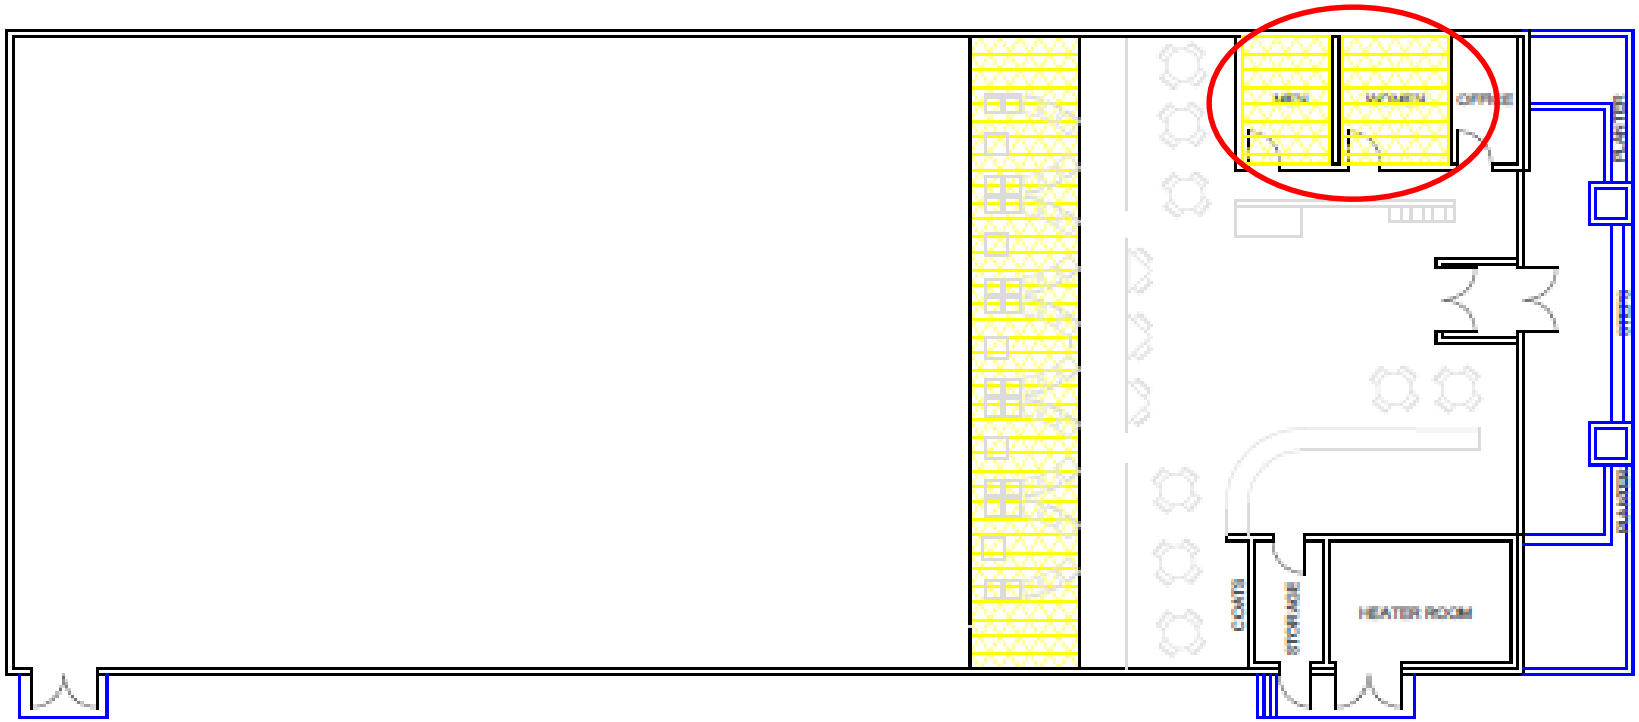

BOWLING CENTER, BLDG. 7115

BR 396
CARPET 2397
TILE 379

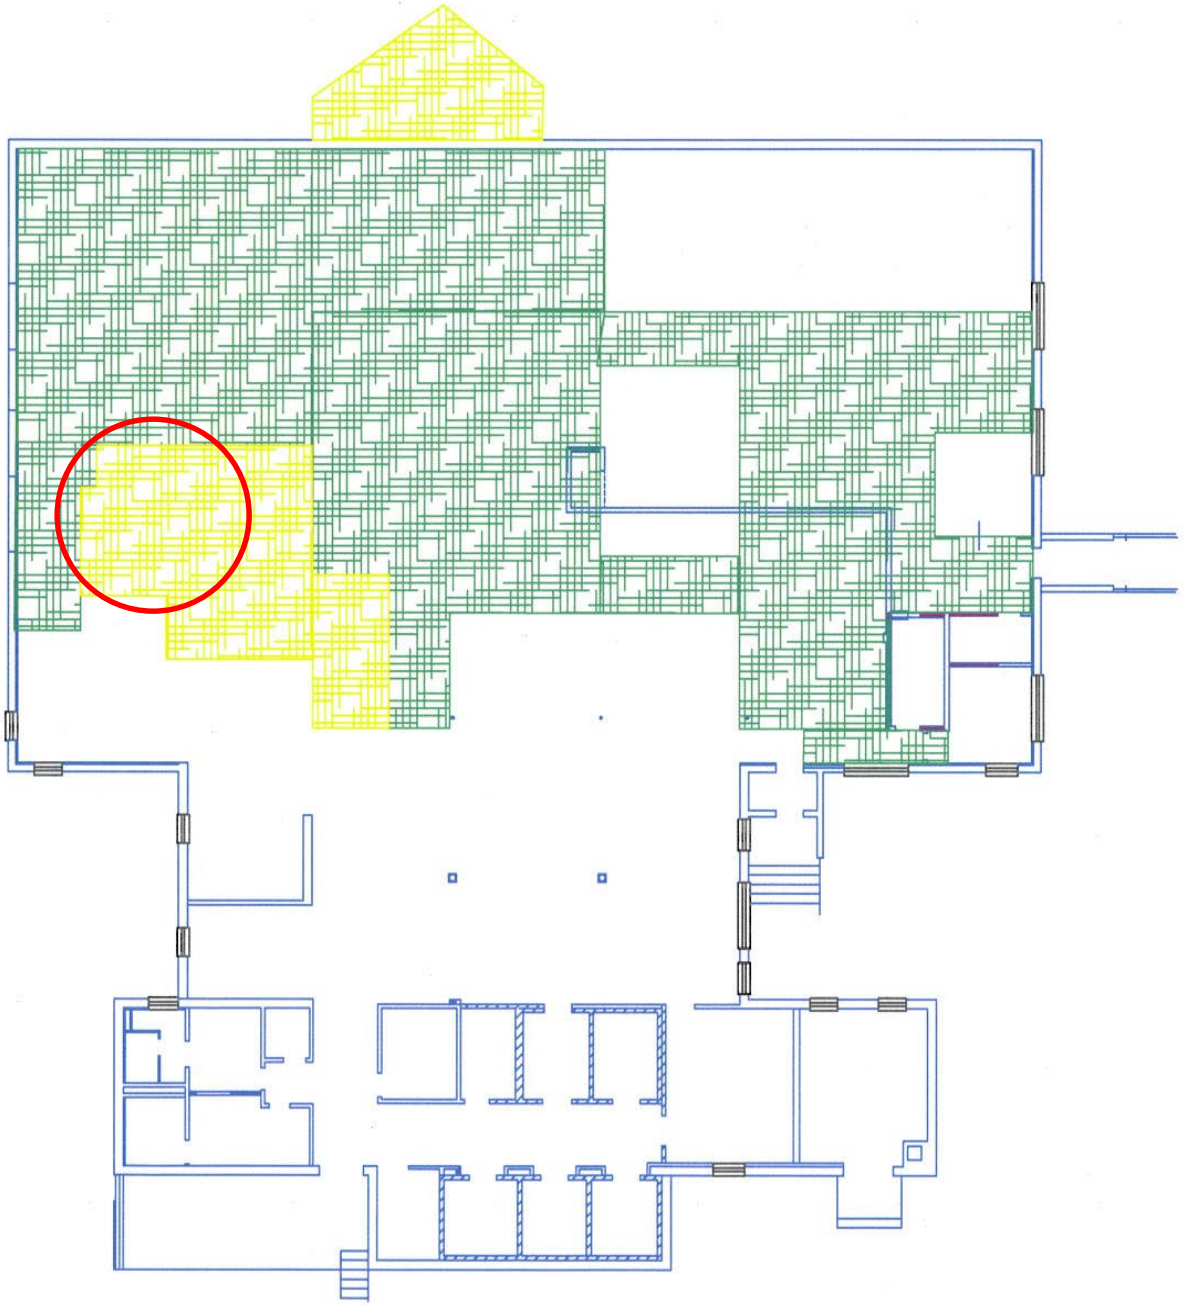

BLDG 7215

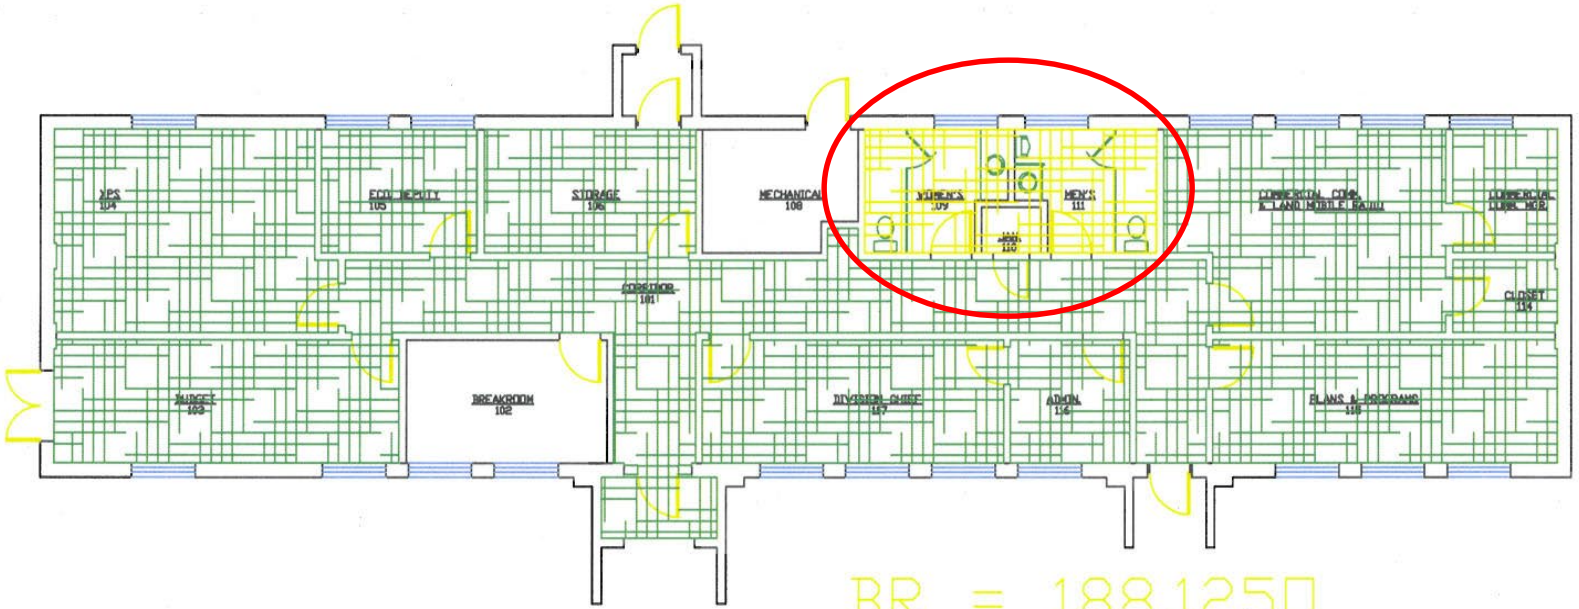

7216 FLOOR PLAN
SCALE 1/4"=1'-0"

BR = 188.1250

CARPET = 2113.3472

TOTAL = 2301.4722

DCMA 735.16
BR - 84

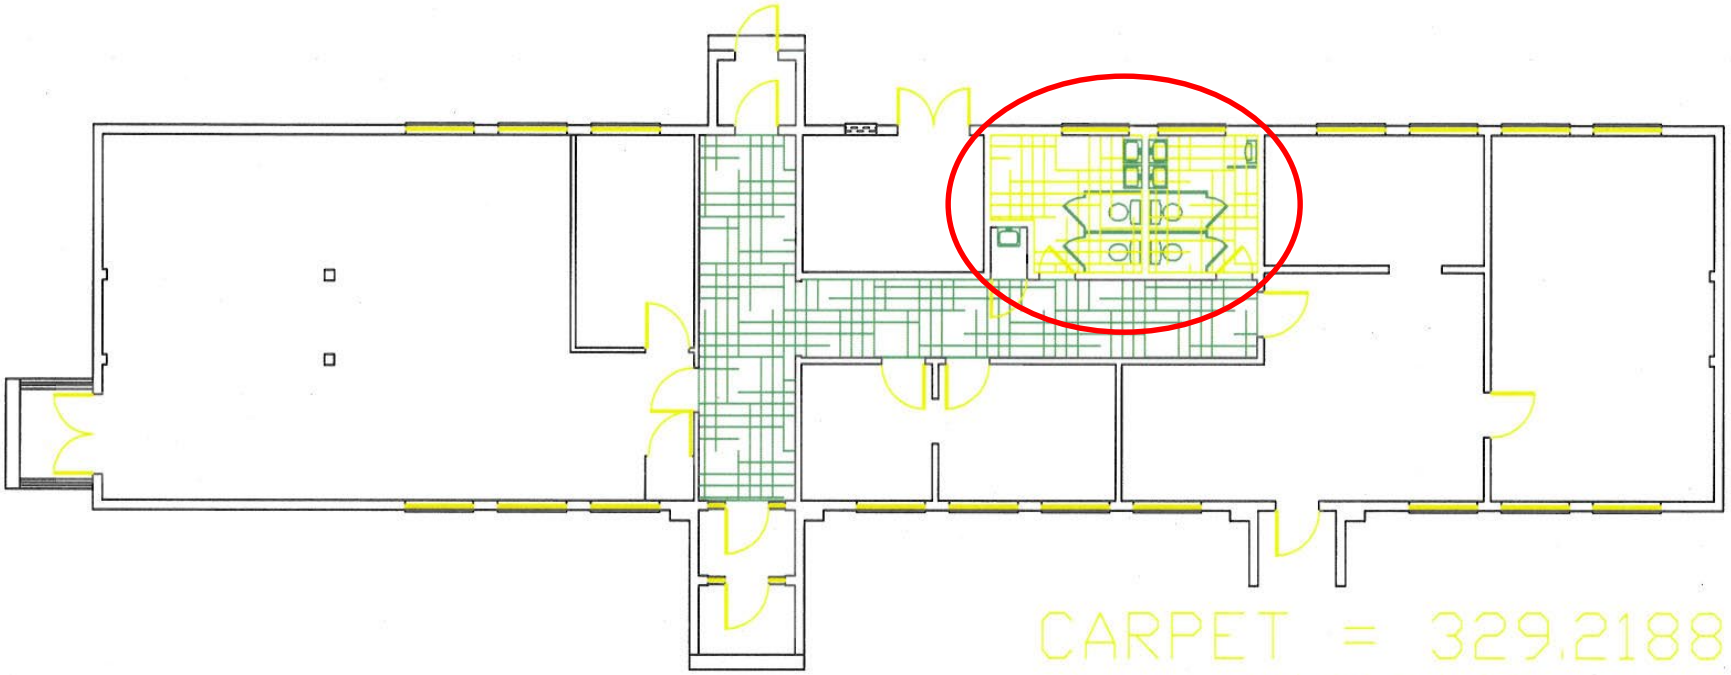

CARPET = 329.2188

BR = 153.5625

RECORD DRAWING BLDG 7217

SCALE : 1/4" = 1'- 0"

Total = 482.7812

THIRD FLOOR PLAN 7232
SCALE: 3/32"=1'-0"

SECOND FLOOR PLAN 7232
SCALE: 3/32"=1'-0"

FIRST FLOOR PLAN 7232
SCALE: 3/32"=1'-0"

Bldg under reno
Current Sqft
BR 154
CARPET 512

BR 986
CARPET 3000
TILE 7501

BLDG 7233

TILE = 1488.5833
BR = 1172.3359

TOTAL = 2660.9192

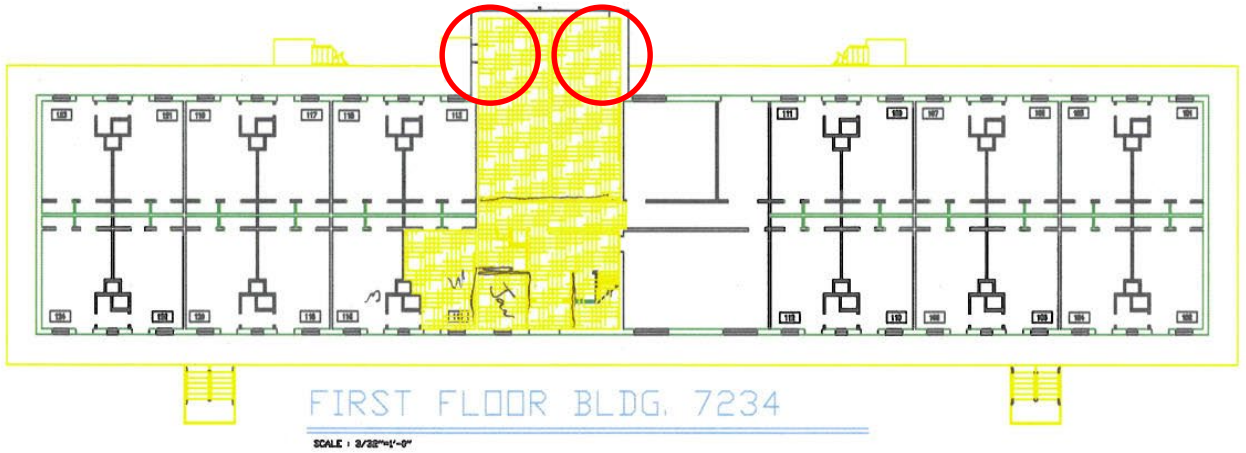

FIRST FLOOR BLDG. 7234

SCALE : 3/32"=1'-0"

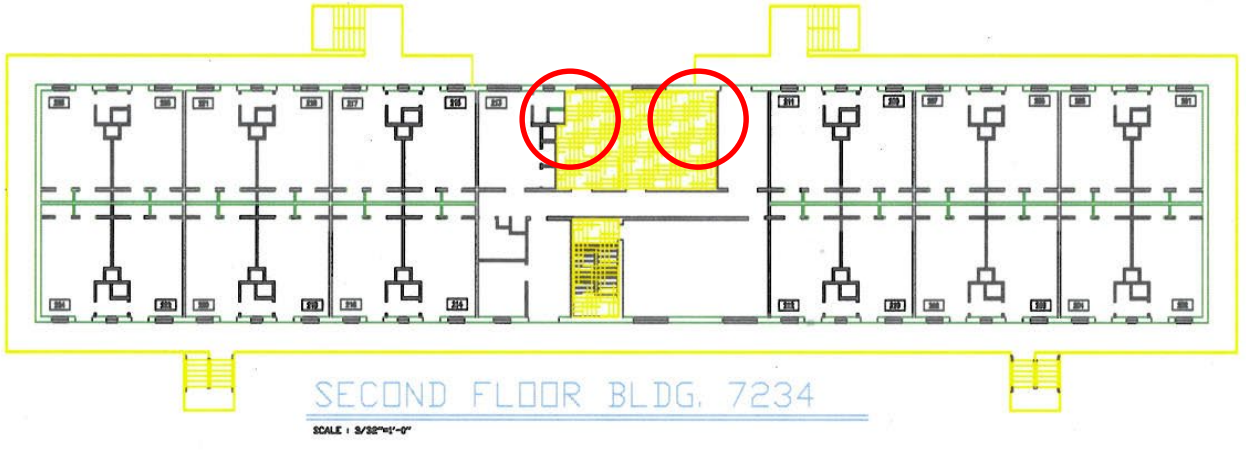

SECOND FLOOR BLDG. 7234

SCALE : 3/32"=1'-0"

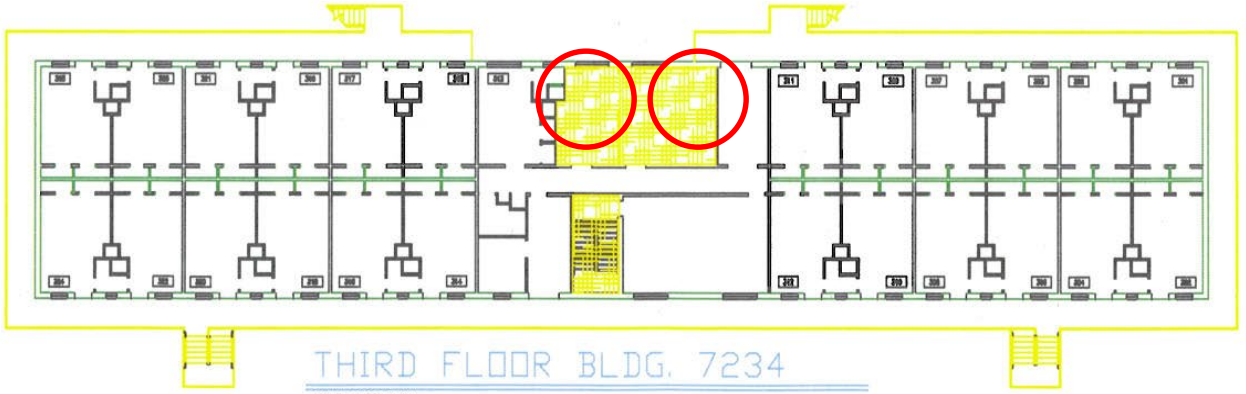

THIRD FLOOR BLDG. 7234

SCALE : 3/32"=1'-0"

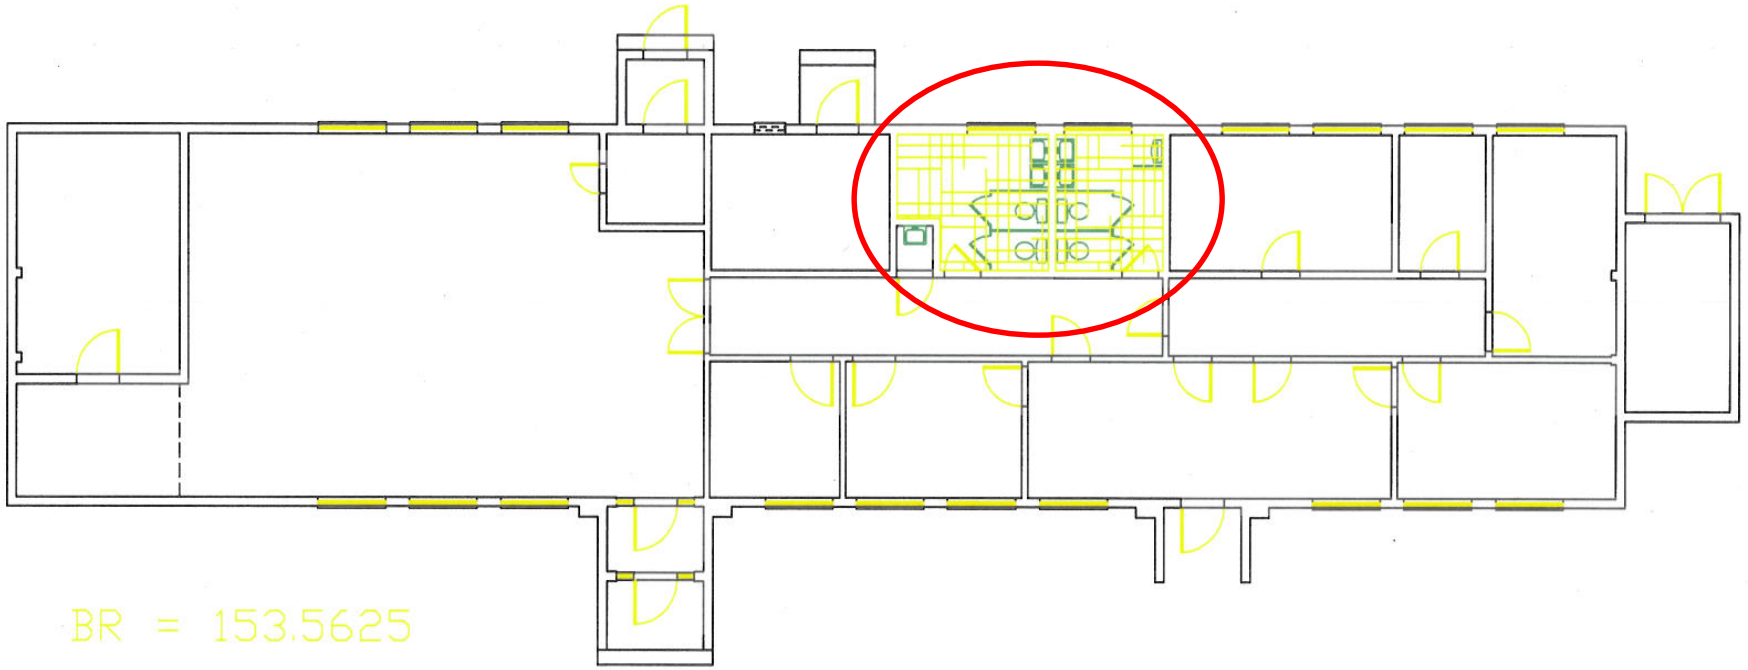

FLOOR PLAN BLDG 7235

SCALE : 1/4" = 1'- 0"

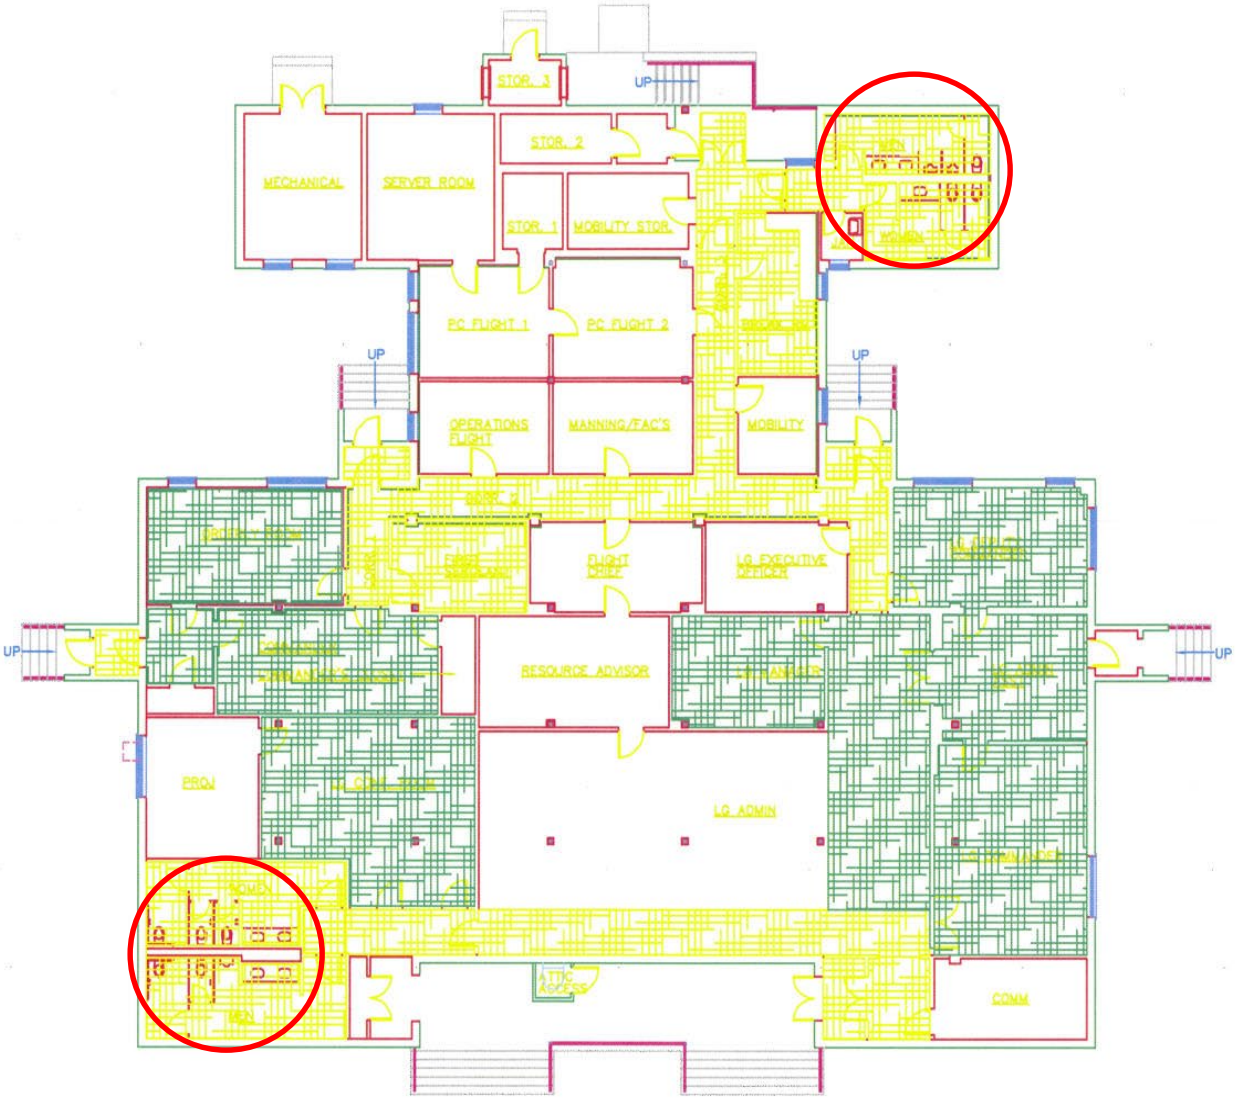

FLOOR PLAN BLDG 7237

SCALE: 1/8" = 1'-0"

BR 238

CARPET 1174

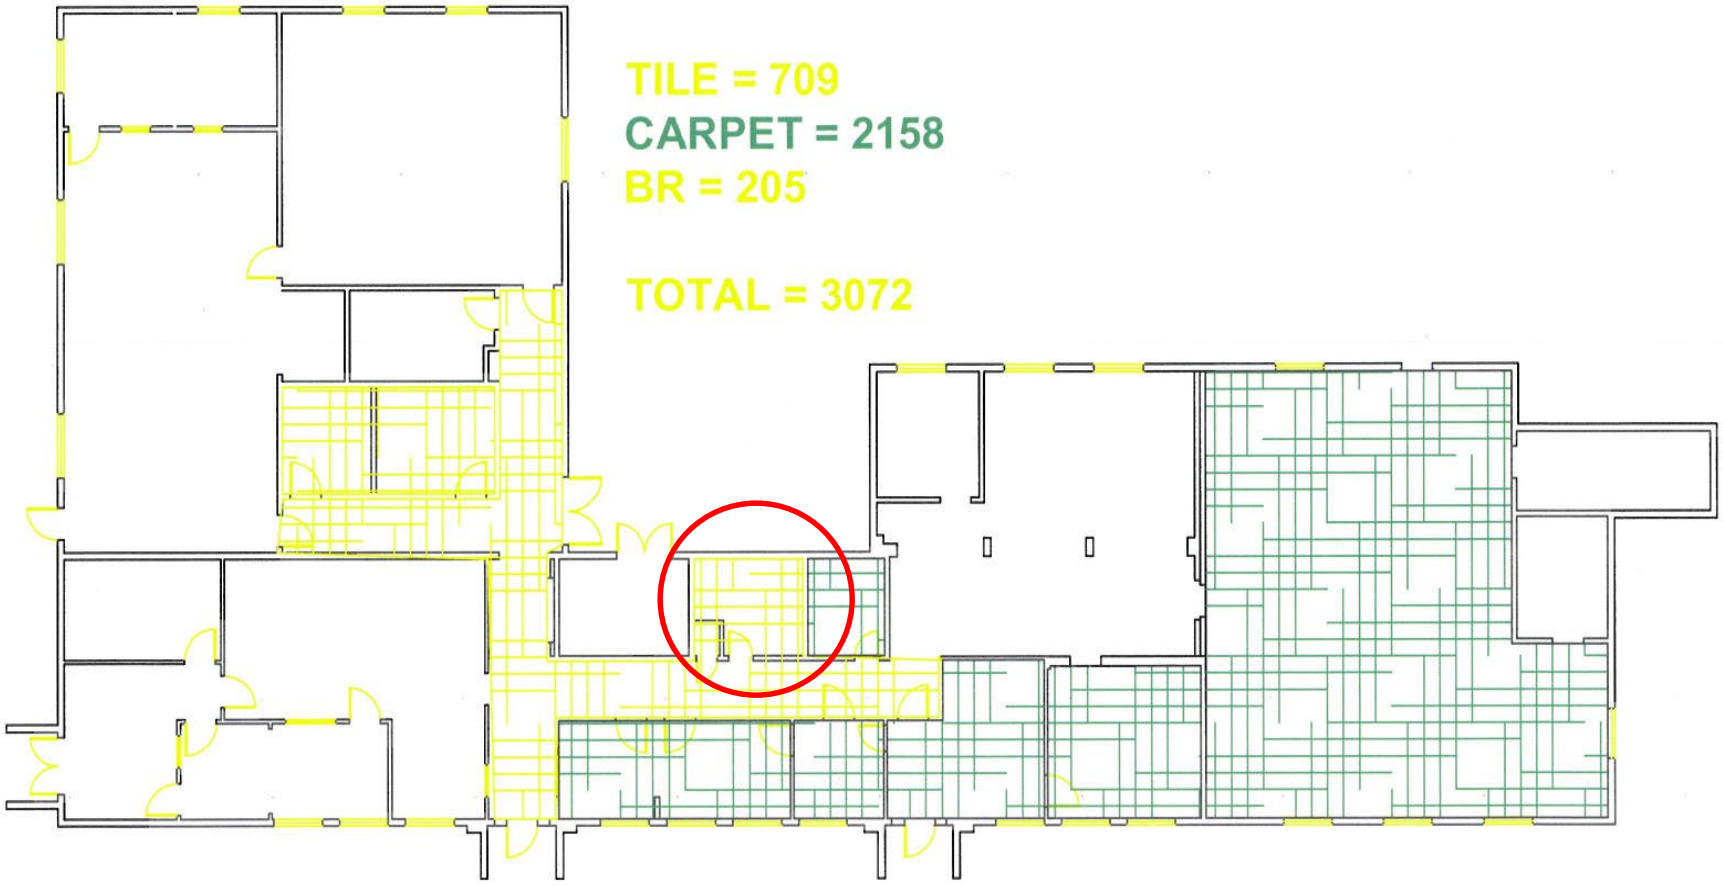

Facility 7238 Floor Plan
SCALE

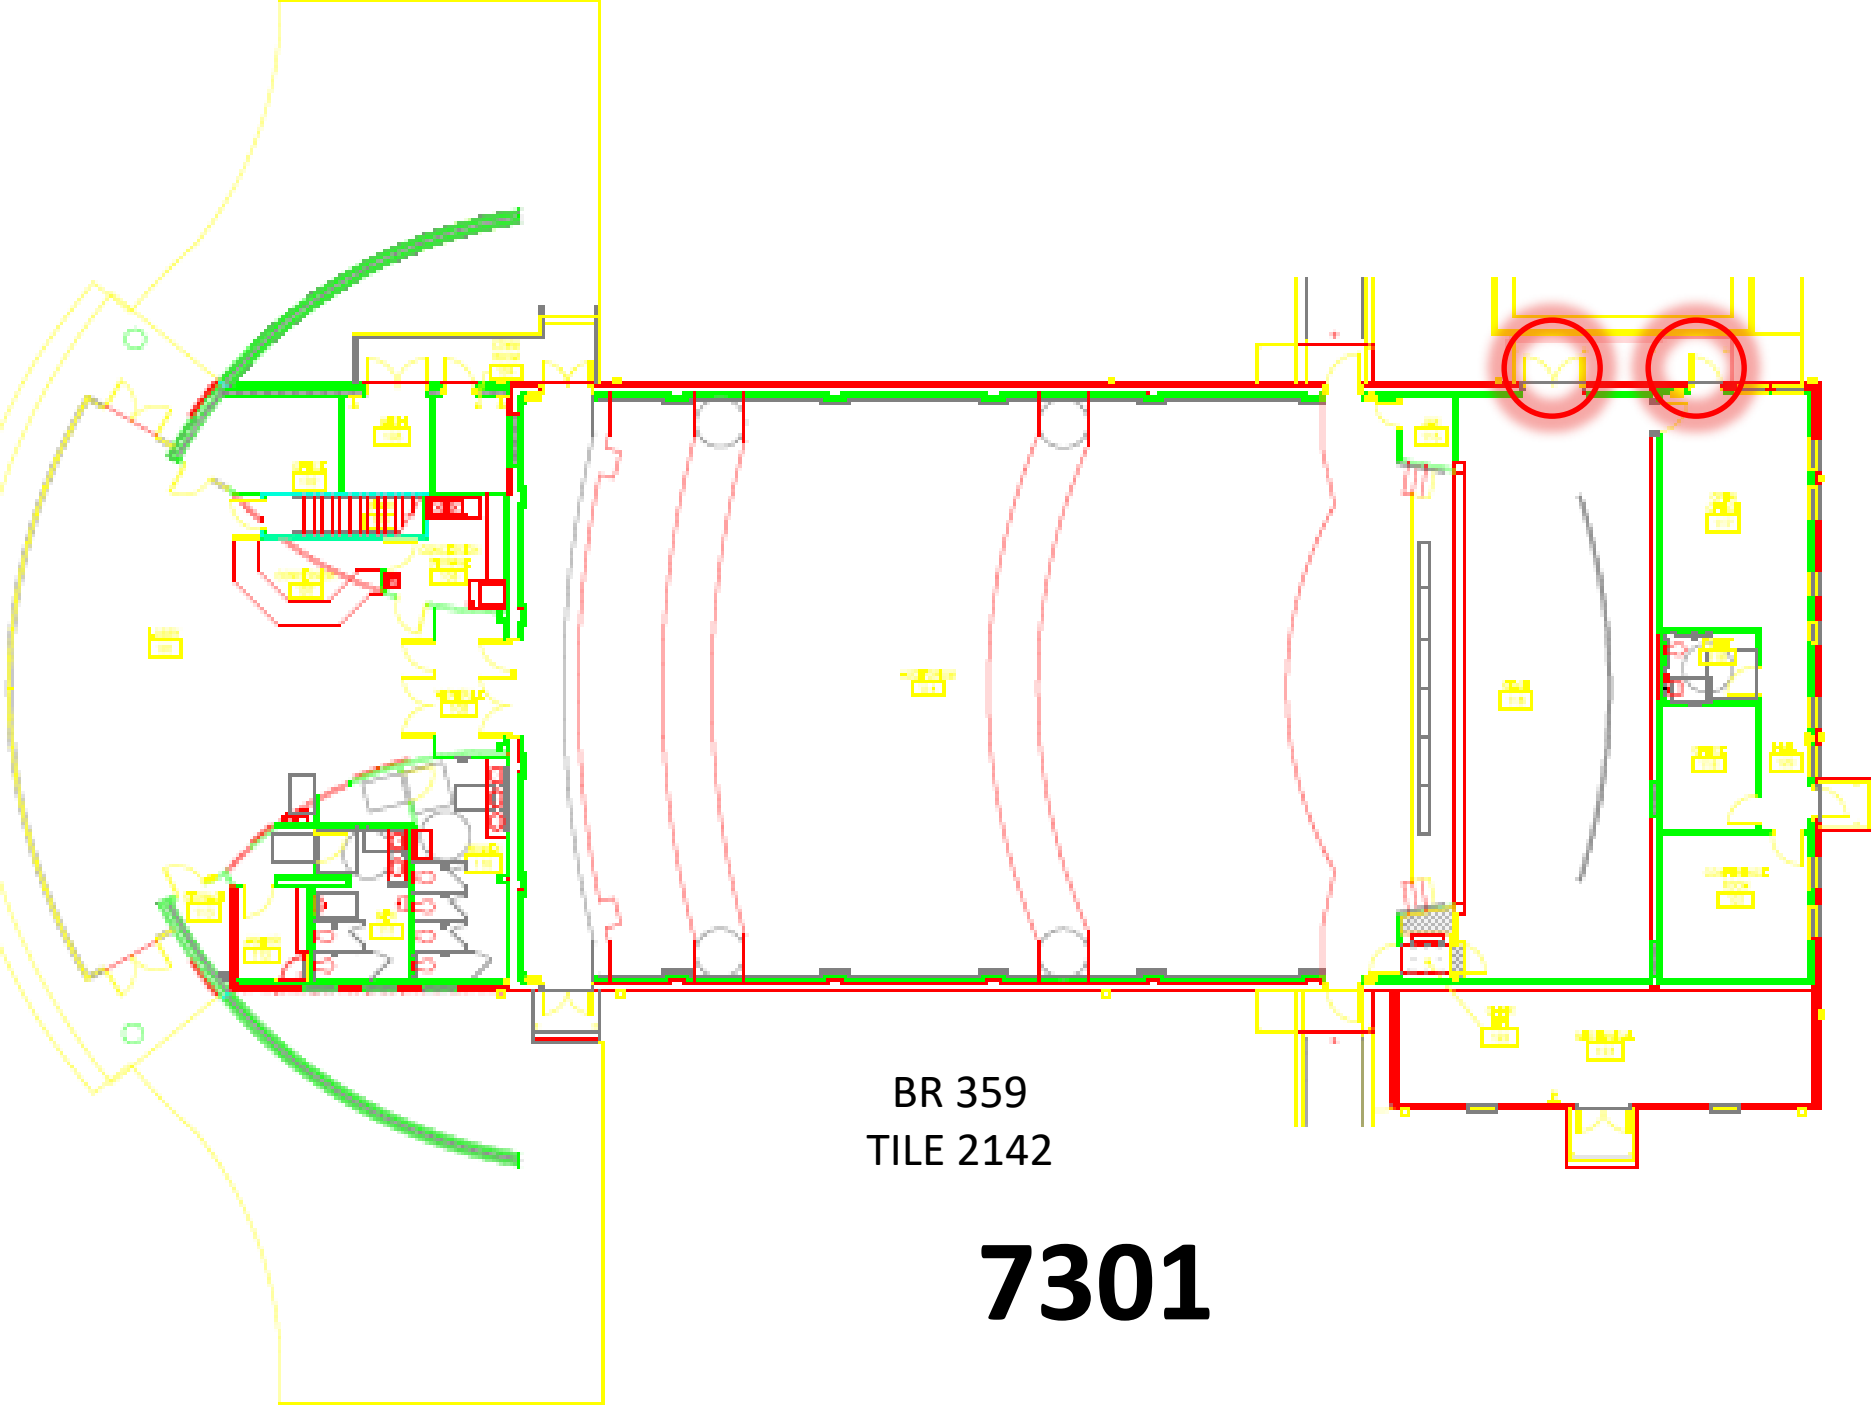

BR 359
TILE 2142

7301

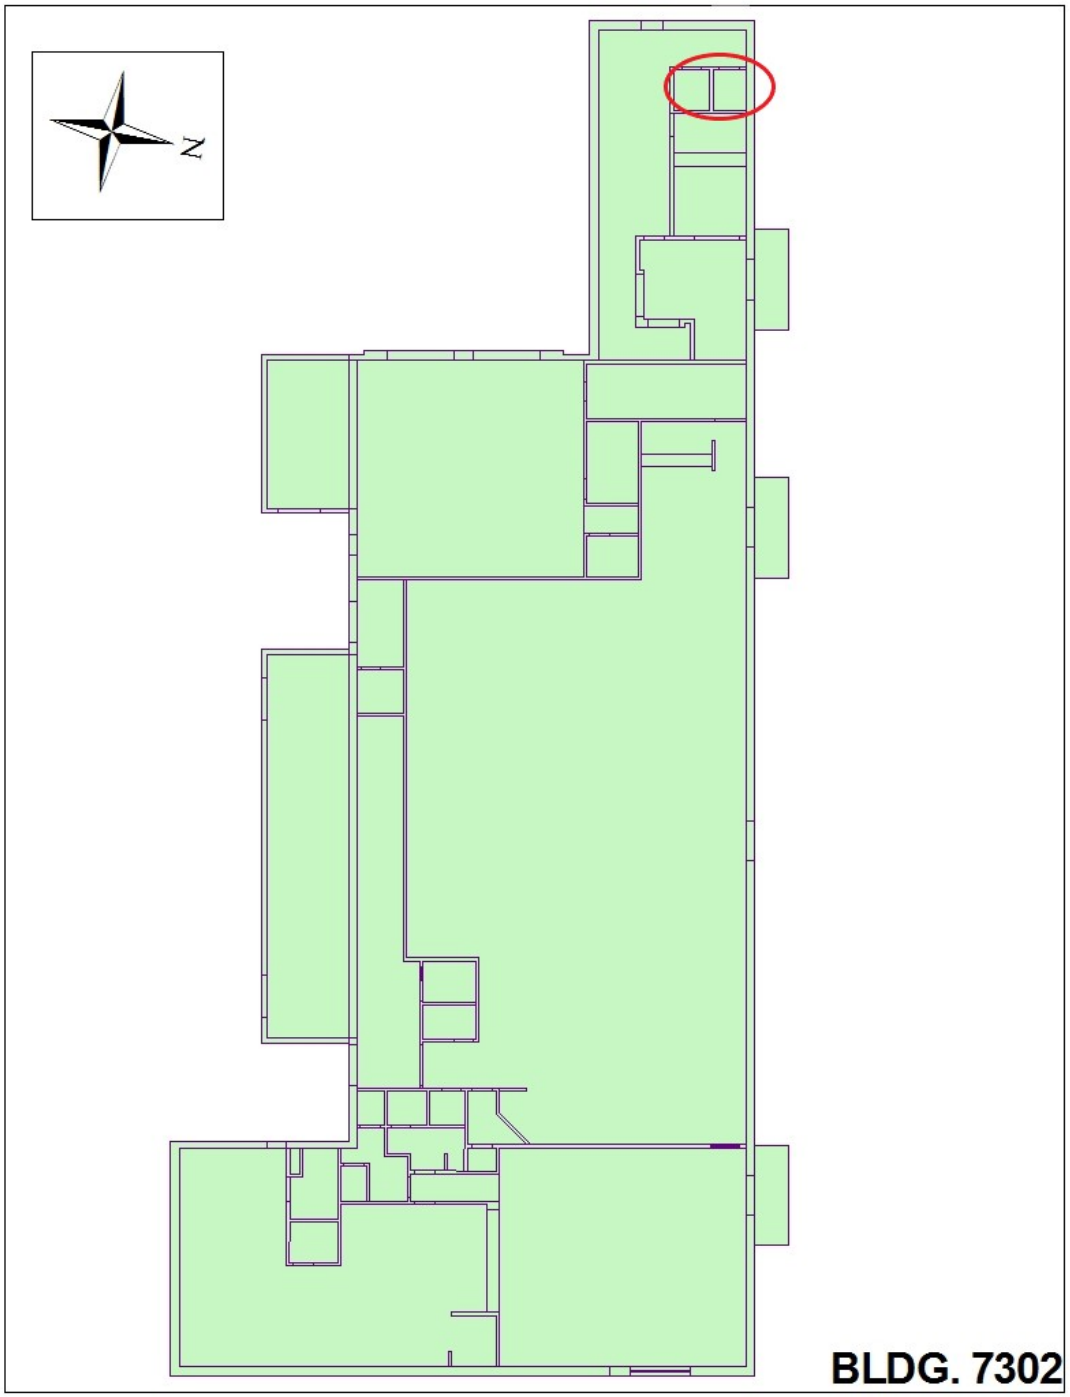

BR 36

N

FLOOR PLAN: BLDG 7312
217 AVE C 217 AVE C

Tile=685.6
Carpet=1009.4
BR = 220.3
Total =1915.3

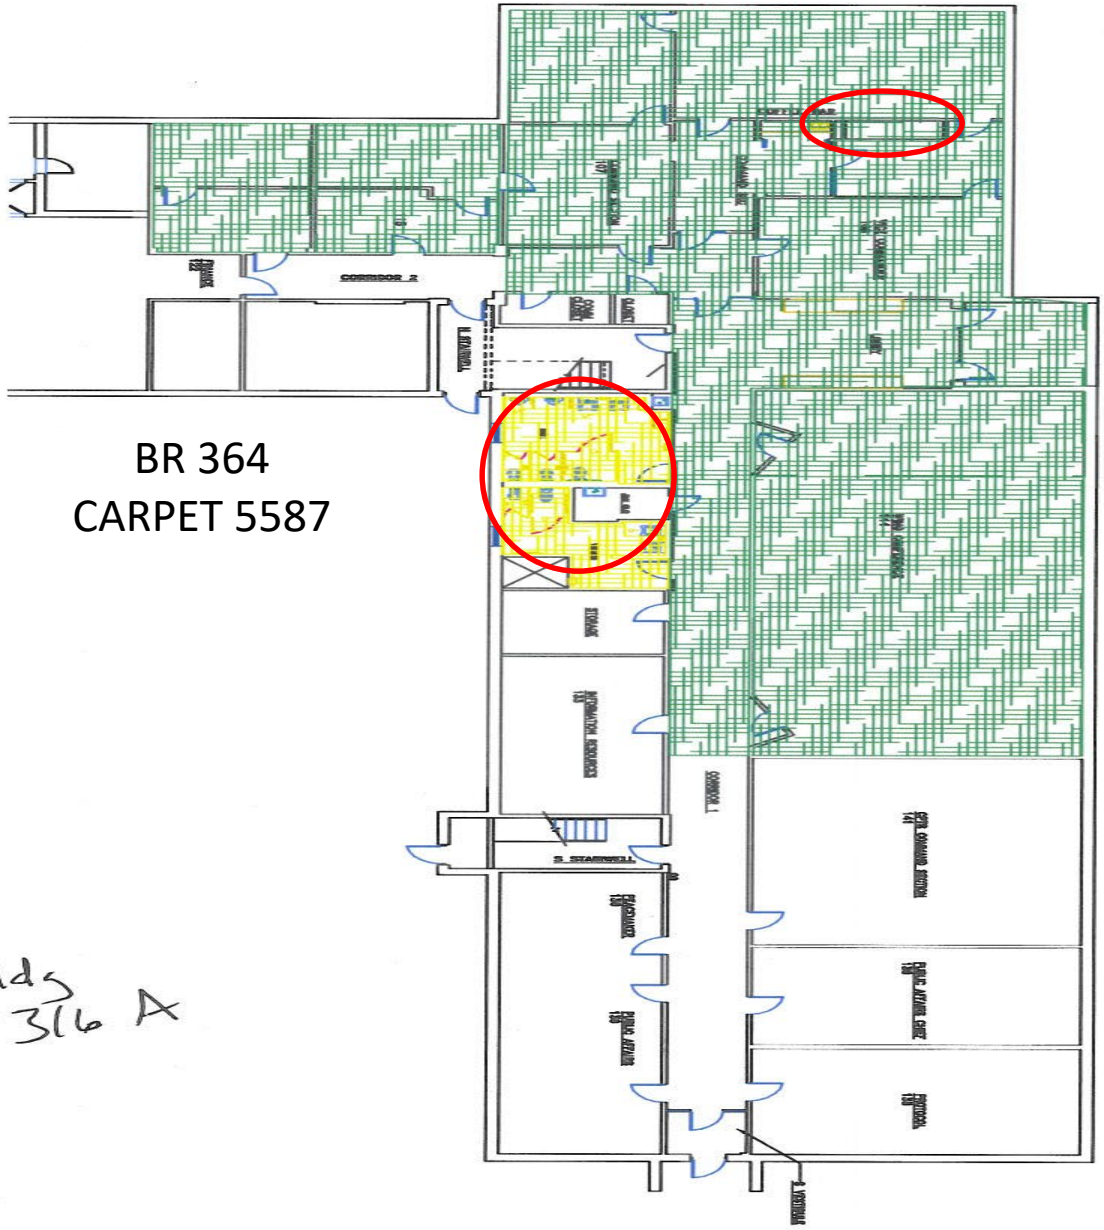
BR 364
CARPET 5587
NORTH
Bldg
7316 A

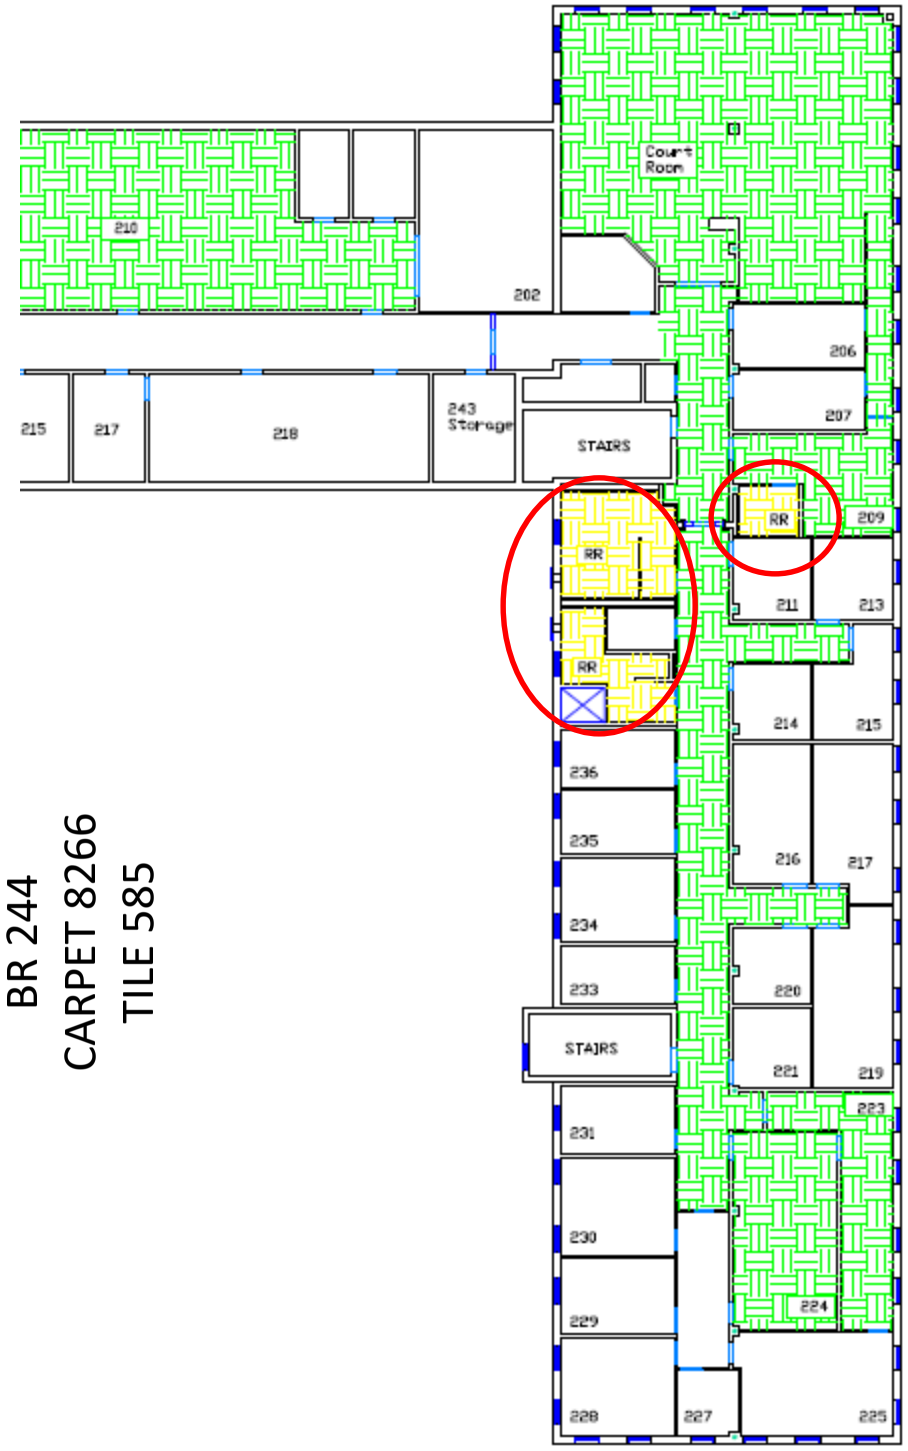

BR 244
CARPET 8266
TILE 585

7316 2nd Floor
(6240 sq.ft.)

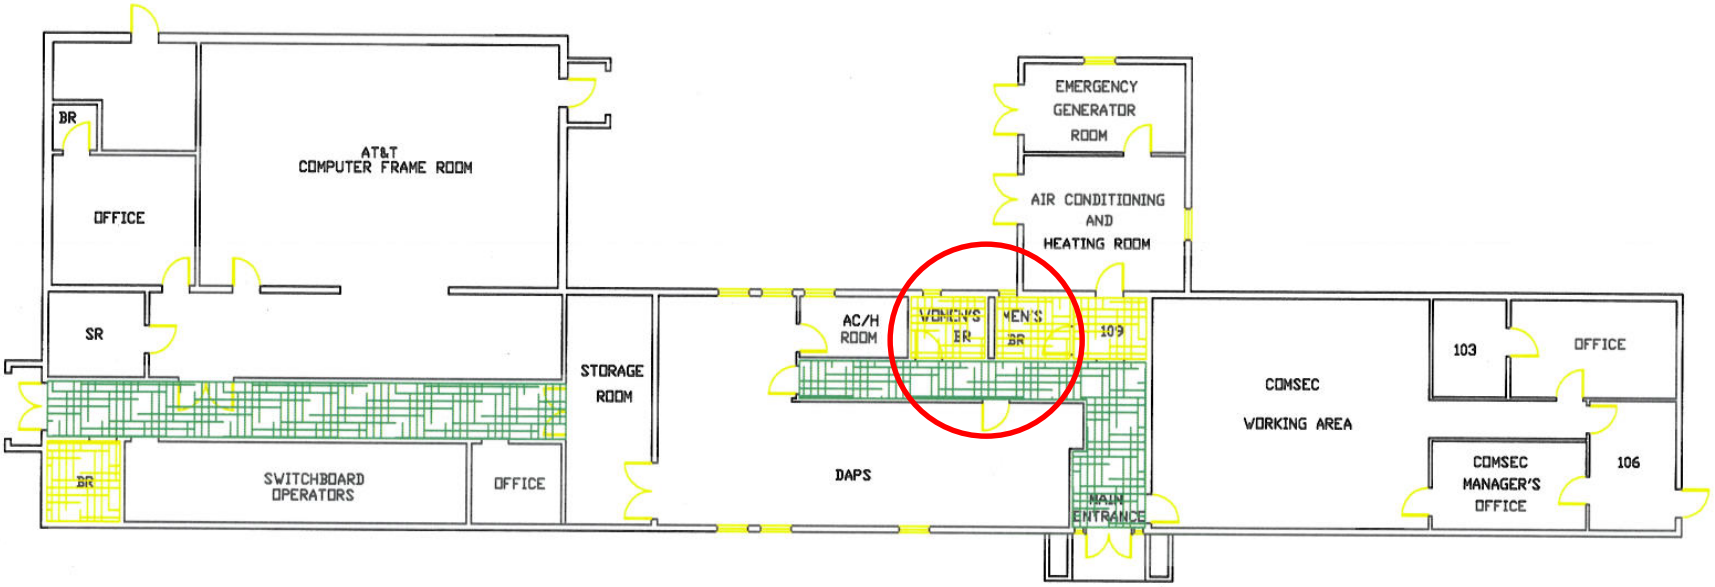

FLOOR PLAN BLDG. 7318

BR 174
CARPET 461
TILE 871

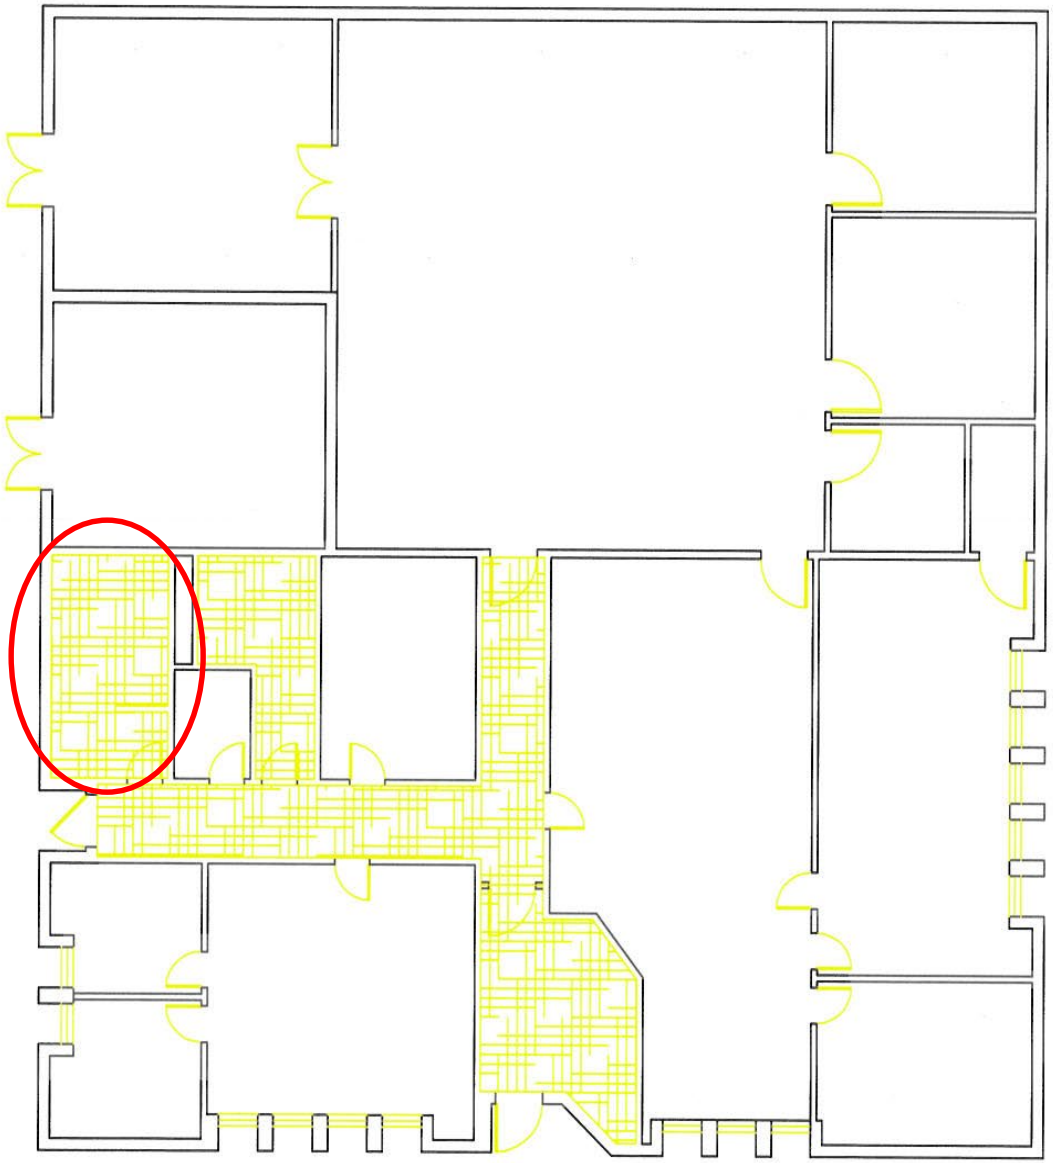

TILE = 553.3223
BR = 319.3293

TOTAL = 872.6516

BLDG 7320

7104
Level 4 Special
Rquirements

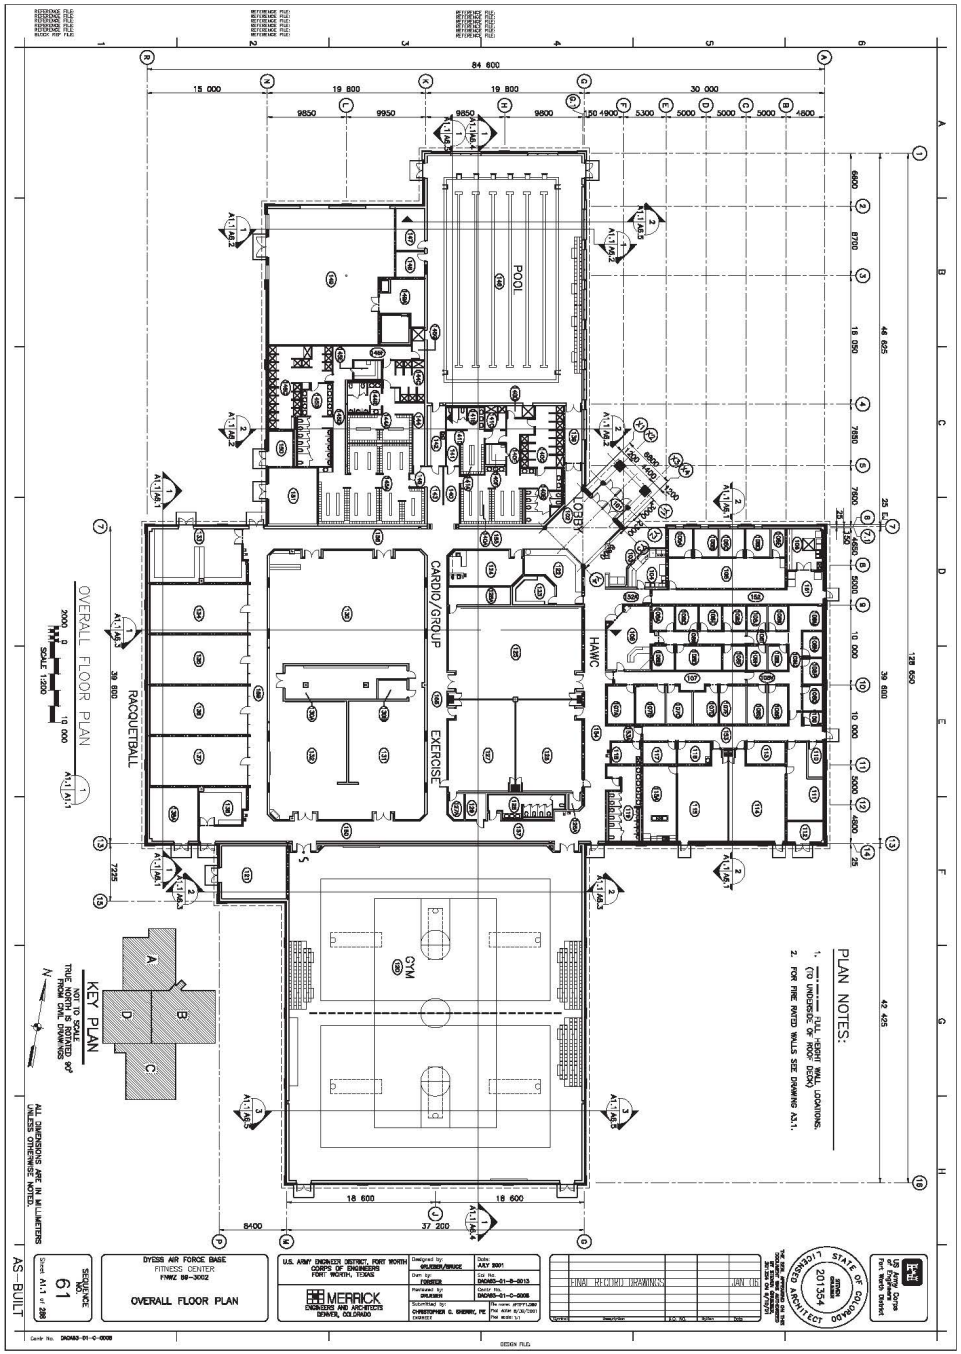

BR 164
CARPET 792
TILE 651

FLOOR PLAN BUILDING 7416

B

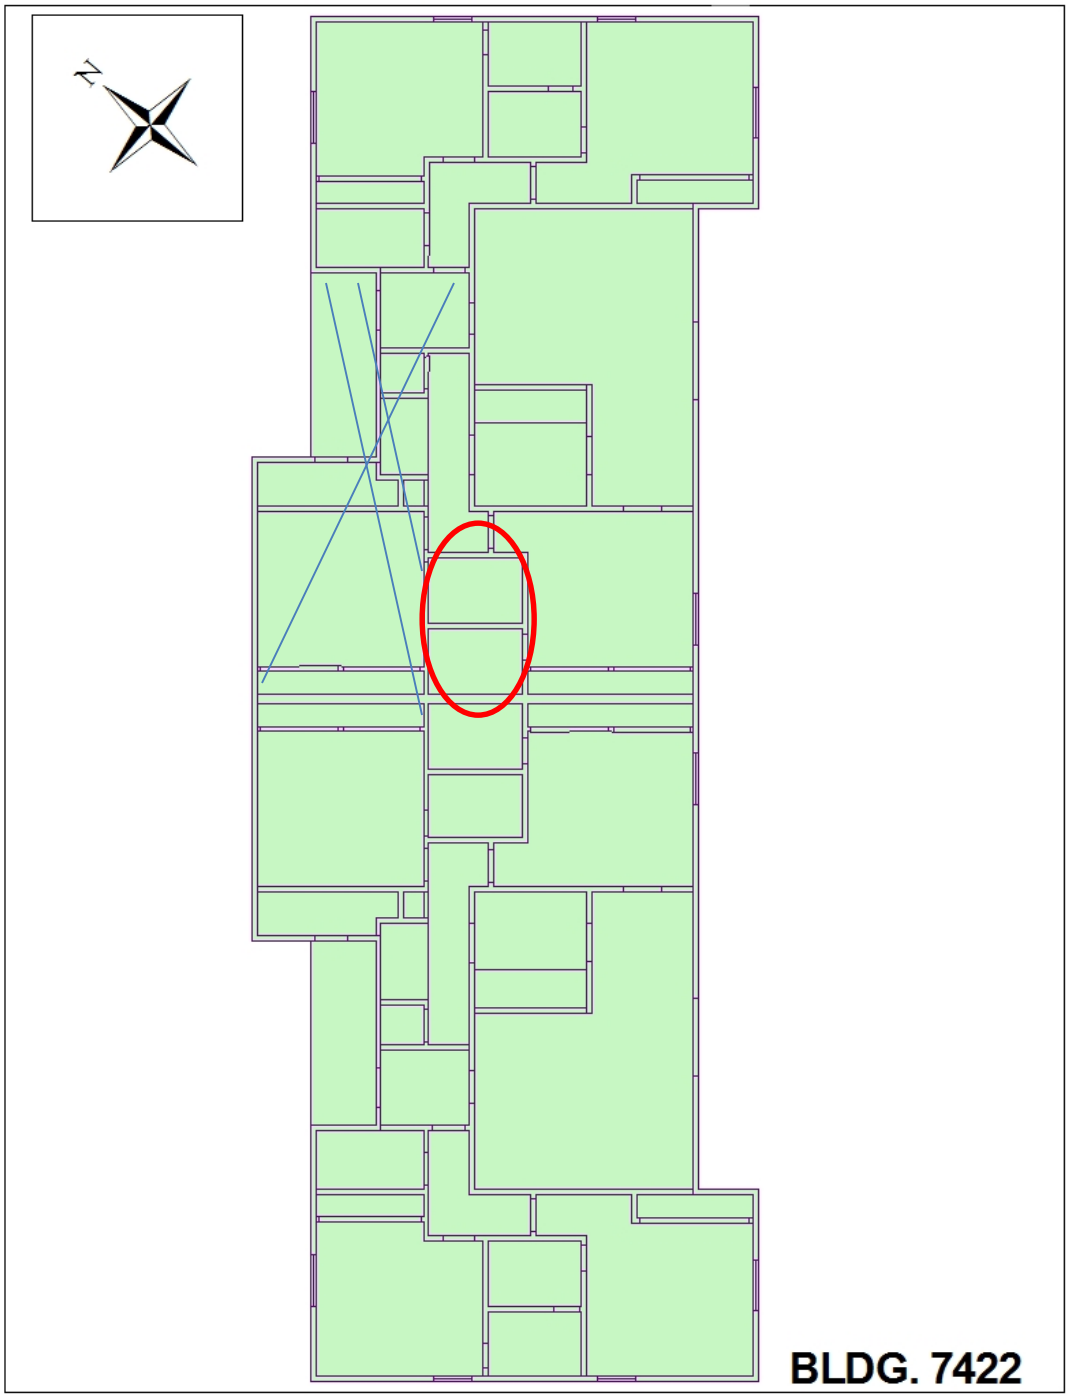

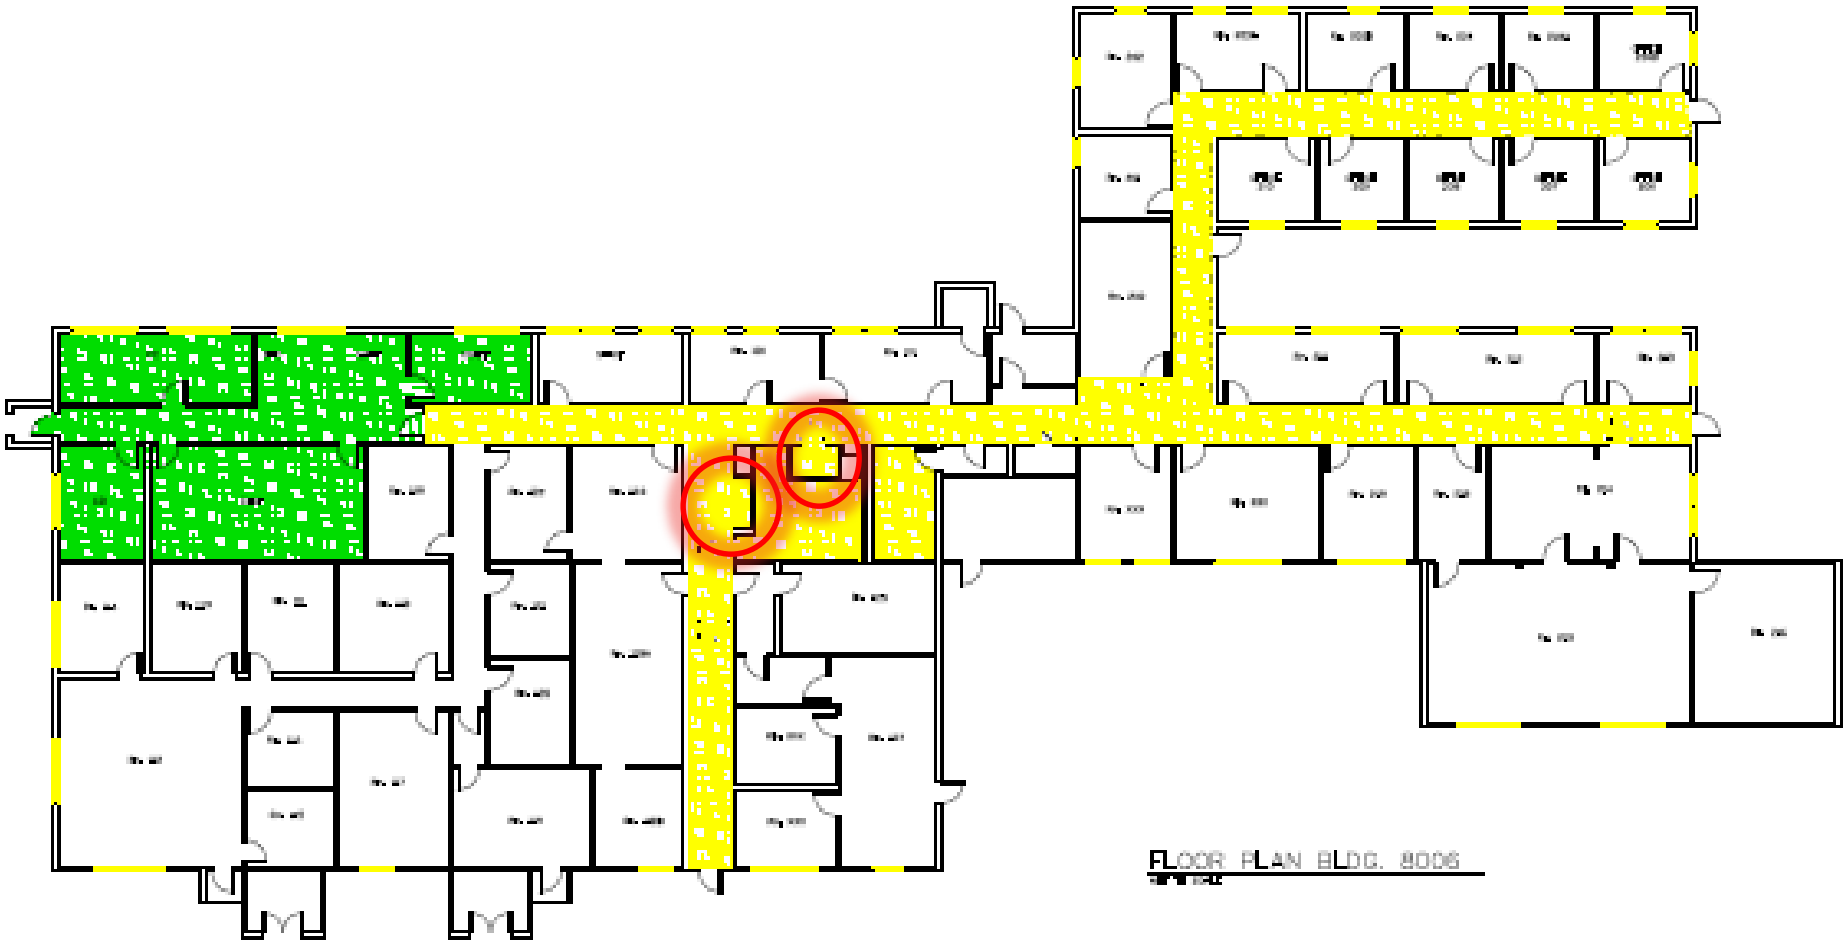

FLOOR PLAN BLDG. 8006

TILE	=	1,810.8841
CARPET	=	1,293.9400
RESTROOMS	=	275.8889
TOTAL	=	3,380.7130

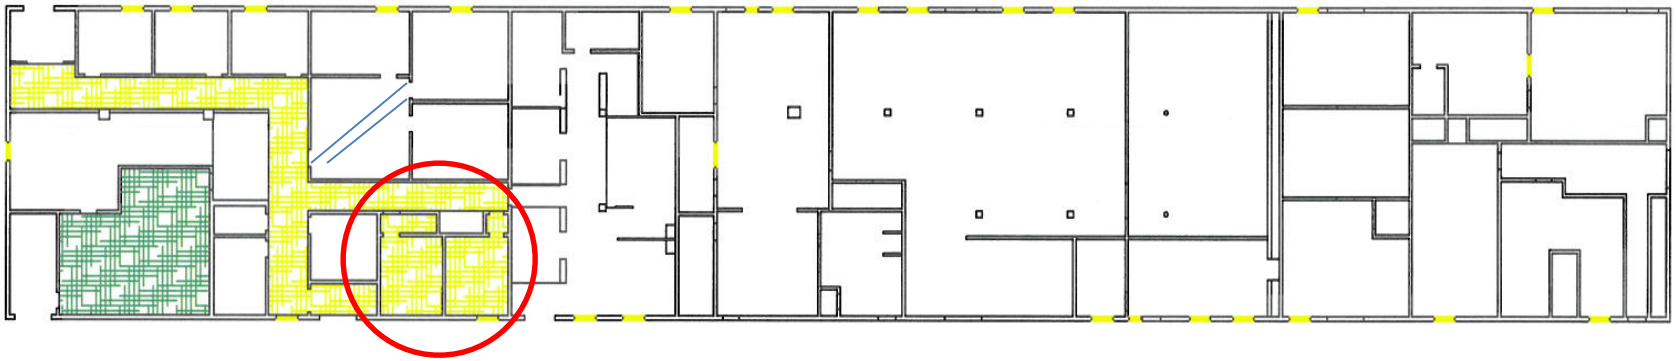

BR 280
CARPET 2657

FLOOR PLAN BLDG. 8008
SCALE: 3/32"=1'-0"

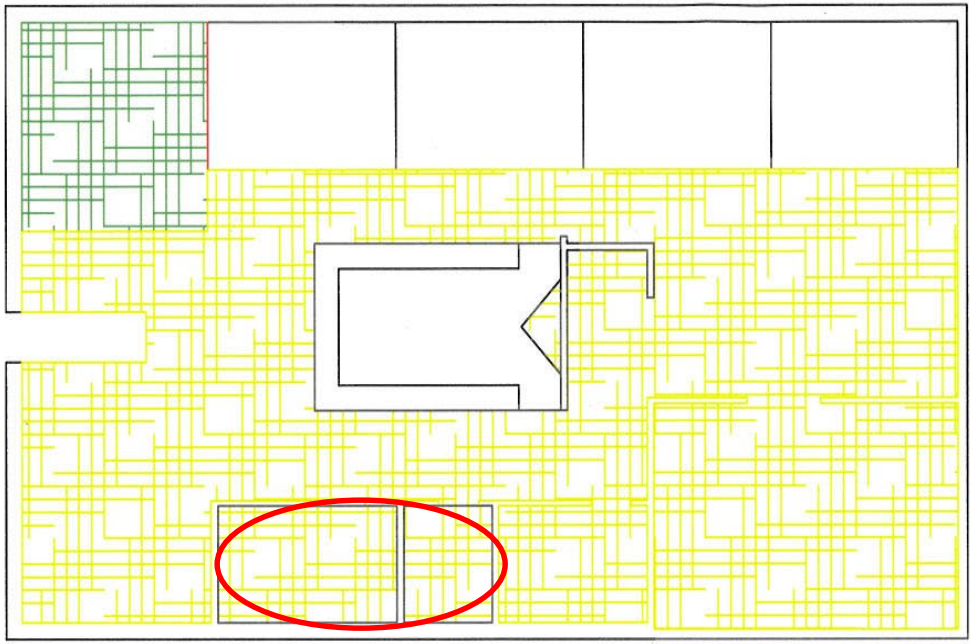

FLOORPLAN BLDG 8011

TILE = 985.5416

CARPET= 144.7917

BR = 116.6667

TOTAL = 1247

CARPET : 0
TILE : 0
BR : 581

TOTAL : 581

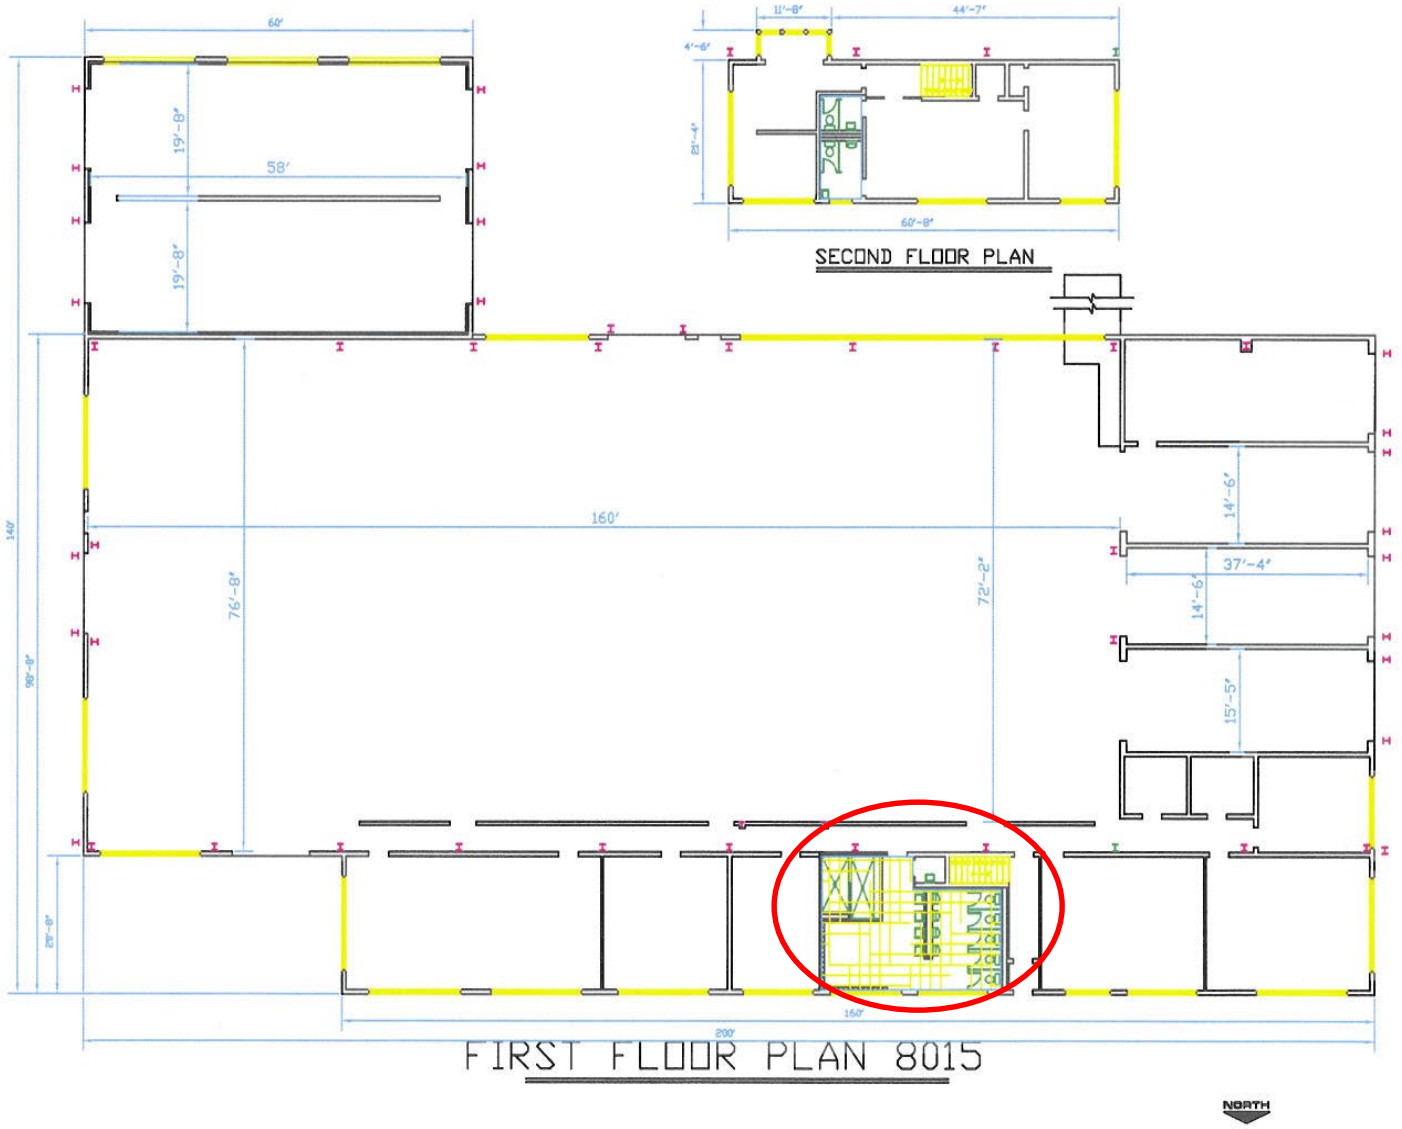

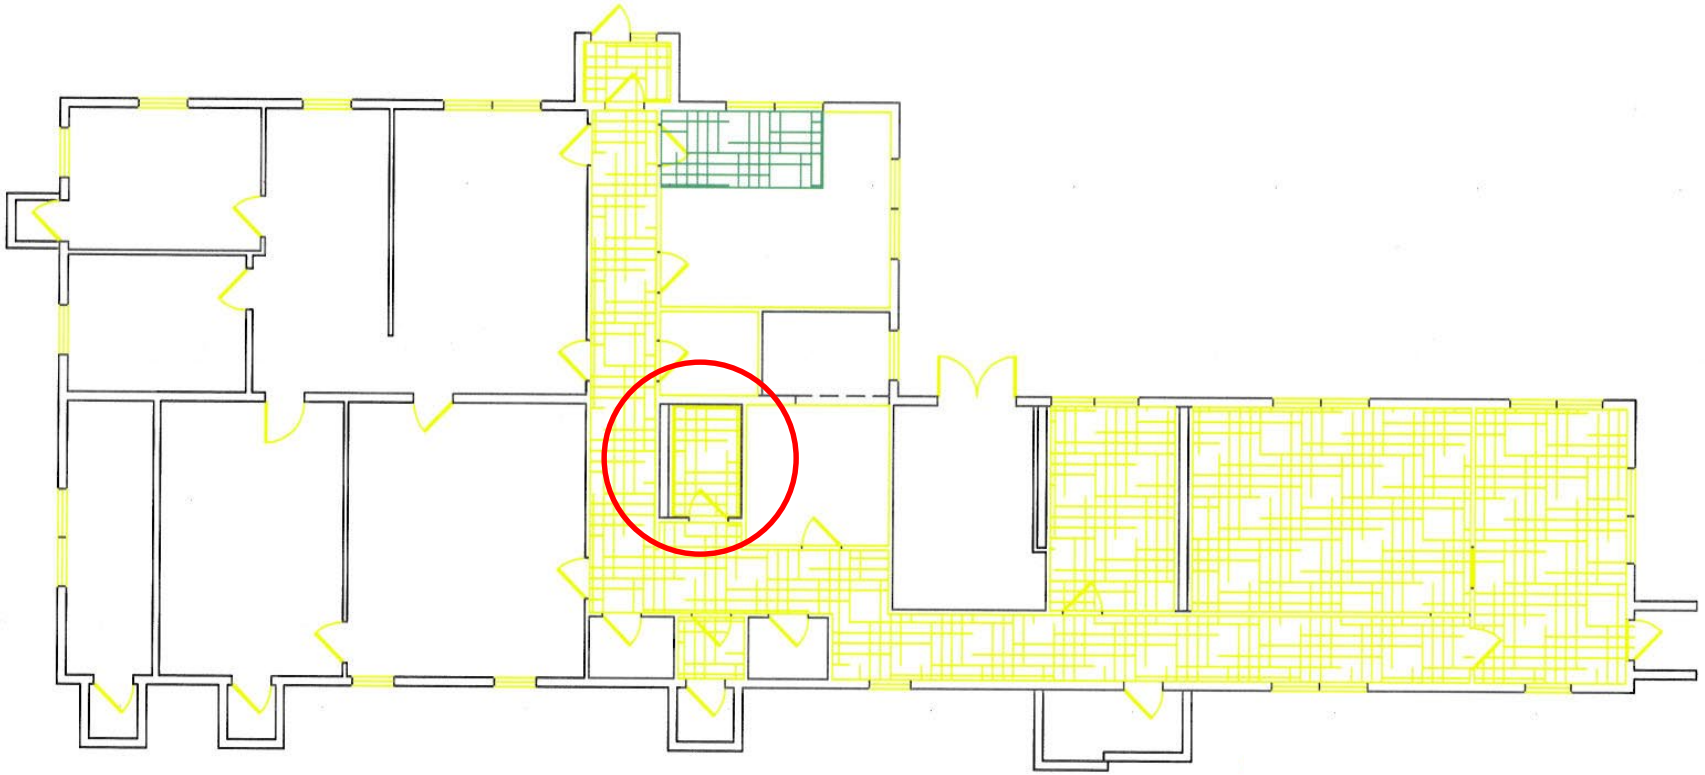

BR 184
TILE 1090

FLOOR PLAN BLDG. 8016

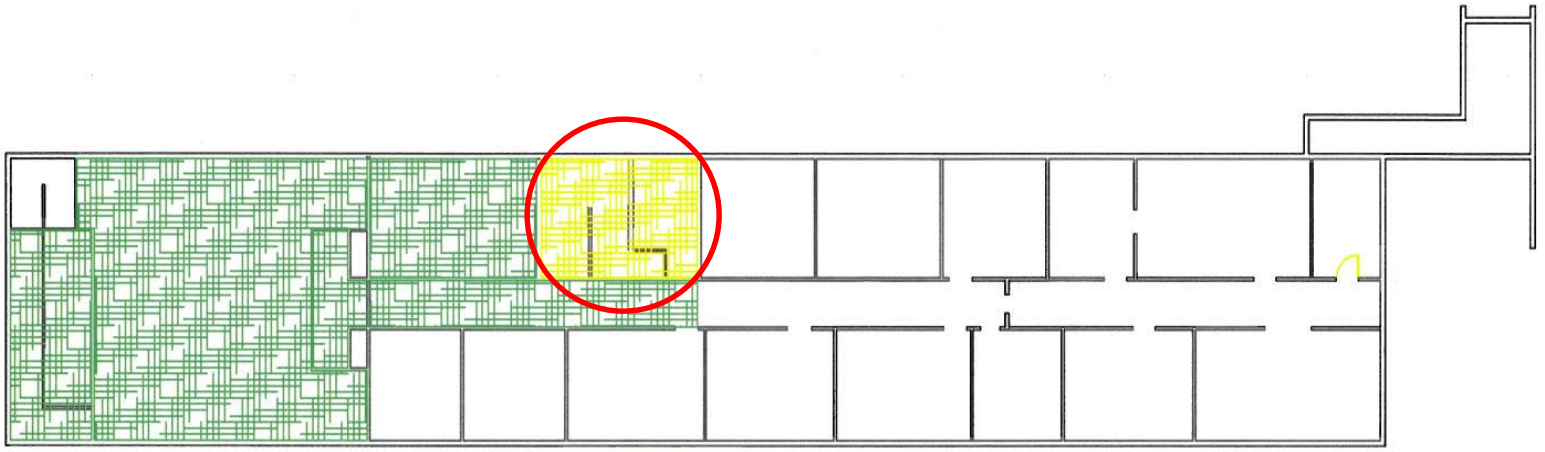

2nd FLOOR PLAN

TILE = 1243.7029
CARPET = 2983.5833
BR = 636.3333

TOTAL = 4863.6195

1st FLOOR PLAN

BLDG. 8030
SCALE: 1/8"=1'-0"

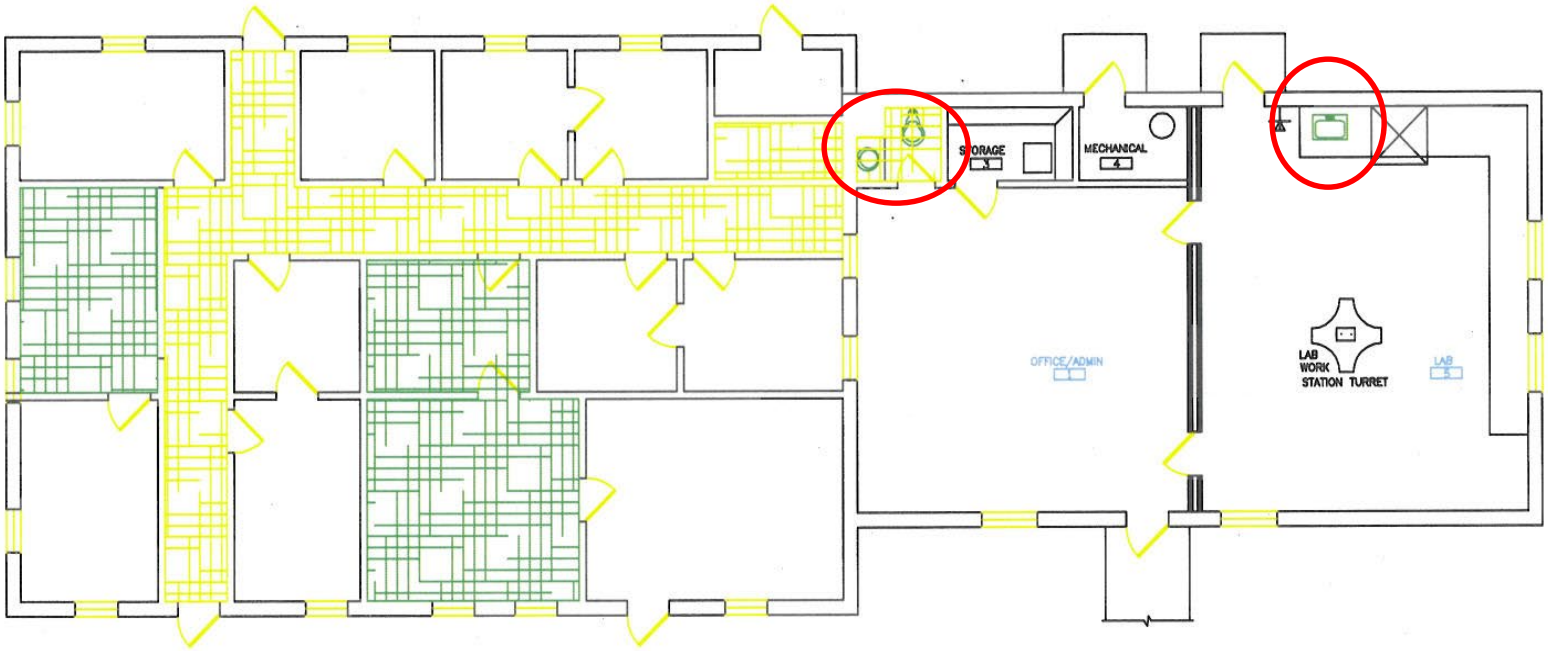

FLOOR PLAN BLDG 8080

SCALE: 1/4" = 1'-0"

CARPET = 450.8472

TILE = 402.3194

BR= 26

Total = 879.1666

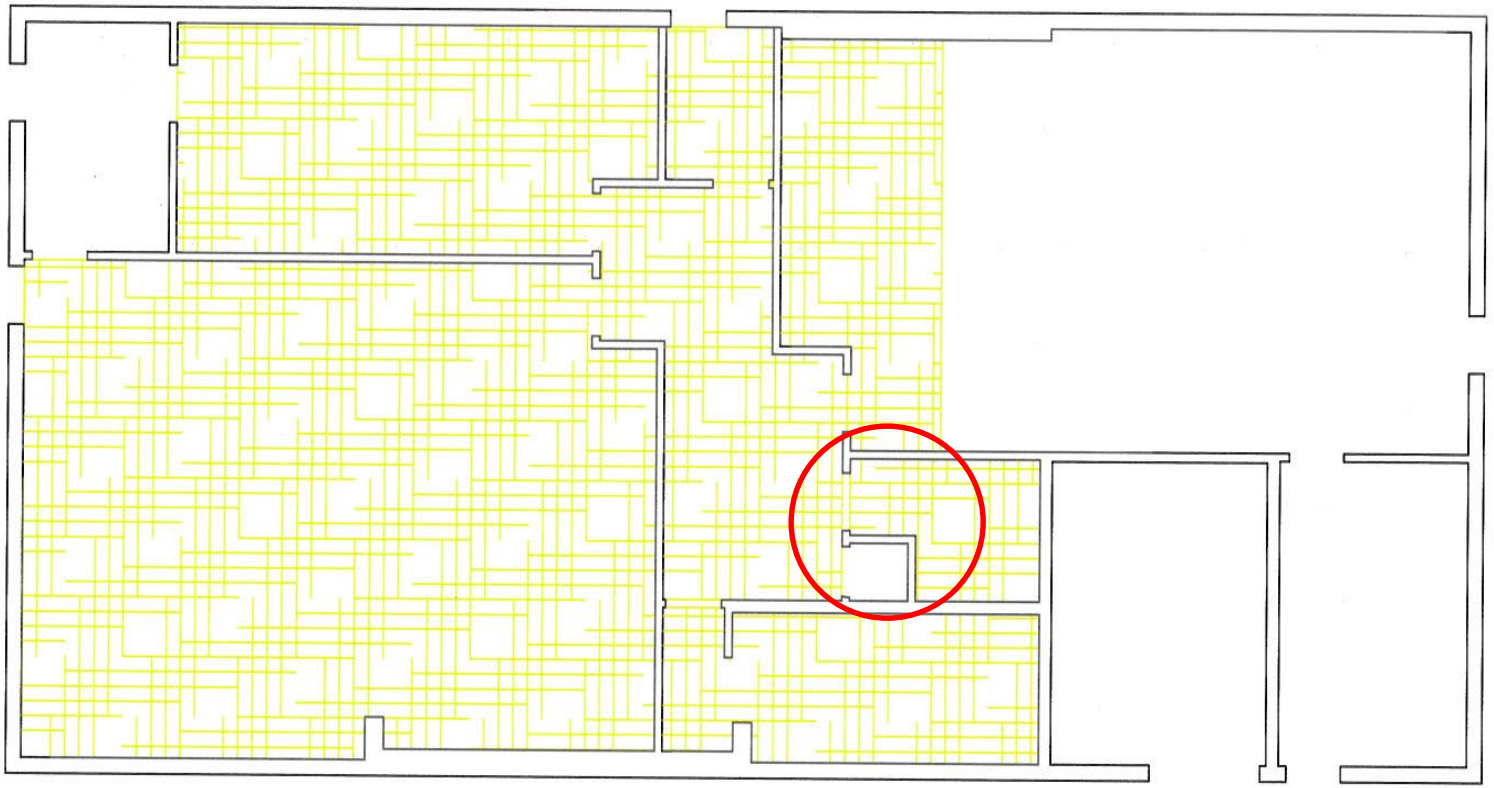

TILE: 1580.6

CARPET = 0

BR = 219.9

BLDG 8119

TOTAL =1800.5

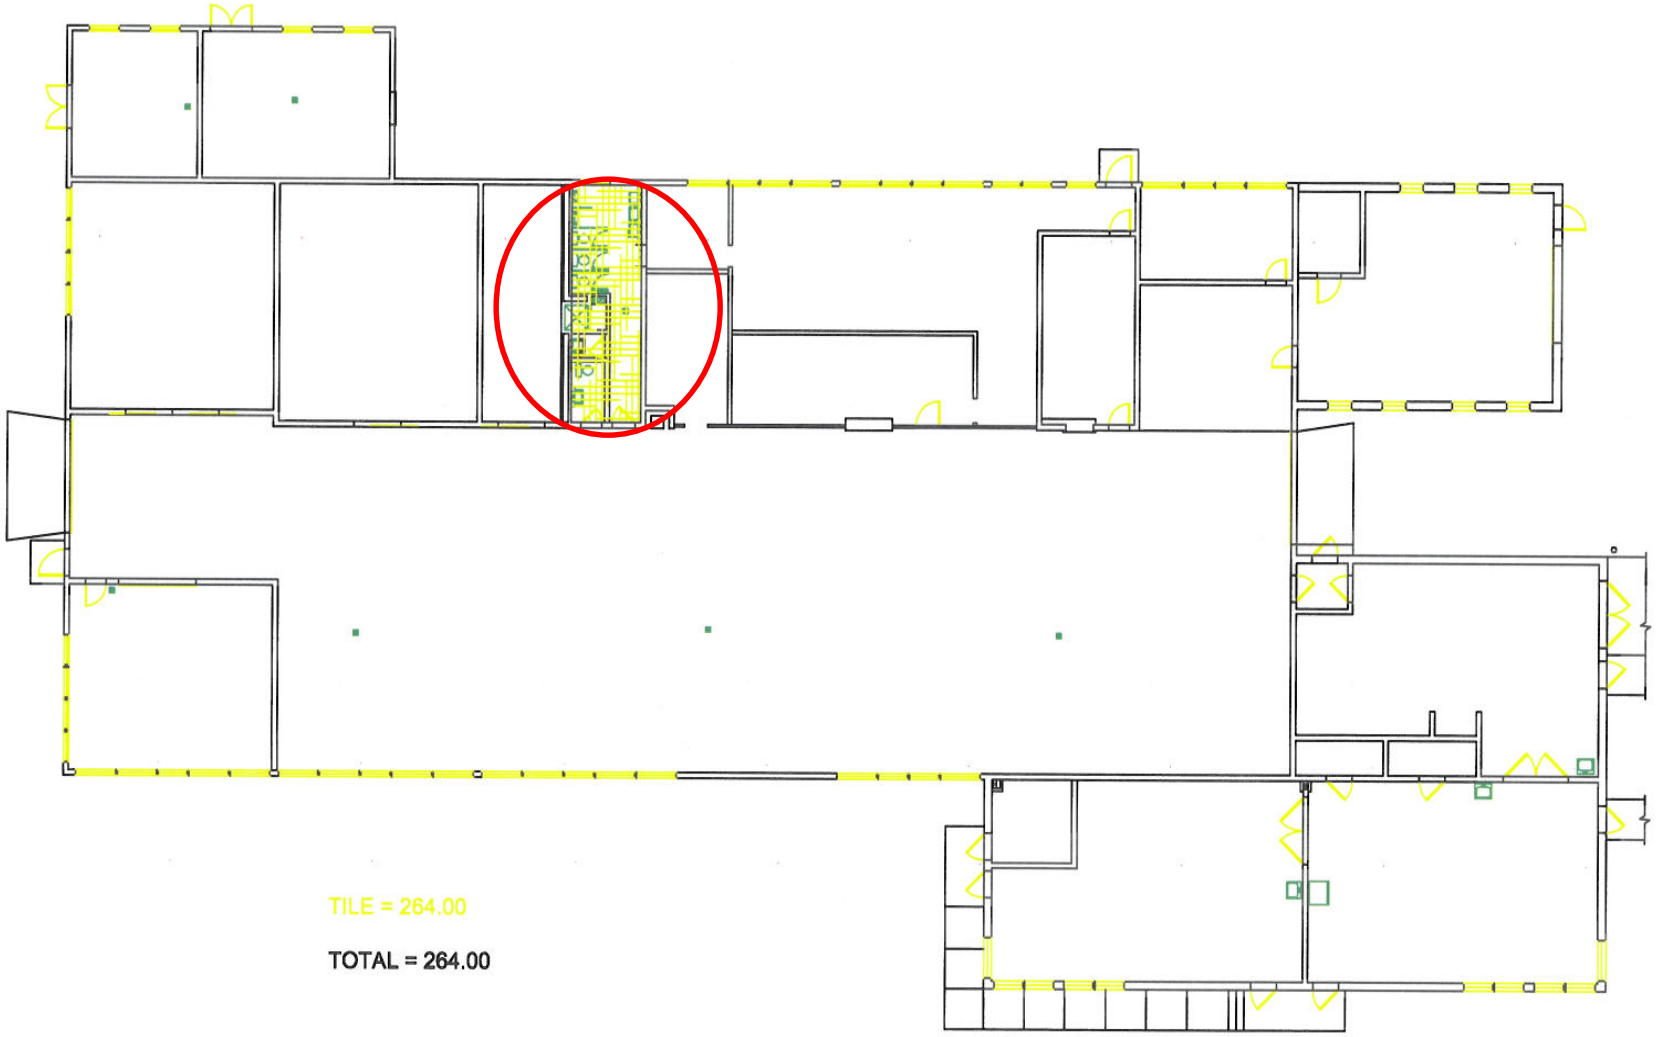

FLOOR PLAN BLDG. 8130

SCALE : 1/8" = 1'-0"

BR 558

8140

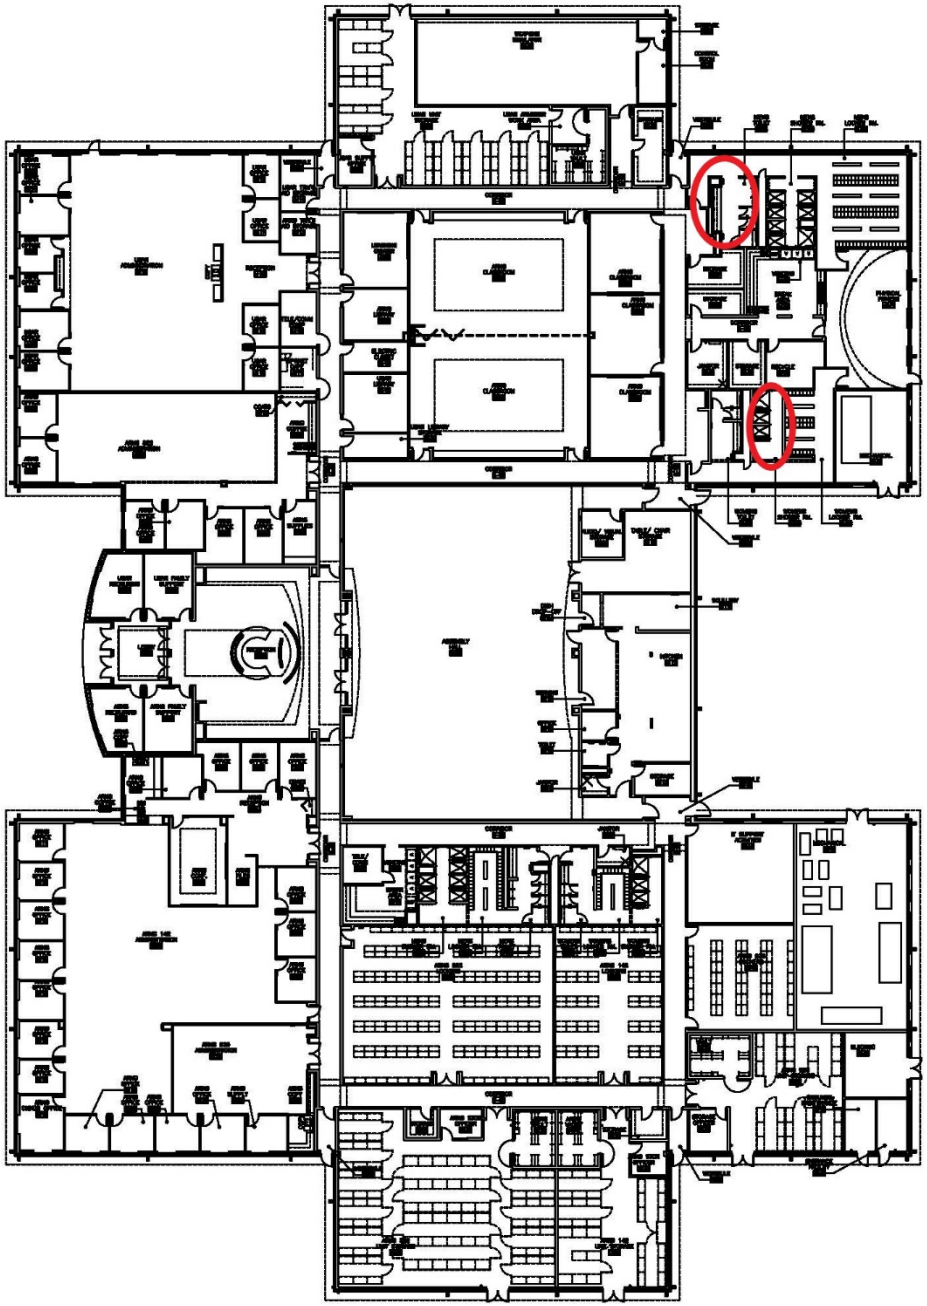

Level 4 Special requirement cleaning
BR 160
Carpet 8650
Tile 6230

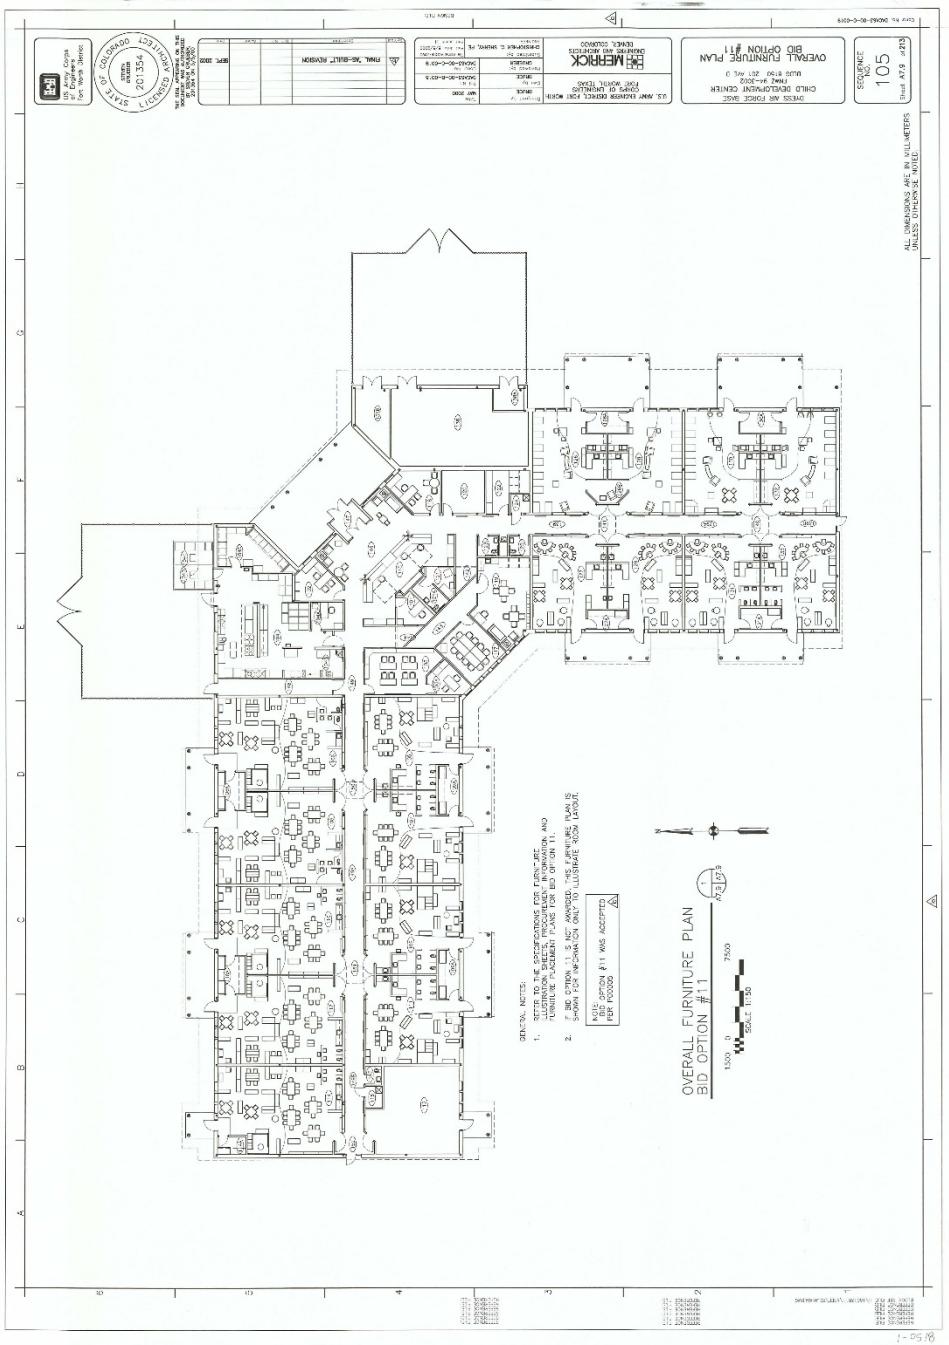

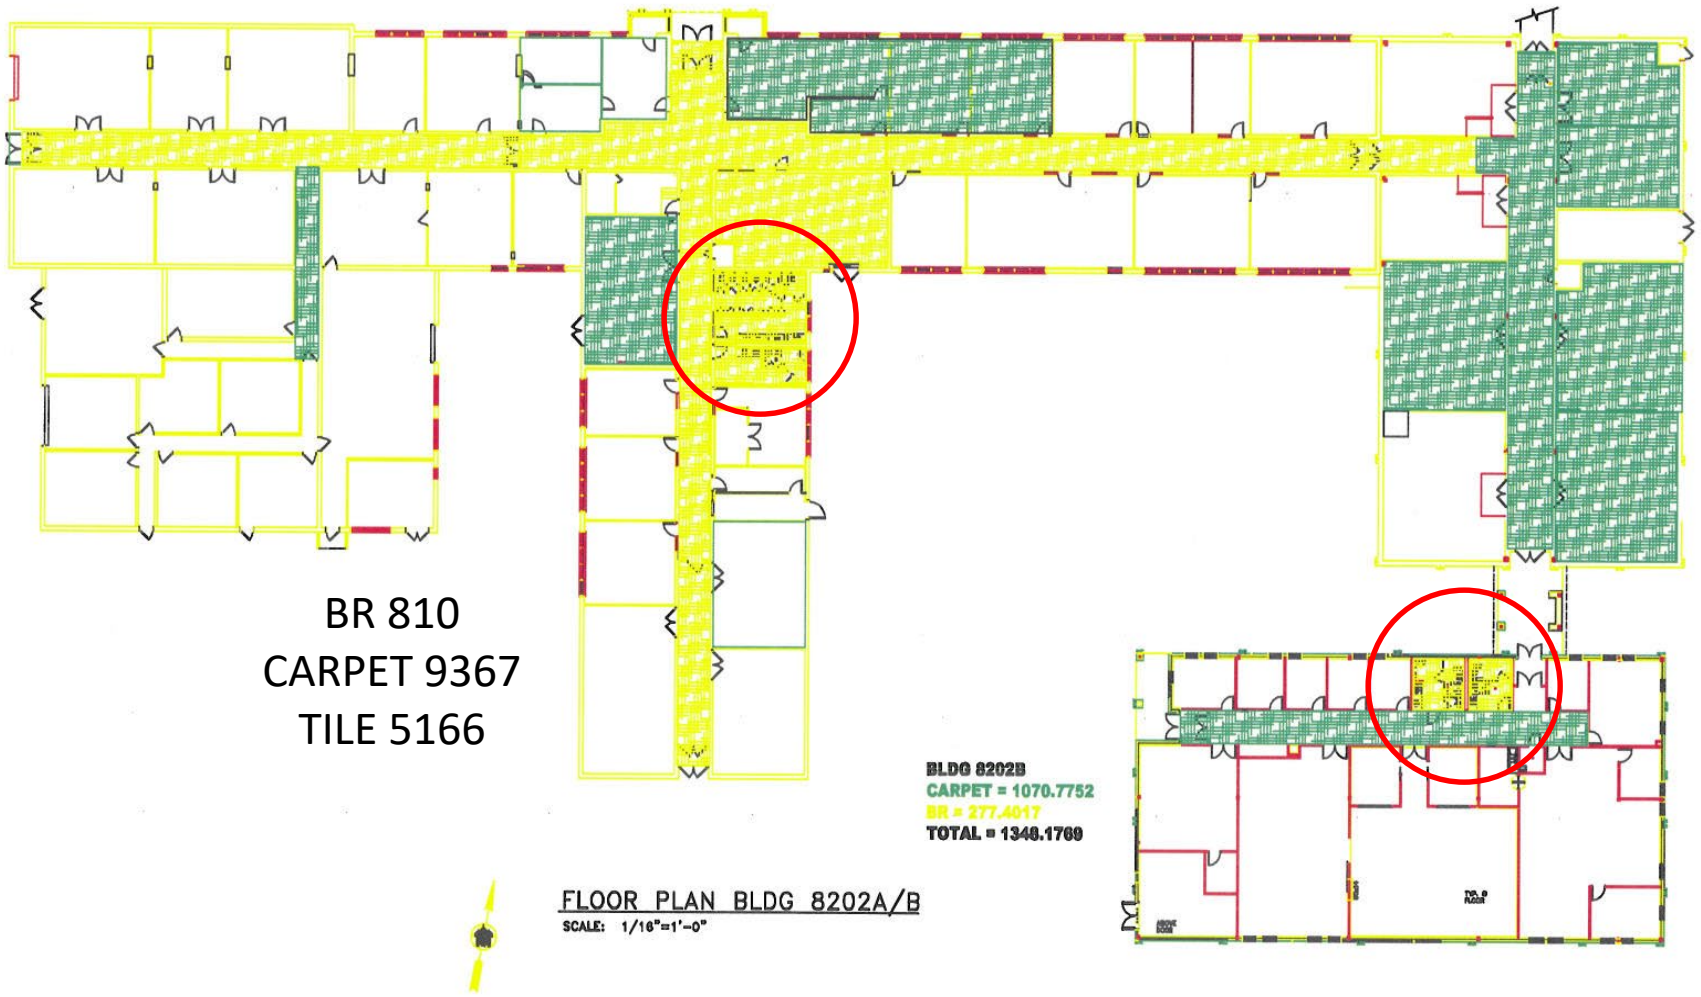
BR 810
CARPET 9367
TILE 5166
BLDG 8202B
CARPET = 1070.7752
BR = 277.4017
TOTAL = 1348.1769
FLOOR PLAN BLDG 8202A/B
SCALE: 1/16"=1'-0"

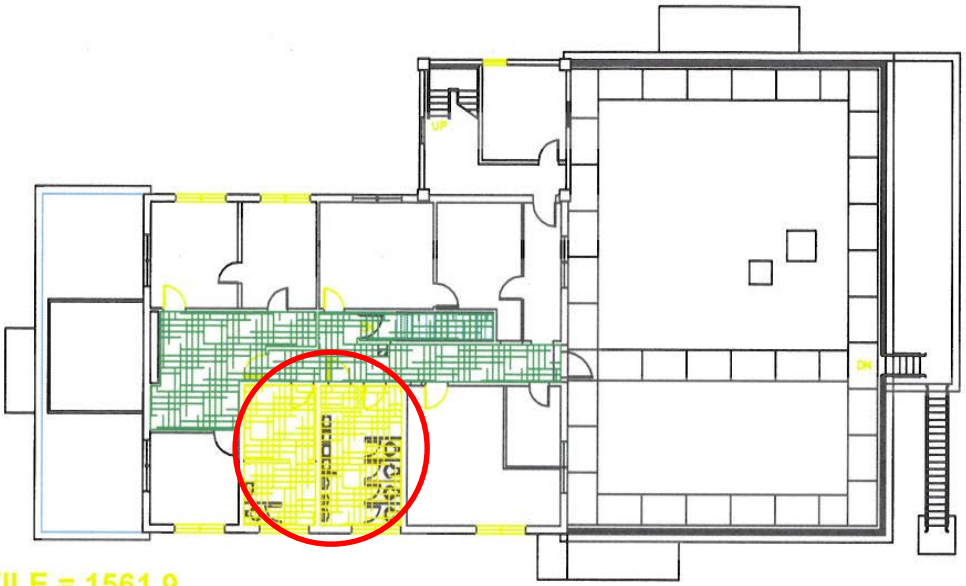

TILE = 1561.9
CARPET = 738.8
BR = 564.3

9001 2ND FLOOR

TOTAL = 2865.0

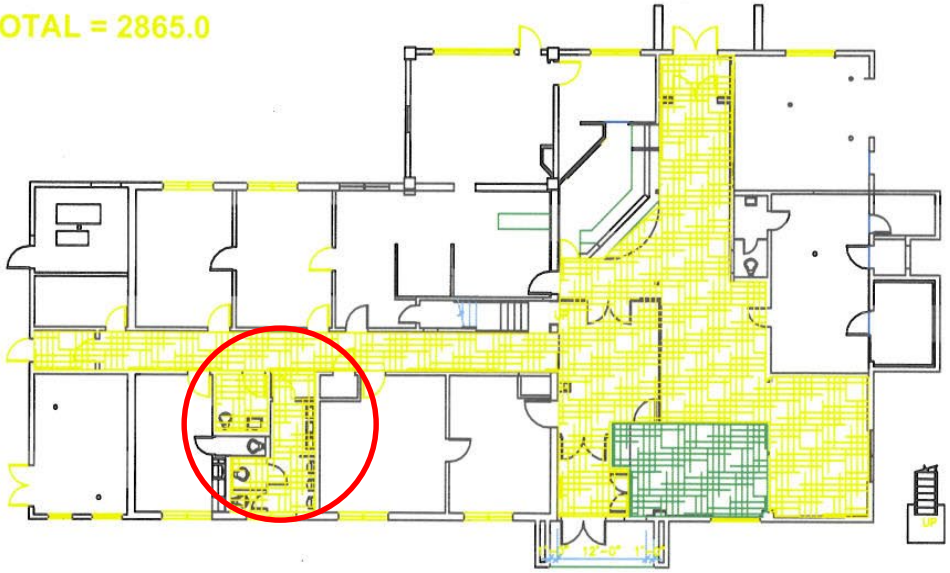

9001 1ST FLOOR

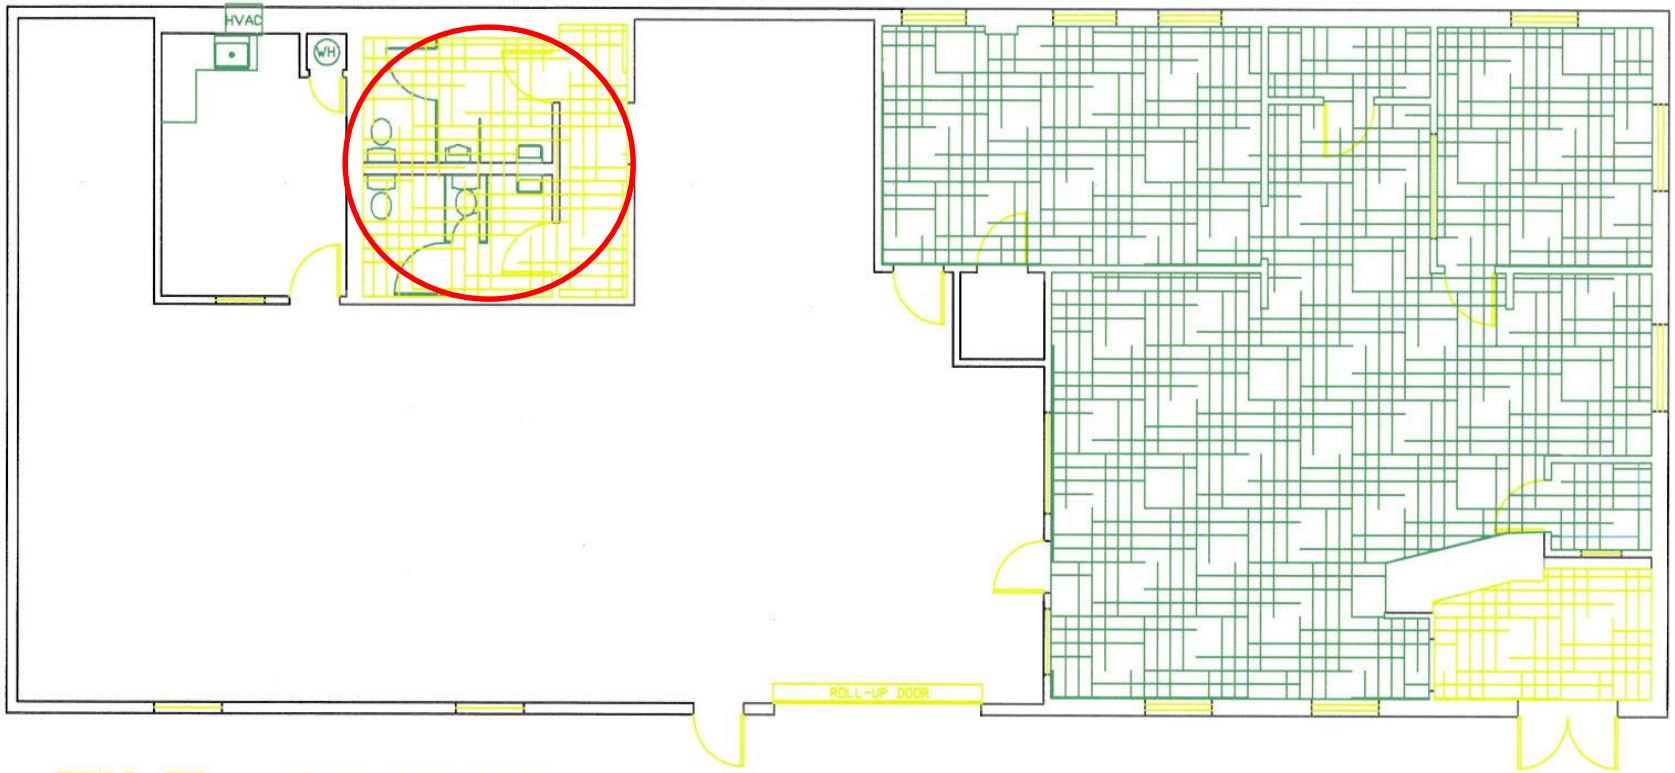

TILE = 90.9628

CARPET = 1371.5913

BR = 235.9536

TOTAL = 1698.5077

FLOOR PLAN, BLDG 9104
SCALE 1/4" = 1'-0"

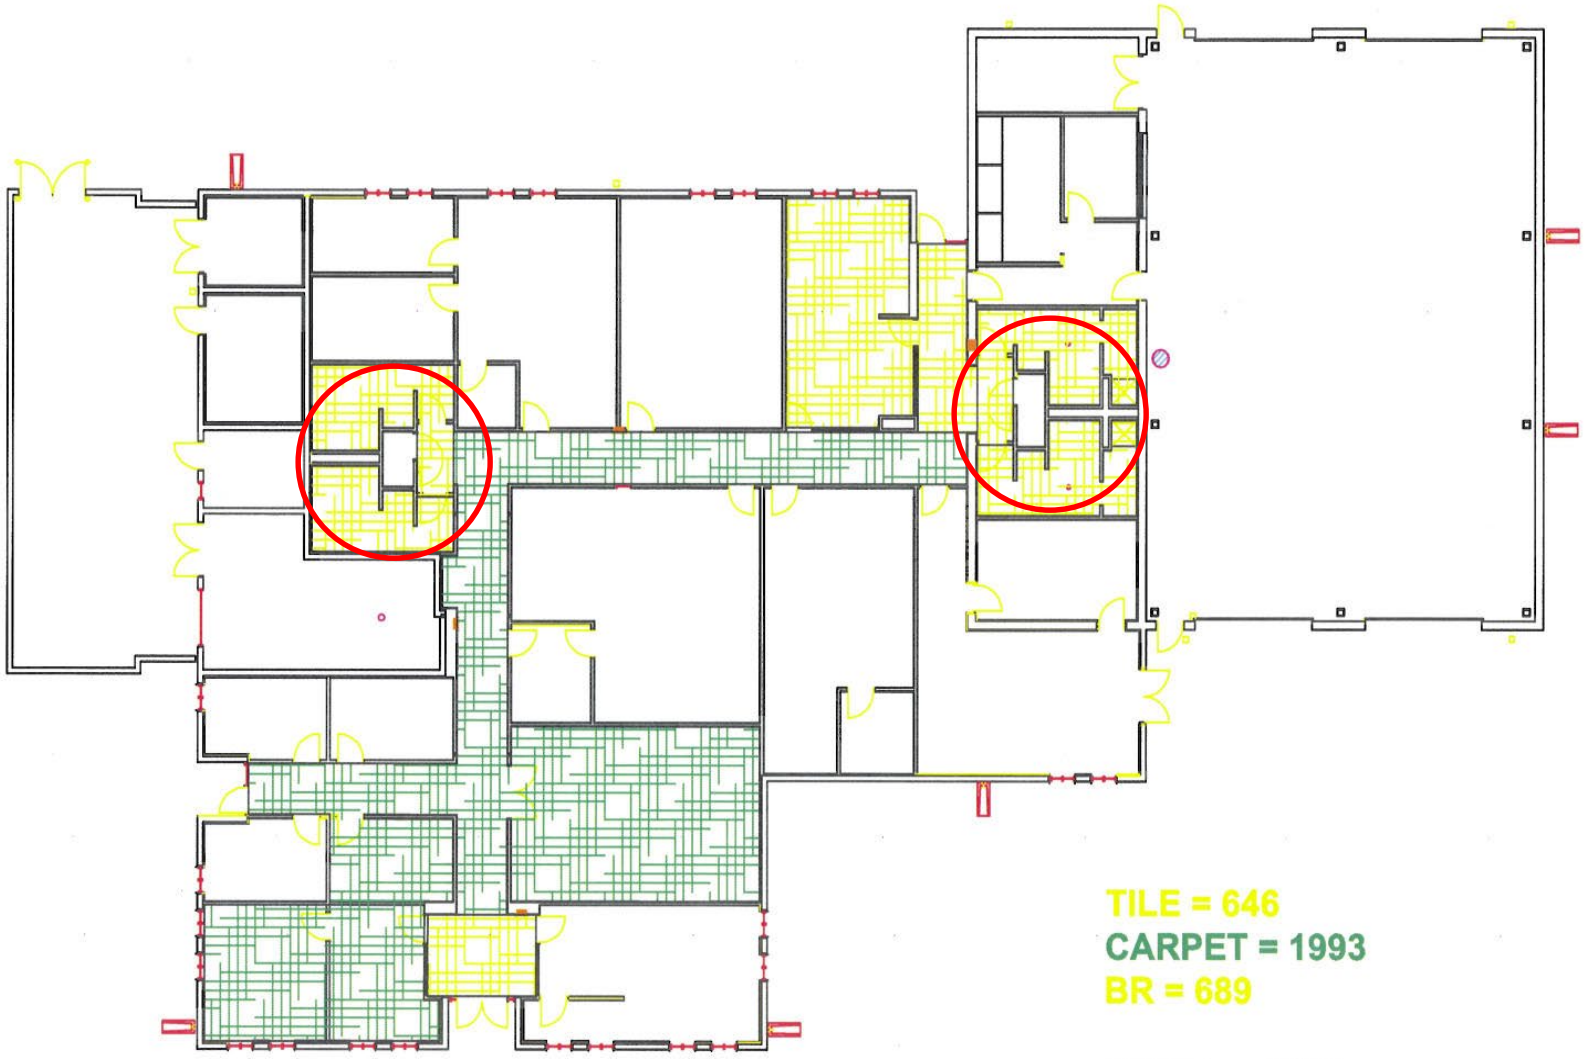

FLOOR PLAN BLDG. 9153

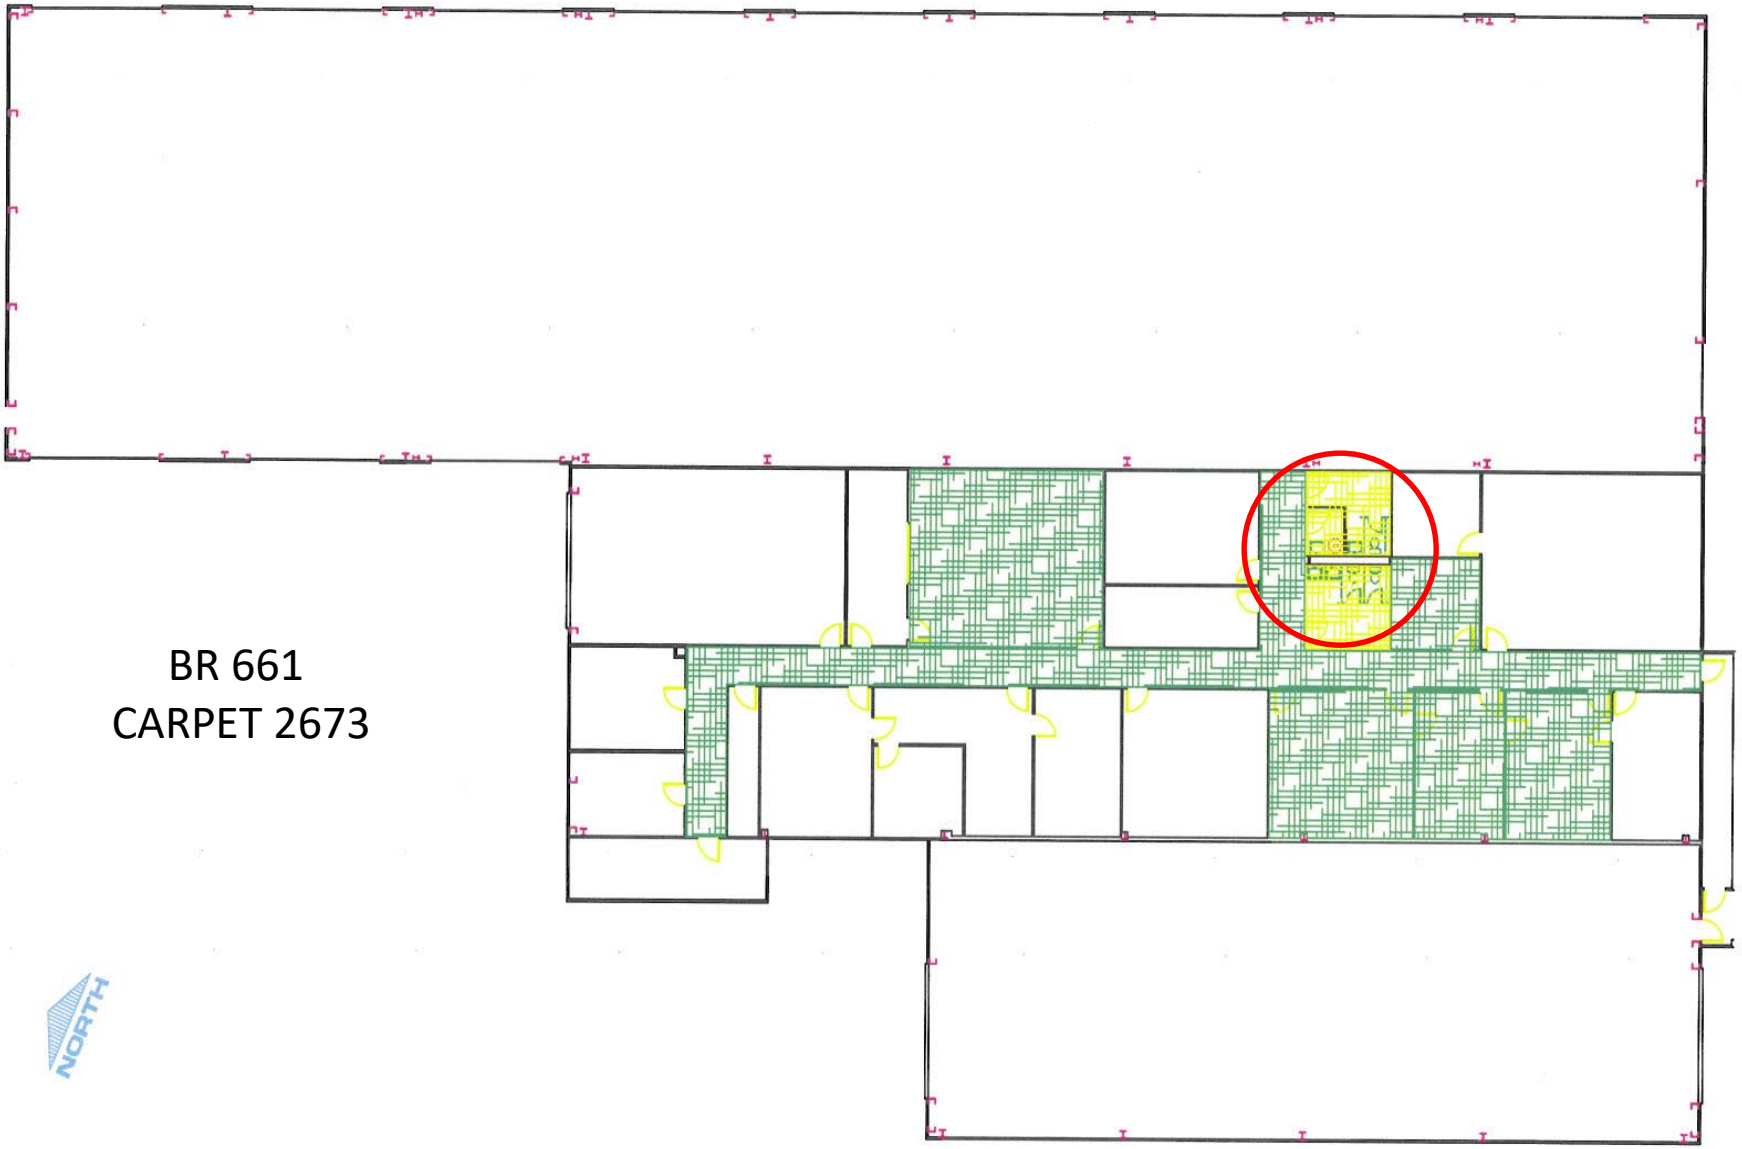

FLOOR PLAN BLDG 9198

SCALE: 1/8"=1'-0"

BLDG 9203

TILE = 393.9678

CARPET = 163.8752

BR = 200.2179

TOTAL = 758.0609

TILE = 164.2099
CARPET = 2389.8226
BR = 197.2556

TOTAL = 2751.2881

SECOND FLOOR PLAN
SCALE: 1/8"=1'-0"

9203

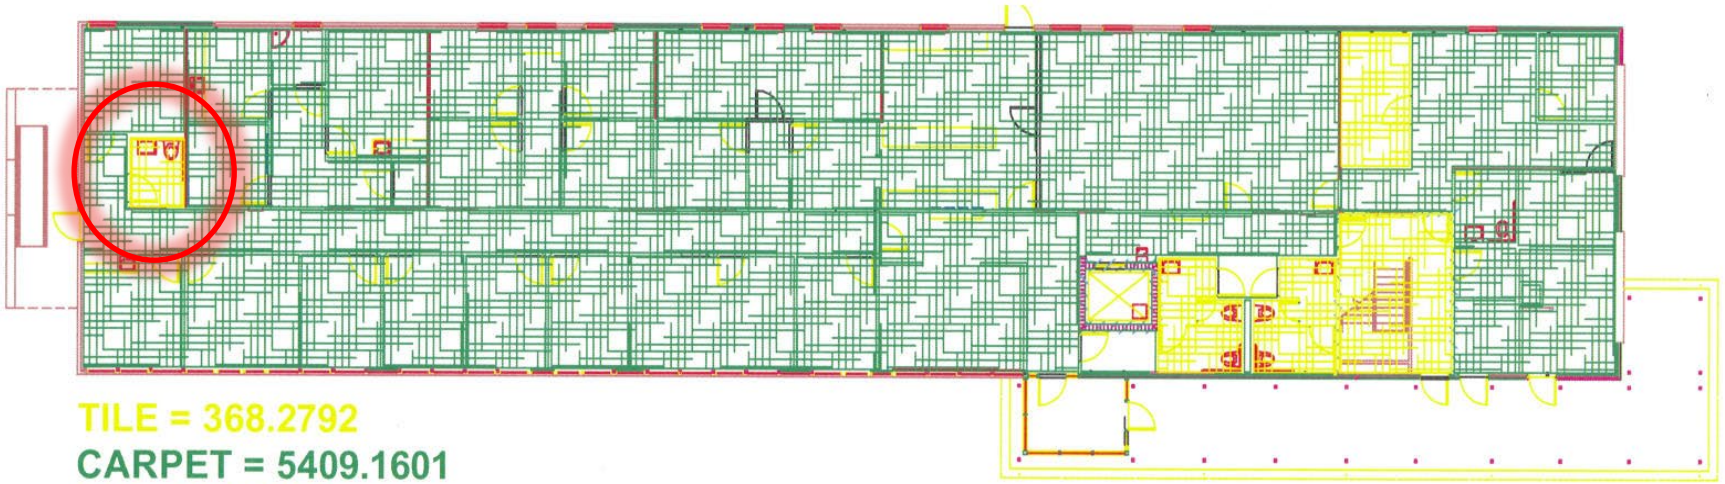

TILE = 368.2792

CARPET = 5409.1601

BR = 200.3317

TOTAL = 5977.7710

BUILDING 9203 FLR 1

SCALE 1/8" = 1'-0"

Acc Tile

~~4~~ 264 Sq Ft

RESTROOM

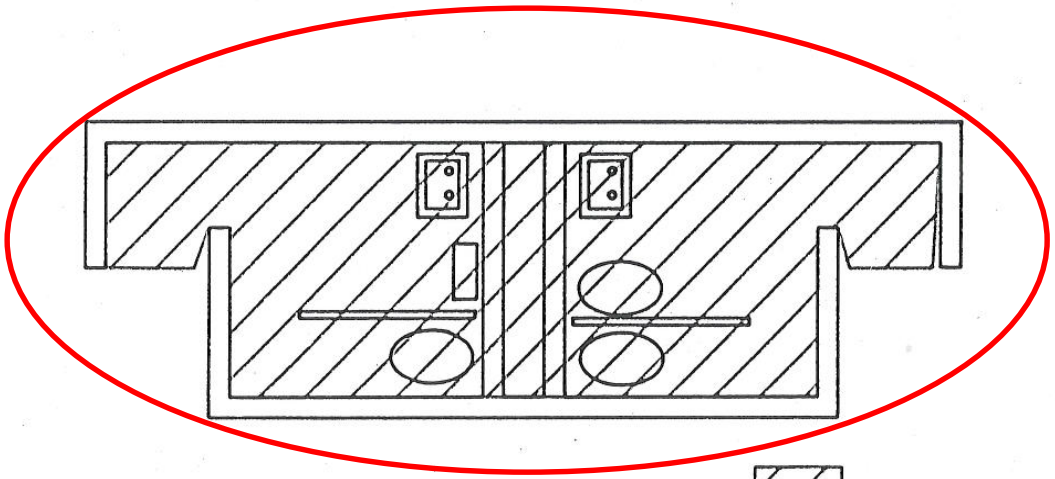

TO BE CLEANED

BLDG 9210

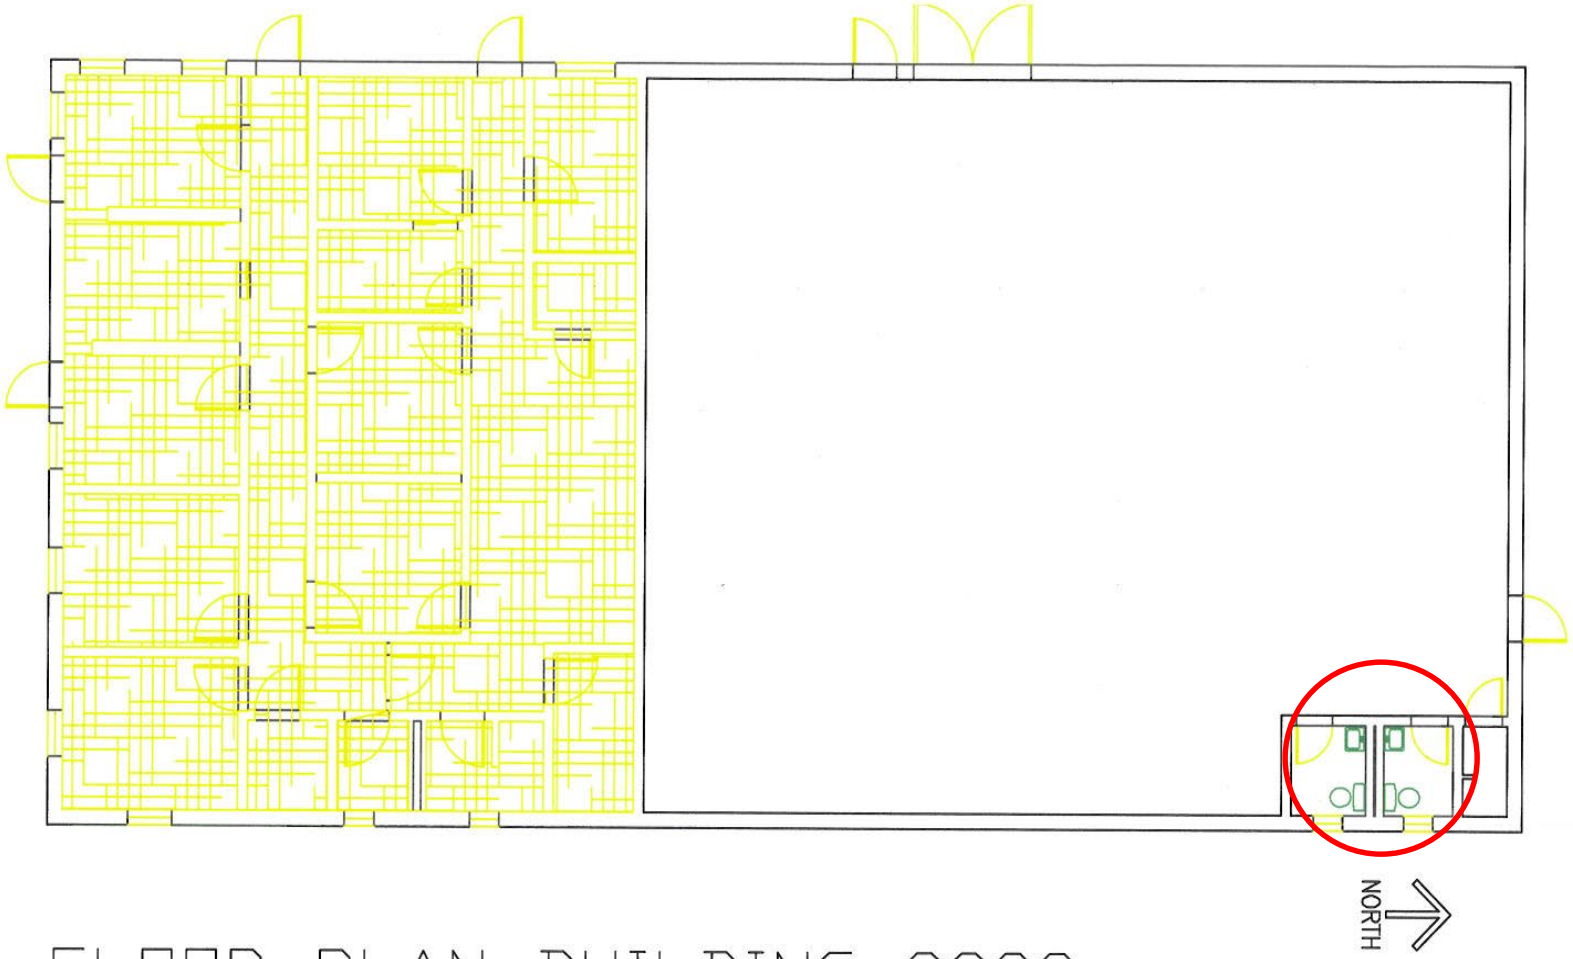

FLOOR PLAN BUILDING 9223

SCALE: 1/4"=1'-0"

Tile = 1633.1624

BR = 74.75

Total = 1707.9124

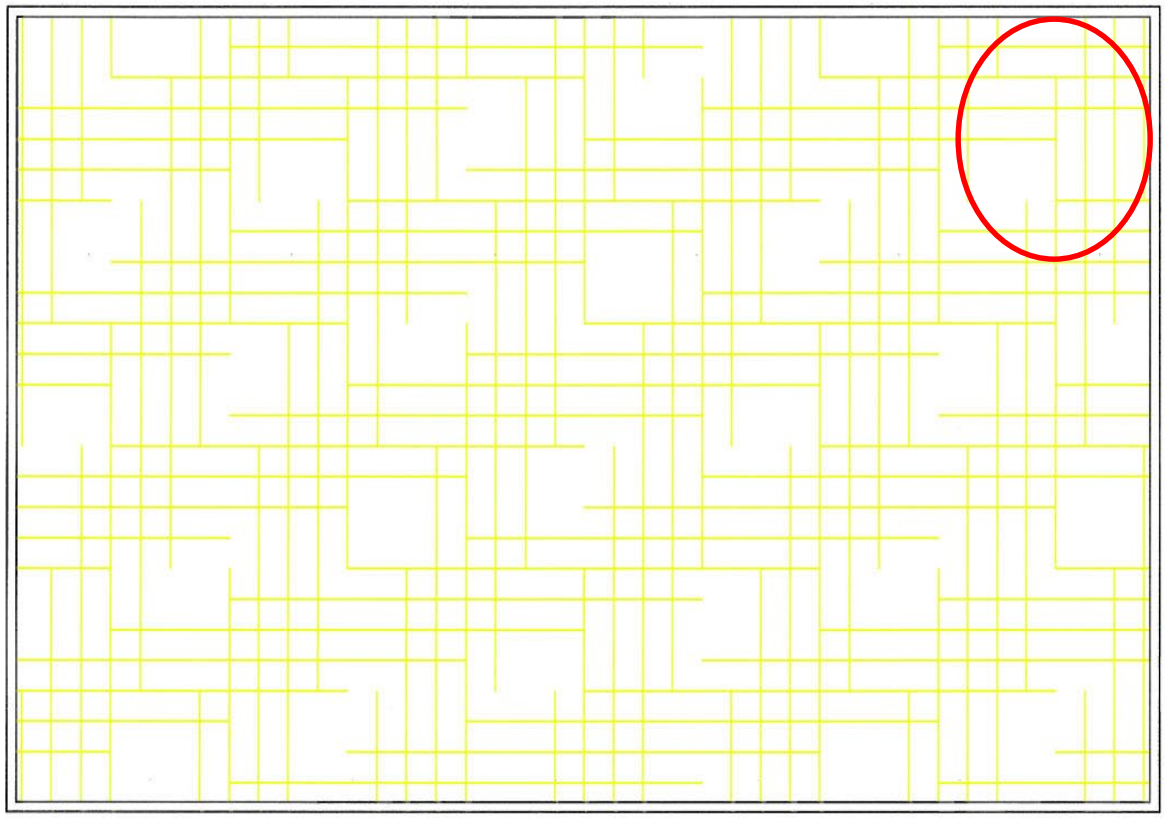

TILE: 2349
BR: 51

Bldg 9250

TOTAL: 2400

TILE = 508
BR = 52

TOTAL = 560

Bldg 9265

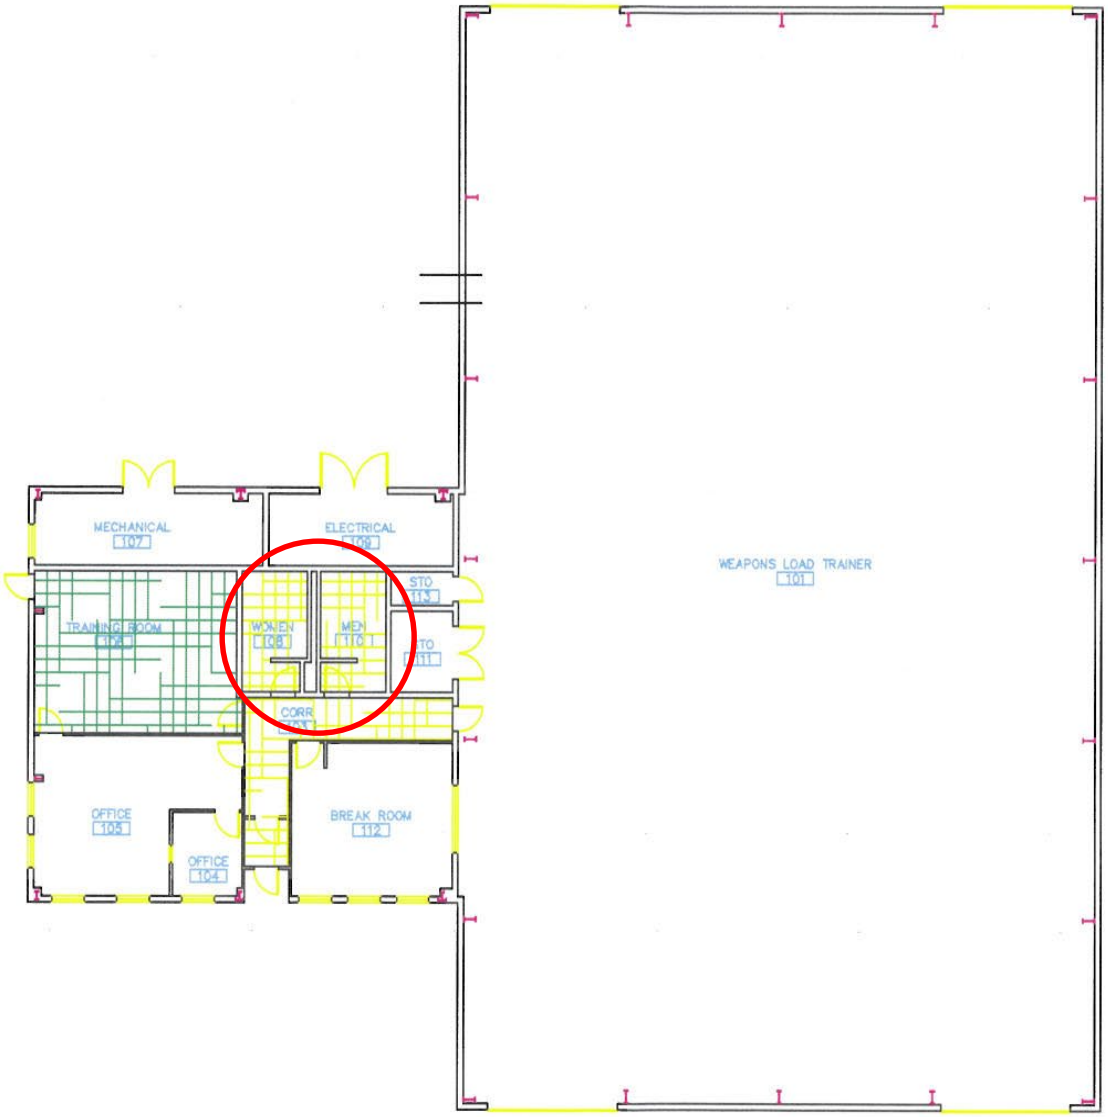

CARPET - 483
TILE - 214
BR - 222

TOTAL - 919

RECORD DRAWING BUILDING 9304
SCALE: 1/8" = 1'-0"