SHEET No. 4-A

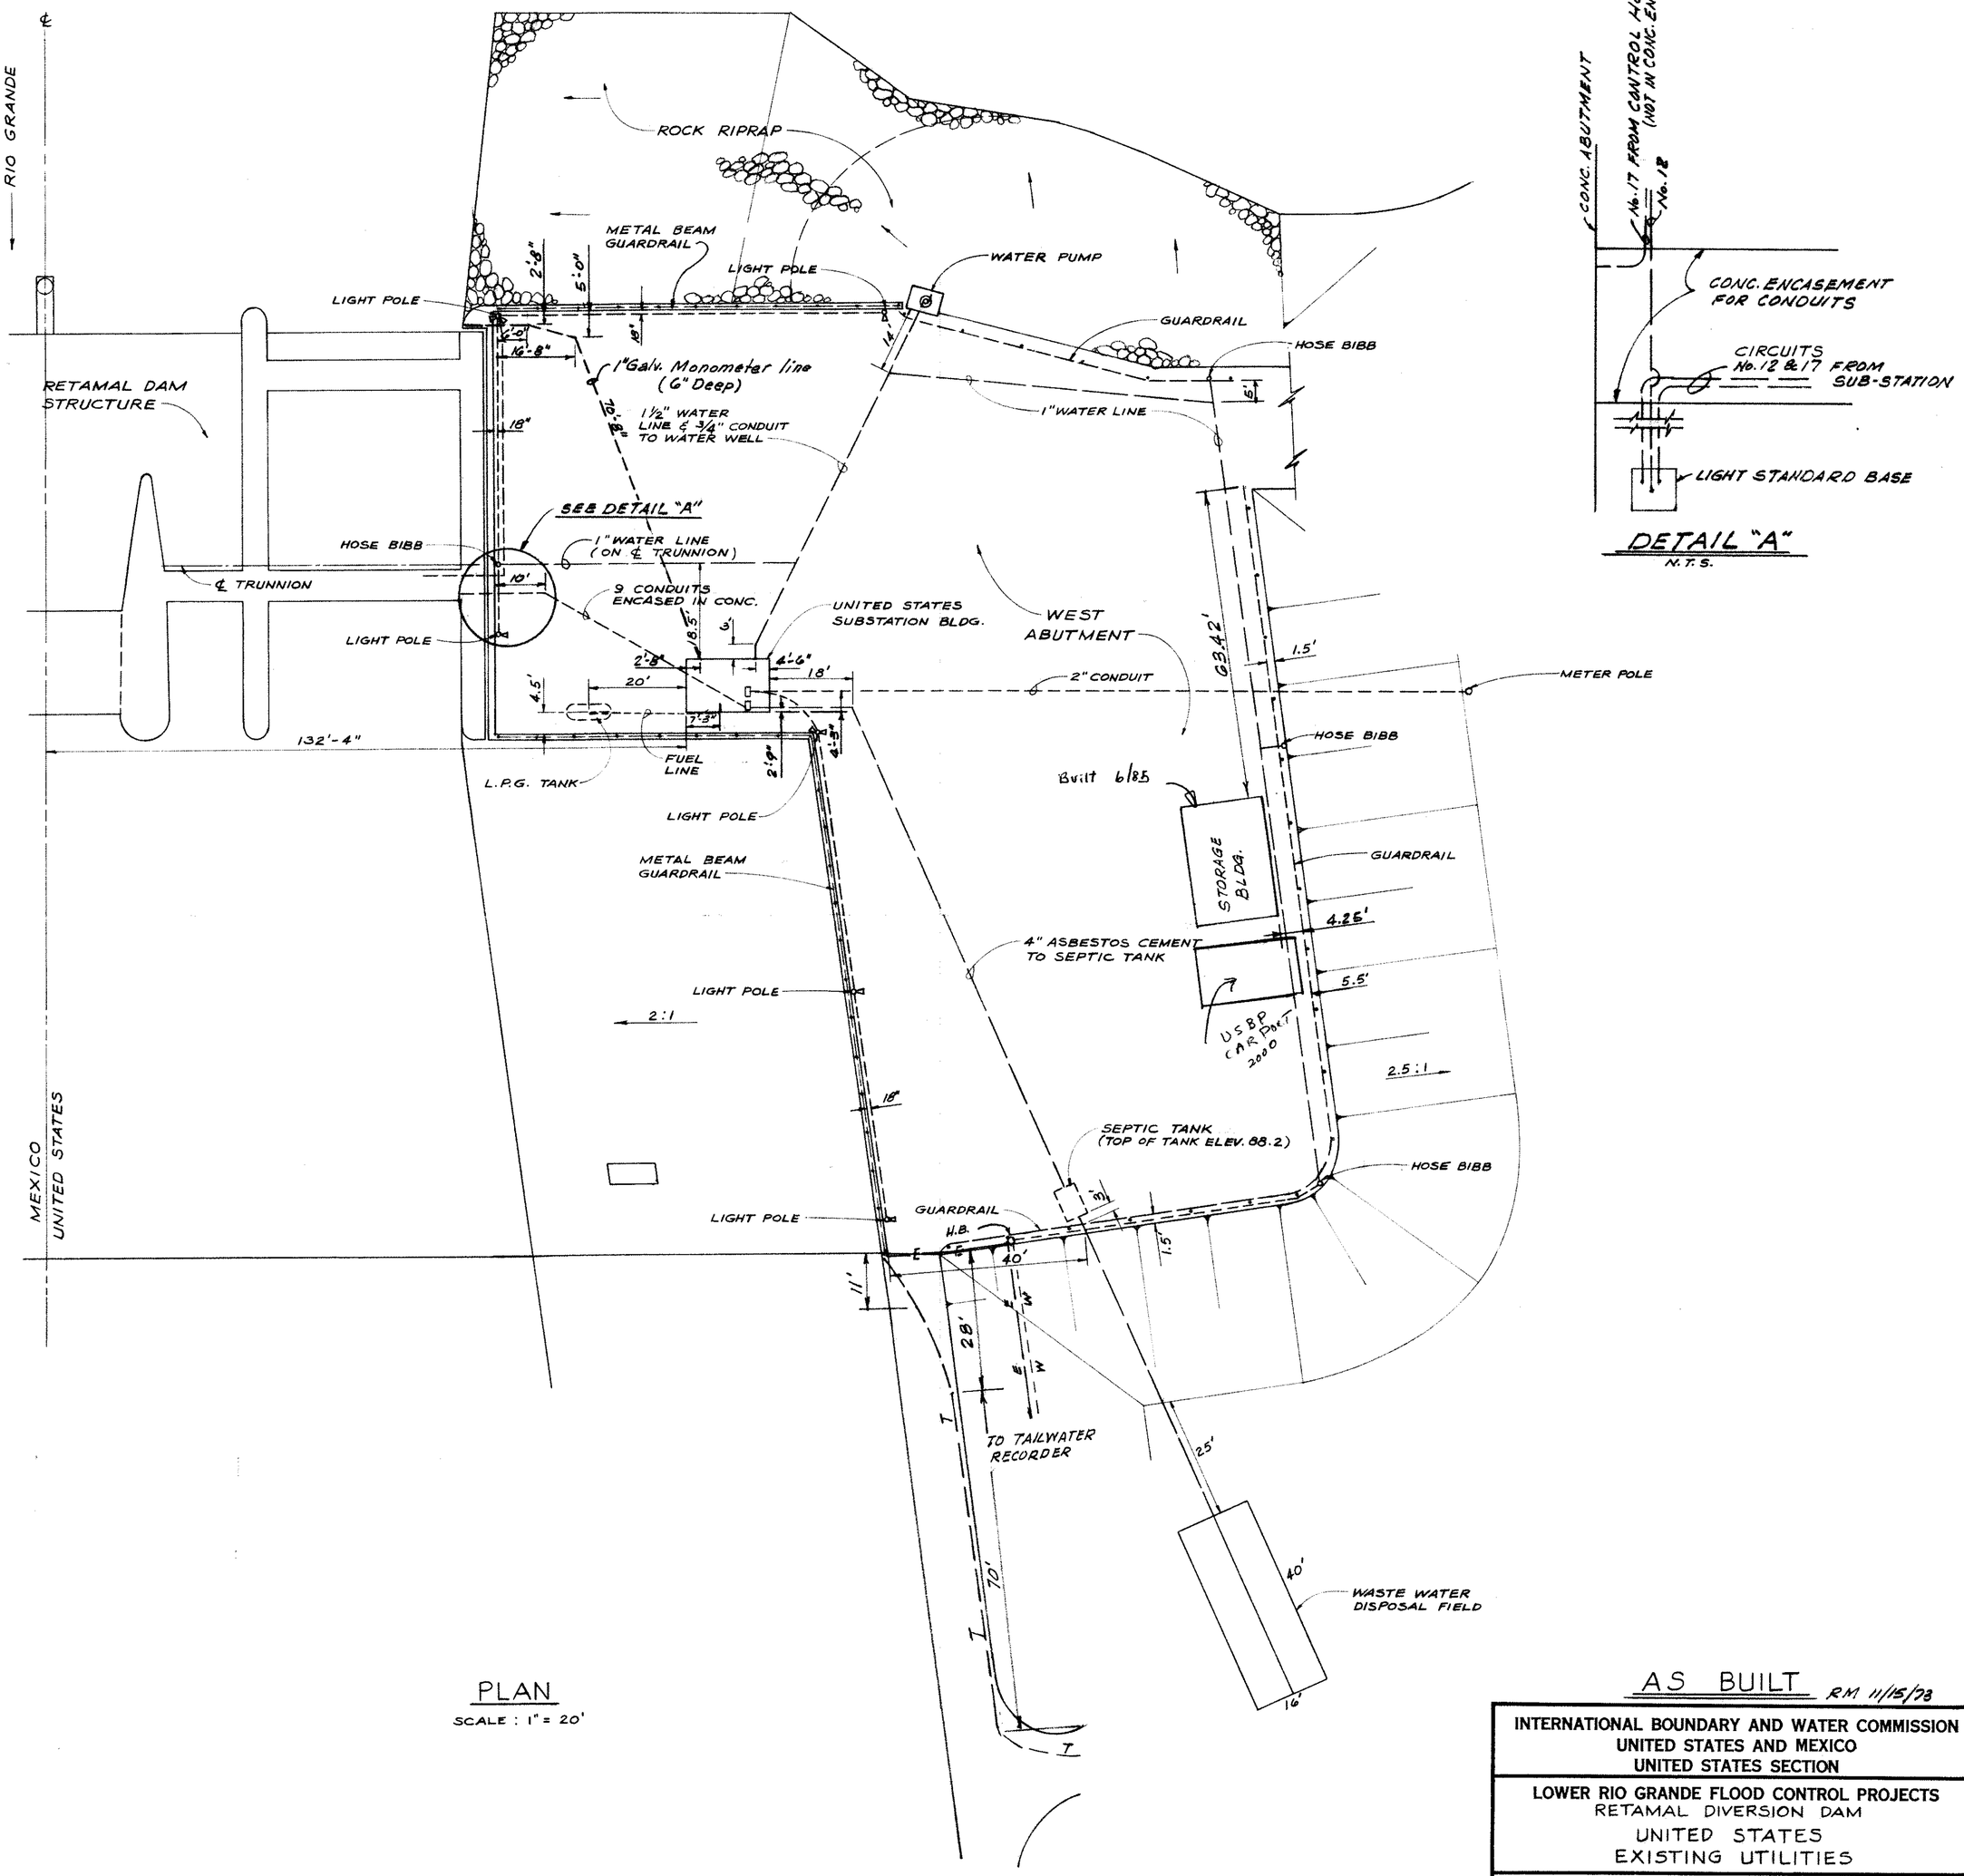

PLAN

SCALE : 1" = 20'

AS BUILT RM 11/15/73

INTERNATIONAL BOUNDARY AND WATER COMMISSION UNITED STATES AND MEXICO UNITED STATES SECTION
LOWER RIO GRANDE FLOOD CONTROL PROJECTS RETAMAL DIVERSION DAM UNITED STATES EXISTING UTILITIES
DRAWN PAC 11/9/73 RECOMMENDED CHECKED RM 11/15/73 APPROVED
6323-RH-10 HARLINGEN, TEXAS 19476-A