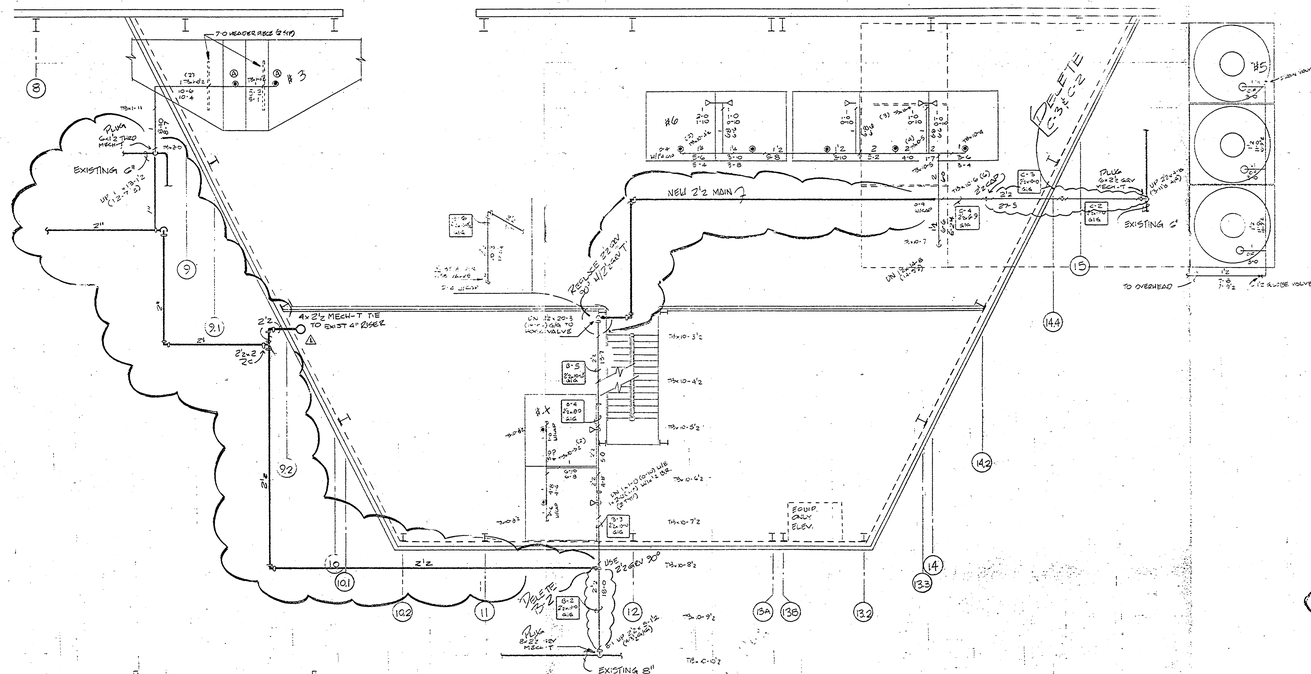

MEZZANINE LEVEL - WEST SUPPORT AREA
SCALE: 1/8" = 1'-0"

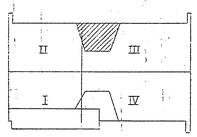

KEY PLAN
NO SCALE

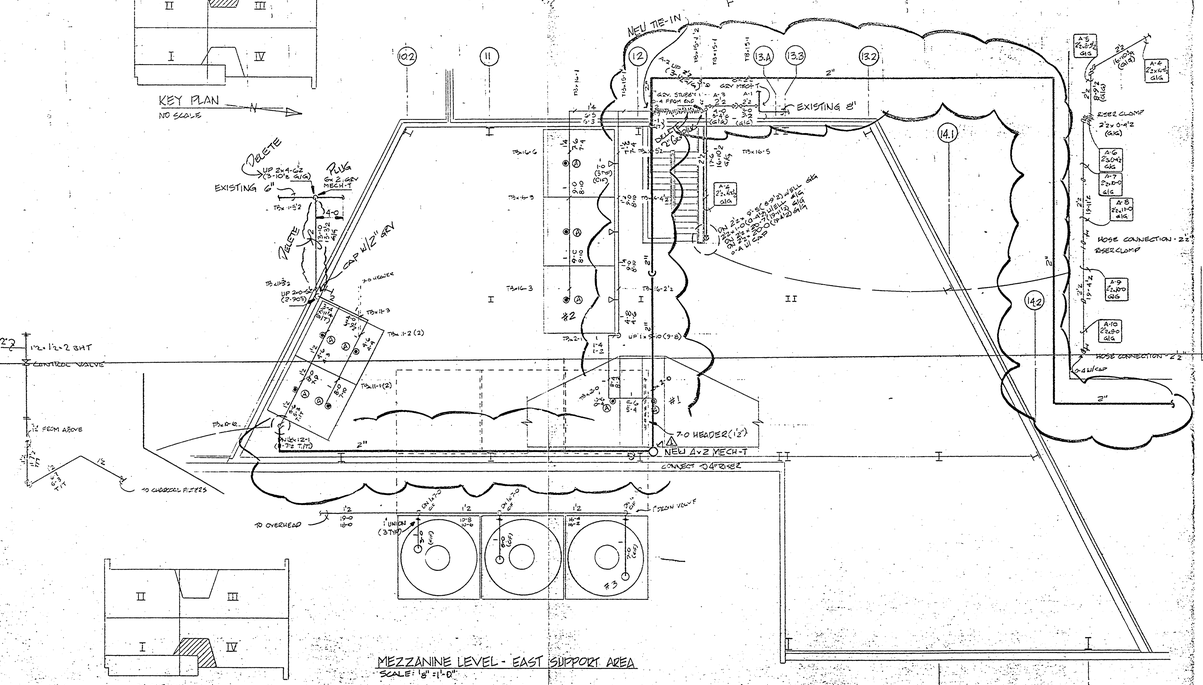

MEZZANINE LEVEL - EAST SUPPORT AREA
SCALE: 1/8" = 1'-0"

KEY PLAN
NO SCALE

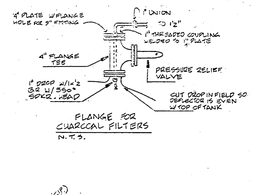

FLANGE FOR CHARCOAL FILTERS
N.T.S.

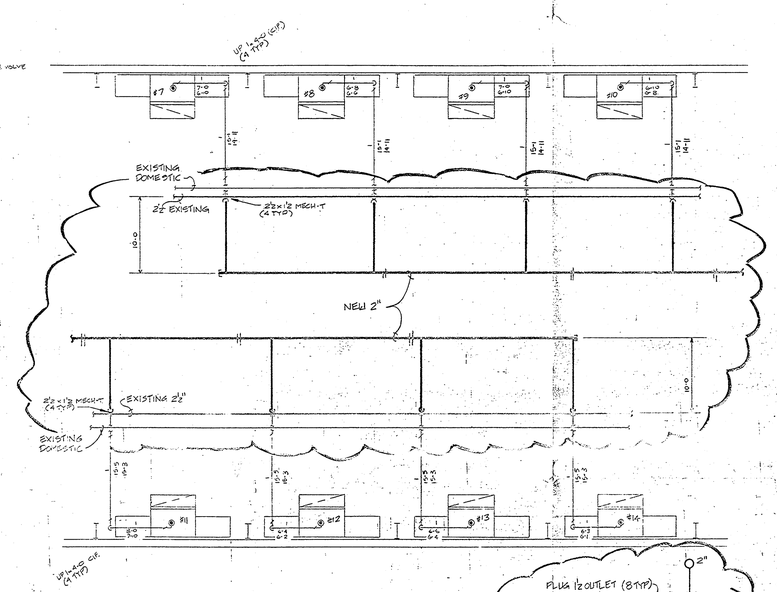

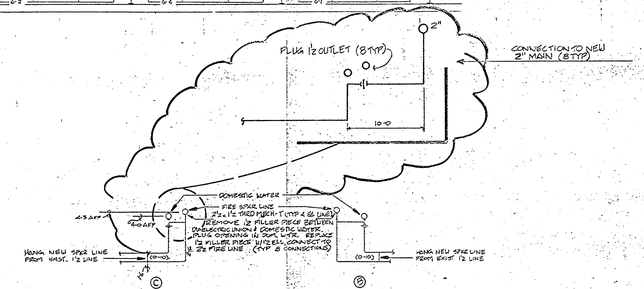

CONNECTION FROM DOMESTIC TO FIRE LINE
N.T.S.

2-1" 90° ELBOW
2-1" FILLER PIECE (C.I.F.)

DROP WIDENDANT

NOTE
DROPS ARE 14'-0" W/ 1'-2" B.O.
DROPS SHALL BE CUT TO FIT IN FIELD

SWING JOINT (18 TYP)

IMPORTANT—PLEASE NOTE

IN ACCORDANCE DIRECT TO PREZING CONDITIONS, IT IS THE OWNER'S RESPONSIBILITY TO PROVIDE MAX DIMENSIONS WET STATE SPRINKLER SYSTEM AREAS AND IN ENCLOSURE FOR DRY FIRE SERVICE AND OTHER STATE OF WATER CONTRACTOR. SHOULD IT BE NECESSARY FOR ANY ELECTRICAL WITHIN TO BE DONE FOR ANY ELECTRICAL DEVICE PROVIDED BY AL FIRE PROTECTION, INC., IT WILL BE THE OWNER'S OR GENERAL CONTRACTOR'S RESPONSIBILITY TO PROVIDE THE ELECTRICAL WORK.

ANY PAINTING OR CLEANING OF EXPOSED PIPE IS BEYOND THE RESPONSIBILITY OF AL FIRE PROTECTION, INC. THE PIPE WILL BE PRIMED WITH ONE COAT OF RUST INHIBITIVE PRIMER. ANY PAINTING OR CLEANING OF EXPOSED PIPE IS TO BE PERFORMED BY THE GENERAL CONTRACTOR OR OTHER TRADES.

SYMB.	TYPE	TEMP.	ORIF.	CANOPY	FINISH	QTY.
	SPRINKLERS					
⊕		165°	½"	PENDANT	BRASS	26
◁		165°	½"	SIDEWALL	BRASS	10
○		286°		PENDANT	BRASS	6
TOTAL THIS SHEET						42

NO.	DATE	BY	REVISIONS
1			RE-ISSUED FOR CONSTRUCTION

CONTRACT NO. A-145
DATE NOV. 1990
SCALE 1/8" = 1'-0"
DRAWN BY: R.B.
DRAWING NO. 1 of 1

PROJECT: AIRCRAFT PROTECTIVE COATING FACILITY
BUILDING 2280
TINKER AIR FORCE BASE, OKLAHOMA

DESCRIPTION

AS BUILT 6-20-91

AL Fire Protection, Inc.
9817 NW 4th
Oklahoma City, Oklahoma 73127
405-787-4417

TG - 2280 - F6 - 319