ATTACHMENT NEXRAD WSR-88D RADAR DRAWINGS

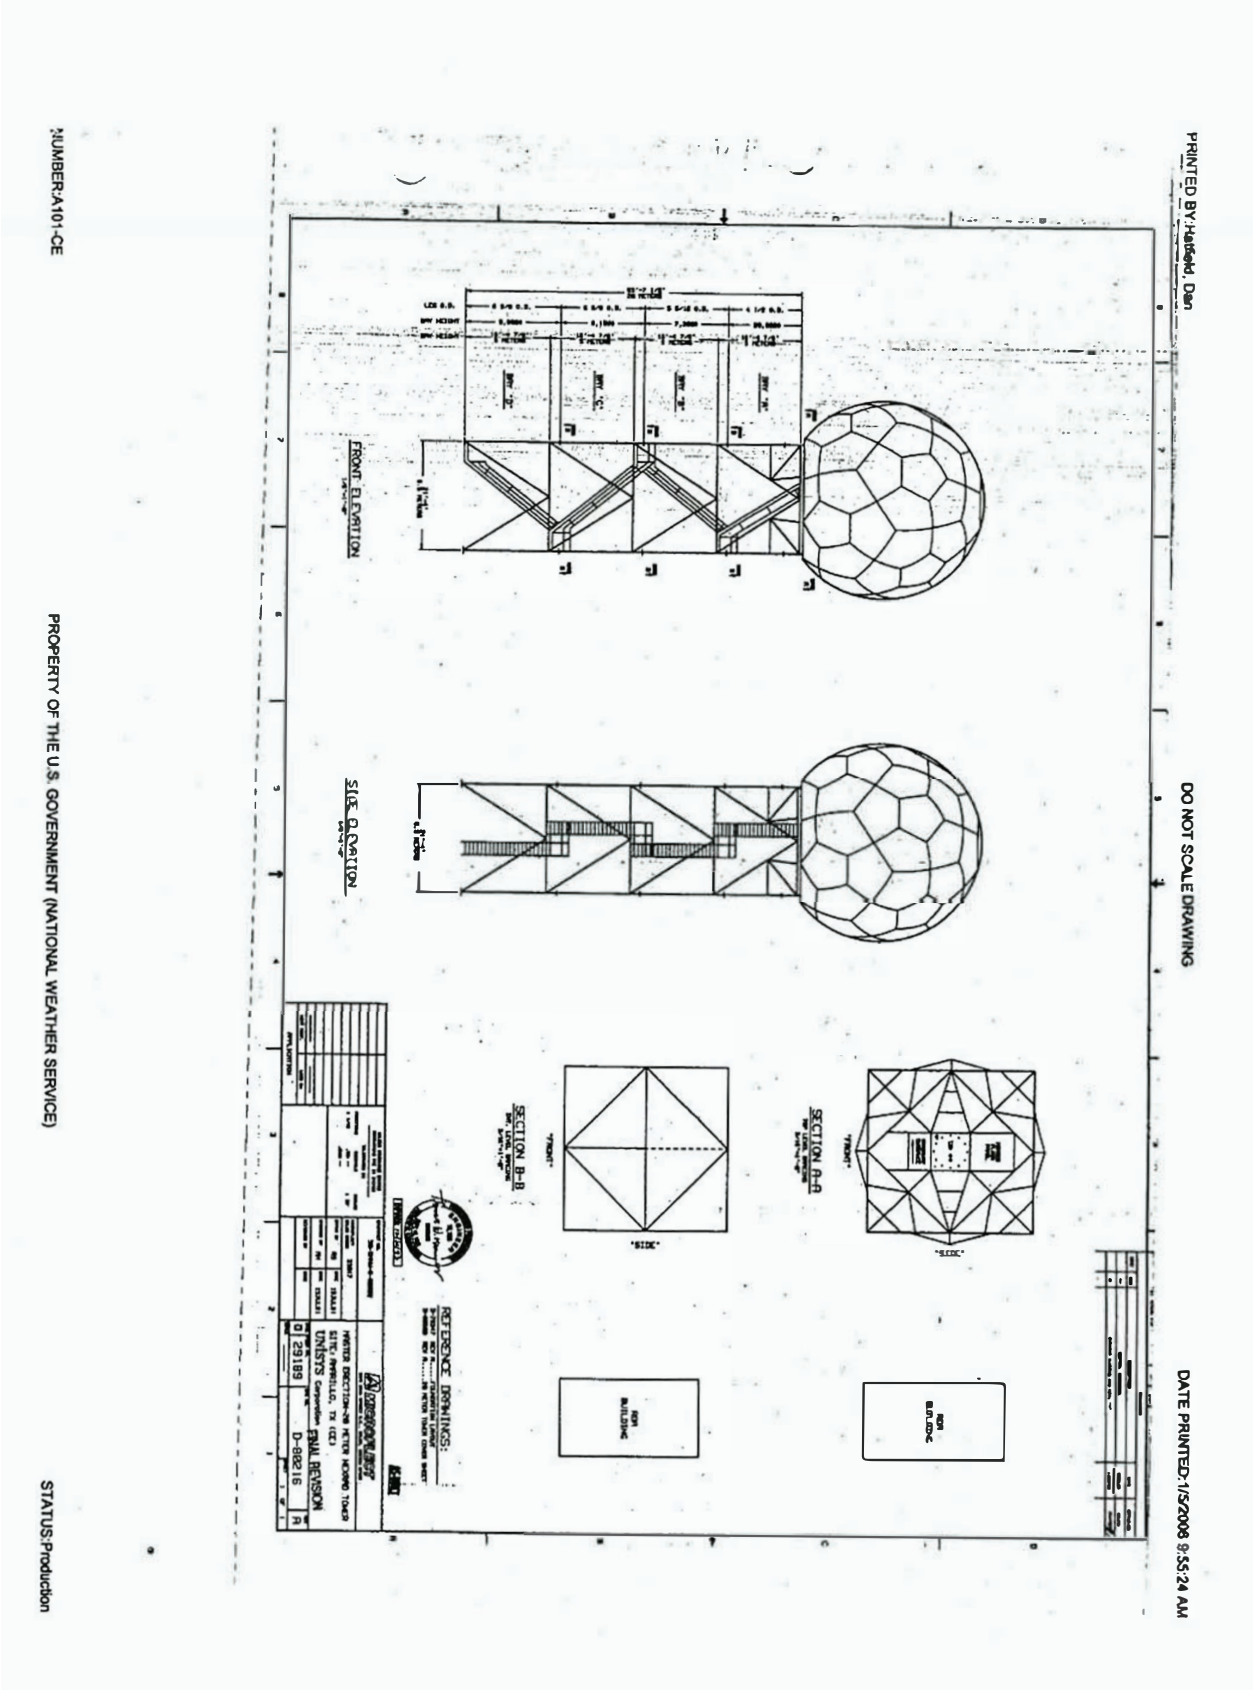

REVISIONS				
ZONE	REV	DESCRIPTION	DATE	APPROVED
	P3	ISSUED FOR REVIEW - DRAFT AS-BUILT	4/23/02	GDH
	A	AS-BUILT	7/20/02	GDH

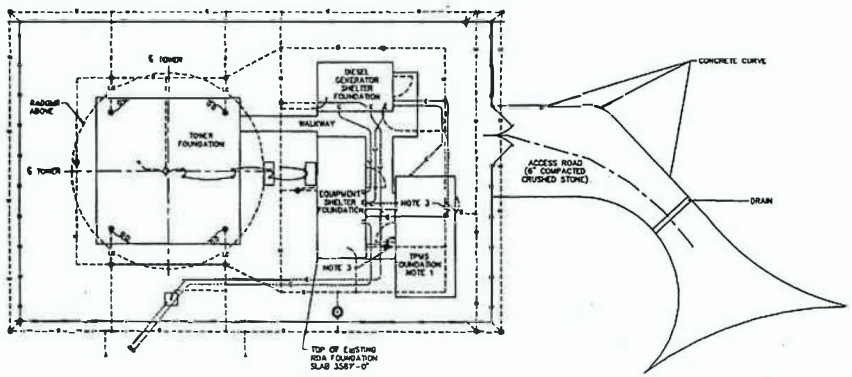

LEGEND

- 12' DOUBLE SWING GATE
- CHAIN LINK FENCE
- UNDERGROUND GROUND CABLE
- UNDERGROUND LIGHTING CONDUCTOR
- UNDERGROUND COMMUNICATIONS CONDUIT
- UNDERGROUND POWER CONDUIT
- UNDERGROUND TELEPHONE CONDUIT
- PROPERTY LINE
- GROUND ROD
- CABLE CROSS CONNECTION
- GROUND TEST WELL
- PIGTAIL
- CONDUIT
- SERVICE DISCONNECT SWITCH PEDESTAL
- WAVEGUIDE BRIDGE FOUNDATION
- SURVEY MONUMENT

NORTH

NOTES:

1. FOUNDATION DEPTH DIMENSION "A"=3'-0", AND SLAB THICKNESS IS 6". SEE SECTION A-A AND FOUNDATION DESIGN TABLE ON DWG. C1-GAS.
2. CONDUIT DEPTH DIMENSION "CD" = 3'-0". SEE DWG. E6-GAS
3. SEE TPMS GROUND CONNECTION DETAIL ON DWG. E6-GAS
4. EARTH ELECTRODE SYSTEM IS 3'-0" BELOW GRADE
5. REFERENCE FIBERBOND DRAWING FOR BUILDING PENETRATION POINTS

AS-BUILTS

GRAPHIC SCALE

0 6" 8" 16" 24"

POWERWARE
RALEIGH, N.C. 27615

DATE 6/20/02	DRAWN AMA	NOAA TRANSITION POWER MAINTENANCE SHELTER SYSTEM	
SCALE NONE	DESIGNED E.G. MONTANA, PE	SITE PLAN FOR TPMS INSTALLATION AMA, ARAMUA, TX	
		4003AC.109	SP1-AMA