The contractor shall be responsible for coordinating and implementing all changes reflected in drawing TS 000 across all other related disciplines, including but not limited to electrical, civil, structural, and architectural drawings.
Even though the alterations are specified only in drawing TS 000, the contractor must ensure that these changes are thoroughly reviewed, integrated, and communicated across all relevant disciplines to maintain consistency and coherence in the overall project design.

Failure to comply with this requirement may result in project delays, additional costs, and potential liabilities for which the contractor will be held responsible.

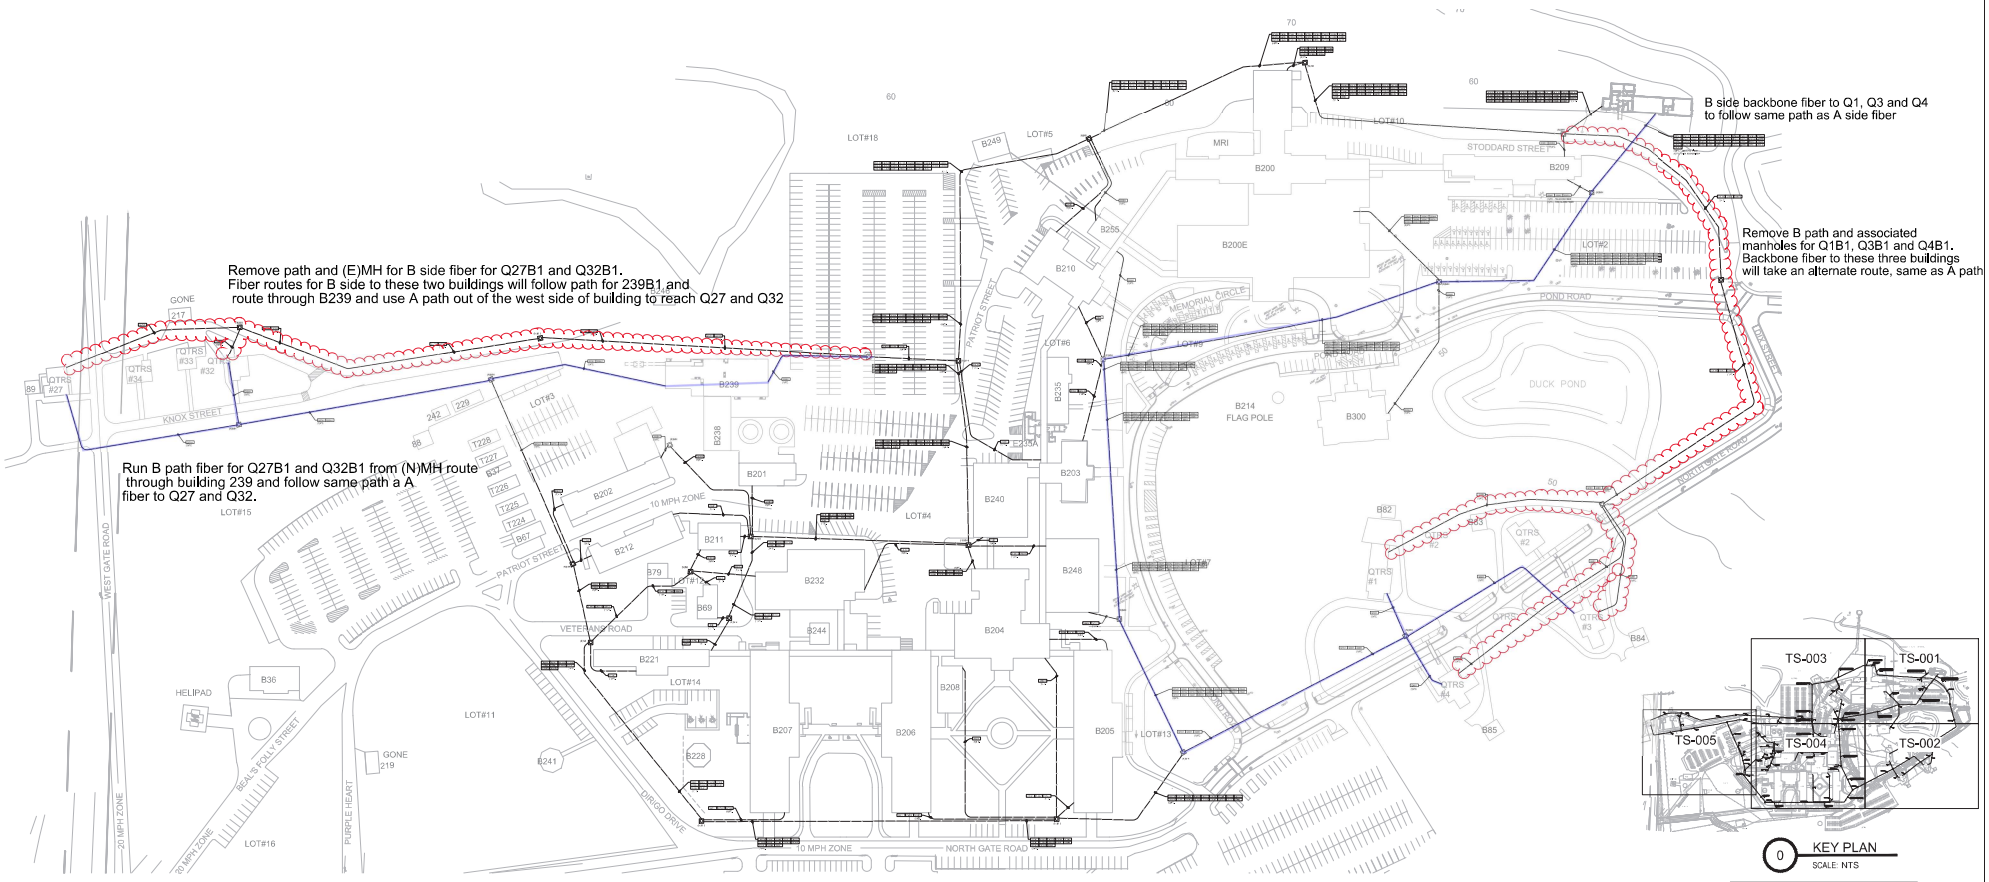

TELECOMMUNICATIONS SITE PLAN
SCALE: 1"=80'-0"
0 80' 160'

0 KEY PLAN
SCALE: NTS

THIS DRAWING WAS PRODUCED FROM ORIGINAL AS-BUILT DRAWINGS AND FIELD OBSERVATIONS, AND MAY NOT REPRESENT AN ACCURATE AS-BUILT CONDITION. DISCREPANCIES MAY BE ENCOUNTERED, AND IT IS THE CONTRACTOR'S RESPONSIBILITY TO FIELD VERIFY ALL CONDITIONS.

Revisions:	Date:

CONSULTANT
ARCHITECT:
A&E DESIGN
129 NORTH 29th STREET, SUITE 100
BILLINGS, MT 59101
PH: 406.248.2633
<To Be Determined>, AIA

ARCHITECT/ENGINEER OF RECORD
A/E:
GDM OF OREGON
1000 W STEUBEN ST, UNIT 3
BINGEN, WA 98605
PH: 541.224.8536
ADAM GOODIN, PE
GDM ARCHITECTS · ENGINEERS

STAMP
BICSI COMMUNICATIONS DISTRIBUTION DESIGNER
BICSI ID # 164277
Expires 12-31-24
REGISTERED RCDD

PROGRAM CONTRACTING ACTIVITY CENTRAL (PCAC)
VA U.S. Department of Veterans Affairs

DRAWING TITLE: TOGUS EHRM SITE PLAN	PHASE: 100% CONSTRUCTION DOCUMENTS	PROJECT TITLE: ELECTRONIC HEALTH RECORD MODERNIZATION (EHRM) INFRASTRUCTURE UPGRADES - TOGUS, ME	PROJECT NUMBER: 402-22-700
			BUILDING NUMBER: —
APPROVED:	FLS: FULLY SPRINKLERED	LOCATION: TOGUS VA MEDICAL CENTER	DRAWING NUMBER: TS-000
		ISSUE DATE: SEPTEMBER 28, 2023 / CHECKED BY: DJC / DRAWN BY: RES	

VA FORM 08-6231

Autodesk Docs://2311_VA Medical Center - Togus ME/2311_B-300-200E_Telecomm_r22.rvt
4/12/2023 10:33:07 AM