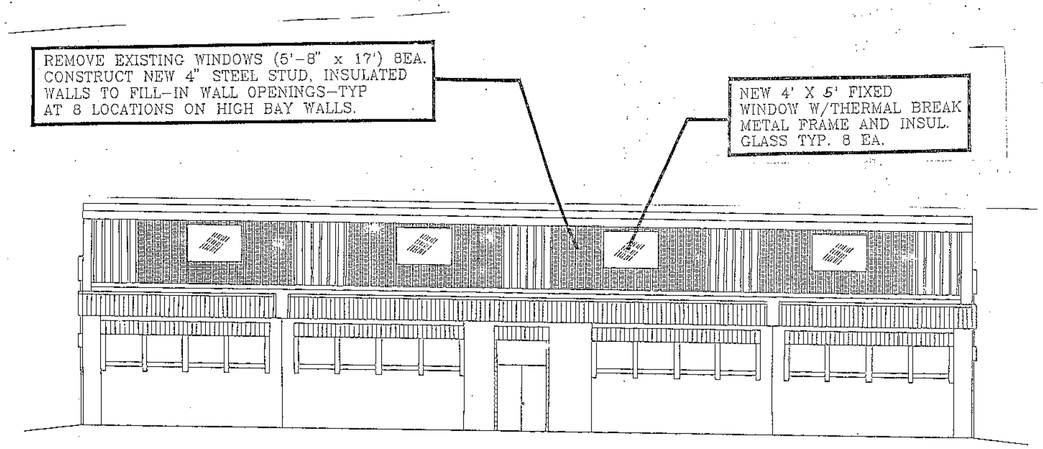

BLDG. 882
NORTHWEST ELEVATION

SCALE 1/8" = 1'-0"

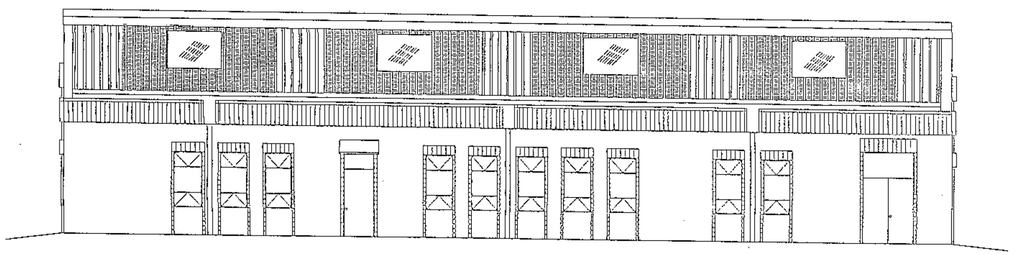

BLDG. 882
SOUTHWEST ELEVATION

SCALE 1/8" = 1'-0"

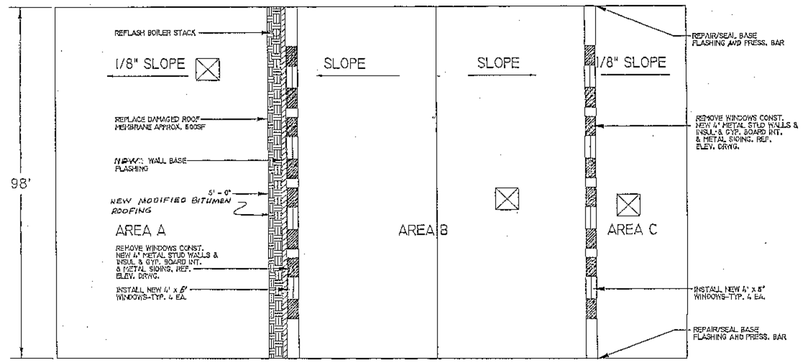

LEGEND

- MEMBRANE REPAIR AREA
- FLASHING/STRIP-IN REPAIR AREA
- NEW WINDOW/WALL PANEL

ROOF/FLOOR PLAN

BLDG. 882

SCALE 1" = 20'

NORTH

0 1 2 3 4 5 6

GRAPHIC SCALE

AS BUILT

REV	DATE	DESCRIPTION	DRAWN	APPRD
—	11-7-94	ASBUILT	TTS/BB	AK

AIR MOBILITY COMMAND
MALSTROM AIR FORCE BASE

REPAIR ROOFS BUILDING 882
ROOF PLAN AND ELEVATIONS
SABER 5163

SUBMITTED	APPROVED	APPROVED
CHIEF ENGINEER	CIVIL ENGINEER	COMMANDER

DRAWN BY	DESIGNED BY	DATE	SHEET
OPHOF	GAMBLE	SEP 93	1 OF 2
SCALE	PROJECT NUMBER		DRAWING NUMBER
AS SHOWN	93-0162		

882-3