2017 As-Constructed Drawing for Reference Only

Dwg. of

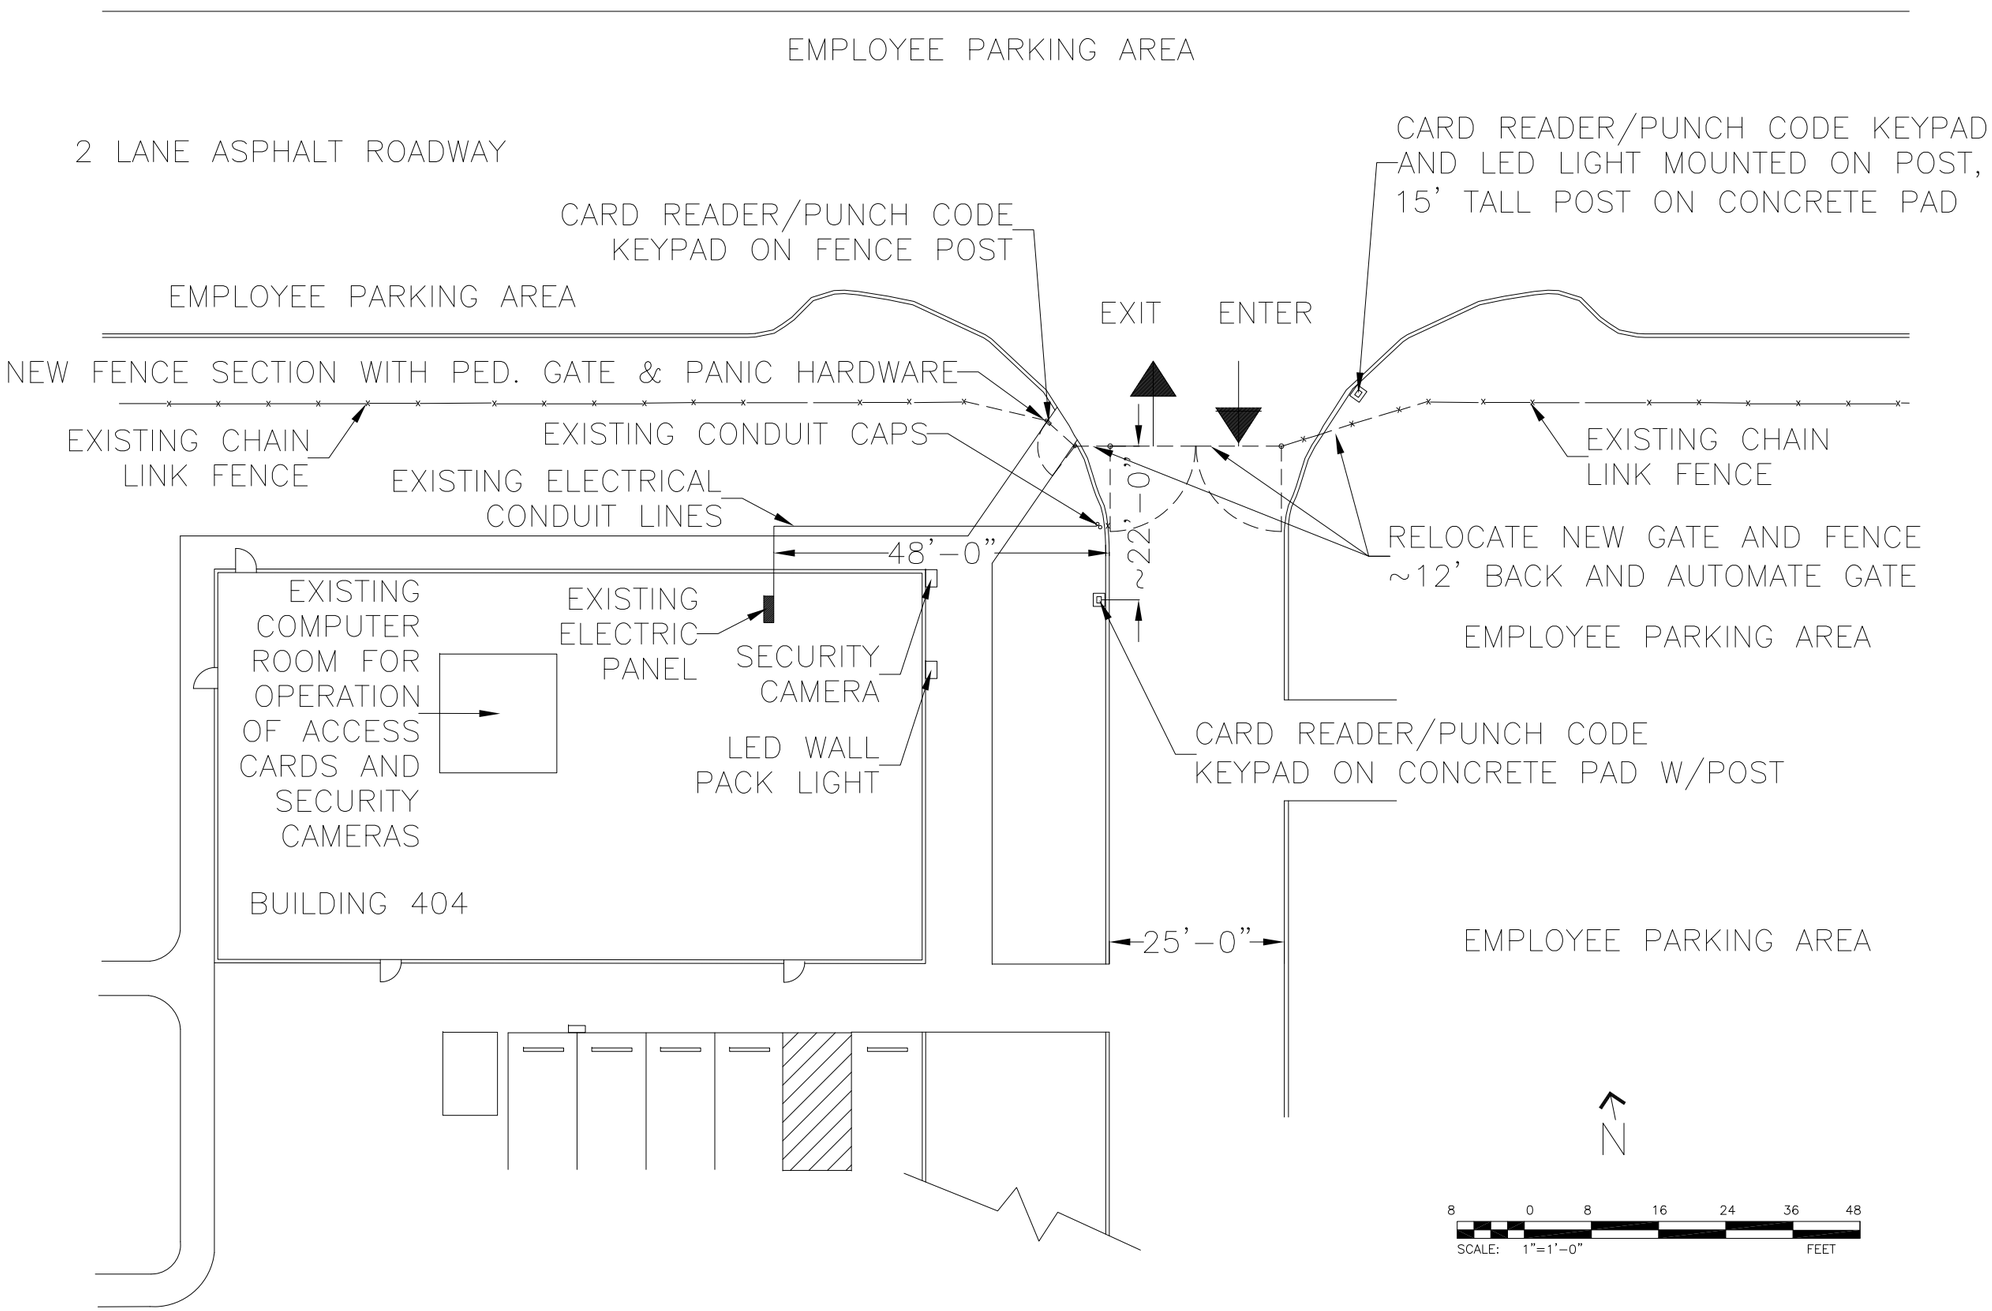

NOTES:

1) OPTIONAL ITEMS INCLUDE;
- 2 LED GATE LIGHTS
- GATE SECURITY CAMERA
- SECURITY CAMERA SOFTWARE
- NEW LAPTOP COMPUTER
- SAFETY EDGE CONTACT SENSOR AT MIDDLE OF NEW GATE

2) CONTRACTOR SHALL CONFIRM DIMENSIONS AND LOCATIONS OF ALL LINE ITEMS INCLUDED IN CONTRACT DESIGN AND ILLUSTRATE THEM AS PLANNED FOR CONSTRUCTION ON SHOP DRAWING SUBMITTAL TO BE APPROVED BY CO/COR.

-REDUCED-
DO NOT SCALE DRAWING

REV.	DESCRIPTION	APPROVED	DATE

U.S. DEPARTMENT OF AGRICULTURE
FOREST SERVICE
THE PACIFIC NORTHWEST REGION (R-6)

404_GATE_SECURITY_CONTRACT
PROJECT_DETAILS
BUILDING_404

Forest: GIFFORD_PINCHOT **City:** VANCOUVER
Building No.: 404 **State:** WASHINGTON
Location: 501_E_5TH_STREET **Project:** 404_GATE_SECURITY

Designed: BECKER **Drawn:** BECKER **Checked:** CHEN

Technical Approval: _____ **Date:** _____
CIVIL ENGINEER

Approved: _____ **Date:** _____
FOREST ENGINEERING

SHEET 1 of 2 | **DWG.No. 030217_1**