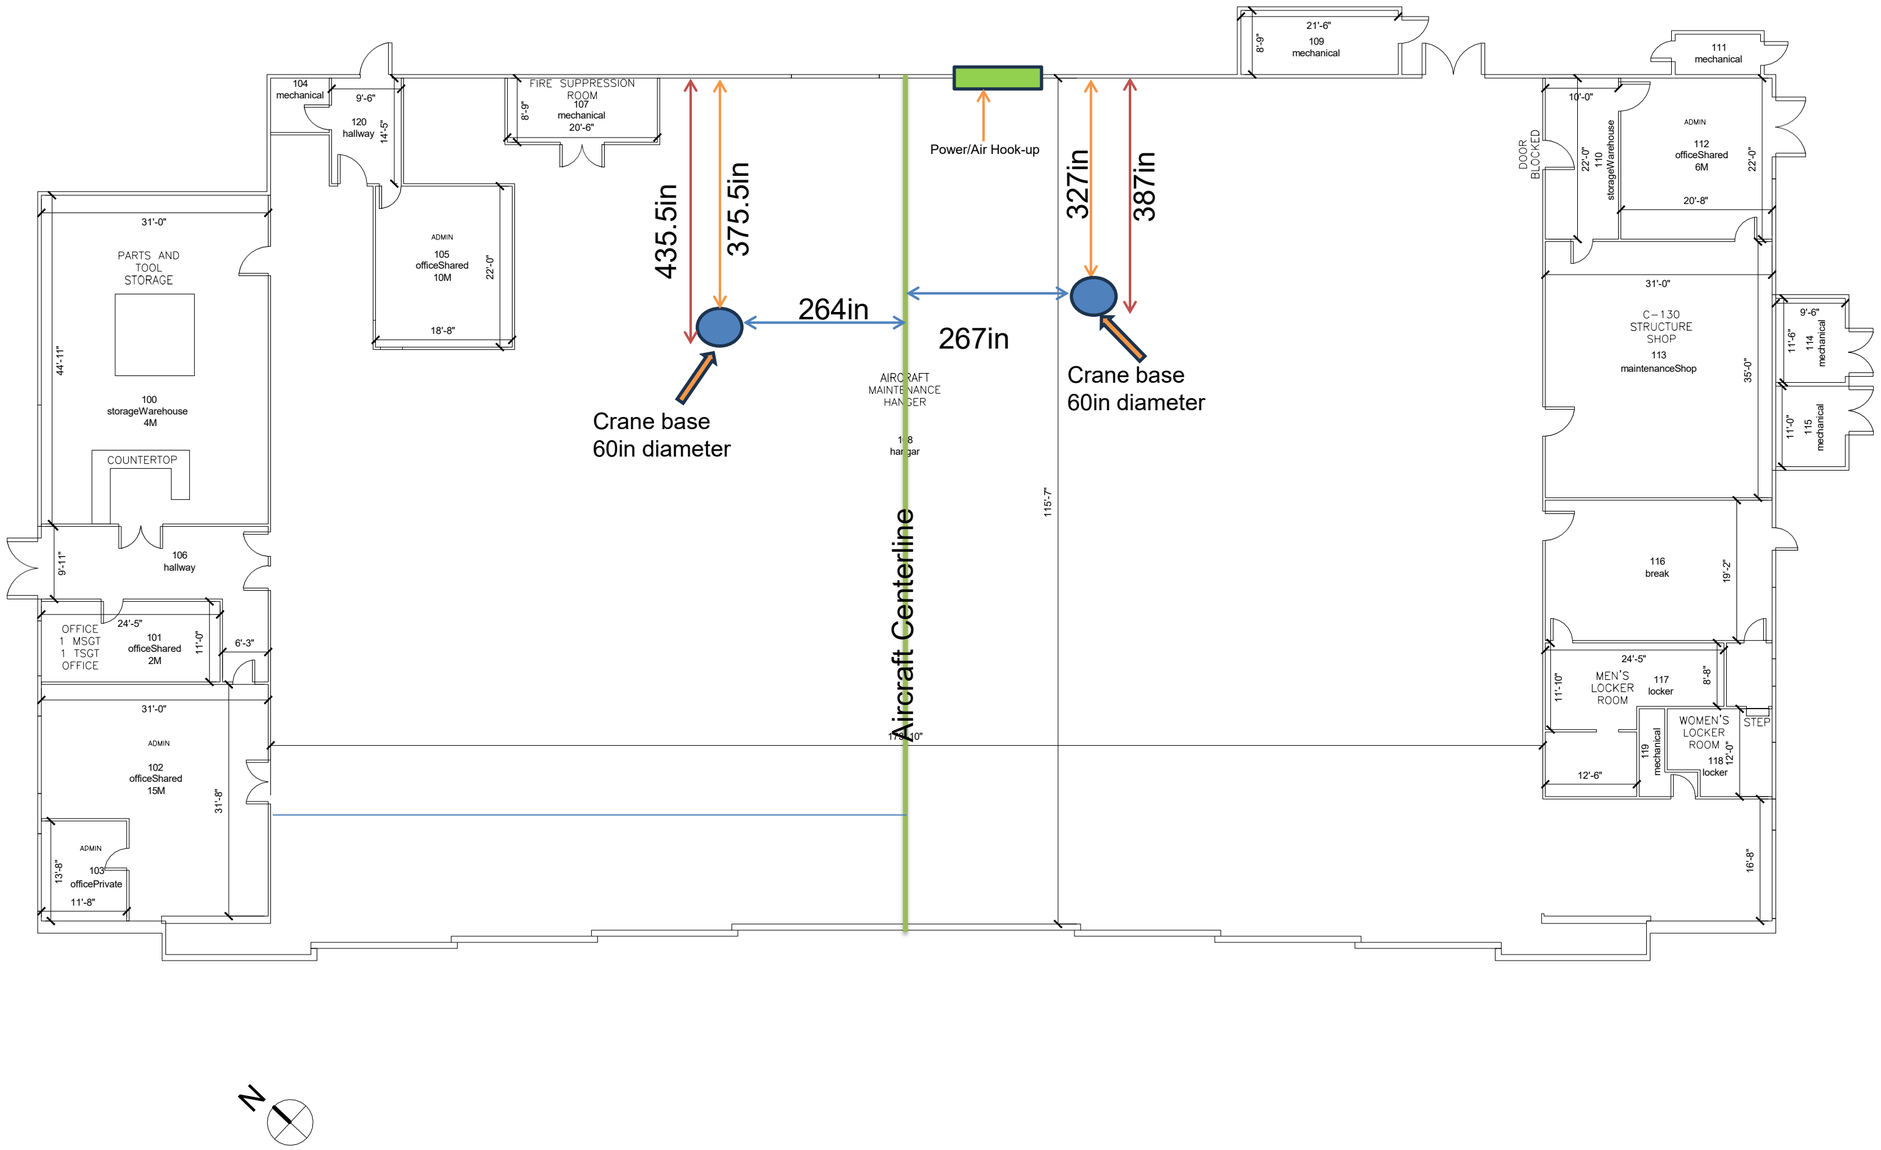

BLDG 00129 FLOOR PLAN

SCALE : 1/8" = 1'-0"

FACILITY 00129 FLOOR PLAN	355 CES/CEOE MAINTENANCE ENGINEERING TECHNICAL SUPPORT SECTION	
DEPARTMENT OF THE AIR FORCE AIR COMBAT COMMAND	DATE: 20210129 DRAWN BY: AutoCAD Sky Tex SCALE: 1/8" = 1'-0"	
AS-BUILTS	DAVIS-MONTHAN AFB, AZ OFFICE OF THE BASE CIVIL ENGINEER	A1

00129-000-A1