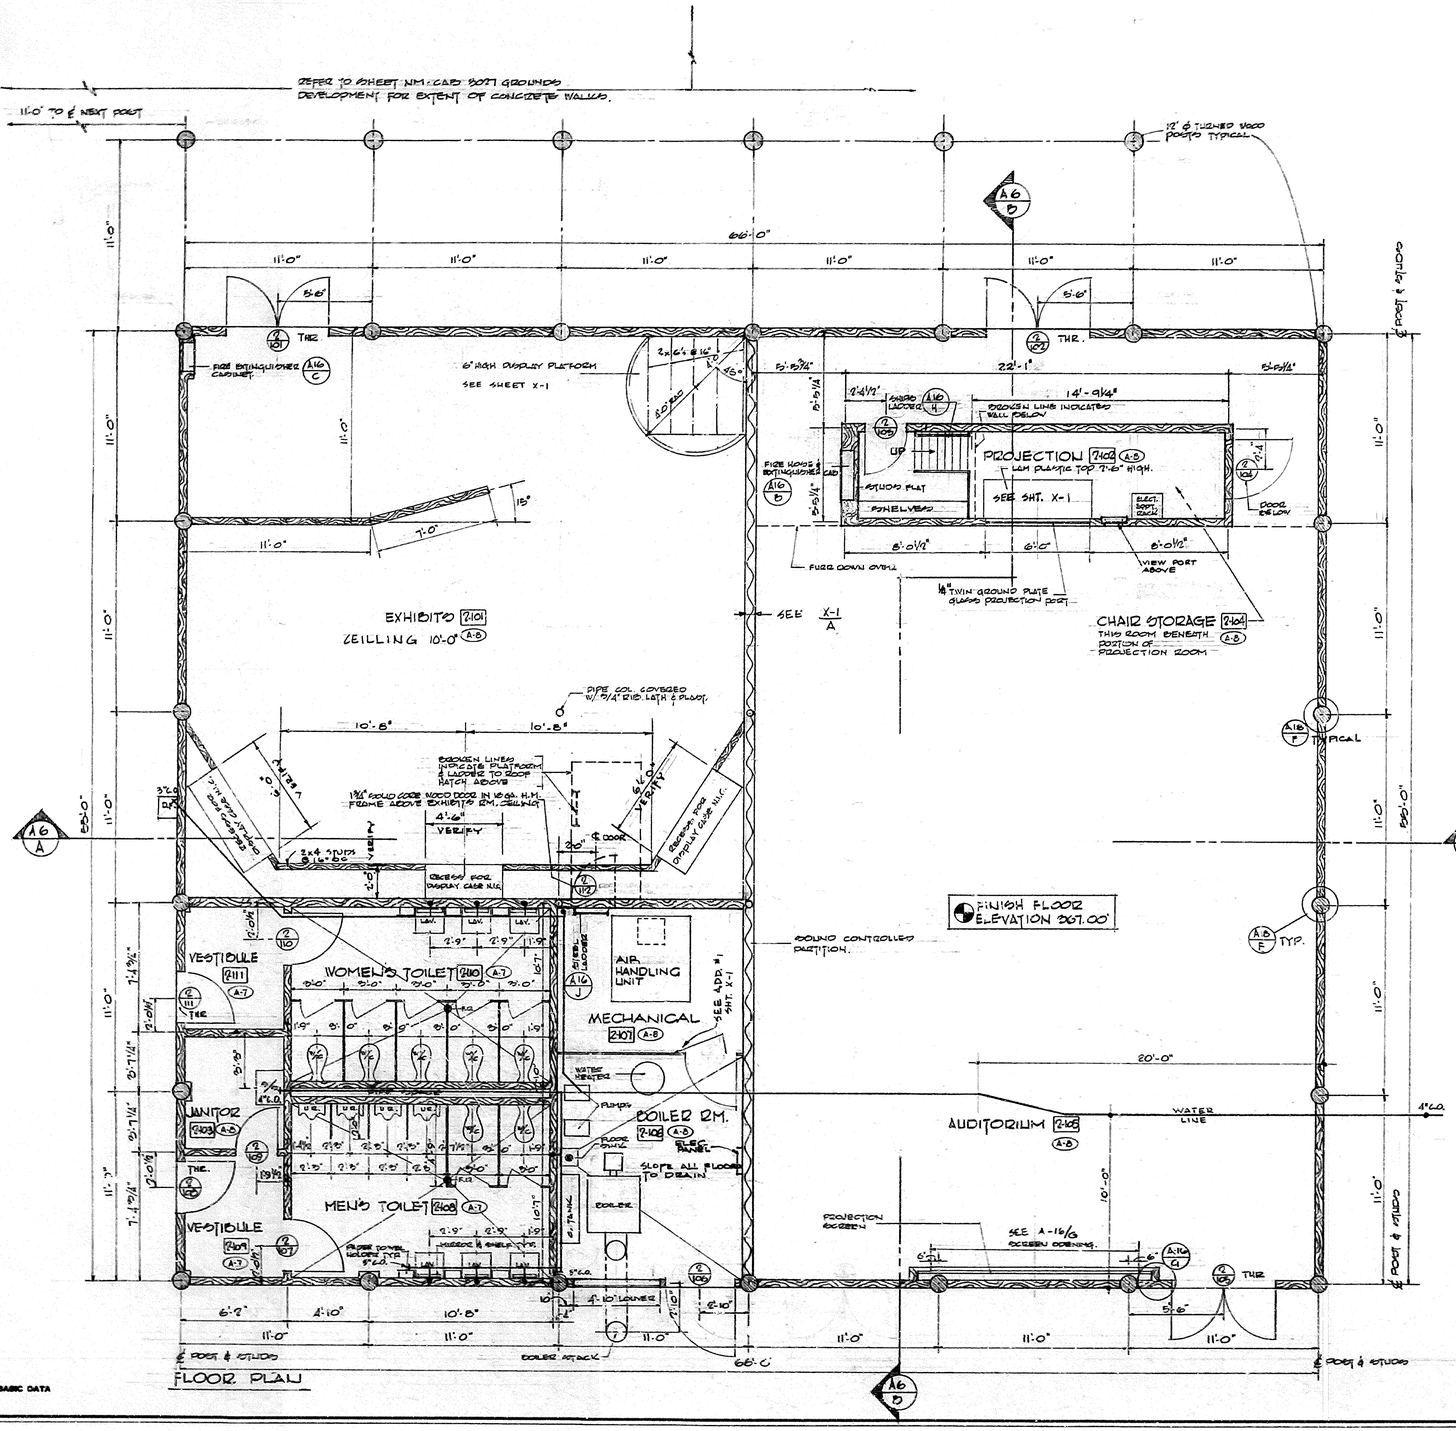

FLOOR PLAN

BASIC DATA

INTERIOR FINISH SCHEDULE

ROOM No	ROOM NAME	FLOOR: VINYL ASB. TILE	FLOOR: CERAMIC TILE	FLOOR: CEMENT	FLOOR: NOTE No	FLOOR: COLOR	BASE: RUBBER COVE	BASE: CERAMIC TILE	BASE: CEMENT	BASE: COLOR	WALLS: PLASTER FINISH	WALLS: PLASTER PAINT	WALLS: WOOD PANELING	WALLS: ACOUSTIC TILE	WALLS: MATCHING VINYL SHEETING	WALLS: COLOR	CEILING: PLASTER FINISH	CEILING: ACOUSTIC TILE	CEILING: PLASTER PAINT	CEILING: HEIGHT	CEILING: NOTE No	CEILING: COLOR
2-101	EXHIBITS	●				1	●			4		●				6		●		8'		—
2-102	PROJECTION	●				1	●			4		●				7			●	:		14
2-103	JANITOR		●			2		●		2	●					7	●			8'		14
2-104	CHAIR STORAGE	●				1	●			4		●				7			●	6'		14
2-106	AUDITORIUM	●				1	●			4		●	●	●		8 & 9		●			1	—
2-108	BOILER RM.		●	●		—			●	—	●					7	●				1	14
2-107	MECHANICAL		●	●		—			●	—	●					7	●				1	14
2-108	MEN'S TOILET		●			2		●		2					●	10 & 11	●			8'		14
2-109	VESTIBULE		●			2		●		2					●	10	●			8'		14
2-110	WOMEN'S TOILET		●			3		●		3					●	12 & 13	●			8'		15
2-111	VESTIBULE		●			3		●		3					●	12	●			8'		15

INTERIOR FINISH SCHEDULE NOTES:
1. CEILING HEIGHT VARIES. REFER TO BUILDING SECTIONS AND INTERIOR ELEVATIONS.

COLOR SELECTIONS

1. RUBEROID #3850 PARCHMENT
2. BEACH TAN, AMERICAN OLEAN TILE CO.
3. PEPPER WHITE, AMERICAN OLEAN TILE CO.
4. #701-P, BURKE
5. #502-P, BURKE
6. VOGUE #220-1D, AMERITONE
7. CINDER #220-1C, AMERITONE
8. WHITE SHADOW #137F, AMERITONE
9. NATURAL FINISH
10. G-65-11, DESCO GLAZETITE
11. #33 LIGHT IVORY, SANYMETAL - TOILET PARTITIONS
12. G-63-31, DESCO GLAZETITE
13. #52 BLUE, SANYMETAL - TOILET PARTITIONS
14. AGATE #243H, AMERITONE
15. BIRCH WHITE #245-G, AMERITONE
16. CLOVE BROWN #139A, AMERITONE - BOTH SIDES
17. WHITE SHADOW #13F, AMERITONE - INSIDE
    NATURAL FINISH - OUTSIDE
18. CINDER #220-1C, AMERITONE - INSIDE
    NATURAL FINISH - OUTSIDE
19. CINDER #220-1C, AMERITONE - INSIDE
    CLOVE BROWN #139A, AMERITONE - OUTSIDE
20. CINDER #220-1C, AMERITONE - BOTH SIDES
21. NATURAL FINISH - BOTH SIDES
22. NADLES BLUE #119-B, AMERITONE - INSIDE
    CLOVE BROWN #139, AMERITONE - OUTSIDE
23. NADLES BLUE #119-B, AMERITONE - BOTH SIDES

DOOR SCHEDULE

DOOR No	PAIR	OPENING SIZE	TYPE	HARDWARE ITEM	COLOR	NOTE No	DETAILS: HEAD	DETAILS: JAMBS	DETAILS: SILL	MISC.
2-101	●	6'-0" x 8'-0"	B	2	16	1	A15/1	A15/1	A15/16	
2-102	●	6'-0" x 8'-0"	B	2	16	1	A15/1	A15/1	A15/16	
2-103		2'-6" x 7'-0"	C	7	21	2	A15/2	A15/2		
2-104		3'-6" x 5'-6"	C	8	21		A15/2	A15/2		
2-105	●	6'-0" x 8'-0"	D	2	17	1/3	A15/3	A15/3	A15/8	
2-106		4'-0" x 6'-0"	D	3	18		A15/3	A15/3		
2-107		3'-0" x 7'-0"	E	5	20		A15/4	A15/4		
2-108		3'-0" x 7'-0"	E	4	19		A15/5	A15/5	A15/10	
2-109		2'-6" x 7'-0"	E	6	20		A15/4	A15/4		
2-110		3'-0" x 7'-0"	E	5	23		A15/4	A15/4		
2-111		3'-0" x 7'-0"	E	4	22		A15/5	A15/5	A15/10	
2-112		2'-8" x 4'-0"	C	9	20		A15/4	A15/4	A15/4	

NOTE DOOR TYPES SHOWN ON SHEET A15

DOOR SCHEDULE NOTES
1. WEATHERSTRIP DOOR
2. UNDERCUT DOOR 3/4"
3. THRESHOLD SILL TO A15/8 BUT 4" WIDE

EXTERIOR FINISH SCHEDULE

1. ALL EXPOSED WOOD - NATURAL FINISH
2. ALL EXPOSED SHEET METAL & METAL LOUVERS - THATCH BROWN 238-1A AMERITONE
3. BOILER STACK - BASTILE #137A AMERITONE
4. CONCRETE - CLEAR SEALER

NOTES:

1. COLOR FOR PIPE RAILING, STEEL LADDER, SHIP LADDER, PLATFORM, HATCH, & MECH. EQUIP. - CINDER #220-1C AMERITONE
2. COLOR FOR PIPE COL. AT EXHIBITS ROOM - CINDER #220-1C AMERITONE

ORIENTATION

FRANK L. HOPE & ASSOCIATES
ARCHITECTS & ENGINEERS
FRANK L. HOPE JR.
REGISTERED ARCHITECT - CEBAB

PREPARED	
DESIGNED	J.E.D.
DRAWN	T.C. EADS
CHECKED	F.B.
ARCH.	
ELEC.	
MECH.	
STRUC.	
REVISED	
DATE	INITIAL
5-66	GHW

A5

SCALE 1/4" = 1'-0"

UNITED STATES
DEPARTMENT OF THE INTERIOR
NATIONAL PARK SERVICE

FRANK L. HOPE & ASSOCIATES
ARCHITECTS AND ENGINEERS — OFFICE — SAN DIEGO, CALIFORNIA

BLDG No 2 FLOOR PLAN, INT. FINISH & DOOR SCHEDULE
TITLE OF DRAWING

VISITOR CENTER
CABRILLO NATIONAL MONUMENT
NAME OF PARK

REGION	WESTERN
PCP NO.	
SHT 5 OF 55	
DRAWING NO.	NM-CAB 3012-F
DATE MAY, 1965	

AS CONSTRUCTED DRAWING