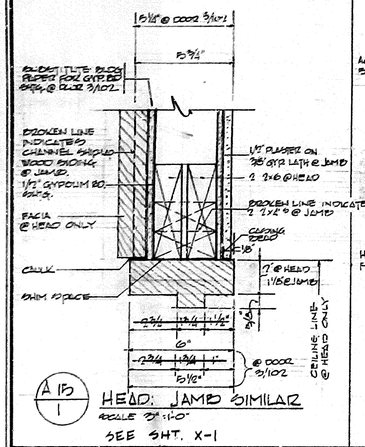

A 15 / 1 HEAD: JAMB SIMILAR
SCALE 3" = 1'-0"
SEE SHT. X-1

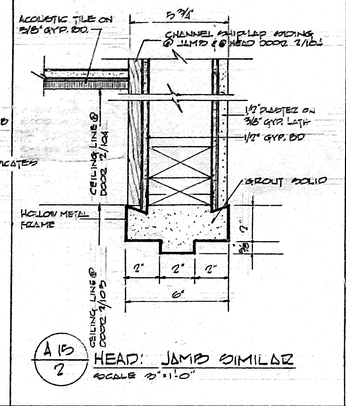

A 15 / 2 HEAD: JAMB SIMILAR
SCALE 3" = 1'-0"

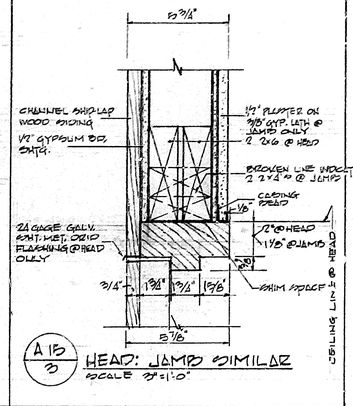

A 15 / 3 HEAD: JAMB SIMILAR
SCALE 3" = 1'-0"

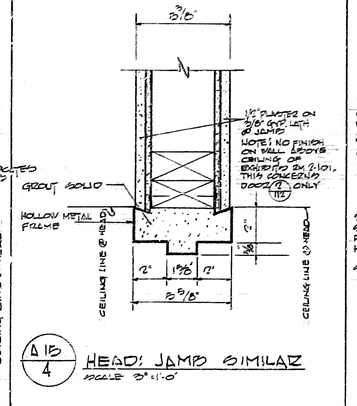

A 15 / 4 HEAD: JAMB SIMILAR
SCALE 3" = 1'-0"

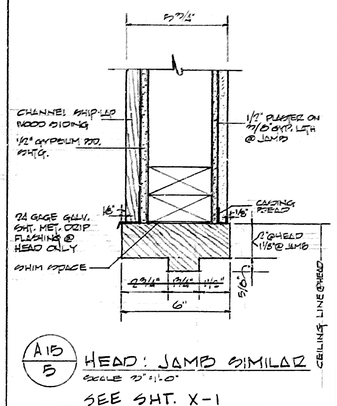

A 15 / 5 HEAD: JAMB SIMILAR
SCALE 3" = 1'-0"
SEE SHT. X-1

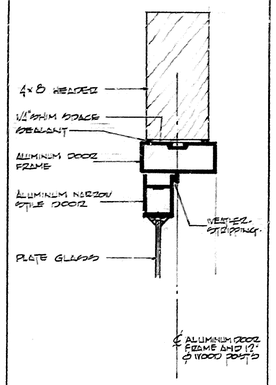

A 15 / 6 HEAD
SCALE 3" = 1'-0"

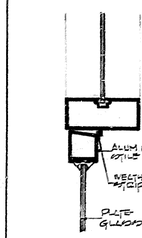

A 15 / 7 JAMB
SCALE 3" = 1'-0"

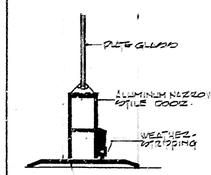

A 15 / 8 SILL
SCALE 3" = 1'-0"

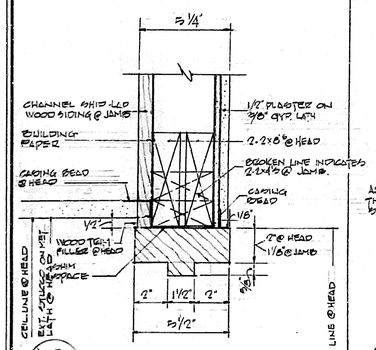

A 15 / 9 HEAD: JAMB SIMILAR
SCALE 3" = 1'-0"

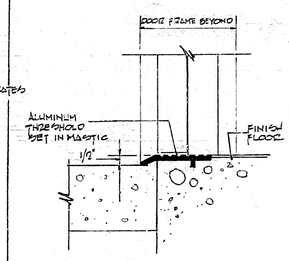

A 15 / 10 SILL
SCALE 3" = 1'-0"

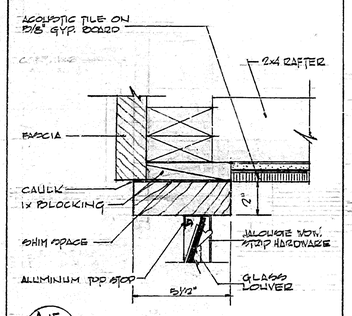

A 15 / 11 HEAD
SCALE 3" = 1'-0"

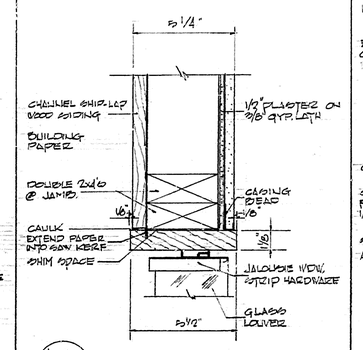

A 15 / 12 JAMB
SCALE 3" = 1'-0"

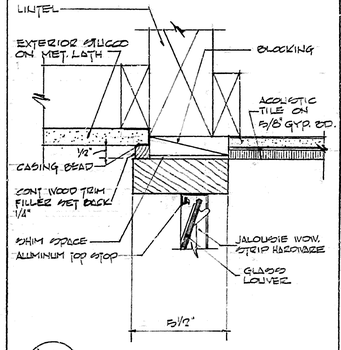

A 15 / 13 HEAD
SCALE 3" = 1'-0"

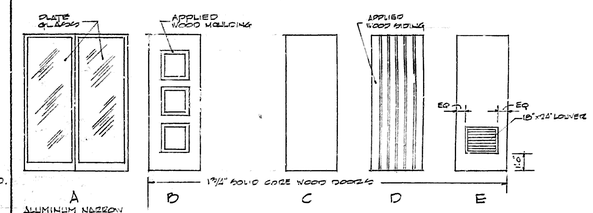

DOOR TYPES

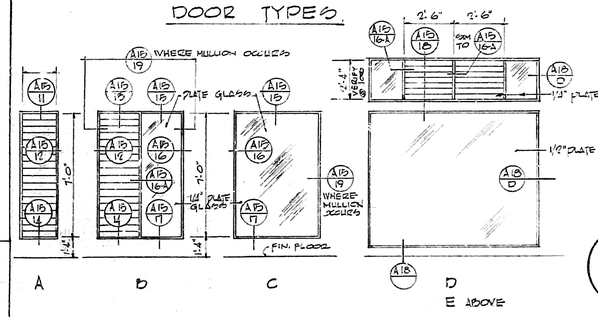

WINDOW TYPES

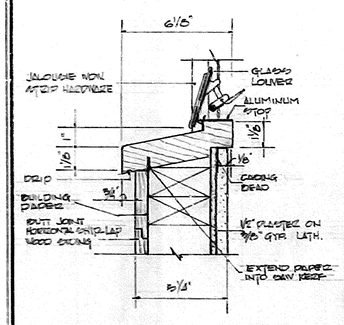

A 15 / 14 SILL
SCALE 3" = 1'-0"
BASIC DATA

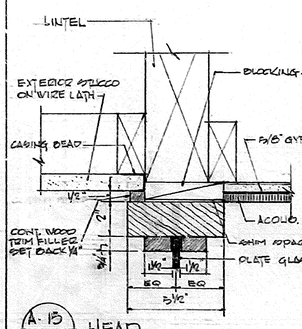

A 15 / 15 HEAD
SCALE 3" = 1'-0"

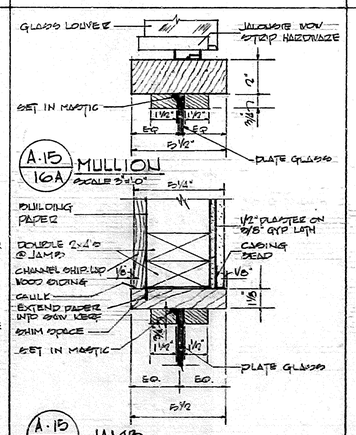

A 15 / 16A MULLION
SCALE 3" = 1'-0"

A 15 / 16 JAMB
SCALE 3" = 1'-0"

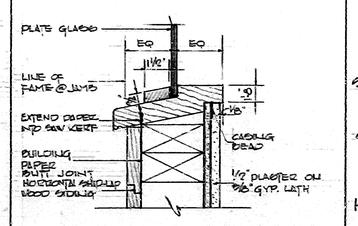

A 15 / 17 SILL
SCALE 3" = 1'-0"

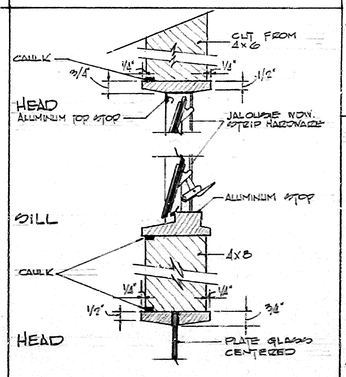

A 15 / 18 HEAD & SILL
SCALE 3" = 1'-0"

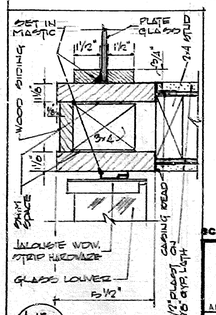

A 15 / 19 MULLION
SCALE 3" = 1'-0"

ORIENTATION

FRANK L. HOPE & ASSOCIATES
ARCHITECTS & ENGINEERS
FRANK L. HOPE JR.
REGISTERED ARCHITECT - C8848

PREPARED	
DESIGNED	J.E.P.
DRAWN	T.C. BADS
CHECKED	F.P.
ARCH.	
ELEC.	
MECH.	
STRUC.	
REVISED	
DATE	INITIAL
3-66	GHW

A15

SCALE 3" = 1'-0"

UNITED STATES
DEPARTMENT OF THE INTERIOR
NATIONAL PARK SERVICE

FRANK L. HOPE & ASSOCIATES
ARCHITECTS AND ENGINEERS OFFICE SAN DIEGO, CALIFORNIA

DOOR TYPES & DETAILS, WINDOW TYPES & DETAILS
TITLE OF DRAWING
VISITORS CENTER
LOCATION WITHIN PARK
CABRILLO NATIONAL MONUMENT
NAME OF PARK

REGION	WESTERN
PCP NO.	
SHT. 15 OF 55	
DRAWING NO.	NM-CAB 8002-F
DATE MAY 1965	

AS CONSTRUCTED DRAWING

17