BLDG 19225 NCOA FACILITY

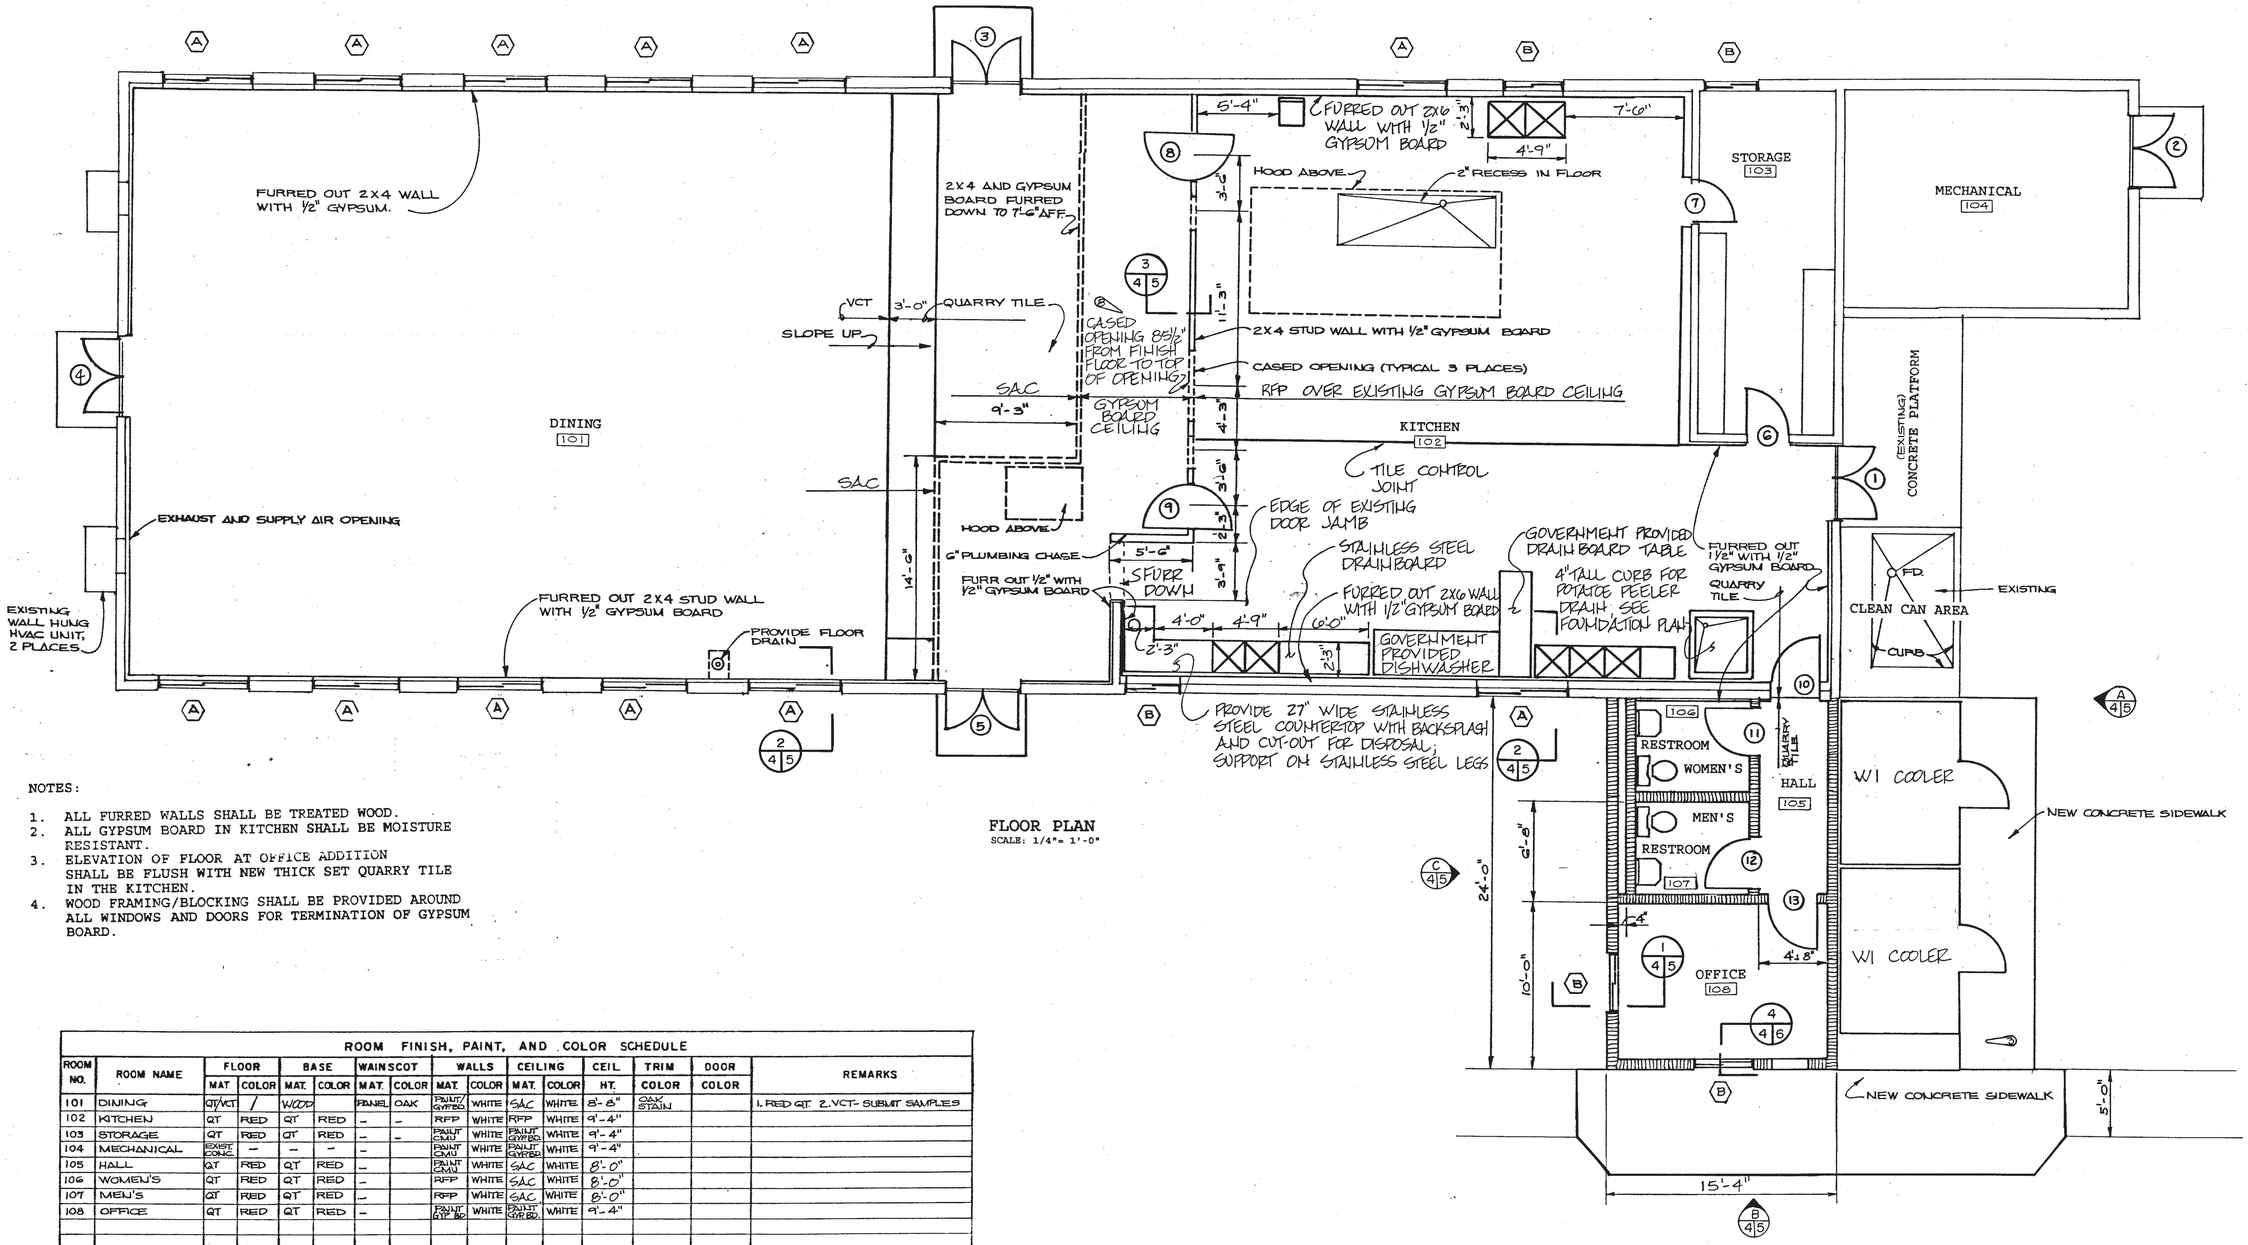

NOTES:

1. ALL FURRED WALLS SHALL BE TREATED WOOD.
2. ALL GYPSUM BOARD IN KITCHEN SHALL BE MOISTURE RESISTANT.
3. ELEVATION OF FLOOR AT OFFICE ADDITION SHALL BE FLUSH WITH NEW THICK SET QUARRY TILE IN THE KITCHEN.
4. WOOD FRAMING/BLOCKING SHALL BE PROVIDED AROUND ALL WINDOWS AND DOORS FOR TERMINATION OF GYPSUM BOARD.

FLOOR PLAN
SCALE: 1/4"= 1'-0"

ROOM FINISH, PAINT, AND COLOR SCHEDULE

ROOM NO.	ROOM NAME	FLOOR		BASE		WAINSCOT		WALLS		CEILING		CEIL.	TRIM	DOOR	REMARKS
		MAT.	COLOR	MAT.	COLOR	MAT.	COLOR	MAT.	COLOR	MAT.	COLOR	HT.	COLOR	COLOR	
101	DINING	QT/VCT	/	WOOD		PANEL	OAK	PAINT/GYPBD.	WHITE	SAC	WHITE	8'-6"	OAK STAIN		1. RED QT. 2. VCT- SUBMIT SAMPLES
102	KITCHEN	QT	RED	QT	RED	–	–	RFP	WHITE	RFP	WHITE	9'-4"			
103	STORAGE	QT	RED	QT	RED	–	–	PAINT CMU	WHITE	PAINT GYPBD.	WHITE	9'-4"			
104	MECHANICAL	EXIST. CONC.	–	–	–	–		PAINT CMU	WHITE	PAINT GYPBD.	WHITE	9'-4"			
105	HALL	QT	RED	QT	RED	–		PAINT CMU	WHITE	SAC	WHITE	8'-0"			
106	WOMEN'S	QT	RED	QT	RED	–		RFP	WHITE	SAC	WHITE	8'-0"			
107	MEN'S	QT	RED	QT	RED	–		RFP	WHITE	SAC	WHITE	8'-0"			
108	OFFICE	QT	RED	QT	RED	–		PAINT GYP BD.	WHITE	PAINT GYP BD.	WHITE	9'-4"			

NOTE:
THIS SCHEDULE IS NOT TO BE CONSTRUED AS A SPECIFICATION OF MATERIALS OTHER THAN FOR COLOR AND TEXTURE.

LEGEND OF COLORS
FOR PAINT AND PREFINISHED ITEMS

(VCT) VINYL COMPOSITION TILE - ARMSTRONG
(CMT) CERAMIC MOSAIC TILE - AMERICAN OLEAN
(MGT) MATTE GLAZED TILE (CERAMIC) - MIDSTATE
(RB) RESILIENT BASE - ARMSTRONG
(RFP) REINFORCED FIBERGLASS PANELS
(QT) QUARRY TILE
(SAC) SUSPENDED ACOUSTICAL CEILING
(PANEL) WOOD VENEER TAMBOUR 140 SOLID WHITE OAK - NATIONAL PRODUCTS, INC.
PAINT - FEDERAL STANDARD 595

DOOR SCHEDULE

DOOR NO.	*SEE TYPE BELOW	MATL.	FRAME	SIZE WIDTH	SIZE HEIGHT	SIZE THICK	CLOSER	LOUVER	THRES.	REMARKS	HEAD	JAMB	SILL	HDWE
1	G	MTL	MTL	2'-6"	6'-10"	1 3/4"	YES	NO	YES		H1	J1	S1	HW-1
2	F	MTL	MTL	2'-3"	7'-0"	1 3/4"	HOLDER	YES	NO		H3	J3	S3	HW-2
3	G	MTL	MTL	2'-6"	6'-10"	1 3/4"	YES	NO	YES		H1	J1	S1	HW-1
4	G	MTL	MTL	2'-6"	7'-0"	1 3/4"	YES	NO	YES		H1	J1	S1	HW-1
5	G	MTL	MTL	2'-6"	6'-10"	1 3/4"	YES	NO	YES		H1	J1	S1	HW-1
6	F	MTL	MTL	2'-8"	7'-0"	1 3/4"	NO	NO	NO		H1	J1	S1	HW-3
7	F	MTL	MTL	2'-8"	7'-0"	1 3/4"	NO	NO	NO		H1	J1	S1	HW-3
8	N	MTL	MTL	3'-0"	7'-0"	1 3/4"	SPRING HINGE	NO	NO		H4	J4	–	HW-4
9	N	MTL	MTL	3'-0"	7'-0"	1 3/4"	SPRING HINGE	NO	NO		H4	J4	–	HW-4
10	N	MTL	MTL	3'-0"	7'-0"	1 3/4"	NO	NO	NO		H1	J1	S1	HW-5
11	F	MTL	MTL	3'-0"	7'-0"	1 3/4"	NO	NO	NO		H3	J3	S3	HW-6
12	F	MTL	MTL	3'-0"	7'-0"	1 3/4"	NO	NO	NO		H3	J3	S3	HW-6
13	N	MTL	MTL	3'-0"	7'-0"	1 3/4"	NO	NO	NO		H3	J3	S3	HW-7

TYPE:
*STEEL DOOR INSTITUTE, STANDARD DOOR TYPE NOMENCLATURE

NOTE: CONTRACTOR SHALL BE RESPONSIBLE FOR MEASURING AND FITTING DOORS/FRAMES TO ALL EXISTING DOOR OPENINGS. DIMENSIONS SHOWN ARE APPROXIMATE.

REVISION	DATE	DESCRIPTION	BY
	8/10/01	AS-BUILT DRAWING	
2	12/20/00	ADDED 85½" OPENING NOTE	PP
3	2/14/00	CHANGED SIDEWALK	PP

OFFICE OF THE ENGINEER
FORT STEWART, GEORGIA

UPGRADE DINING FACILITY AT NCO ACADEMY
BUILDING 19225
ARCHITECTURAL

FT. STEWART
LIBERTY COUNTY GEORGIA

SCALE: AS SHOWN
DRAWN BY: JEAN GAY
DESIGN BY: DATE:
DRAWING NUMBER FS-2479 SHEET 4 OF 14

BLDGS H1 (12902_12903)_H2 (13102_13103)_H3(13302_13303)
GGTC FACILITIES (ALL THREE ARE IDENTICAL)

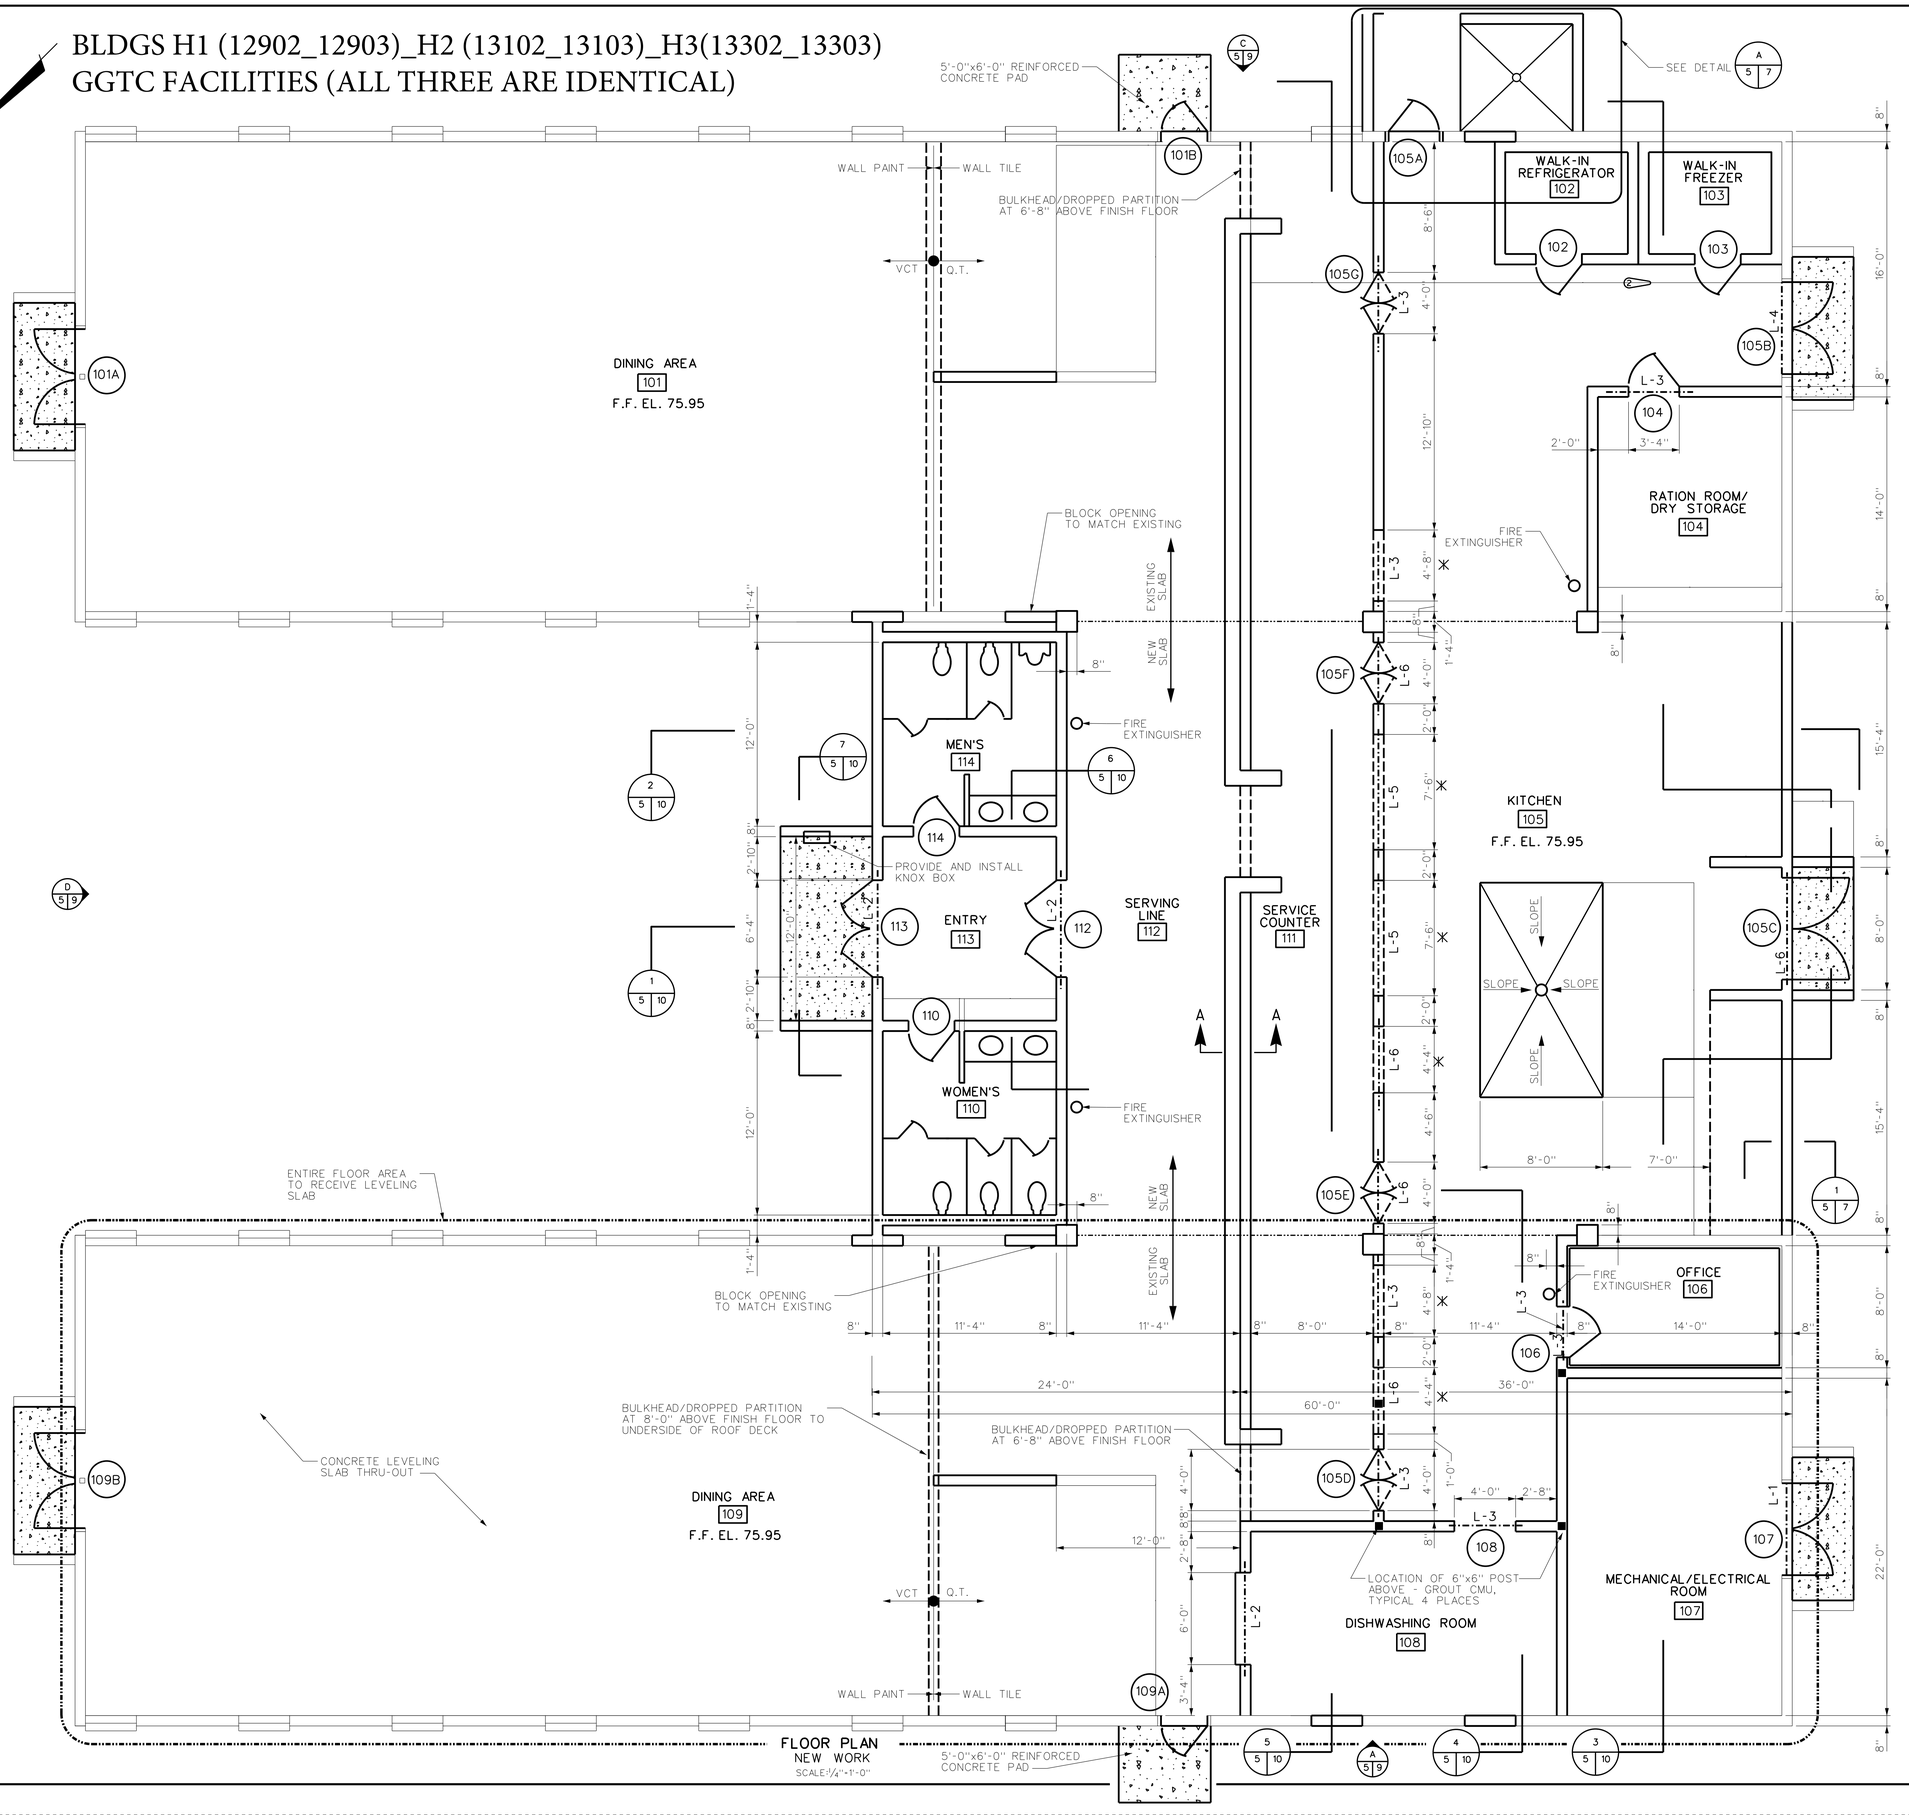

LINTEL SCHEDULE	
MARK	DESCRIPTION
L-1	3½"x9½" VERSA-LAM OR EQUAL
L-2	CMU - U BLOCK, 8" WIDE x 8" HIGH WITH 2-#6 BARS, MINIMUM 8" BEARING EACH END
L-3	CUM - U BLOCK, 8" WIDE x 8" HIGH WITH 2-#4 BARS, MINIMUM 8" BEARING EACH END
L-4	2 - 2x10 WITH½" PLYWOOD BETWEEN
L-5	PRE-CAST 8" WIDE x 8" HIGH WITH 2-#5 BARS TOP AND 2-#5 BARS BOTTOM, MINIMUM 8" BEARING EACH END
L-6	PRE-CAST 8" WIDE x 8" HIGH 2-#4 BARS TOP AND 2-#4 BARS BOTTOM, MINIMUM 8" BEARING EACH END

NOTES:

1. PROVIDE CEMENT TILE BACKER BOARD AT EXISITNG MASONRY WALLS SCHEDULED TO RECEIVE TILE.
2. PROVIDE METAL FURRING AND ⅝" GYPSUM BOARD WALL FINISH IN OFFICE 106.
3. PROVIDE INTERIOR CMU WALLS WITH HORIZONTAL JOINT REINFORCED AT 16" O.C., VERTICAL AND BOND BEAM WITH 2-#4's AT TOP WALL.

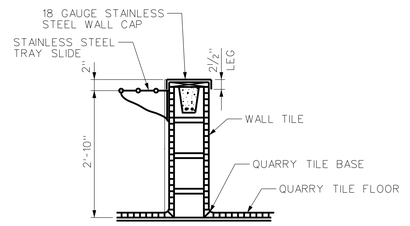

A-A
SCALE: ¾"-1'-0"

TOTAL SQ/FT : 9,206
MECH RM SQ/FT : 332
USEABLE SPACE : 8,874

* DIMENSIONS FOR KITCHEN EQUIPMENT OPENINGS SHALL BE COORDINATED WITH THE KITCHEN EQUIPMENT SUPPLIER.

REVISION	DATE	DESCRIPTION	BY
2	2-18-04	MISCELLANEOUS CHANGES	RC

OFFICE OF THE ENGINEER
FORT STEWART, GEORGIA

CONVERT NATIONAL GUARD MESS TO DFAC, BUILDING 12902 AND 12903
ARCHITECTURAL
FT. STEWART
LIBERTY COUNTY GEORGIA

SCALE: AS SHOWN
DRAWN BY: PBP
JIM SEARFOSS 1-04
DESIGN BY: DATE
DRAWING NUMBER FS-2688
SHEET 5 OF 26

WG-23-4J

BLDG 110

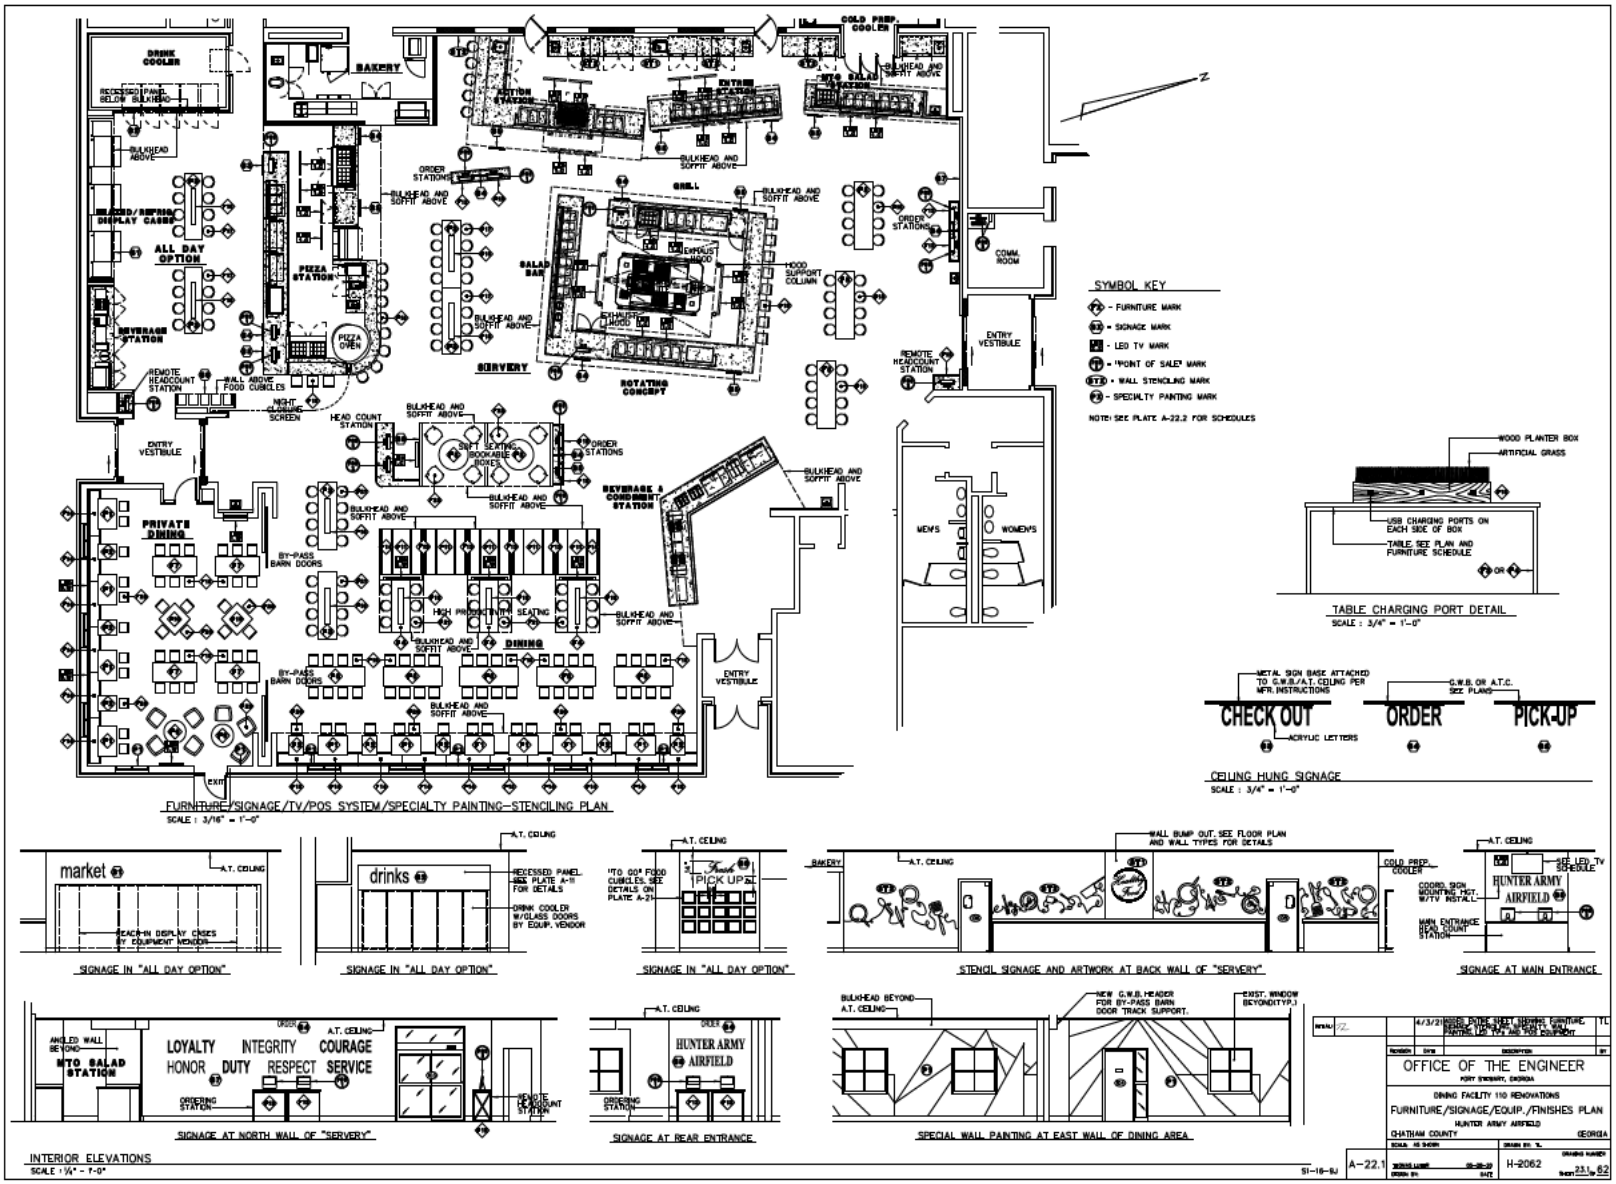
SYMBOL KEY
FURNITURE/SIGNAGE/TV/POS SYSTEM/SPECIALTY PAINTING-STENCILING PLAN
SCALE : 3/16" = 1'-0"
TABLE CHARGING PORT DETAIL
SCALE : 3/4" = 1'-0"
CEILING HUNG SIGNAGE
SCALE : 3/4" = 1'-0"
CHECK OUT
ORDER
PICK-UP
SIGNAGE IN "ALL DAY OPTION"
SIGNAGE IN "ALL DAY OPTION"
SIGNAGE IN "ALL DAY OPTION"
STENCIL SIGNAGE AND ARTWORK AT BACK WALL OF "SERVERY"
SIGNAGE AT MAIN ENTRANCE
SIGNAGE AT NORTH WALL OF "SERVERY"
SIGNAGE AT REAR ENTRANCE
SPECIAL WALL PAINTING AT EAST WALL OF DINING AREA
INTERIOR ELEVATIONS
SCALE : 1/4" = 1'-0"
OFFICE OF THE ENGINEER
FORT STEWART, GEORGIA
DINING FACILITY 110 RENOVATIONS
FURNITURE/SIGNAGE/EQUIP./FINISHES PLAN
HUNTER ARMY AIRFIELD
CHATHAM COUNTY
GEORGIA
A-22.1
H-2062