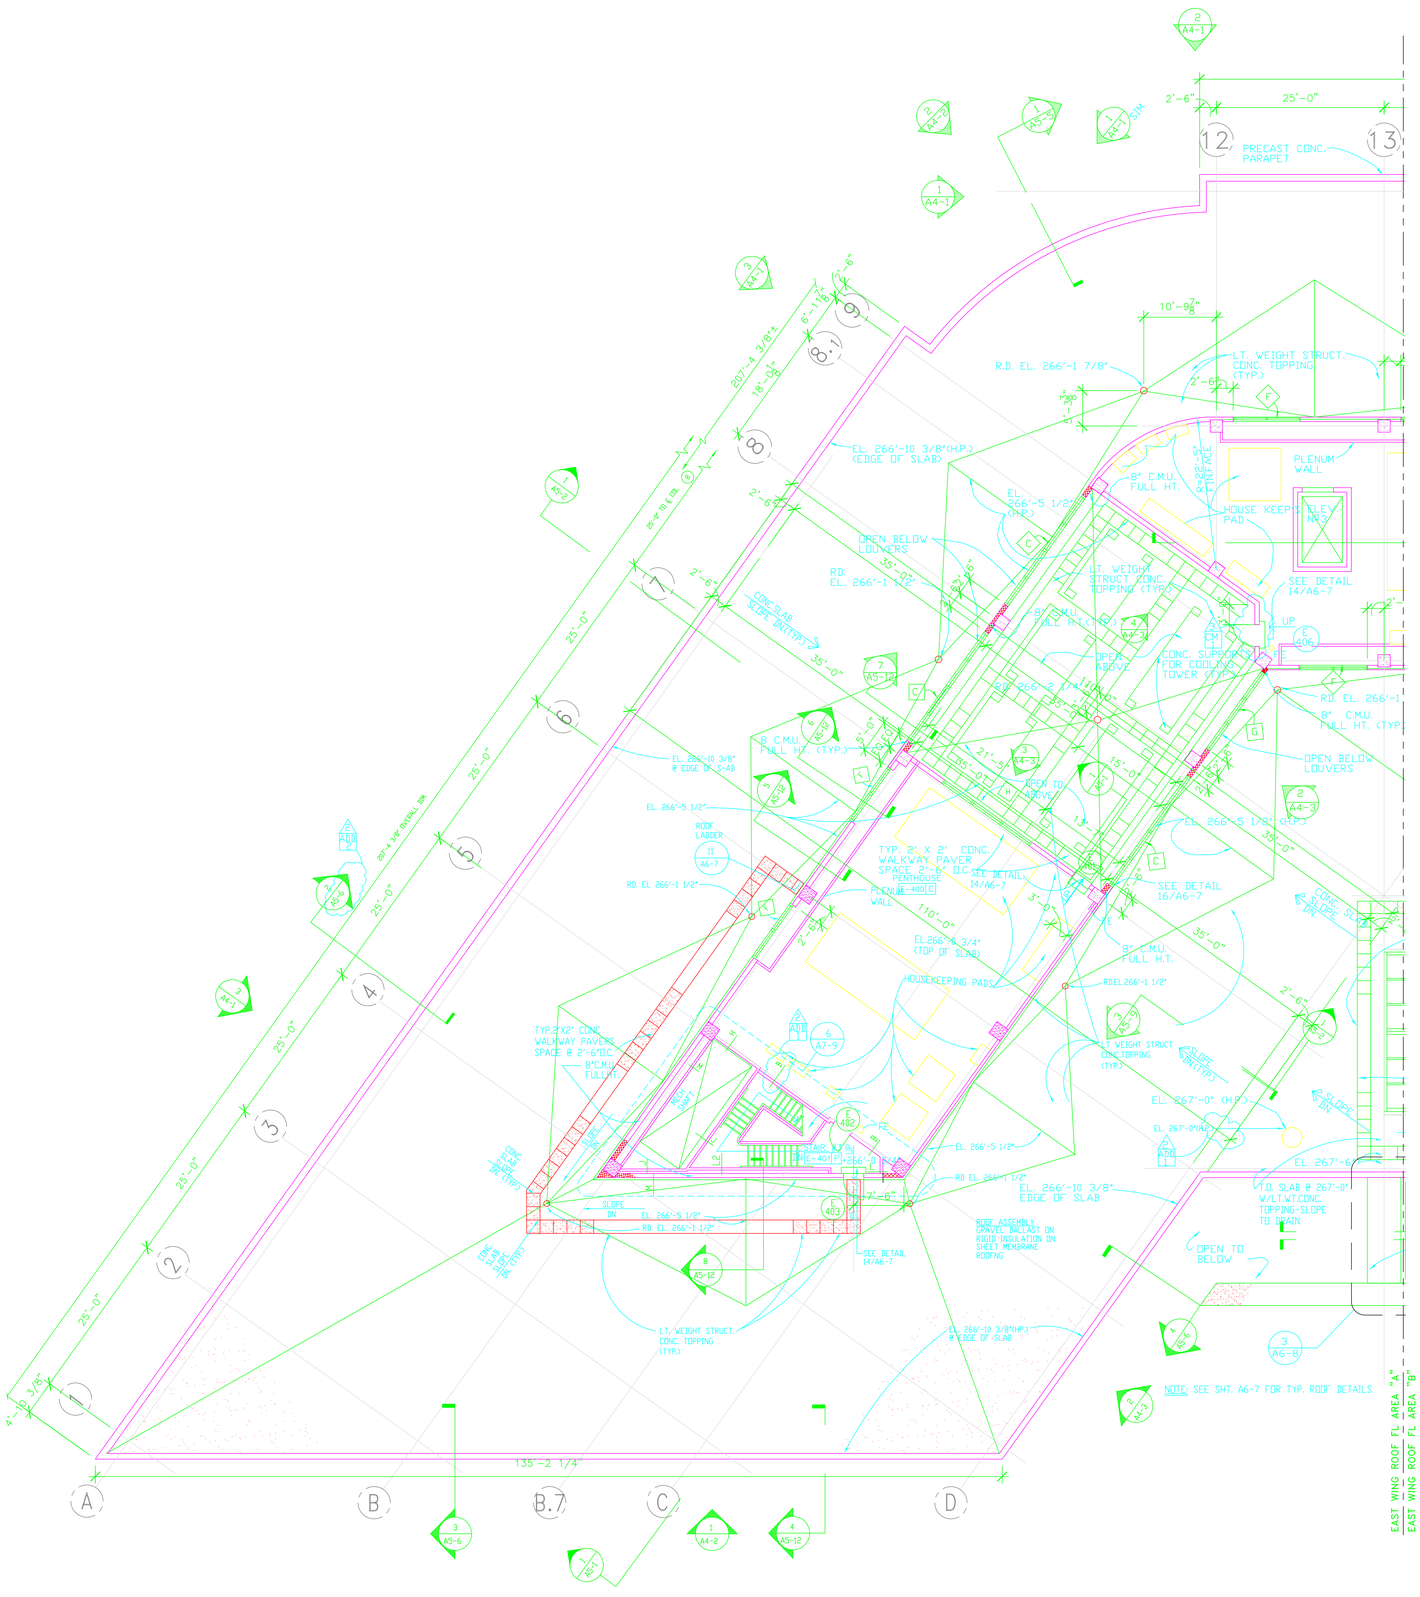

SmithGroup
1825 Eye Street NW
Suite 250
Washington DC 20006
202.842.2100 P
202.974.4500 D

AS-BUILT DRAWINGS
These as-built drawings have been prepared in part, on the basis of information completed and furnished by others. SmithGroup will not be responsible for any errors on omissions which have been incorporated into this document as a result.

THE ARMY NATIONAL GUARD CENTER
AT ARLINGTON HALL, VIRGINIA

SmithGroup
Architecture and Engineering
WASHINGTON, D.C.

REVISIONS:

EAST PARKING STRUCTURE
EAST WING
NORTH
LOADING DOCK
ATRIUM
WEST WING
WEST PARKING STRUCTURE

KEY PLAN
NO SCALE

EAST WING AREA "A"

SHEET TITLE
PARTITION PLAN PENTHOUSE ROOF

DRAWN	EL, SM
CHECKED	WRJ, EL
SCALE	1/8"=1'-0"
DATE	02.05.02

SHEET NO.
A2-8

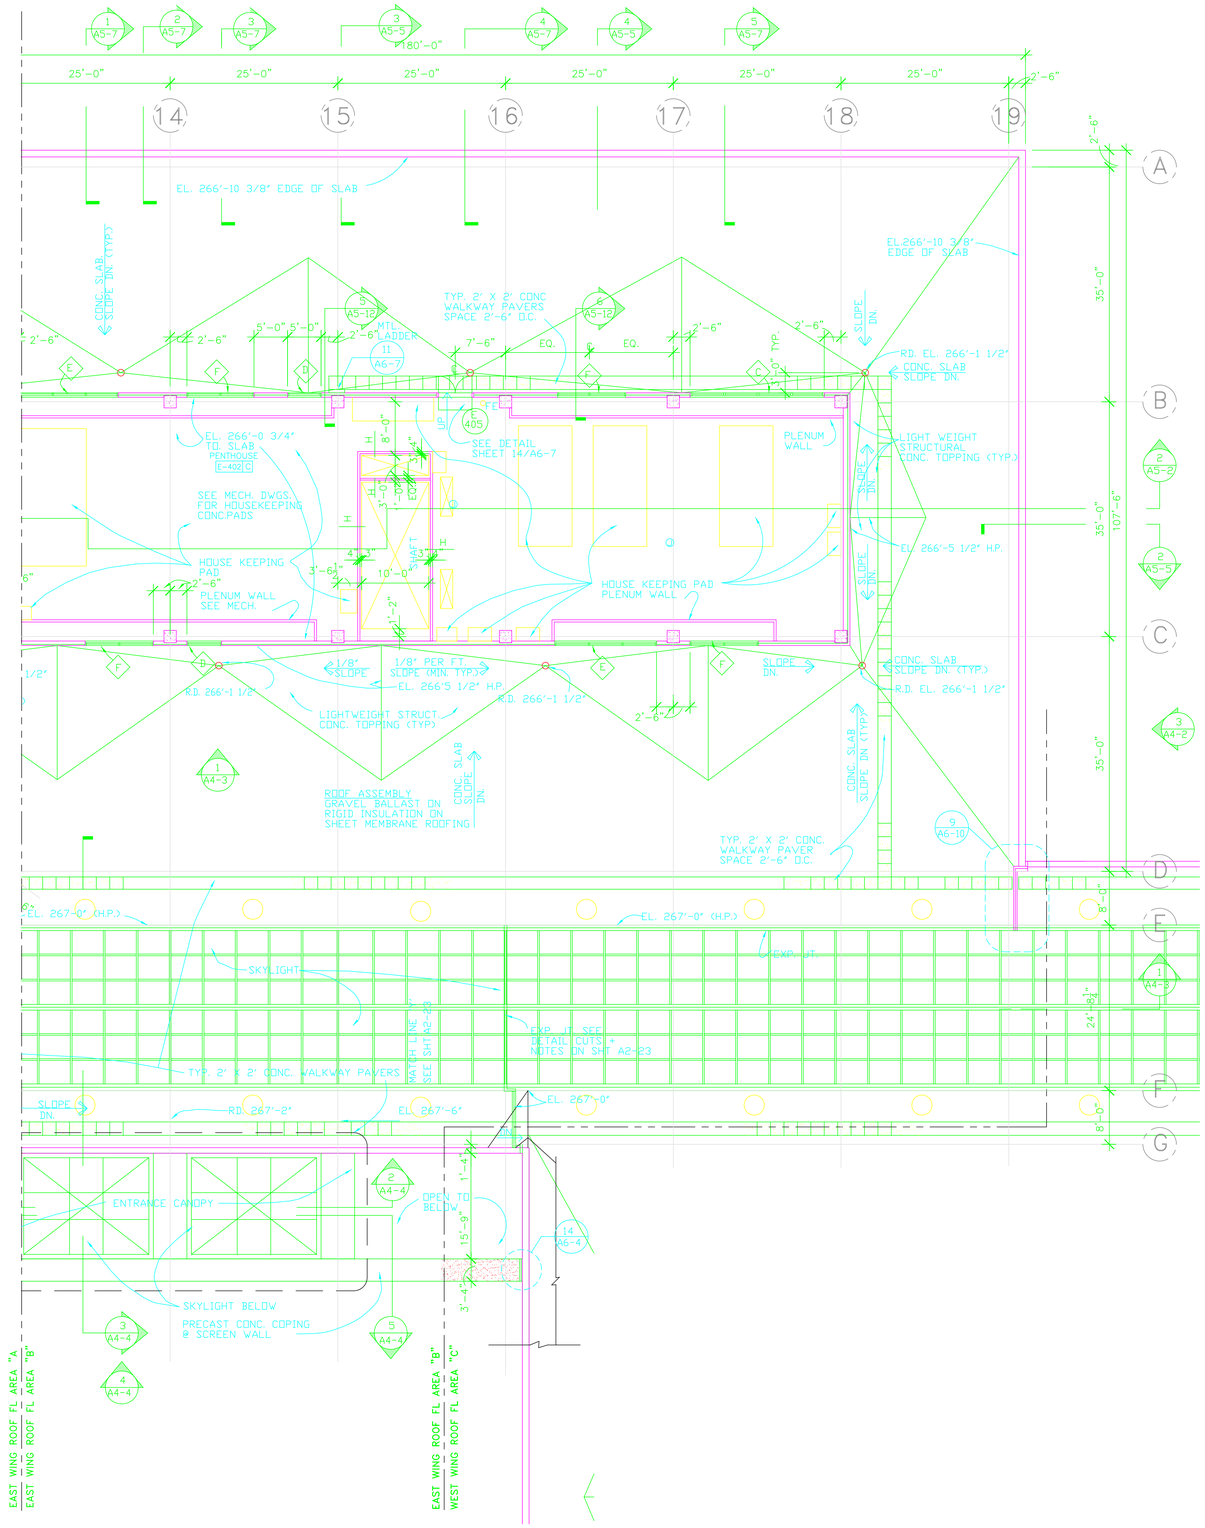

SmithGroup
1825 Eye Street NW
Suite 250
Washington DC 20006
202.842.2100
202.974.4500

AS-BUILT DRAWINGS

These as-built drawings have been prepared in part, on the basis of information completed and furnished by others. SmithGroup will not be responsible for any errors on omissions which have been incorporated into this document as a result.

THE ARMY NATIONAL GUARD CENTER
AT ARLINGTON HALL, VIRGINIA

SmithGroup
Architecture and Engineering
WASHINGTON, D.C.

REVISIONS:

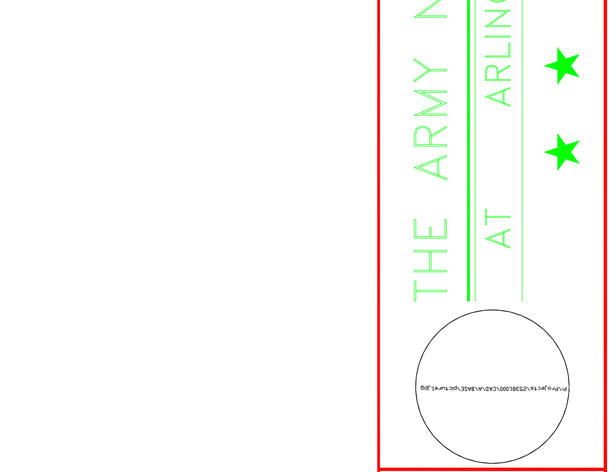

KEY PLAN
NO SCALE

EAST WING AREA "B"

SHEET TITLE
PARTITION PLAN PENTHOUSE ROOF

DRAWN	EL, SM
CHECKED	WRJ, EL
SCALE	1/8"=1'-0"
DATE	02.05.02

SHEET NO.
A2-9

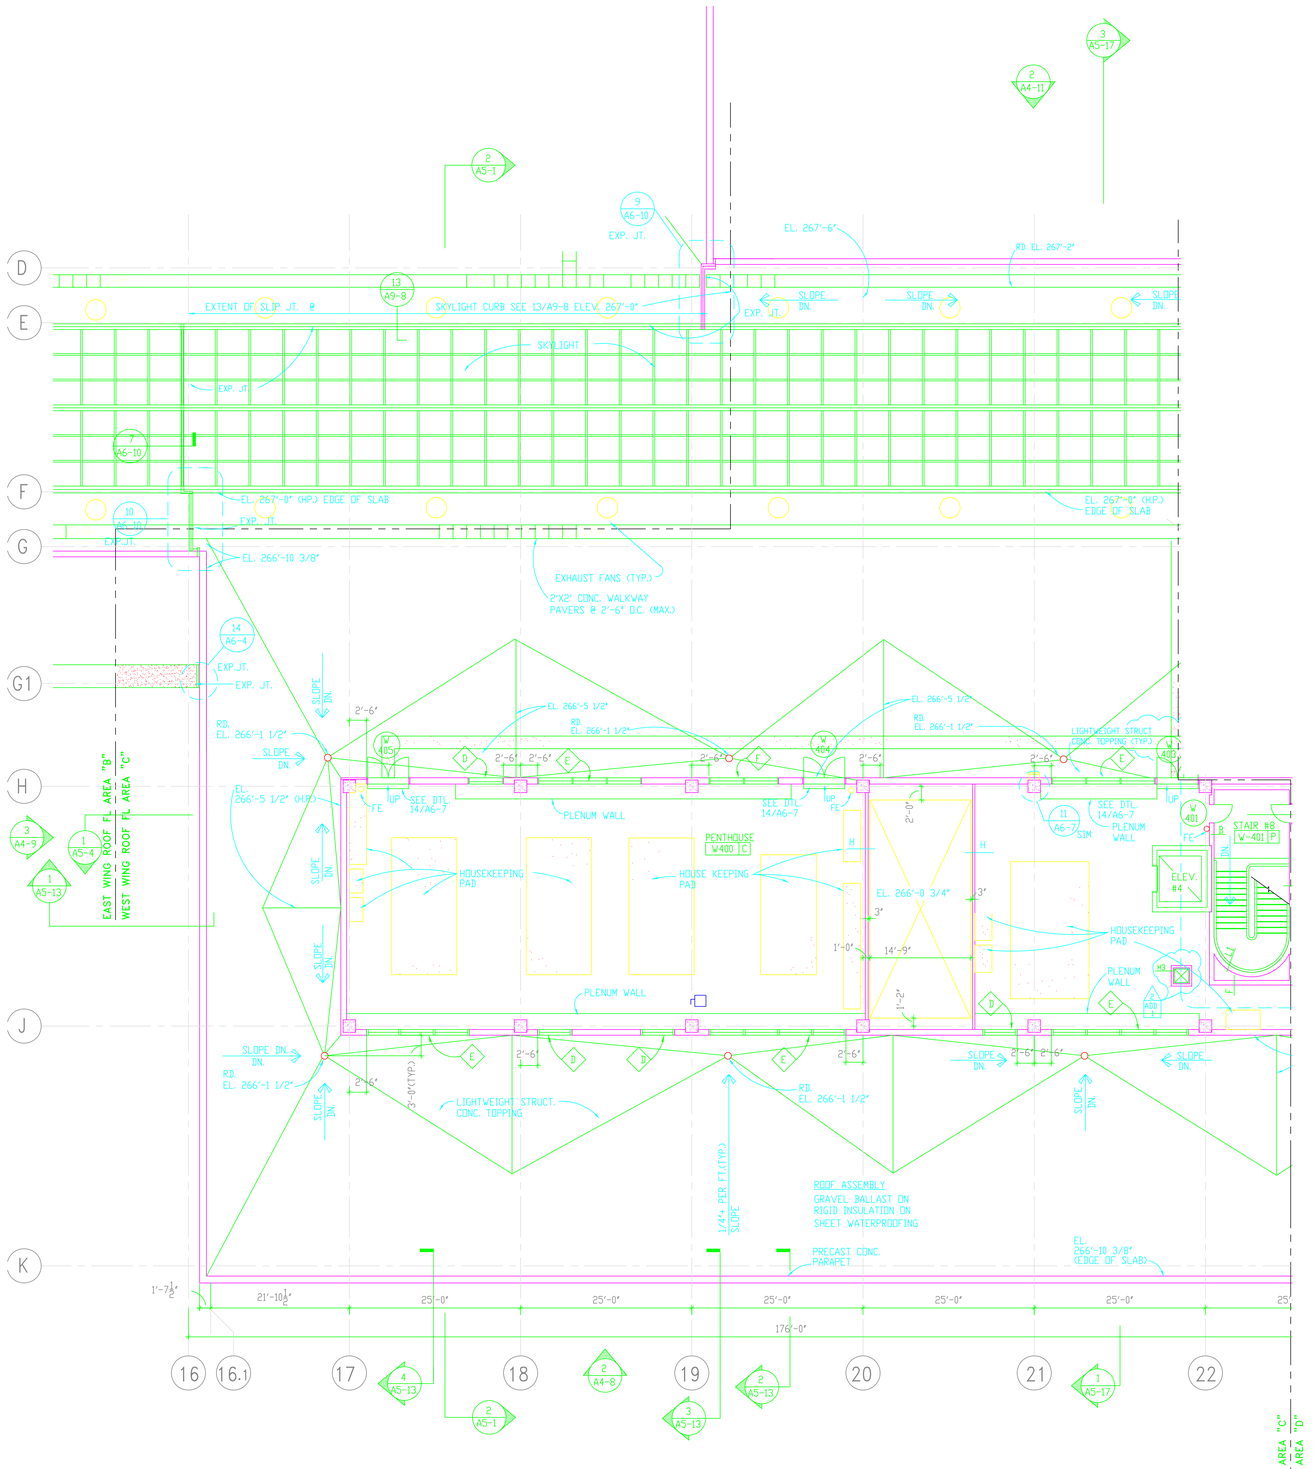

SmithGroup
1825 Eye Street NW
Suite 250
Washington DC 20006
202.842.2100
202.974.4500

AS-BUILT DRAWINGS

These as-built drawings have been prepared in part, on the basis of information completed and furnished by others. SmithGroup will not be responsible for any errors on omissions which have been incorporated into this document as a result.

THE ARMY NATIONAL GUARD CENTER
AT ARLINGTON HALL, VIRGINIA

SmithGroup
Architecture and Engineering
WASHINGTON, D.C.

REVISIONS:
2 10. 5. 90 ADD

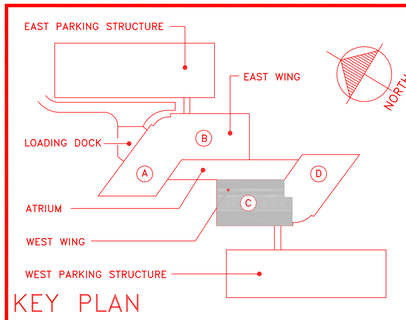

KEY PLAN
NO SCALE

WEST WING AREA "C"

SHEET TITLE
PARTITION PLAN ROOF FLOOR

DRAWN SM, EL
CHECKED WRJ, EL
SCALE 1/8"=1'-0"
DATE 02.05.02

SHEET NO.
A2-23

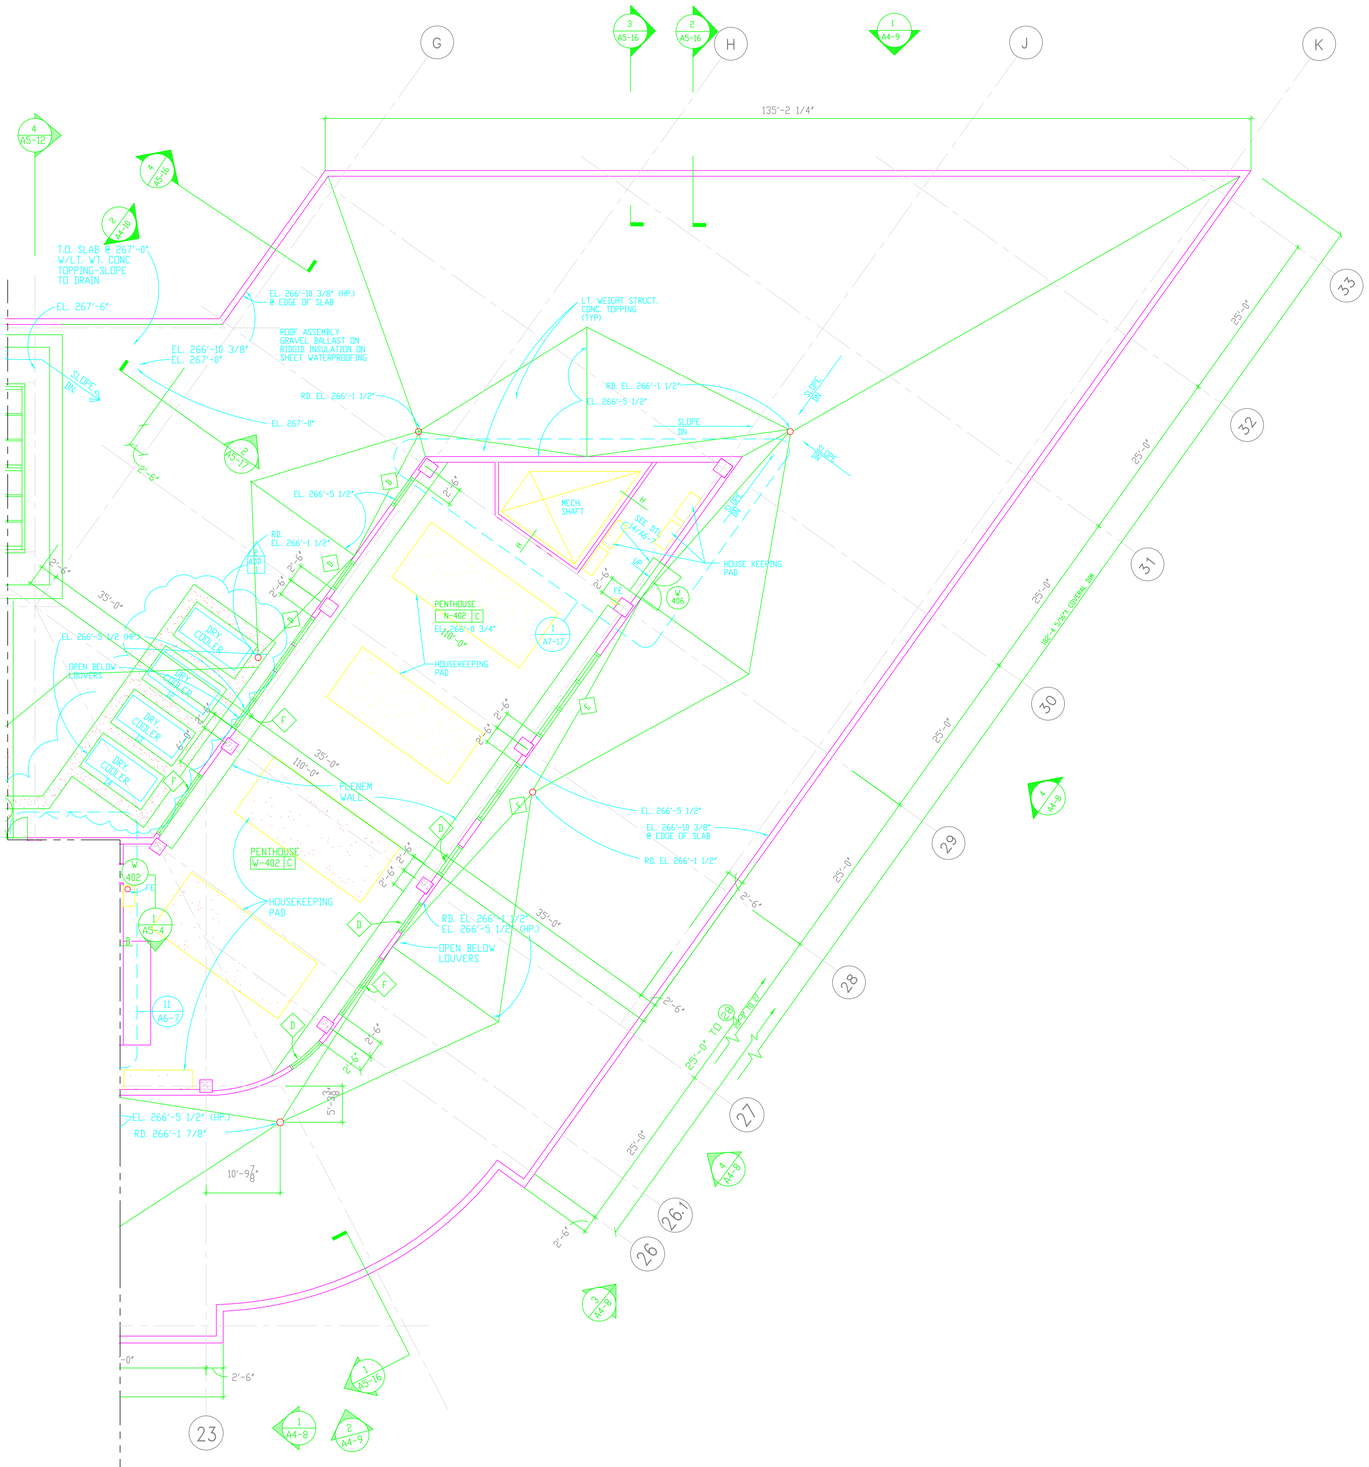

SmithGroup
1825 Eye Street NW
Suite 250
Washington DC 20006
202.842.2100
202.974.4500

AS-BUILT DRAWINGS

These as-built drawings have been prepared in part, on the basis of information completed and furnished by others. SmithGroup will not be responsible for any errors on omissions which have been incorporated into this document as a result.

THE ARMY NATIONAL GUARD CENTER AT ARLINGTON HALL, VIRGINIA

SmithGroup
Architecture and Engineering
WASHINGTON, D.C.

REVISIONS:

2. 10. 5. 90 ADD

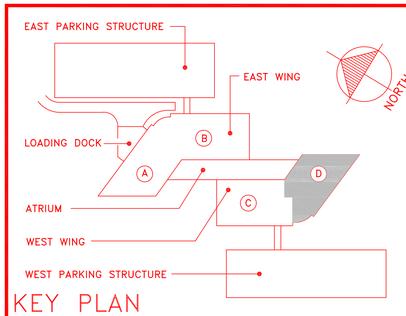

KEY PLAN
NO SCALE

WEST WING AREA "D"

SHEET TITLE

PARTITION PLAN ROOF FLOOR

DRAWN	SM, EL
CHECKED	WRJ, EL
SCALE	1/8"=1'-0"
DATE	02.05.02

SHEET NO.

A2-24