PLAN REFERENCE NOTES

1. PROVIDE 1" REDUCED PRESSURE BACKFLOW PREVENTER (+36"A.F.F.) PIPE DISCHARGE THRU AIR-GAP TO FLOOR DRAIN.
2. 1" COLD WATER MAKE-UP FOR HVAC EQUIPMENT. MAKE FINAL CONNECTIONS TO EQUIPMENT.
3. PROVIDE FLOOR MOUNTED REMOTE COOLER FOR DRINKING FOUNTAINS.

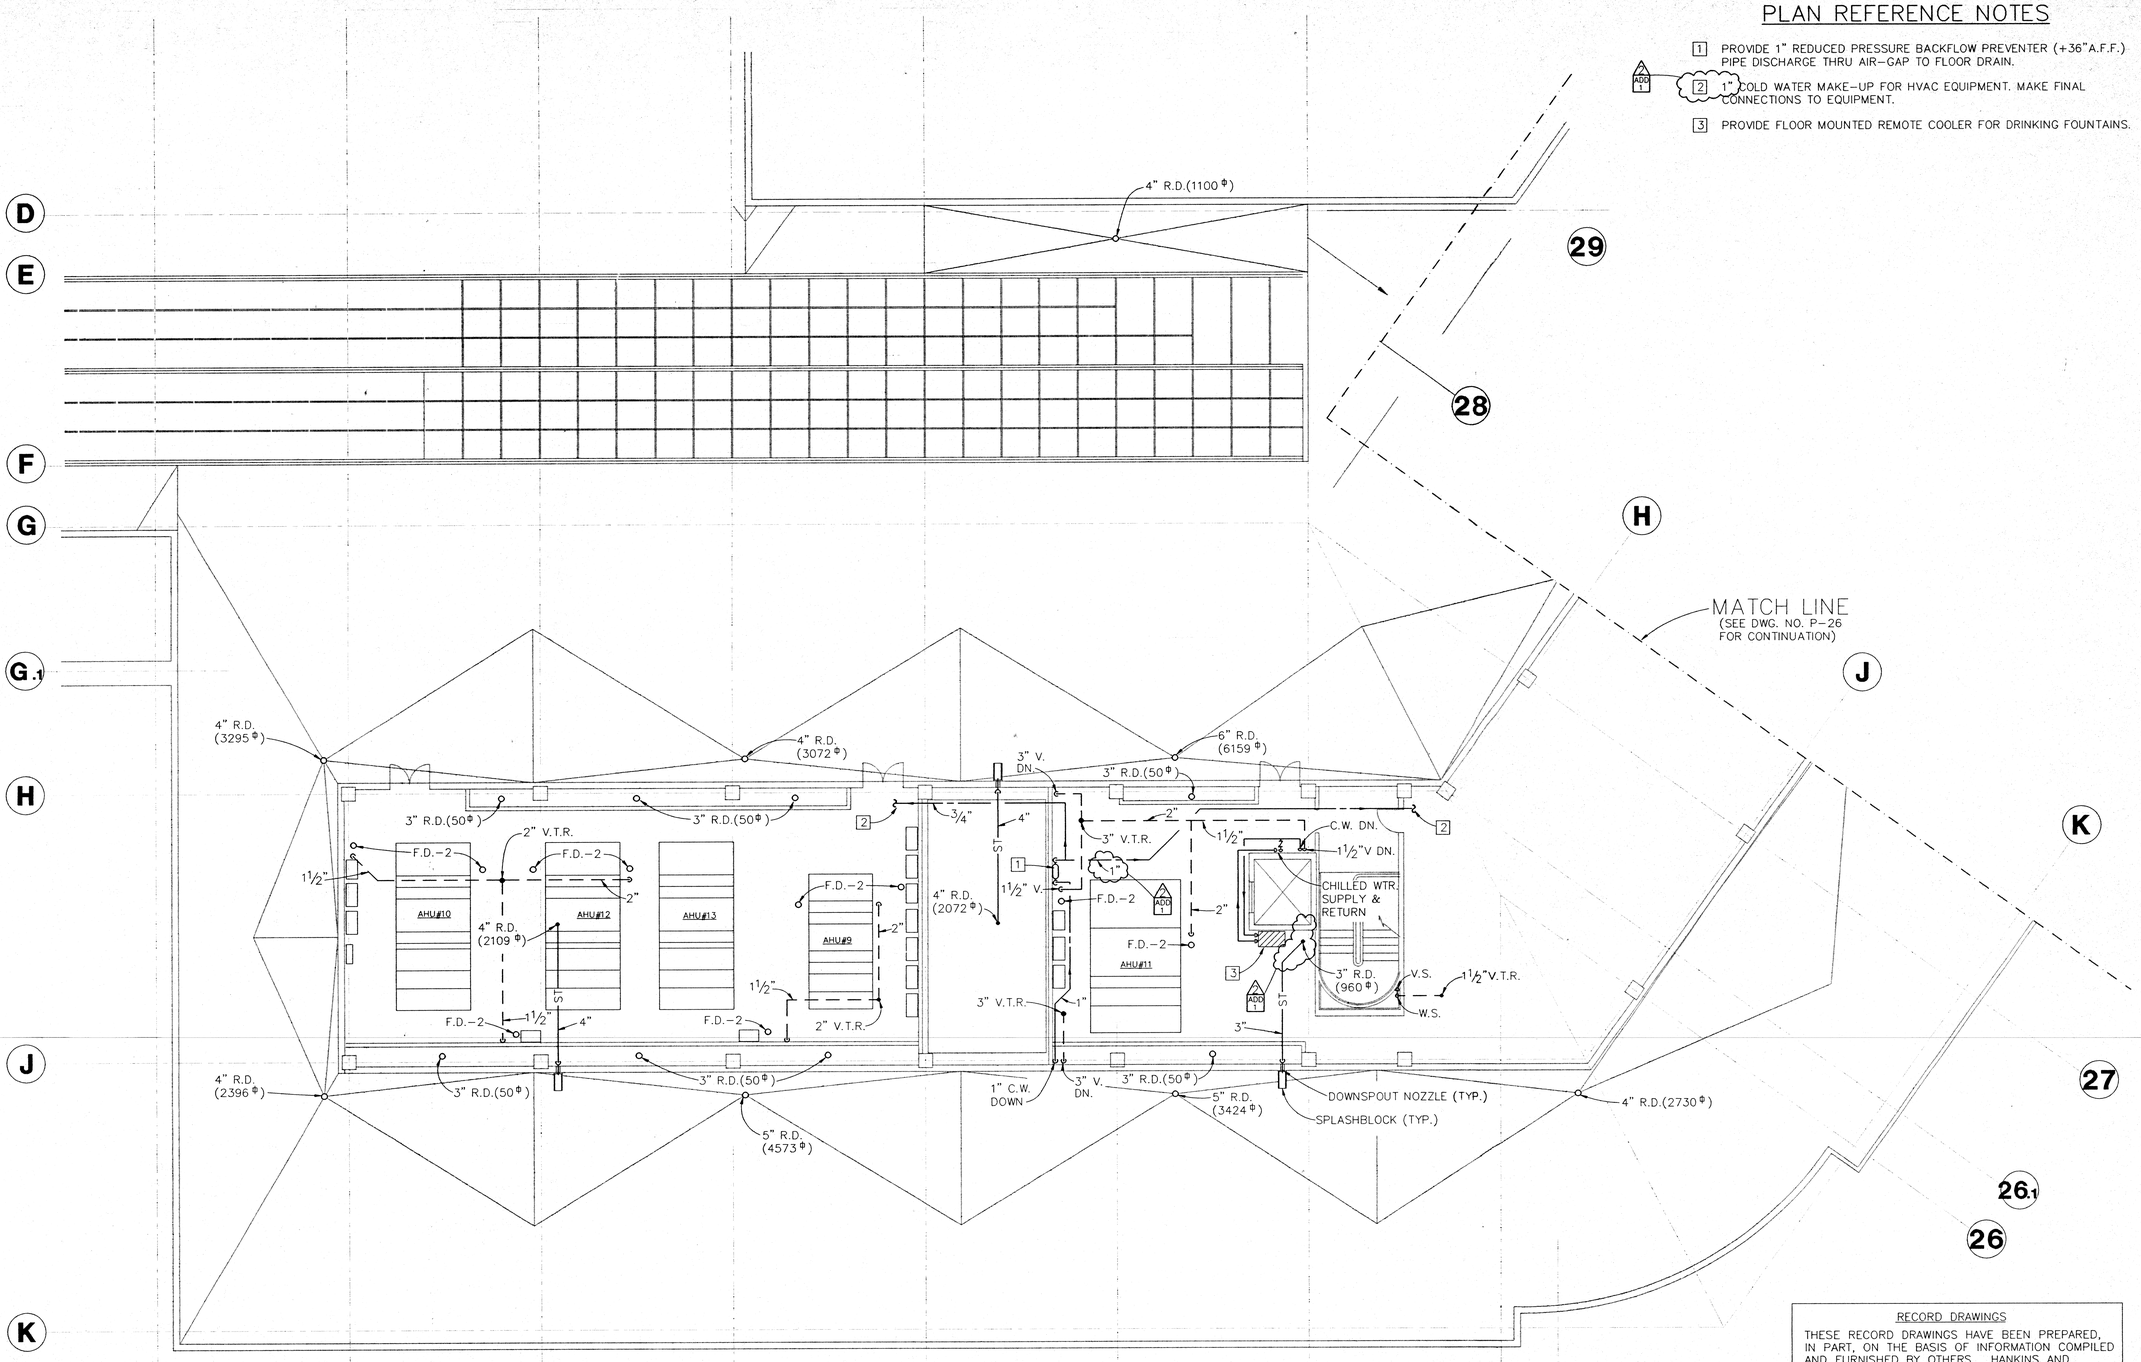

ROOF PLAN – AREA 'C'

RECORD DRAWINGS

THESE RECORD DRAWINGS HAVE BEEN PREPARED, IN PART, ON THE BASIS OF INFORMATION COMPILED AND FURNISHED BY OTHERS. HANKINS AND ANDERSON, INC. WILL NOT BE RESPONSIBLE FOR ANY ERRORS OR OMISSIONS WHICH HAVE BEEN INCORPORATED INTO THIS DOCUMENT AS A RESULT.

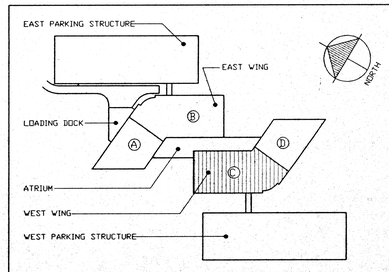

KEY PLAN
NO SCALE

COMMONWEALTH OF VIRGINIA
ROBERT M. LUMPKIN
LICENSE No. 3948
PROFESSIONAL ENGINEER

REVISIONS:

2 OCT. 5,1990	
	1 11-1-93 AB

THE ARMY NATIONAL GUARD CENTER

AT ARLINGTON HALL, VIRGINIA

HANKINS AND ANDERSON
MECHANICAL, ELECTRICAL, CIVIL CONSULTANTS
RICHMOND, VIRGINIA

MMP INTERNATIONAL
STRUCTURAL CONSULTANTS
WASHINGTON, D.C.

METCALF AND ASSOCIATES
ARCHITECTS AND PLANNERS
WASHINGTON, D.C.

WEST WING

SHEET TITLE
PENTHOUSE
AREA "C"
PLUMBING

DRAWN	KBL
CHECKED	A.C.W.
SCALE	1/8"=1'-0"
DATE	11/1/93

SHEET NO.
P-25

Transcribed by: Tue 11/08/93
Username: KDAY
Drawing Name: 3001-06
Plot No: 1/8"=1'-0"