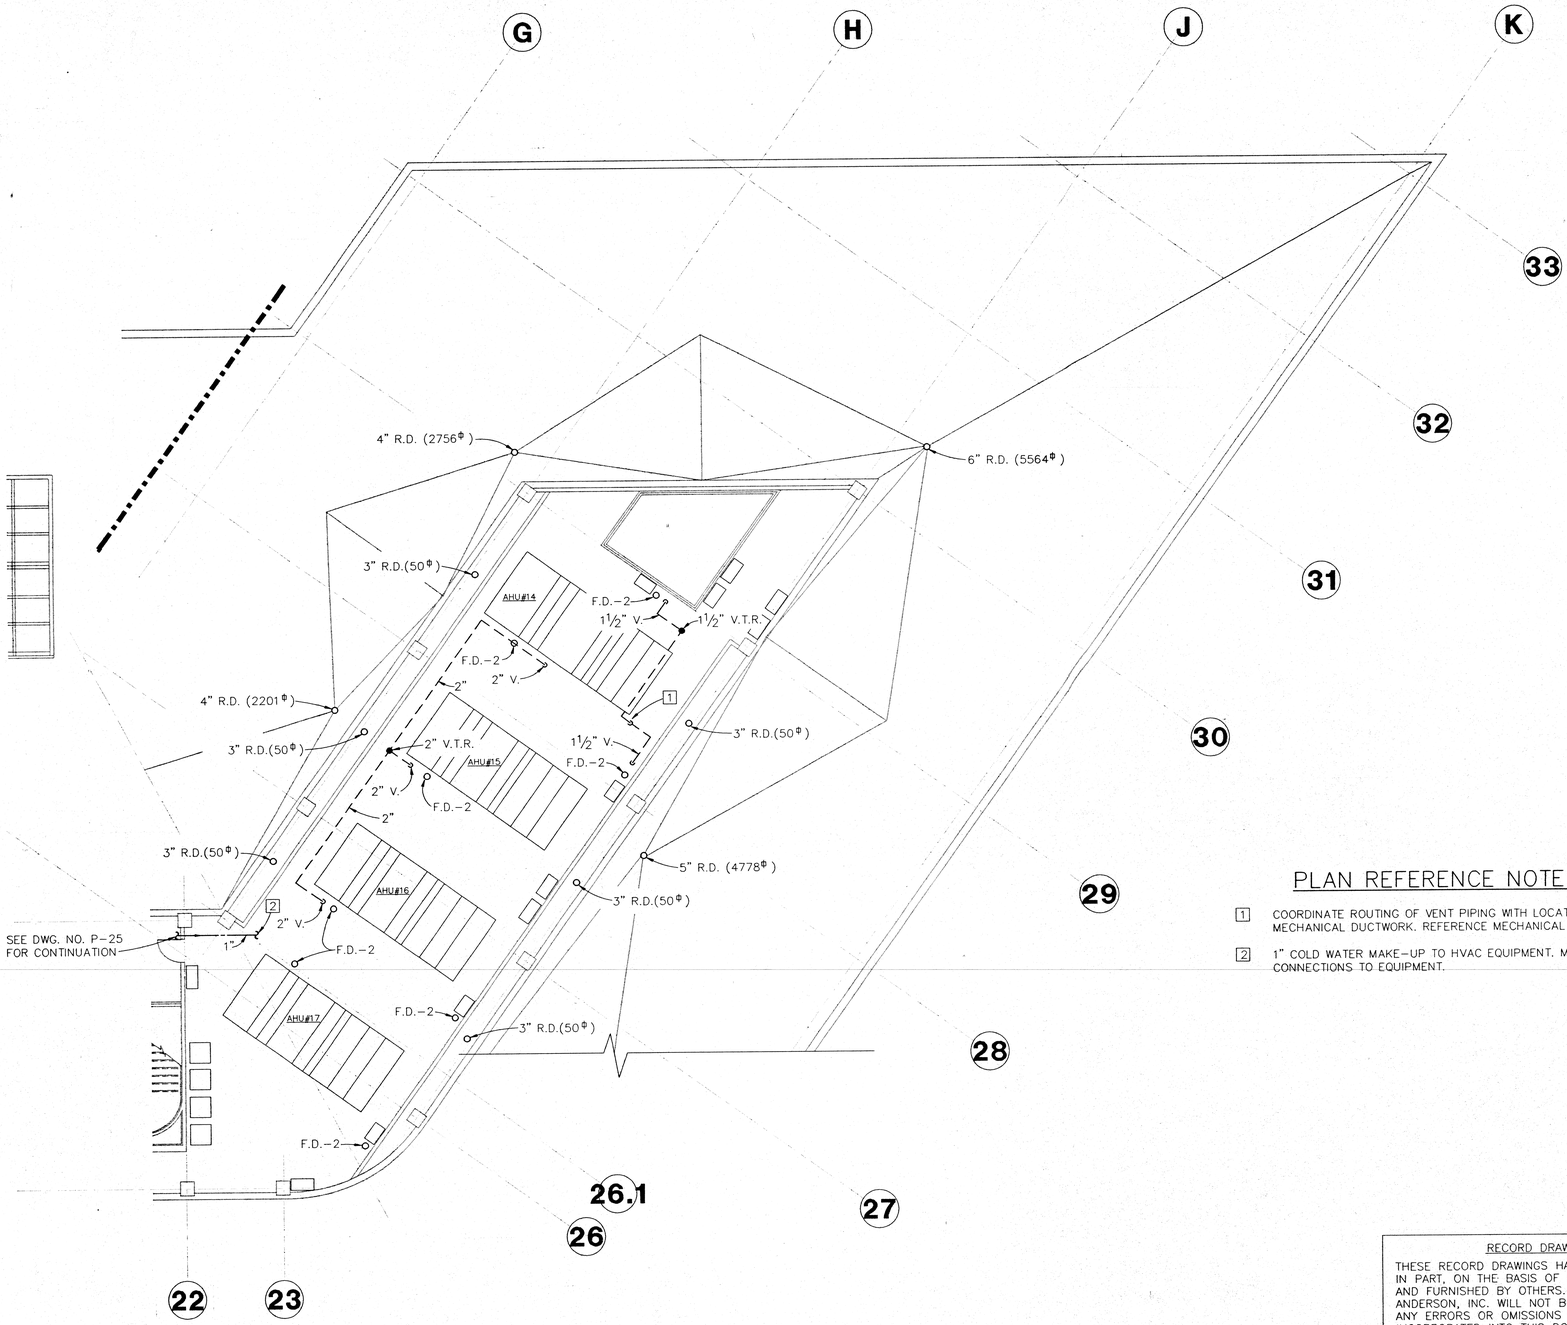

ROOF PLAN – AREA 'D'

PLAN REFERENCE NOTES

[1] COORDINATE ROUTING OF VENT PIPING WITH LOCATION OF MECHANICAL DUCTWORK. REFERENCE MECHANICAL DWGS.

[2] 1" COLD WATER MAKE–UP TO HVAC EQUIPMENT. MAKE FINAL CONNECTIONS TO EQUIPMENT.

RECORD DRAWINGS

THESE RECORD DRAWINGS HAVE BEEN PREPARED, IN PART, ON THE BASIS OF INFORMATION COMPILED AND FURNISHED BY OTHERS. HANKINS AND ANDERSON, INC. WILL NOT BE RESPONSIBLE FOR ANY ERRORS OR OMISSIONS WHICH HAVE BEEN INCORPORATED INTO THIS DOCUMENT AS A RESULT.

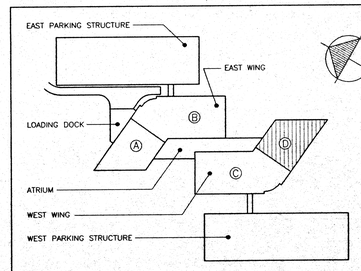

KEY PLAN
NO SCALE

COMMONWEALTH OF VIRGINIA
ROBERT M. LUMPKIN
LICENSE No. 3948
PROFESSIONAL ENGINEER

REVISIONS:

6	11–1–93 AB

THE ARMY NATIONAL GUARD CENTER
AT ARLINGTON HALL, VIRGINIA

METCALF AND ASSOCIATES
ARCHITECTS AND PLANNERS
WASHINGTON, D.C.

MMP INTERNATIONAL
STRUCTURAL CONSULTANTS
WASHINGTON, D.C.

HANKINS AND ANDERSON
MECHANICAL, ELECTRICAL, CIVIL CONSULTANTS
RICHMOND, VIRGINIA

WEST WING

SHEET TITLE
PENTHOUSE
AREA "D"
PLUMBING

DRAWN	KBL
CHECKED	A.C.W.
SCALE	1/8"=1'–0"
DATE	11/1/93

SHEET NO.
P-26

revision Dwg Date: 11/28/93
Username: KLMY
Current File: Model
Plot Info: 1/8"=1'-0" 3001-06