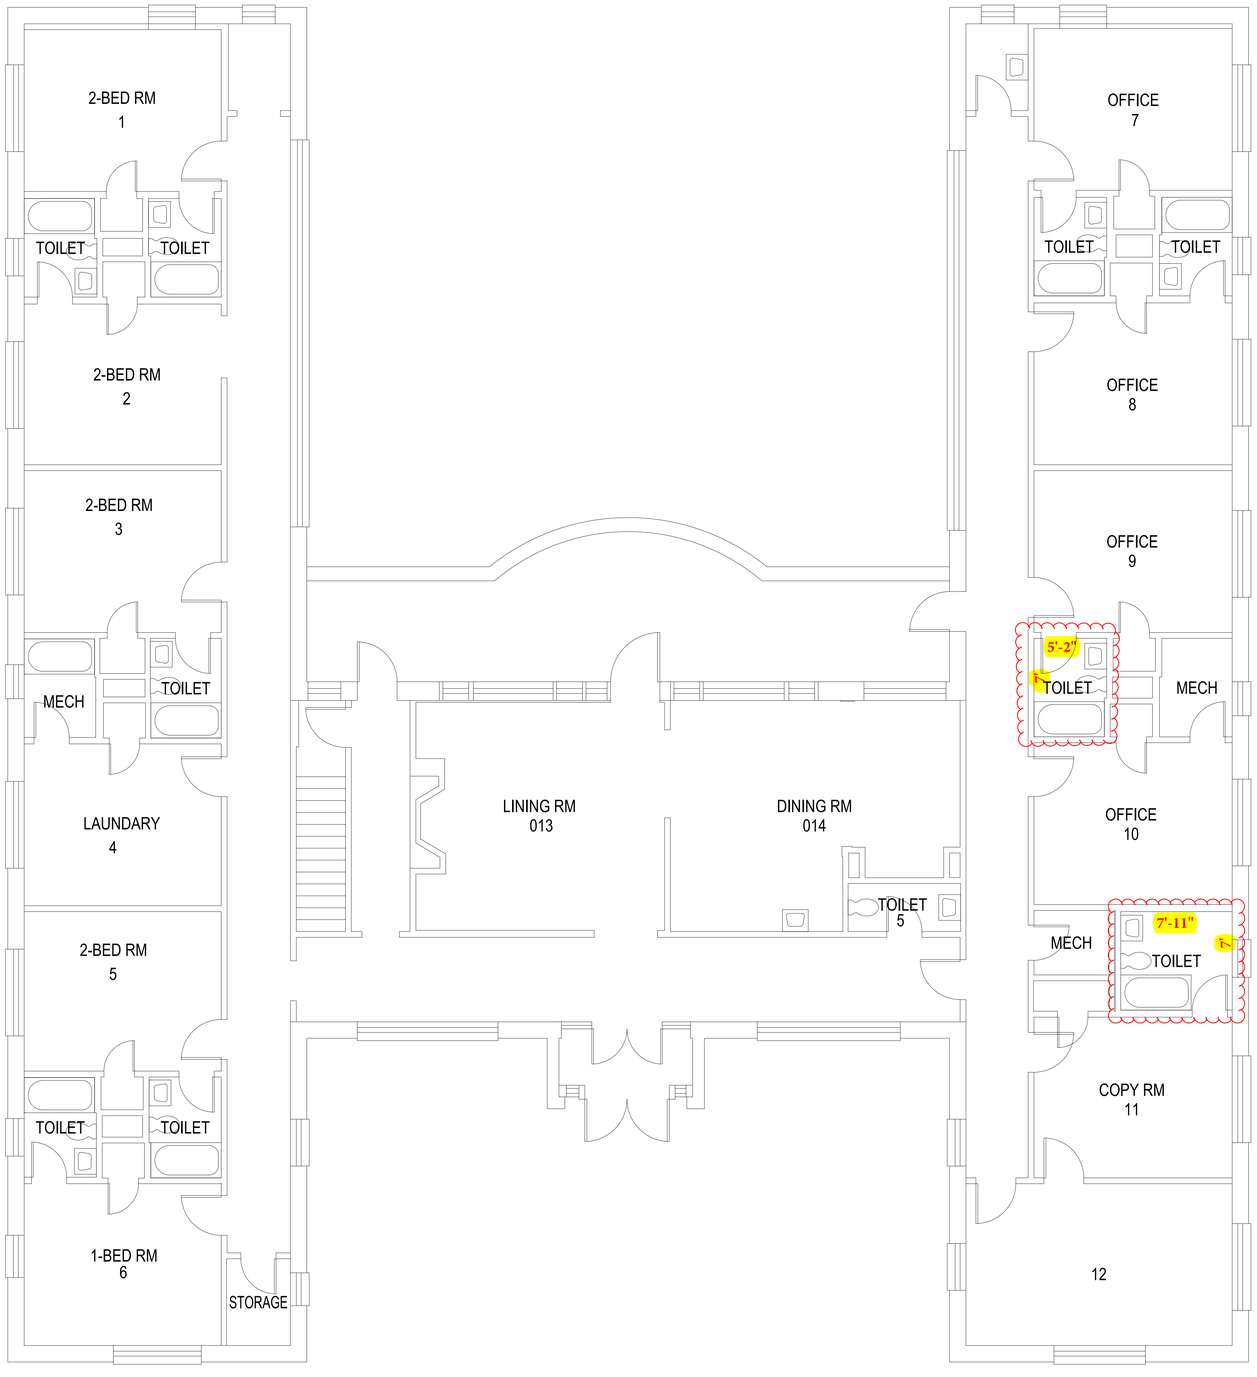

Final Submission	03-27-2020
Revisions	Date

Architects/Engineers/Consultants:

Professional Seal

VLogic

V Logic Systems Inc.
2352 Main Street, Suite 207
Concord, MA 01742
Phone: 978-341-9000
www.vlogicsystems.com

Drawing Title: BUILDING 05 GROUND FLOOR PLAN ARCHITECTURAL

Approved Project Director:

Project Title: AS-BUILT DRAWINGS

Location: WOOLWORTH AVENUE OMAHA, NE 68105-1850

File Name: GI-05-0BAR

Date: 03-27-2020

Checked:

Drawn:

Project Number:

Building Number: 05

Drawing Number:

Dwg. of

Office of Facilities Management

Department of Veterance Affairs

VA FORM 08-6231, OCT 1978