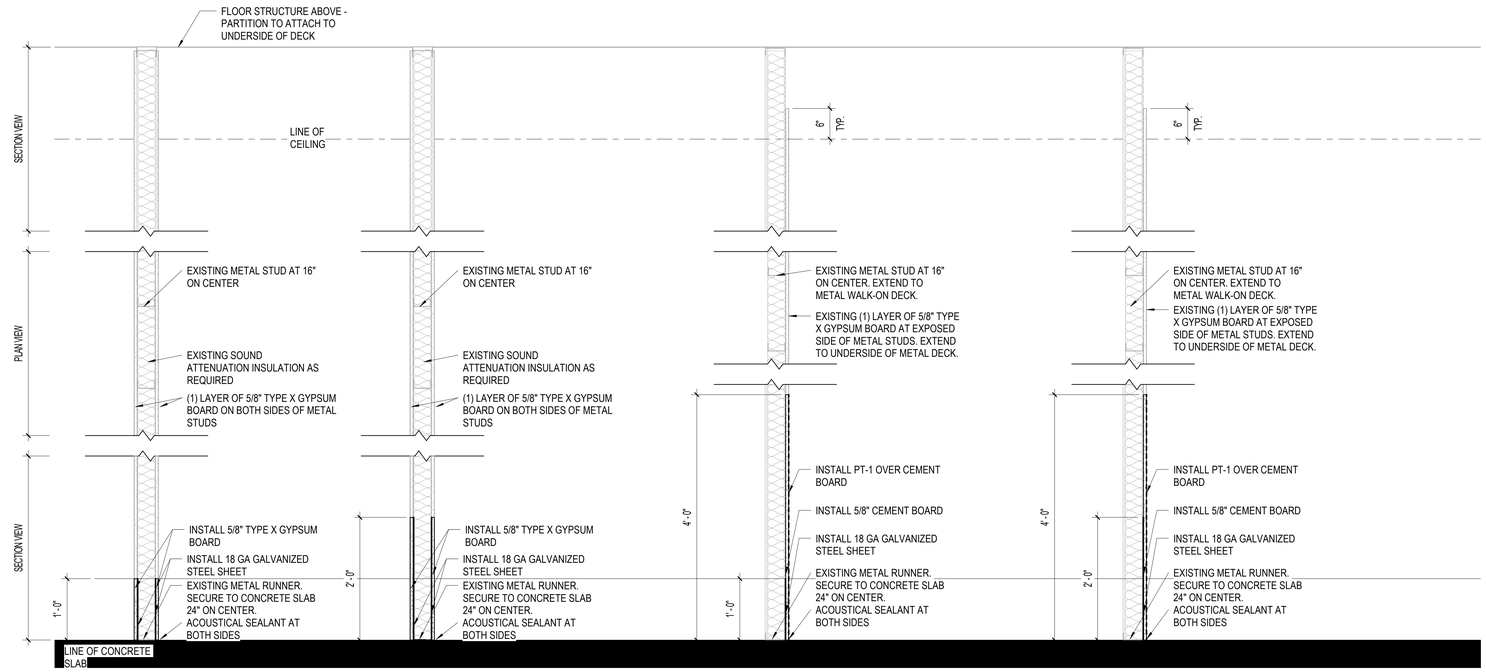

1 PARTITION TYPES

1" = 1'-0"

REVIEW ONLY - NOT FOR CONSTRUCTION

50% DESIGN DEVELOPMENT	04/21/2025
Revisions:	Date:

CONSULTANT

ARCHITECT/ENGINEER OF RECORD

BANCROFT ARCHITECTS + ENGINEERS
3300 Dundee Rd.
Northbrook, IL 60062
T: 847.952.9362
www.bancroft-ae.com
VA CONTRACT NO.36C25223C0071 Bancroft Project No. 23-009

STAMP

Office of Construction and Facilities Management

U.S. Department of Veterans Affairs

Drawing Title: ARCHITECTURAL - PARTITION TYPES

Phase: 50% DESIGN DEVELOPMENT

Approved: Project Director

Project Title: RENOVATIONS TO BUILDING 217 - CLIN005

Project Number: 578-20-002

Building Number: 217

Location: EDWARD J. HINES JR. VAMC

Issue Date: 04/21/2025

Checked: CZ

Drawn: CR

Drawing Number: AE501

VA FORM 08-6231

Install 18 gauge sheet metal -
2' aff along exterior walls (red lines),
1' aff along interior walls (blue lines).

Cut sheets for all penetrations (outlets, data drops, radiator piping, etc.) < 3/16" gap.

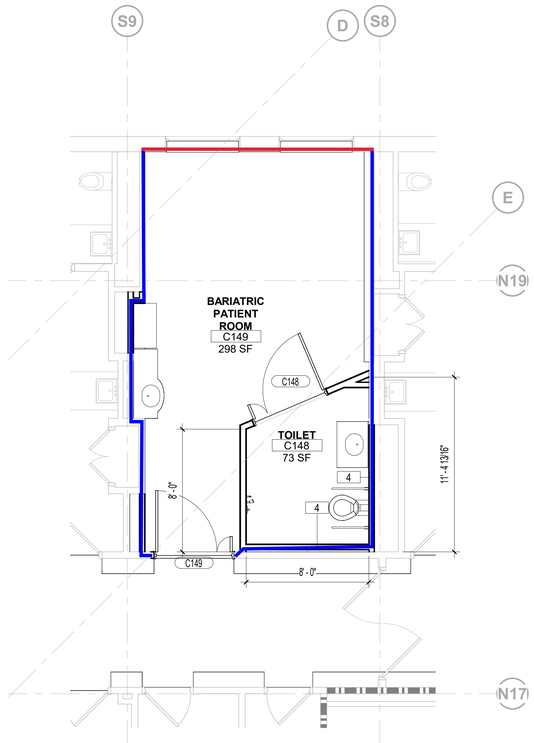

N

2 ARCHITECTURAL - ENLARGED PLAN - BARIATRIC C149

1/4" = 1'-0"

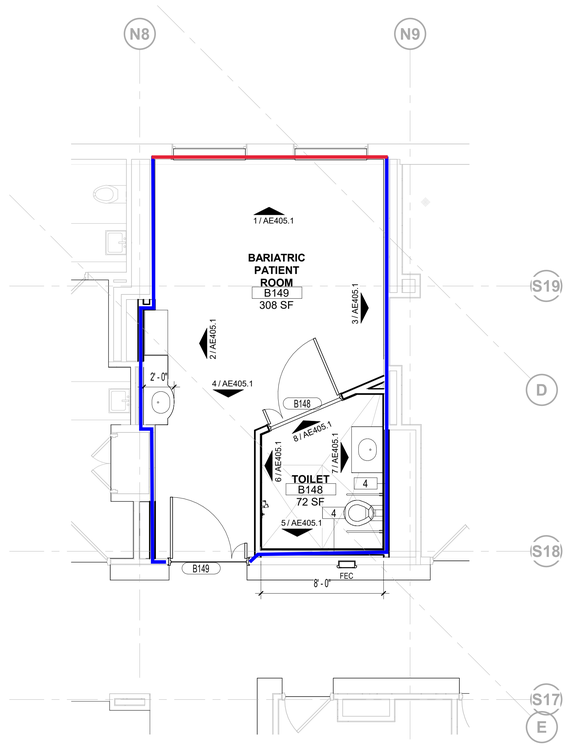

N

1 ARCHITECTURAL - ENLARGED PLAN - BARIATRIC B149

1/4" = 1'-0"

GENERAL NOTES FLOOR PLAN

A. REFER TO GI002 "CONSTRUCTION PERIOD SCHEDULING OF WORK – GENERAL NOTES" REGARDING THE VA'S DISCRETION IN SELECTING WORK TO BE DONE AFTERHOURS/OFF-HOURS.

B. REFER TO GI002 "CONSTRUCTION PERIOD SCHEDULING OF WORK

C. REFER TO GENERAL NOTES ON GI001 AND GI002.

D. REFER TO SHEET SERIES AF AND QH FOR FINISHES AND EQUIPMENT.

E. REFER TO SHEET ANNN FOR DETAILS FOR WALL GUARDS, CRASH RAILS, HANDRAILS, INTEGRAL COVE BASE, CORNER GUARDS.

F. REVIEW THIS DRAWING IN CONJUNCTION WITH CORRESPONDING FIRE PROTECTION, PLUMBING, MECHANICAL AND ELECTRICAL DRAWINGS FOR FULL SCOPE OF CONSTRUCTION WORK.

G. UNLESS OTHERWISE NOTED ALL WALLS TO BE TYPE '1'. REFER TO SHEET AE501 FOR PARTITION TYPES.

H. REFER TO SHEET AE601 FOR DOOR AND WINDOW SCHEDULES.

I. ALL DIMENSIONS ARE TO THE FINISHED FACE.

J. SEAL/FIRESTOP ALL OPENINGS IN ALL FIRE RATED WALLS TO CREATE A CONTINUOUS SYSTEM. INCLUDES ALL EXPOSED CONDUIT AND PIPING.

K. EACH PARTITION NOTED TO CARRY AN ACOUSTIC RATING SHALL CARRY THAT RATING IN THE ENTIRETY OF ITS CONSTRUCTION TO CREATE A CONTINUOUS SYSTEM. INCLUDES PLACEMENT AND SEALING OF PENETRATIONS, JUNCTION BOXES, ETC. UNLESS NOTED OTHERWISE, PARTITIONS SHALL EXTEND TO THE STRUCTURE ABOVE AND ACCOMMODATE ITS PROFILE.

L. NEW DOOR INSTALLATIONS SHALL COMPLY WITH THE FOLLOWING UNLESS OTHERWISE NOTED: (A) ON THE PUSH SIDE OF DOORS: PROVIDE A MINIMUM CLEARANCE OF 12" AT THE LOCK/LATCH SIDE FACE OF DOOR FRAME OPENING TO ANY FIXED CONSTRUCTION THAT WOULD BE ADJACENT TO THE FACE OF PARTITION. (B) ON THE PULL SIDE OF DOORS: PROVIDE A MINIMUM CLEARANCE OF 18" AT THE LOCK/LATCH SIDE FACE OF DOOR FRAME OPENING TO ANY FIXED CONSTRUCTION THAT WOULD BE ADJACENT TO THE FACE OF PARTITION. (C) IN METAL FRAMED GYPSUM BOARD PARTITIONS TYPICALLY ON THE PULL SIDE OF DOORS WHERE THE HINGE SIDE OF A DOOR FRAME IS PLACED ADJACENT TO ANY FIXED CONSTRUCTION, LOCATE THE DOOR SIDE FRAME OPENING 4" FROM THE FIXED CONSTRUCTION.

M. PROVIDE METAL BACKING PLATE AT ALL WALL MOUNTED ITEMS, SEE EQUIPMENT PLANS AND SCHEDULES.

N. NEW SUBSURFACE FLOOR PREPARATION: THE EXISTING CONCRETE FLOOR SUB-SURFACES RESULTING FROM THE REMOVAL OF OLD FLOOR FINISHES (I.E., CERAMIC TILE, VCT, MASTICS, VINYL SHEETS, ABATEMENTS, CARPETING, ETC.) OR GOING OVER CONCRETE FLOOR REPAIRS OR INFILLS SHALL BE ENTIRELY SKIM COATED TO A SMOOTH AND LEVEL FINISH, TO BE LEVEL WITH ALL ADJACENT FLOOR SURFACES REQUIRING EXISTING FLOOR FINISH REMOVALS AND/OR NEW FLOOR FINISHES, SUCH THAT THE FINAL FINISHED FLOORS ARE SMOOTH AND LEVEL AND HAVE FINISH TRANSITIONS AS SHOWN AND INTENDED. FOR BIDDING PURPOSES, FLOOR SKIM COATING SHALL BE FIGURED AT 3/4" THICKNESS AVERAGE

O. FURRED PARTITIONS EXTEND TO STRUCTURE ABOVE, UNLESS NOTED OTHERWISE.

FLOOR PLAN LEGEND

- EXISTING CONSTRUCTION TO REMAIN
- NEW PARTITION WALL
- MATCHLINE
- LIMITS OF NEW CONSTRUCTION
- FEC — FIRE EXTINGUISHER CABINET - REFER TO DETAIL AE561

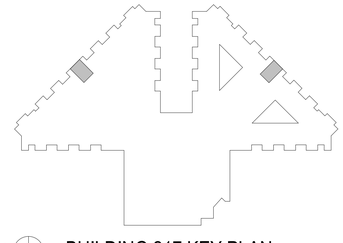

N

BUILDING 217 KEY PLAN

100% CONSTRUCTION DOCUMENTS	12/06/2024
90% CONSTRUCTION DOCUMENTS	08/23/2024
60% DESIGN DEVELOPMENT	05/08/2024
30% SCHEMATIC DESIGN	11/23/2023
Revisions:	Date:

CONSULTANT

ARCHITECT/ENGINEER OF RECORD

BANCROFT ARCHITECTS + ENGINEERS
3300 Dundee Rd.
Northbrook, IL 60062
T: 847.952.9362
www.bancroft-ae.com
VA CONTRACT NO.36C25223C0071
Bancroft Project No. 23-009

STAMP

Office of Construction and Facilities Management

VA U.S. Department of Veterans Affairs

REVIEW ONLY - NOT FOR CONSTRUCTION

Drawing Title: ARCHITECTURAL - ENLARGED PLAN - BARIATRIC ROOMS

Approved: Project Director

Phase: 100% CONSTRUCTION DOCUMENTS

Project Title: RENOVATIONS TO BUILDING 217

Project Number: 578-20-002

Building Number: 217

Location: EDWARD J. HINES JR. VAMC

Drawing Number: AE405

Issue Date: 12/06/2024

Checked: CZ

Drawn: CR

VA FORM 08-6231

Install 18 gauge sheet metal -
2' aff along exterior walls (red lines),
1' aff along interior walls (blue lines).

Cut sheets for all penetrations (outlets, data drops, radiator piping, etc.) < 3/16" gap.

N

1 **ARCHITECTURAL - ENLARGED PLAN - DEMENTIA UNIT**

1/8" = 1'-0"

GENERAL NOTES FLOOR PLAN

A. REFER TO GI002 "CONSTRUCTION PERIOD SCHEDULING OF WORK – GENERAL NOTES" REGARDING THE VA'S DISCRETION IN SELECTING WORK TO BE DONE AFTERHOURS/OFF-HOURS.

B. REFER TO GI002 "CONSTRUCTION PERIOD SCHEDULING OF WORK

C. REFER TO GENERAL NOTES ON GI001 AND GI002.

D. REFER TO SHEET SERIES AF AND QH FOR FINISHES AND EQUIPMENT.

E. REFER TO SHEET ANNN FOR DETAILS FOR WALL GUARDS, CRASH RAILS, HANDRAILS, INTEGRAL COVE BASE, CORNER GUARDS.

F. REVIEW THIS DRAWING IN CONJUNCTION WITH CORRESPONDING FIRE PROTECTION, PLUMBING, MECHANICAL AND ELECTRICAL DRAWINGS FOR FULL SCOPE OF CONSTRUCTION WORK.

G. UNLESS OTHERWISE NOTED ALL WALLS TO BE TYPE '1'. REFER TO SHEET AE501 FOR PARTITION TYPES.

H. REFER TO SHEET AE601 FOR DOOR AND WINDOW SCHEDULES.

I. ALL DIMENSIONS ARE TO THE FINISHED FACE.

J. SEAL/FIRESTOP ALL OPENINGS IN ALL FIRE RATED WALLS TO CREATE A CONTINUOUS SYSTEM. INCLUDES ALL EXPOSED CONDUIT AND PIPING.

K. EACH PARTITION NOTED TO CARRY AN ACOUSTIC RATING SHALL CARRY THAT RATING IN THE ENTIRETY OF ITS CONSTRUCTION TO CREATE A CONTINUOUS SYSTEM. INCLUDES PLACEMENT AND SEALING OF PENETRATIONS, JUNCTION BOXES, ETC. UNLESS NOTED OTHERWISE, PARTITIONS SHALL EXTEND TO THE STRUCTURE ABOVE AND ACCOMMODATE ITS PROFILE.

L. NEW DOOR INSTALLATIONS SHALL COMPLY WITH THE FOLLOWING UNLESS OTHERWISE NOTED: (A) ON THE PUSH SIDE OF DOORS: PROVIDE A MINIMUM CLEARANCE OF 12" AT THE LOCK/LATCH SIDE FACE OF DOOR FRAME OPENING TO ANY FIXED CONSTRUCTION THAT WOULD BE ADJACENT TO THE FACE OF PARTITION. (B) ON THE PULL SIDE OF DOORS: PROVIDE A MINIMUM CLEARANCE OF 18" AT THE LOCK/LATCH SIDE FACE OF DOOR FRAME OPENING TO ANY FIXED CONSTRUCTION THAT WOULD BE ADJACENT TO THE FACE OF PARTITION. (C) IN METAL FRAMED GYPSUM BOARD PARTITIONS TYPICALLY ON THE PULL SIDE OF DOORS WHERE THE HINGE SIDE OF A DOOR FRAME IS PLACED ADJACENT TO ANY FIXED CONSTRUCTION, LOCATE THE DOOR SIDE FRAME OPENING 4" FROM THE FIXED CONSTRUCTION.

M. PROVIDE METAL BACKING PLATE AT ALL WALL MOUNTED ITEMS, SEE EQUIPMENT PLANS AND SCHEDULES.

N. NEW SUBSURFACE FLOOR PREPARATION: THE EXISTING CONCRETE FLOOR SUB-SURFACES RESULTING FROM THE REMOVAL OF OLD FLOOR FINISHES (I.E., CERAMIC TILE, VCT, MASTICS, VINYL SHEETS, ABATEMENTS, CARPETING, ETC.) OR GOING OVER CONCRETE FLOOR REPAIRS OR INFILLS SHALL BE ENTIRELY SKIM COATED TO A SMOOTH AND LEVEL FINISH, TO BE LEVEL WITH ALL ADJACENT FLOOR SURFACES REQUIRING EXISTING FLOOR FINISH REMOVALS AND/OR NEW FLOOR FINISHES, SUCH THAT THE FINAL FINISHED FLOORS ARE SMOOTH AND LEVEL AND HAVE FINISH TRANSITIONS AS SHOWN AND INTENDED. FOR BIDDING PURPOSES, FLOOR SKIM COATING SHALL BE FIGURED AT 3/4" THICKNESS AVERAGE

O. FURRED PARTITIONS EXTEND TO STRUCTURE ABOVE, UNLESS NOTED OTHERWISE.

FLOOR PLAN LEGEND

- EXISTING CONSTRUCTION TO REMAIN
- NEW PARTITION WALL
- MATCHLINE
- LIMITS OF NEW CONSTRUCTION
- FEC FIRE EXTINGUISHER CABINET - REFER TO DETAIL AE561

N

BUILDING 217 KEY PLAN

REVIEW ONLY - NOT FOR CONSTRUCTION

100% CONSTRUCTION DOCUMENTS	12/06/2024
90% CONSTRUCTION DOCUMENTS	08/23/2024
60% DESIGN DEVELOPMENT	05/08/2024
30% SCHEMATIC DESIGN	11/23/2023
Revisions:	Date:

CONSULTANT

ARCHITECT/ENGINEER OF RECORD

BANCROFT ARCHITECTS + ENGINEERS
3300 Dundee Rd.
Northbrook, IL 60062
T: 847.952.9362
www.bancroft-ae.com
VA CONTRACT NO.36C25223C0071 Bancroft Project No. 23-009

STAMP

Office of Construction and Facilities Management

VA U.S. Department of Veterans Affairs

Drawing Title: ARCHITECTURAL - ENLARGED PLAN - DEMENTIA UNIT

Approved: Project Director

Phase: 100% CONSTRUCTION DOCUMENTS

Project Title: RENOVATIONS TO BUILDING 217

Project Number: 578-20-002

Building Number: 217

Location: EDWARD J. HINES JR. VAMC

Drawing Number: AE407

Issue Date: 12/06/2024

Checked: CZ

Drawn: CR

VA FORM 08-6231

Install 18 gauge sheet metal -
2' aff along exterior walls (red lines),
1' aff along interior walls (blue lines).

Cut sheets for all penetrations (outlets, data drops, radiator piping, etc.) < 3/16" gap.

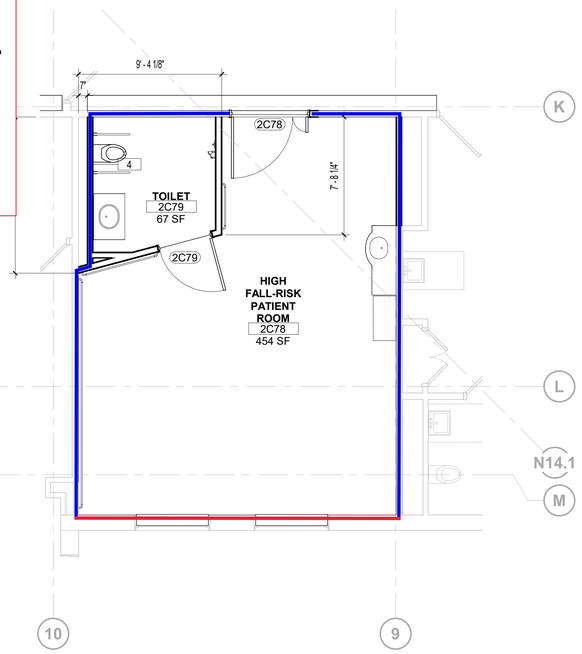

N 4 **ARCHITECTURAL - ENLARGED PLAN - HIGH FALL-RISK ROOM 2C78**
1/4" = 1'-0"

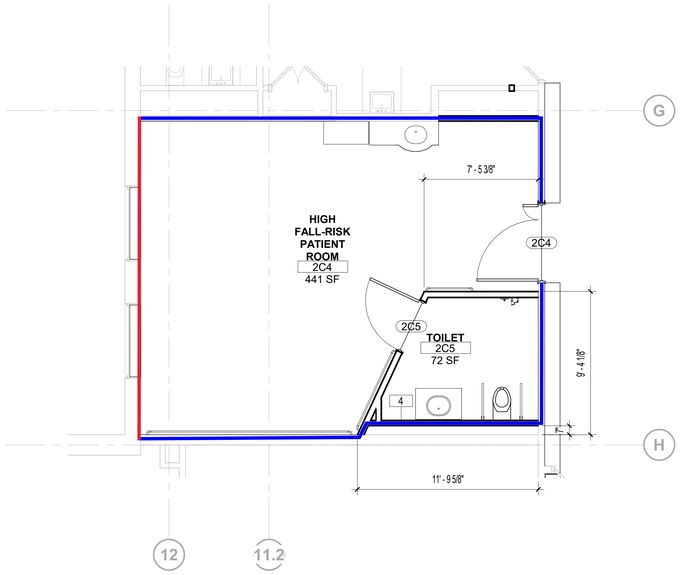

1/4" = 1'-0"

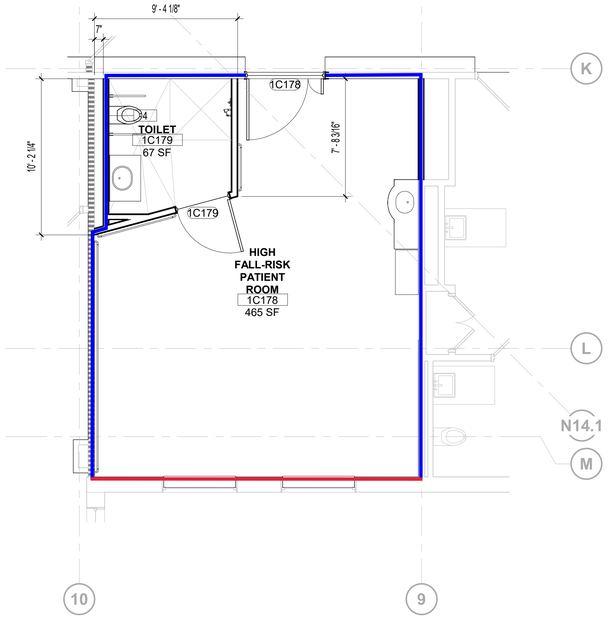

N 2 **ARCHITECTURAL - ENLARGED PLAN - HIGH FALL-RISK ROOM 1C178**
1/4" = 1'-0"

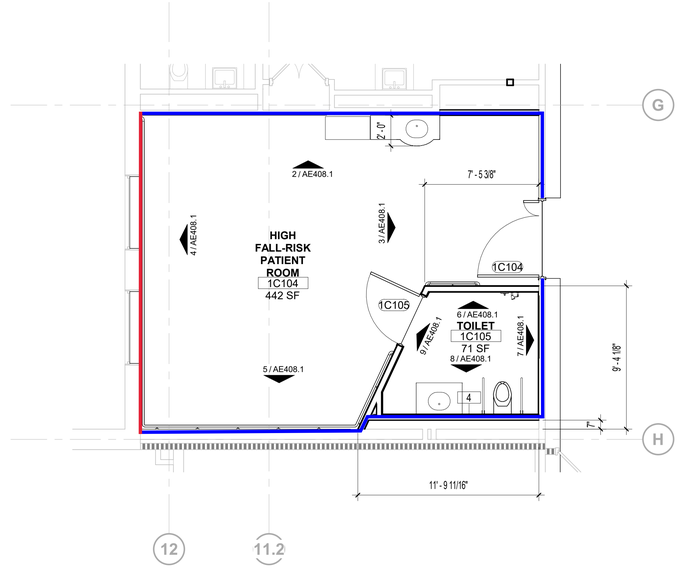

N 1 **ARCHITECUTRAL - ENLARGED PLAN - HIGH FALL-RISK ROOM 1C104**
1/4" = 1'-0"

GENERAL NOTES FLOOR PLAN

A. REFER TO GI002 "CONSTRUCTION PERIOD SCHEDULING OF WORK – GENERAL NOTES" REGARDING THE VA'S DISCRETION IN SELECTING WORK TO BE DONE AFTERHOURS/OFF-HOURS.

B. REFER TO GI002 "CONSTRUCTION PERIOD SCHEDULING OF WORK

C. REFER TO GENERAL NOTES ON GI001 AND GI002.

D. REFER TO SHEET SERIES AF AND QH FOR FINISHES AND EQUIPMENT.

E. REFER TO SHEET ANNN FOR DETAILS FOR WALL GUARDS, CRASH RAILS, HANDRAILS, INTEGRAL COVE BASE, CORNER GUARDS.

F. REVIEW THIS DRAWING IN CONJUNCTION WITH CORRESPONDING FIRE PROTECTION, PLUMBING, MECHANICAL AND ELECTRICAL DRAWINGS FOR FULL SCOPE OF CONSTRUCTION WORK.

G. UNLESS OTHERWISE NOTED ALL WALLS TO BE TYPE '1'. REFER TO SHEET AE501 FOR PARTITION TYPES.

H. REFER TO SHEET AE601 FOR DOOR AND WINDOW SCHEDULES.

I. ALL DIMENSIONS ARE TO THE FINISHED FACE.

J. SEAL/FIRESTOP ALL OPENINGS IN ALL FIRE RATED WALLS TO CREATE A CONTINUOUS SYSTEM. INCLUDES ALL EXPOSED CONDUIT AND PIPING.

K. EACH PARTITION NOTED TO CARRY AN ACOUSTIC RATING SHALL CARRY THAT RATING IN THE ENTIRETY OF ITS CONSTRUCTION TO CREATE A CONTINUOUS SYSTEM. INCLUDES PLACEMENT AND SEALING OF PENETRATIONS, JUNCTION BOXES, ETC. UNLESS NOTED OTHERWISE, PARTITIONS SHALL EXTEND TO THE STRUCTURE ABOVE AND ACCOMMODATE ITS PROFILE.

L. NEW DOOR INSTALLATIONS SHALL COMPLY WITH THE FOLLOWING UNLESS OTHERWISE NOTED: (A) ON THE PUSH SIDE OF DOORS: PROVIDE A MINIMUM CLEARANCE OF 12" AT THE LOCK/LATCH SIDE FACE OF DOOR FRAME OPENING TO ANY FIXED CONSTRUCTION THAT WOULD BE ADJACENT TO THE FACE OF PARTITION. (B) ON THE PULL SIDE OF DOORS: PROVIDE A MINIMUM CLEARANCE OF 18" AT THE LOCK/LATCH SIDE FACE OF DOOR FRAME OPENING TO ANY FIXED CONSTRUCTION THAT WOULD BE ADJACENT TO THE FACE OF PARTITION. (C) IN METAL FRAMED GYPSUM BOARD PARTITIONS TYPICALLY ON THE PULL SIDE OF DOORS WHERE THE HINGE SIDE OF A DOOR FRAME IS PLACED ADJACENT TO ANY FIXED CONSTRUCTION, LOCATE THE DOOR SIDE FRAME OPENING 4" FROM THE FIXED CONSTRUCTION.

M. PROVIDE METAL BACKING PLATE AT ALL WALL MOUNTED ITEMS, SEE EQUIPMENT PLANS AND SCHEDULES.

N. NEW SUBSURFACE FLOOR PREPARATION: THE EXISTING CONCRETE FLOOR SUB-SURFACES RESULTING FROM THE REMOVAL OF OLD FLOOR FINISHES (I.E., CERAMIC TILE, VCT, MASTICS, VINYL SHEETS, ABATEMENTS, CARPETING, ETC.) OR GOING OVER CONCRETE FLOOR REPAIRS OR INFILLS SHALL BE ENTIRELY SKIM COATED TO A SMOOTH AND LEVEL FINISH, TO BE LEVEL WITH ALL ADJACENT FLOOR SURFACES REQUIRING EXISTING FLOOR FINISH REMOVALS AND/OR NEW FLOOR FINISHES, SUCH THAT THE FINAL FINISHED FLOORS ARE SMOOTH AND LEVEL AND HAVE FINISH TRANSITIONS AS SHOWN AND INTENDED. FOR BIDDING PURPOSES, FLOOR SKIM COATING SHALL BE FIGURED AT 3/4" THICKNESS AVERAGE

O. FURRED PARTITIONS EXTEND TO STRUCTURE ABOVE, UNLESS NOTED OTHERWISE.

FLOOR PLAN LEGEND

- EXISTING CONSTRUCTION TO REMAIN
- NEW PARTITION WALL
- MATCHLINE
- LIMITS OF NEW CONSTRUCTION
- FEC — FIRE EXTINGUISHER CABINET - REFER TO DETAIL AE561

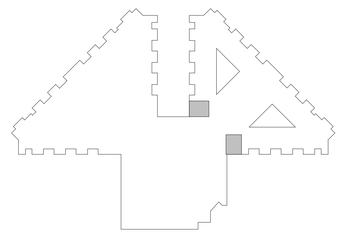

N **BUILDING 217 KEY PLAN**

REVIEW ONLY - NOT FOR CONSTRUCTION

100% CONSTRUCTION DOCUMENTS	**12/06/2024**
90% CONSTRUCTION DOCUMENTS	**08/23/2024**
60% DESIGN DEVELOPMENT	**05/08/2024**
30% SCHEMATIC DESIGN	**11/23/2023**
Revisions:	**Date:**

CONSULTANT

ARCHITECT/ENGINEER OF RECORD

Bancroft
BANCROFT ARCHITECTS + ENGINEERS
3300 Dundee Rd.
Northbrook, IL 60062
T: 847.952.9362
www. bancroft-ae.com
Bancroft Project No. 23-009
VA CONTRACT NO.36C25223C0071

STAMP

Office of Construction and Facilities Management

VA U.S. Department of Veterans Affairs

Drawing Title
ARCHITECTURAL -ENLARGED PLAN - HIGH FALL RISK ROOMS

Approved: Project Director

Phase
100% CONSTRUCTION DOCUMENTS

Project Title
RENOVATIONS TO BUILDING 217

Location
EDWARD J. HINES JR. VAMC

Issue Date 12/06/2024 | **Checked** CZ | **Drawn** CR

Project Number 578-20-002

Building Number 217

Drawing Number AE408

VA FORM 08-6231

Install 18 gauge sheet metal -
2' aff along exterior walls (red lines),
1' aff along interior walls (blue lines).

Cut sheets for all penetrations (outlets, data drops, radiator piping, etc.) < 3/16" gap.

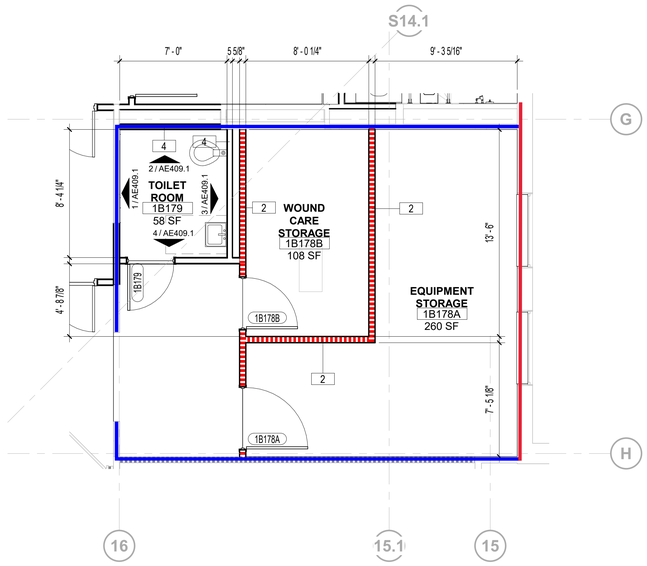

N 3 **ARCHITECTURAL -ENLARGED PLAN - EQUIPMENT 1B178**

1/4" = 1'-0"

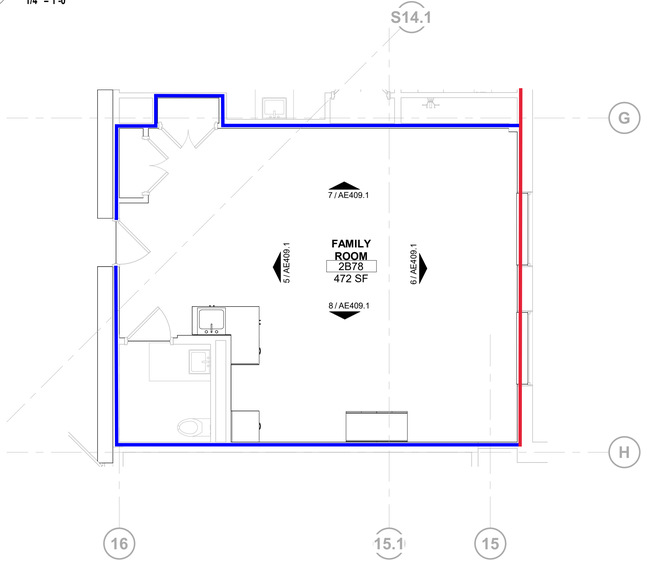

N 2 **ARCHITECTURAL - ENLARGED PLAN - FAMILY ROOM 2B78**

1/4" = 1'-0"

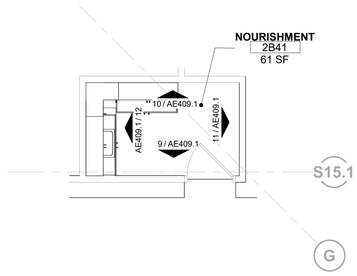

N 1 **ARCHITECTURAL - ENLARGED PLAN - NOURISHMENT 2B41**

1/4" = 1'-0"

GENERAL NOTES FLOOR PLAN

A. REFER TO GI002 "CONSTRUCTION PERIOD SCHEDULING OF WORK – GENERAL NOTES" REGARDING THE VA'S DISCRETION IN SELECTING WORK TO BE DONE AFTERHOURS/OFF-HOURS.

B. REFER TO GI002 "CONSTRUCTION PERIOD SCHEDULING OF WORK

C. REFER TO GENERAL NOTES ON GI001 AND GI002.

D. REFER TO SHEET SERIES AF AND QH FOR FINISHES AND EQUIPMENT.

E. REFER TO SHEET ANNN FOR DETAILS FOR WALL GUARDS, CRASH RAILS, HANDRAILS, INTEGRAL COVE BASE, CORNER GUARDS.

F. REVIEW THIS DRAWING IN CONJUNCTION WITH CORRESPONDING FIRE PROTECTION, PLUMBING, MECHANICAL AND ELECTRICAL DRAWINGS FOR FULL SCOPE OF CONSTRUCTION WORK.

G. UNLESS OTHERWISE NOTED ALL WALLS TO BE TYPE '1'. REFER TO SHEET AE501 FOR PARTITION TYPES.

H. REFER TO SHEET AE601 FOR DOOR AND WINDOW SCHEDULES.

I. ALL DIMENSIONS ARE TO THE FINISHED FACE.

J. SEAL/FIRESTOP ALL OPENINGS IN ALL FIRE RATED WALLS TO CREATE A CONTINUOUS SYSTEM. INCLUDES ALL EXPOSED CONDUIT AND PIPING.

K. EACH PARTITION NOTED TO CARRY AN ACOUSTIC RATING SHALL CARRY THAT RATING IN THE ENTIRETY OF ITS CONSTRUCTION TO CREATE A CONTINUOUS SYSTEM. INCLUDES PLACEMENT AND SEALING OF PENETRATIONS, JUNCTION BOXES, ETC. UNLESS NOTED OTHERWISE, PARTITIONS SHALL EXTEND TO THE STRUCTURE ABOVE AND ACCOMMODATE ITS PROFILE.

L. NEW DOOR INSTALLATIONS SHALL COMPLY WITH THE FOLLOWING UNLESS OTHERWISE NOTED: (A) ON THE PUSH SIDE OF DOORS: PROVIDE A MINIMUM CLEARANCE OF 12" AT THE LOCK/LATCH SIDE FACE OF DOOR FRAME OPENING TO ANY FIXED CONSTRUCTION THAT WOULD BE ADJACENT TO THE FACE OF PARTITION. (B) ON THE PULL SIDE OF DOORS: PROVIDE A MINIMUM CLEARANCE OF 18" AT THE LOCK/LATCH SIDE FACE OF DOOR FRAME OPENING TO ANY FIXED CONSTRUCTION THAT WOULD BE ADJACENT TO THE FACE OF PARTITION. (C) IN METAL FRAMED GYPSUM BOARD PARTITIONS TYPICALLY ON THE PULL SIDE OF DOORS WHERE THE HINGE SIDE OF A DOOR FRAME IS PLACED ADJACENT TO ANY FIXED CONSTRUCTION, LOCATE THE DOOR SIDE FRAME OPENING 4" FROM THE FIXED CONSTRUCTION.

M. PROVIDE METAL BACKING PLATE AT ALL WALL MOUNTED ITEMS, SEE EQUIPMENT PLANS AND SCHEDULES.

N. NEW SUBSURFACE FLOOR PREPARATION: THE EXISTING CONCRETE FLOOR SUB-SURFACES RESULTING FROM THE REMOVAL OF OLD FLOOR FINISHES (I.E., CERAMIC TILE, VCT, MASTICS, VINYL SHEETS, ABATEMENTS, CARPETING, ETC.) OR GOING OVER CONCRETE FLOOR REPAIRS OR INFILLS SHALL BE ENTIRELY SKIM COATED TO A SMOOTH AND LEVEL FINISH, TO BE LEVEL WITH ALL ADJACENT FLOOR SURFACES REQUIRING EXISTING FLOOR FINISH REMOVALS AND/OR NEW FLOOR FINISHES, SUCH THAT THE FINAL FINISHED FLOORS ARE SMOOTH AND LEVEL AND HAVE FINISH TRANSITIONS AS SHOWN AND INTENDED. FOR BIDDING PURPOSES, FLOOR SKIM COATING SHALL BE FIGURED AT 3/4" THICKNESS AVERAGE

O. FURRED PARTITIONS EXTEND TO STRUCTURE ABOVE, UNLESS NOTED OTHERWISE.

FLOOR PLAN LEGEND

- EXISTING CONSTRUCTION TO REMAIN
- NEW PARTITION WALL
- MATCHLINE
- LIMITS OF NEW CONSTRUCTION
- FEC — FIRE EXTINGUISHER CABINET - REFER TO DETAIL AE561

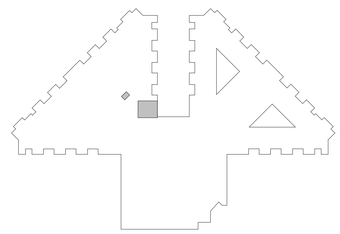

N BUILDING 217 KEY PLAN

REVIEW ONLY - NOT FOR CONSTRUCTION

100% CONSTRUCTION DOCUMENTS	12/06/2024
90% CONSTRUCTION DOCUMENTS	08/23/2024
60% DESIGN DEVELOPMENT	05/08/2024
30% SCHEMATIC DESIGN	11/23/2023
Revisions:	Date:

CONSULTANT

ARCHITECT/ENGINEER OF RECORD

BANCROFT ARCHITECTS + ENGINEERS
3300 Dundee Rd.
Northbrook, IL 60062
T: 847.952.9362
www. bancroft-ae.com
VA CONTRACT NO.36C25223C0071
Bancroft Project No. 23-009

STAMP

Office of Construction and Facilities Management

VA U.S. Department of Veterans Affairs

Drawing Title: ARCHITECTURAL - ENLARGED PLAN - EQUIPMENT STORAGE

Approved: Project Director

Phase: 100% CONSTRUCTION DOCUMENTS

Project Title: RENOVATIONS TO BUILDING 217

Location: EDWARD J. HINES JR. VAMC

Issue Date: 12/06/2024

Checked: CZ

Drawn: CR

Project Number: 578-20-002

Building Number: 217

Drawing Number: AE409

VA FORM 08-6231