LIFE SAFETY LEGEND

SYMBOLS / LINETYPES	DESCRIPTION
FE	FIRE EXTINGUISHER
S	SMOKE DETECTOR
S	FIRE ALARM SPEAKER
S P	FIRE ALARM OVERHEAD PAGING SPEAKER
	EXIT LIGHT
F	FIRE ALARM PULL STATION
F	STROBE OR VISUAL ALARM OR STROBE LIGHT
FE	FIRE EXTINGUISHER CABINET
EXIT	EXIT SIGN
	1 HOUR FIRE WALL
	2 HOUR FIRE WALL
	30 MINUTE SMOKE WALL
	HAZARDOUS AREA SMOKE WALL
	SUITE (NO RATING)

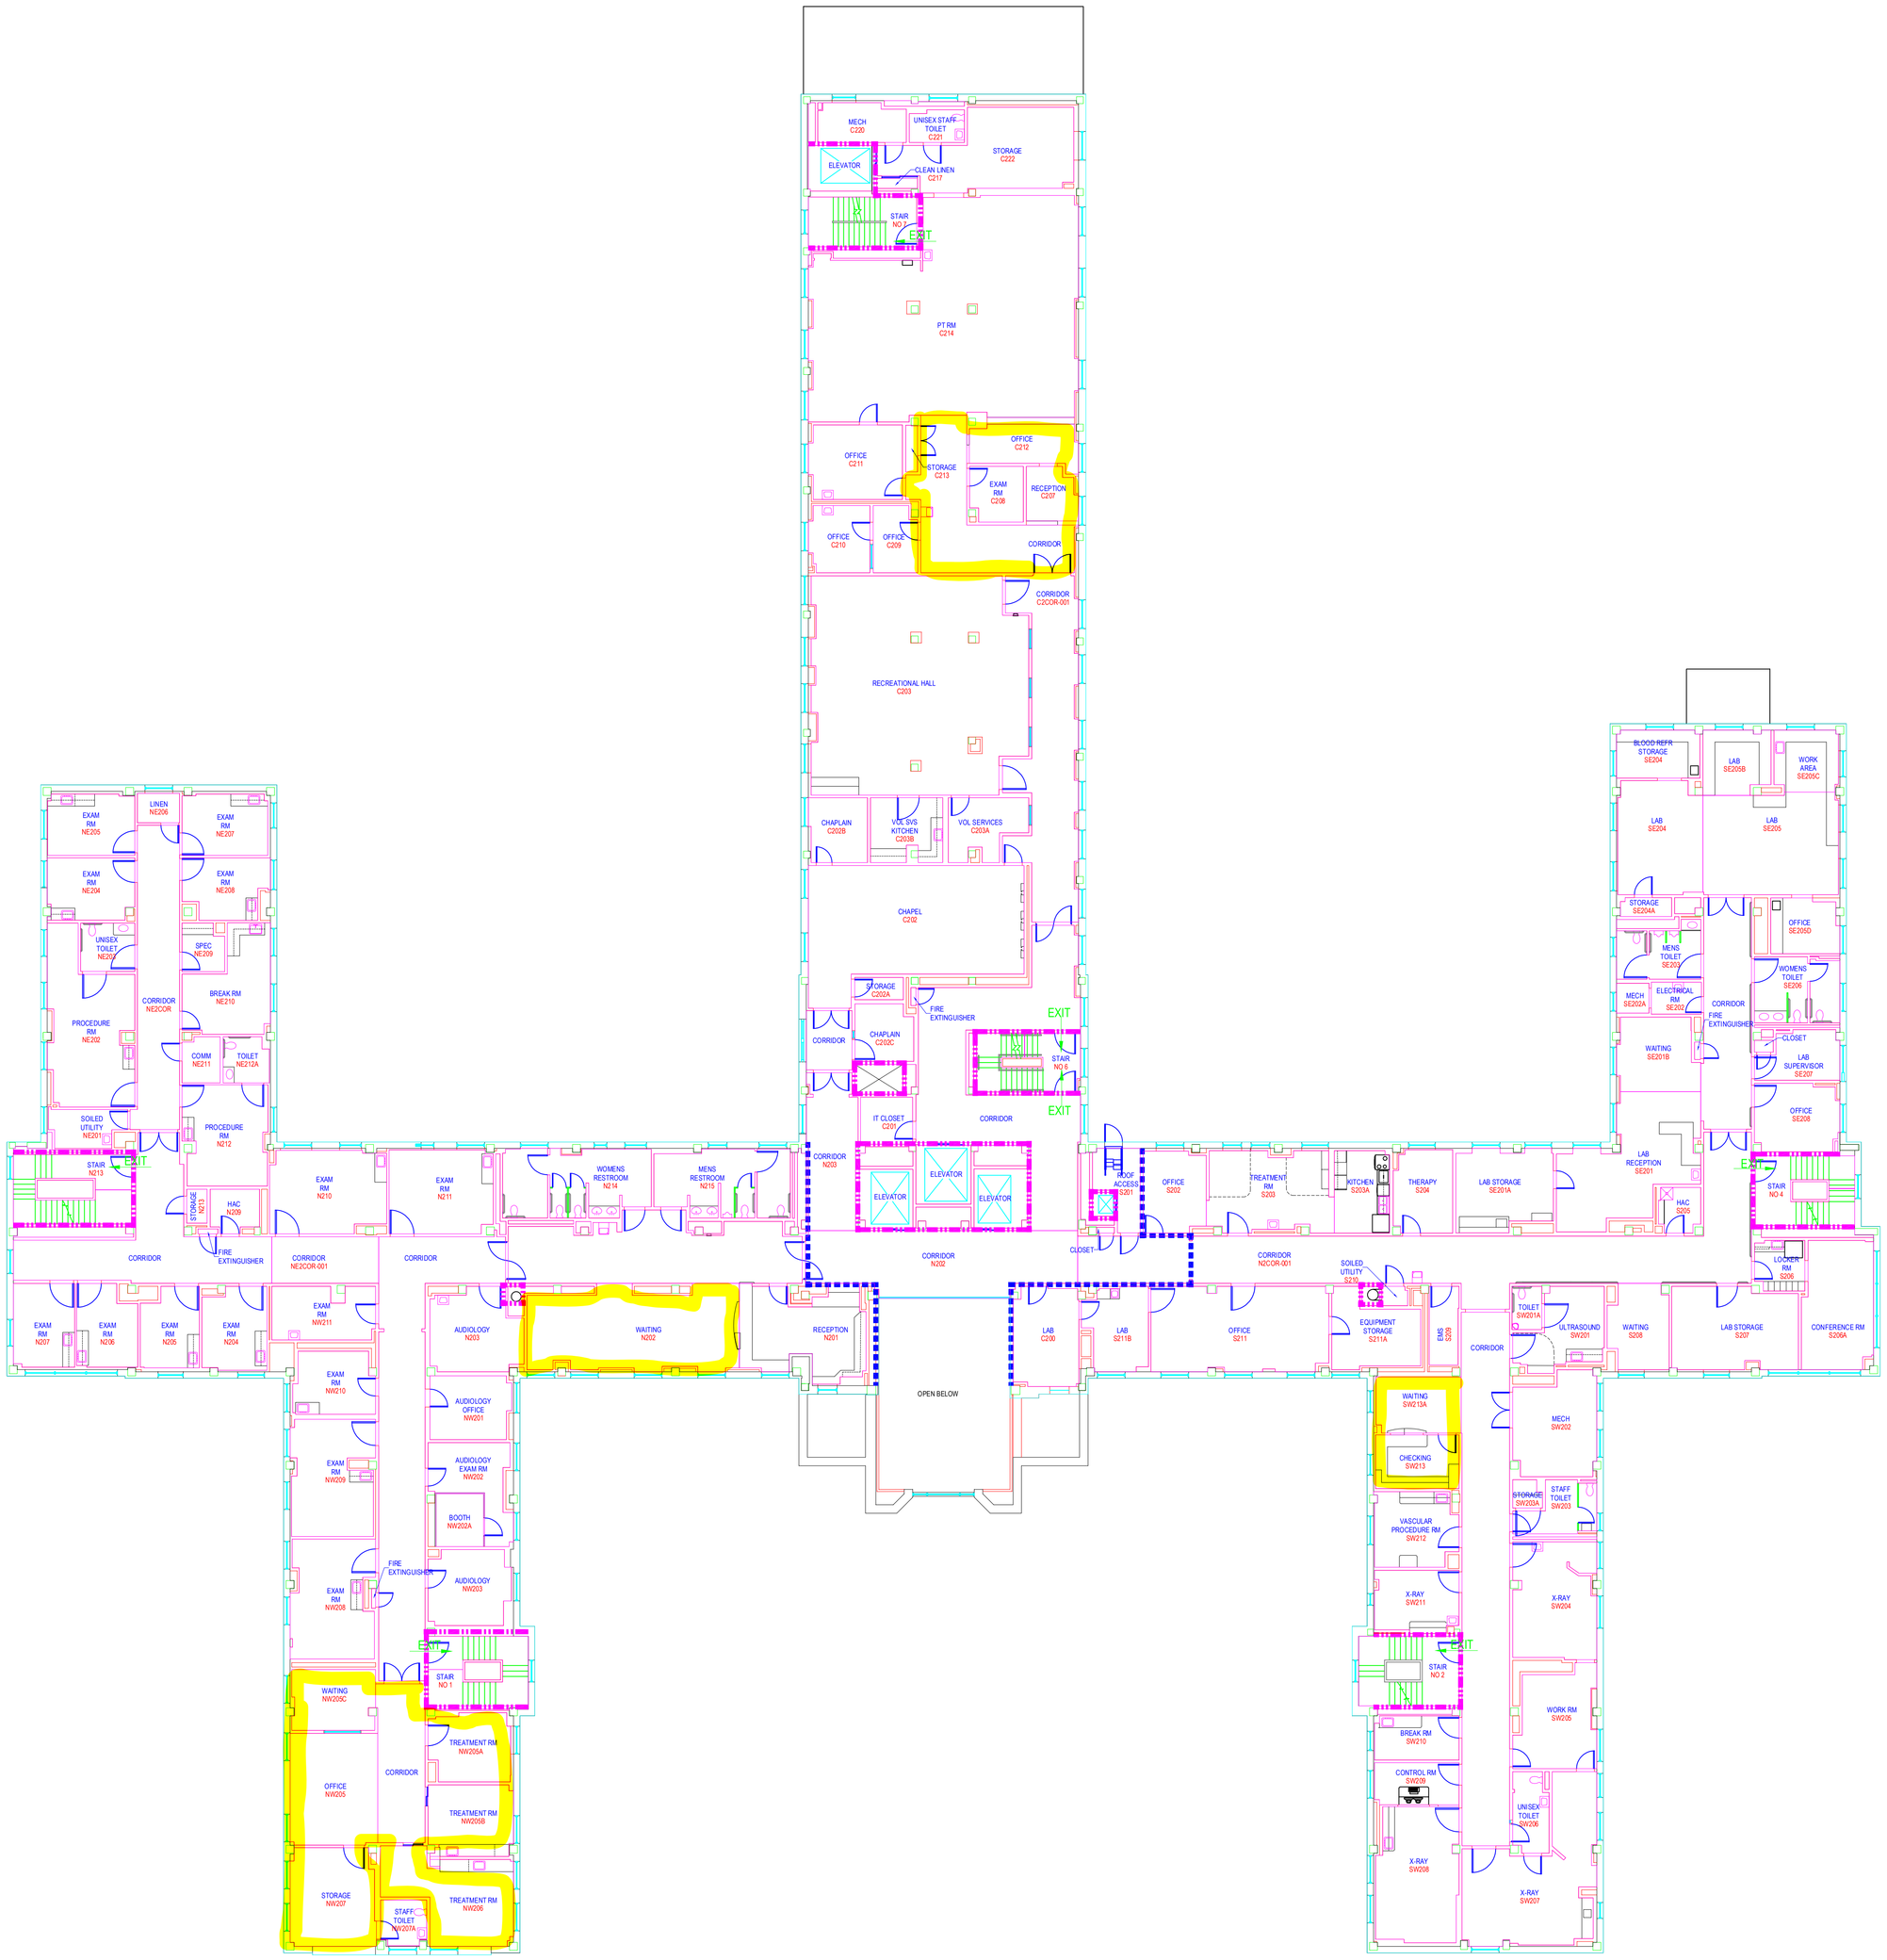

Final Submission	12-01-2020	Architects/Engineers/Consultants:	VLogic	V Logic Systems Inc. 2352 Main Street, Suite 207 Concord, MA 01742 Phone: 978-341-9000 www.vlogicsystems.com	Drawing Title: BUILDING 01 SECOND FLOOR PLAN ARCHITECTURAL	Project Title: AS-BUILT DRAWINGS
Revisions	Date	Professional Seal			Approved Project Director:	Location: WOOLWORTH AVENUE OMAHA, NE 68105-1850
						Date: 12-01-2020

Project Number:

Building Number: 01

File Name: GI-01-02AR

Checked:

Drawn: VL

Drawing Number:

Dwg. of

Office of Facilities Management

Department of Veterans Affairs

VA FORM 08-6231, OCT 1978

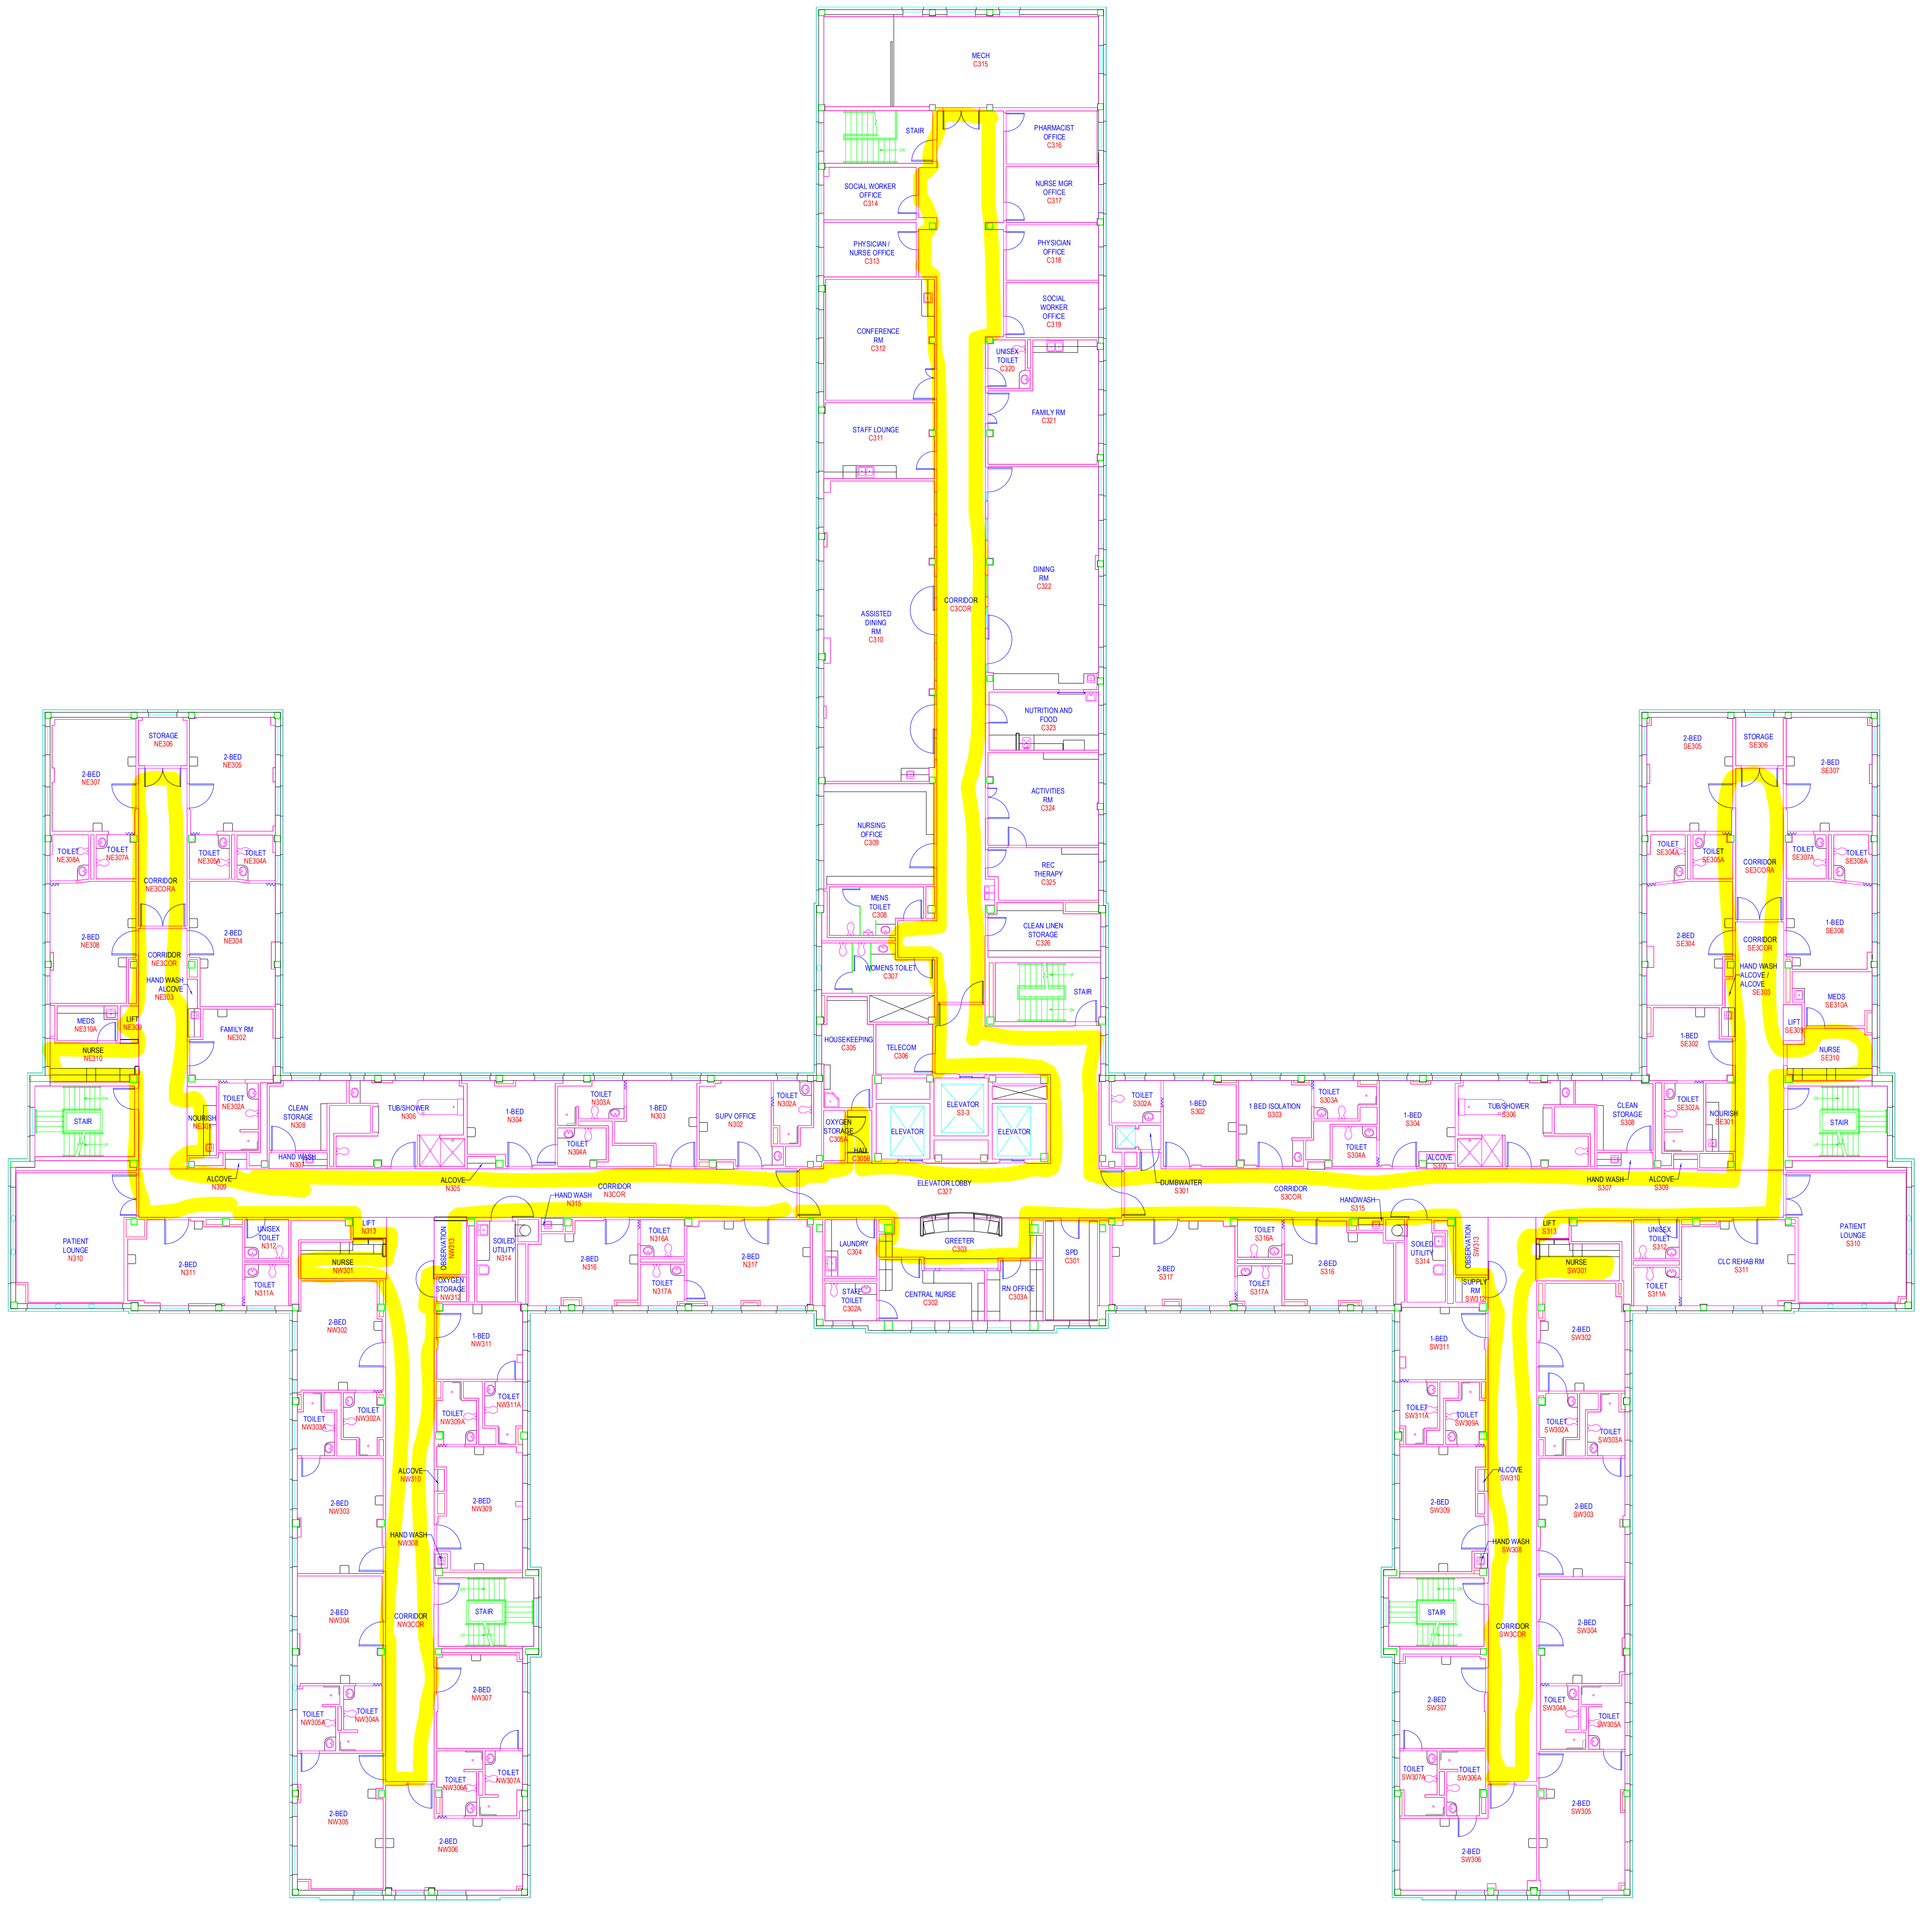

		Architects/Engineers/Consultants:	Professional Seal	V Logic Systems Inc. 2352 Main Street, Suite 207 Concord, MA 01742 Phone: 978-341-9000 www.vlogicsystems.com	Drawing Title BUILDING 01 THIRD FLOOR PLAN ARCHITECTURAL	Project Title AS-BUILT DRAWINGS	Project Number:	Office of Facilities Management
							Building Number: 01	
					Approved Project Director:	Location: WOOLWORTH AVENUE OMAHA, NE 68105-1850 / File Name: GI-01-03AR	Drawing Number:	
Final Submission	11-02-2020					Date: 11-02-2020 / Checked: / Drawn: VL	Dwg. of	Department of Veterans Affairs
Revisions	Date							

VA FORM 08-6231, OCT 1978