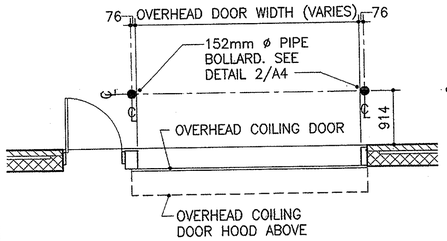

AT OVERHEAD DOORS

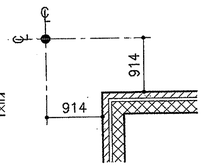

AT BUILDING CORNERS
(WHERE INDICATED ON PLAN)

TYPICAL BOLLARD CONFIGURATION
1:50 — 1 / A5|A4|A4

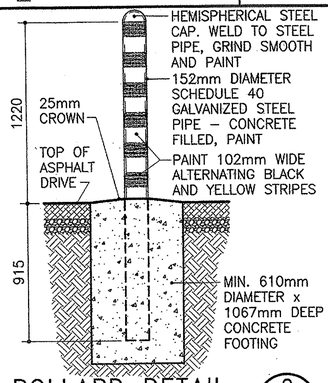

BOLLARD DETAIL
1:20 — 2 / A4|A4

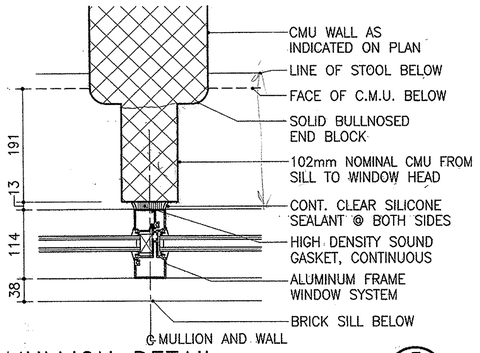

MULLION DETAIL
1:5 — 3 / A4|A4

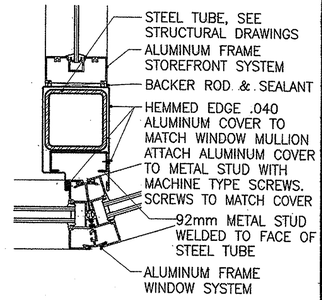

MULLION DETAIL
1:5 — 4 / A21|A4|A4

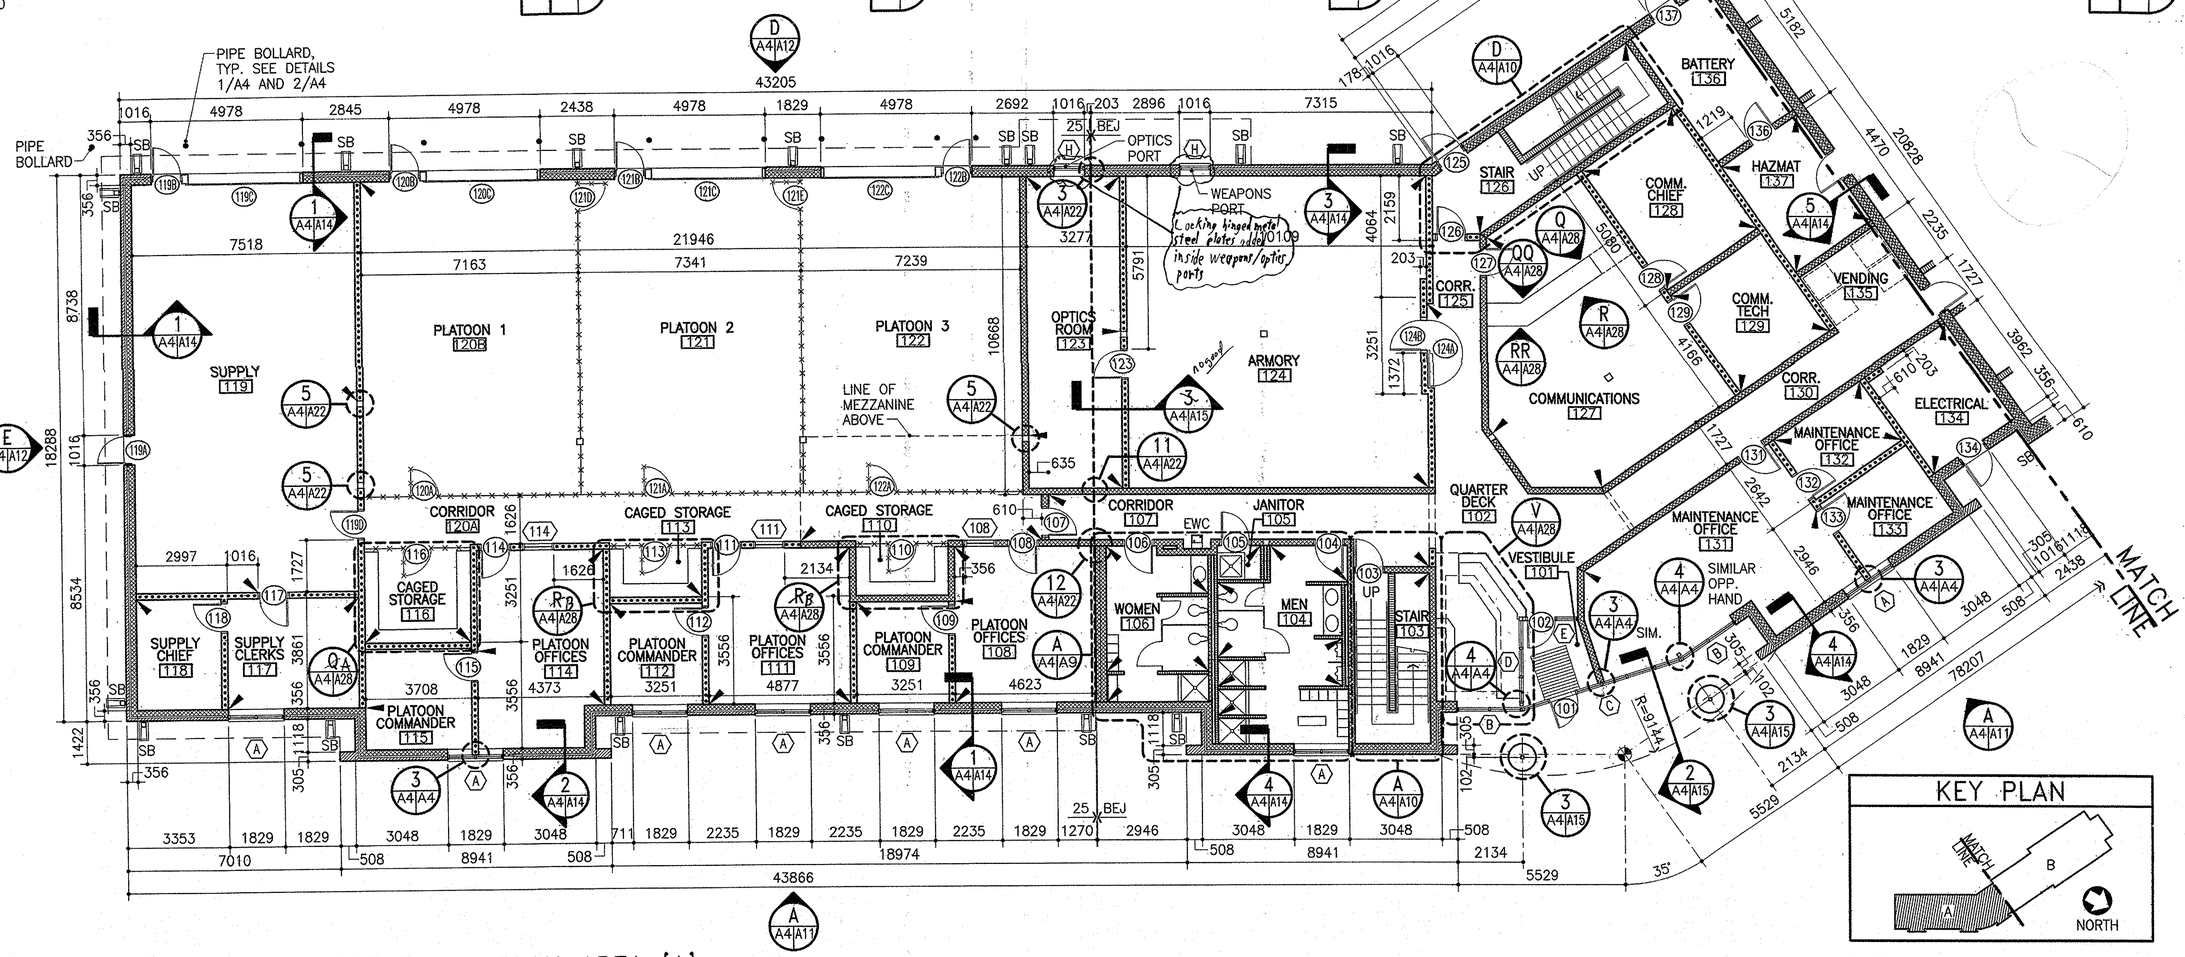

PARTIAL FIRST FLOOR PLAN AREA 'A'
1:100

NORTH

KEY PLAN

AS BUILT CONDITIONS
SATISFACTORY TO ARCHITECT: DATE 3/4/03
SATISFACTORY TO INSPECTOR: DATE 11-4-03
CONTRACTOR

1:5 0 50 100 200 300 400 500mm
1:20 0 200 500 1000 2000mm
1:50 0 1000 3000 5000mm
1:100 0 1000 5000 10000mm
ALL DIMENSIONS ARE MILLIMETERS (mm) UNLESS OTHERWISE INDICATED

NO.	DESCRIPTION	DATE	APPR

HBA
ARCHITECTURE ENGINEERING INTERIOR DESIGN

WILLIAM H. HARGROVE III REGISTERED ARCHITECT 03610 01-30-01 NORTH CAROLINA VIRGINIA BEACH, VA SEAL

APPROVED
ACTIVITY – SATISFACTORY TO
DATE
APPROVED
FOR EFD FOR COMMANDER, NAVFAC
DATE

A/E	EFD
HBA	DESIGN
HBA	DRAWN
JDB	REVIEW JMA
HAJ	QC
WHH	CHIEF ARCH./ ENGR.
PROJECT MANAGER	
FIRE PROTECTION	
BRANCH MANAGER	
DESIGN DIRECTOR	

DEPARTMENT OF THE NAVY
NAVAL STATION
ATLANTIC DIVISION
NAVAL FACILITIES ENGINEERING COMMAND
NORFOLK, VIRGINIA
COURTHOUSE BAY, U.S. MARINE CORPS BASE
CAMP LEJEUNE, NORTH CAROLINA

AMPHIBIOUS OPERATIONS AND MAINTENANCE COMPLEX

FIRST FLOOR PLAN – AREA 'A'

CODE ID. NO. 80091 | SIZE D
SCALE: GRAPHIC
EFD NO.
STA. PROJ. NO. P-019
SPEC. NO. 05-99-9152
CONSTR. CONTR. NO. N62470-99-B-9152
NAVFAC DRAWING NO. 4430523
SHEET 84 OF 197

A-4

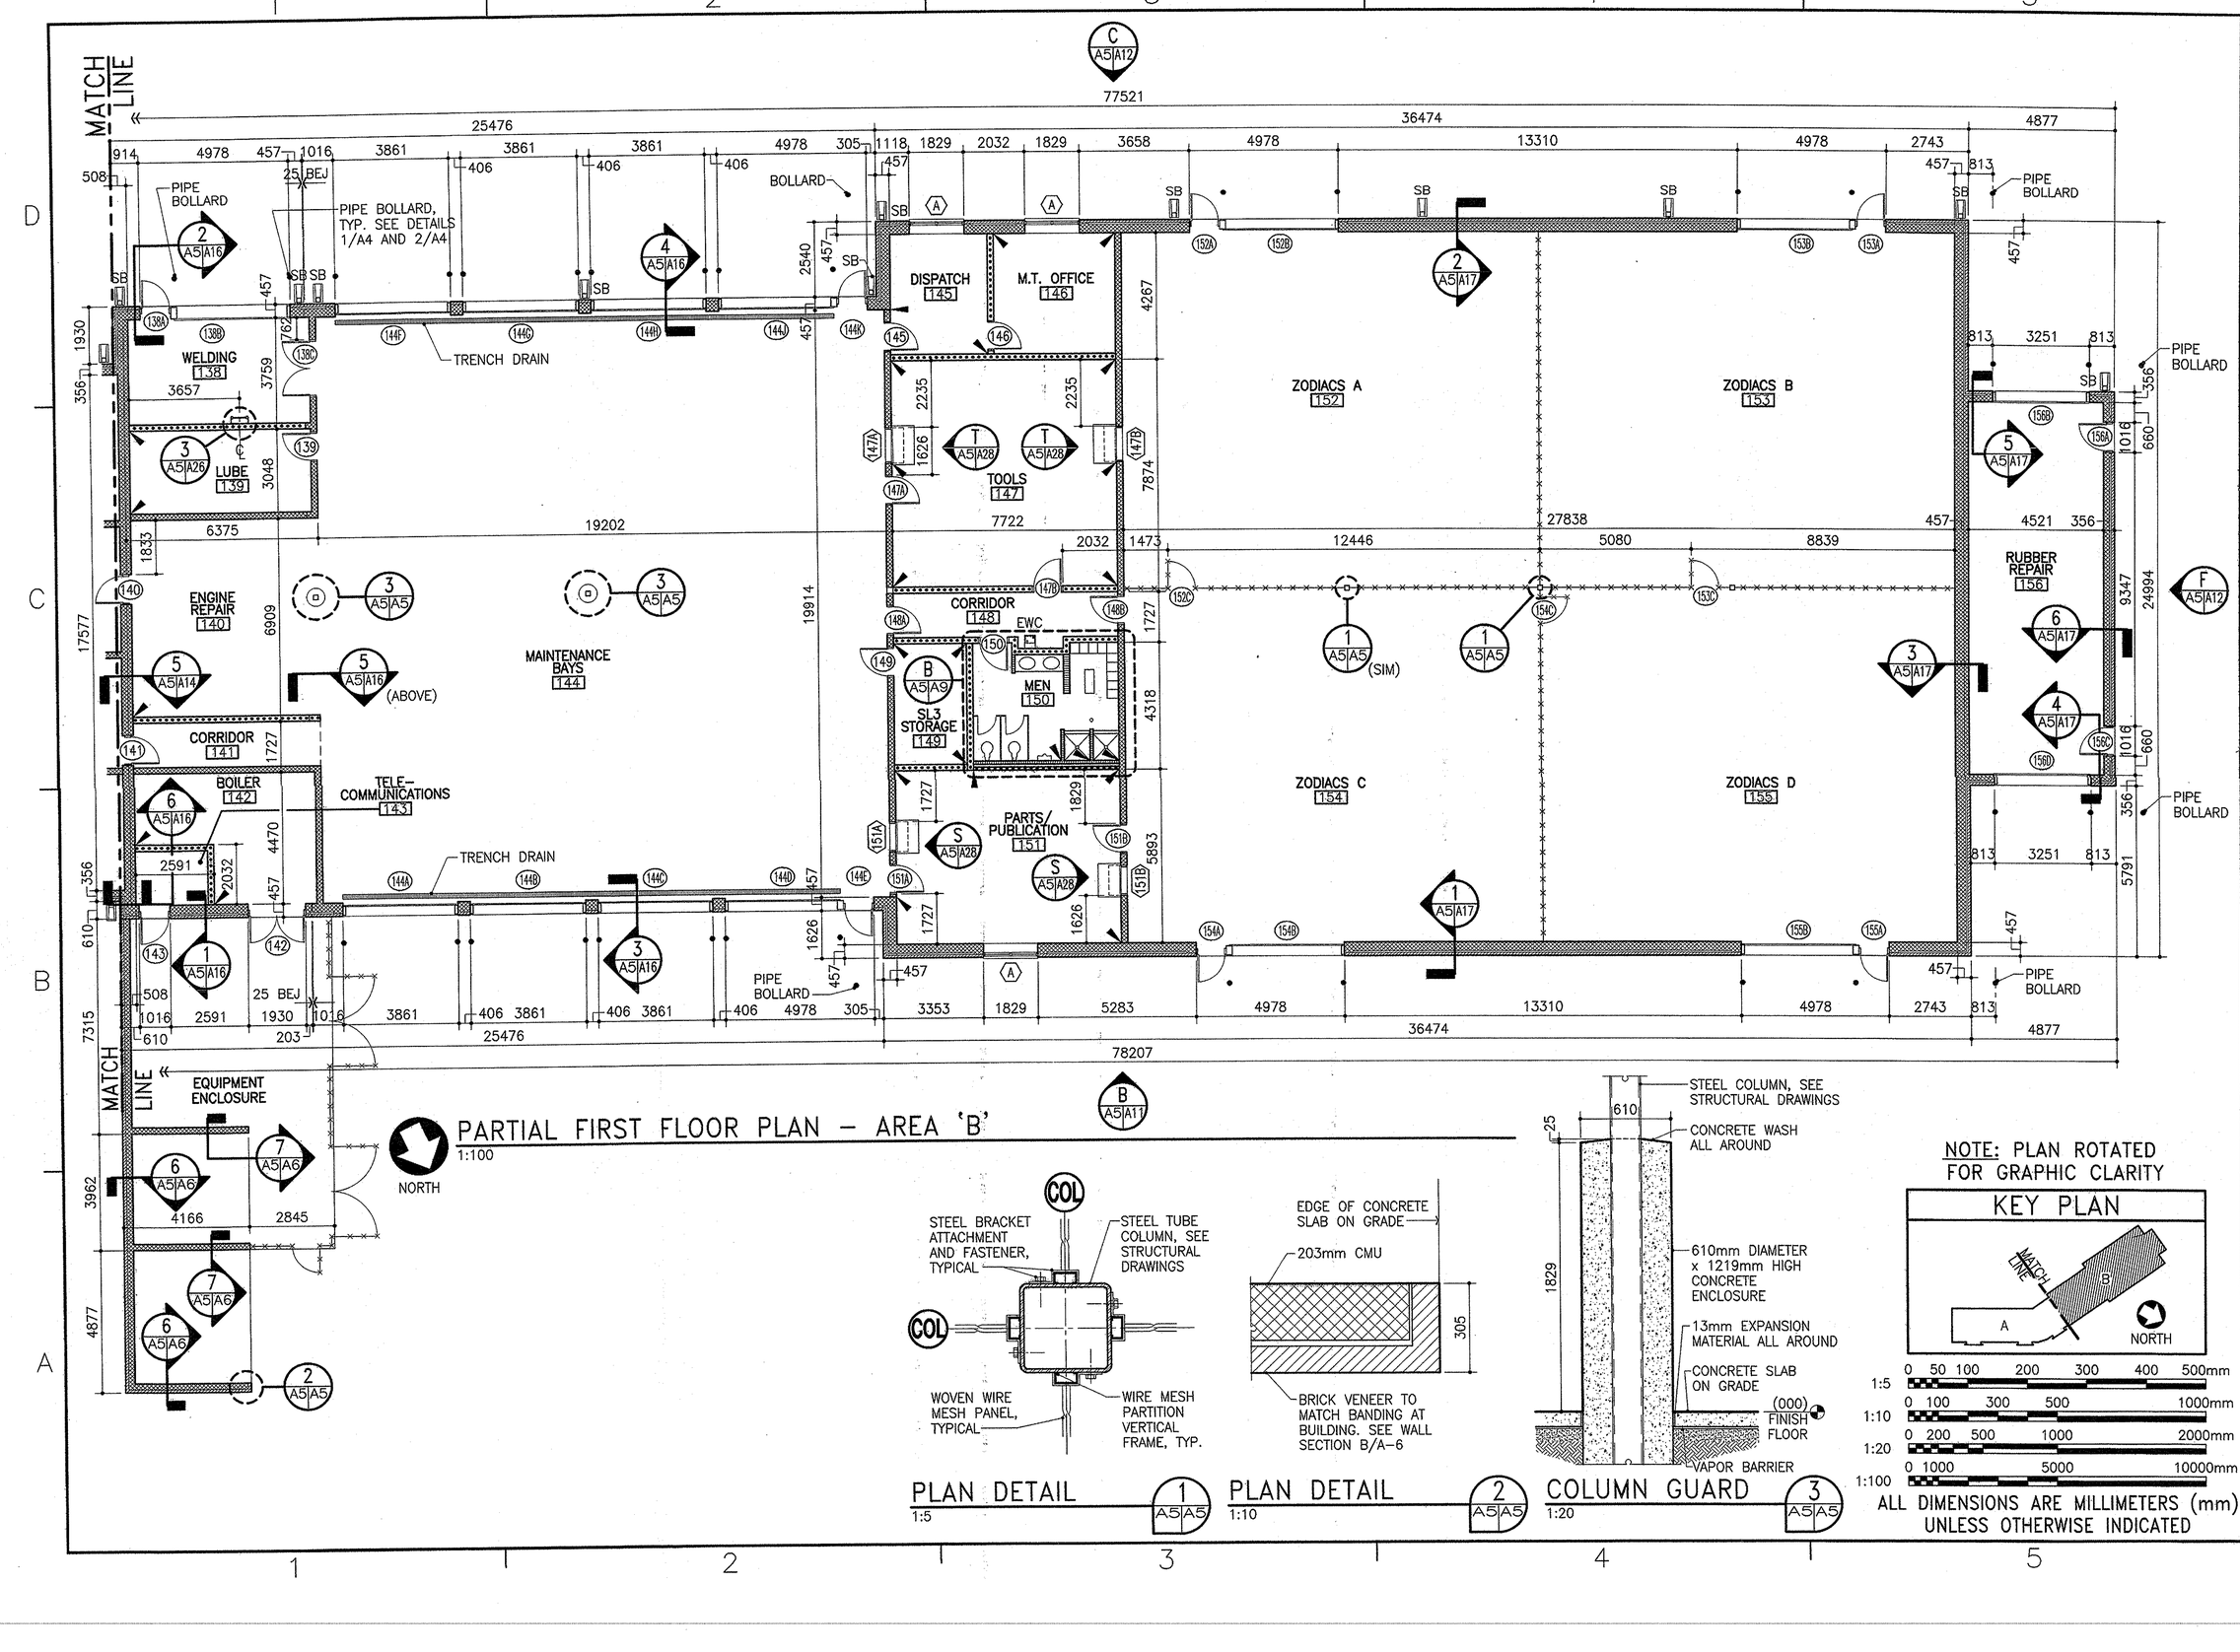

PARTIAL FIRST FLOOR PLAN – AREA 'B'

1:100

PLAN DETAIL 1/A5|A5

1:5

PLAN DETAIL 2/A5|A5

1:10

COLUMN GUARD 3/A5|A5

1:20

NOTE: PLAN ROTATED FOR GRAPHIC CLARITY

KEY PLAN

ALL DIMENSIONS ARE MILLIMETERS (mm) UNLESS OTHERWISE INDICATED

HBA ARCHITECTURE ENGINEERING INTERIOR DESIGN

WILLIAM H. HARGROVE III REGISTERED ARCHITECT 03610 01-30-01 NORTH CAROLINA VIRGINIA BEACH, VA SEAL

APPROVED
ACTIVITY – SATISFACTORY TO
DATE
APPROVED
FOR EFD FOR COMMANDER NAVFAC
2/20/01
DATE

A/E	EFD
HBA	DESIGN
HBA	DRAWN
JDB	REVIEW JMA
HAJ	QC
WHH	CHIEF ARCH./ ENGR.
PROJECT MANAGER	
FIRE PROTECTION	
BRANCH MANAGER	
DESIGN DIRECTOR	

DEPARTMENT OF THE NAVY
NAVAL FACILITIES ENGINEERING COMMAND
NORFOLK, VIRGINIA
ATLANTIC DIVISION
NAVAL STATION
COURTHOUSE BAY, U.S. MARINE CORPS BASE
CAMP LEJEUNE, NORTH CAROLINA

AMPHIBIOUS OPERATIONS AND MAINTENANCE COMPLEX

FIRST FLOOR PLAN – AREA 'B'

CODE ID. NO. 80091	SIZE D
SCALE: GRAPHIC	
EFD NO.	
STA. PROJ. NO. P-019	
SPEC. NO. 05-99-9152	
CONSTR. CONTR. NO.	N62470-99-B-9152
NAVFAC DRAWING NO.	4430529
SHEET 85 OF 197	

A-5

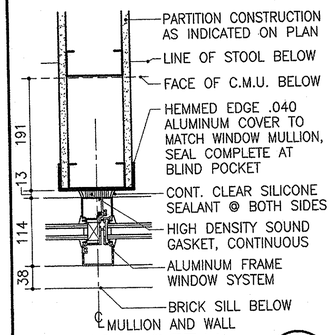

MULLION DETAIL

1:5 — 1 A6|A6

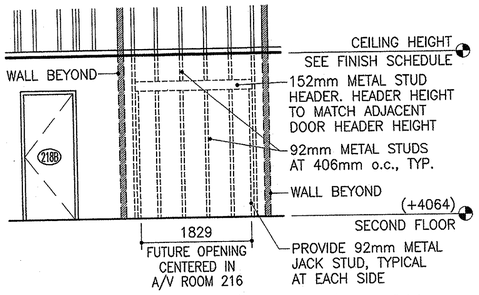

FRAME KNOCK-OUT ELEVATION AT CLASSROOM 218

1:50 — 5 A6|A6

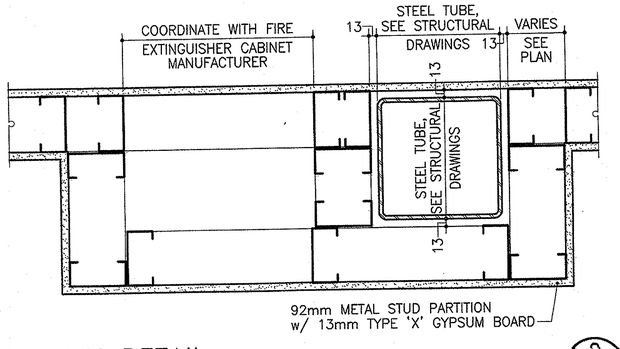

COLUMN DETAIL

1:5 — 2 A6|A6

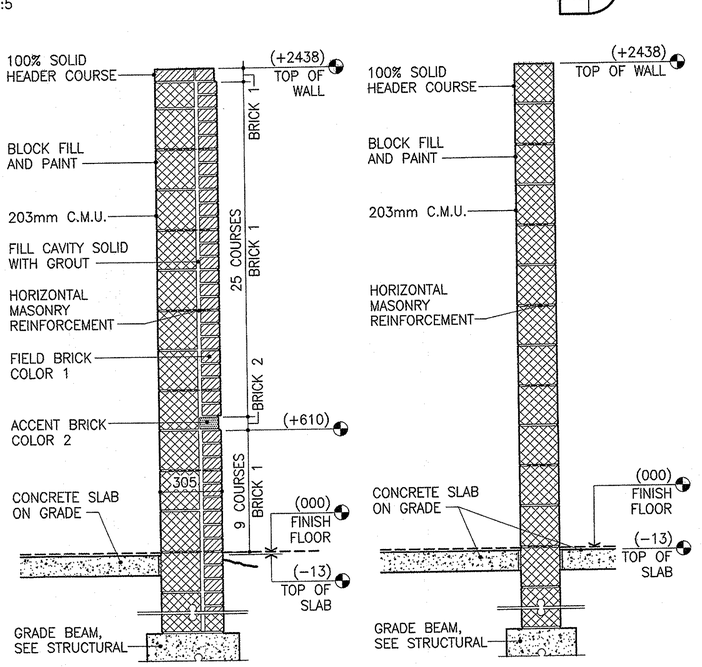

WALL SECTION

1:15 — 6 A5|A6

WALL SECTION

1:15 — 7 A5|A6

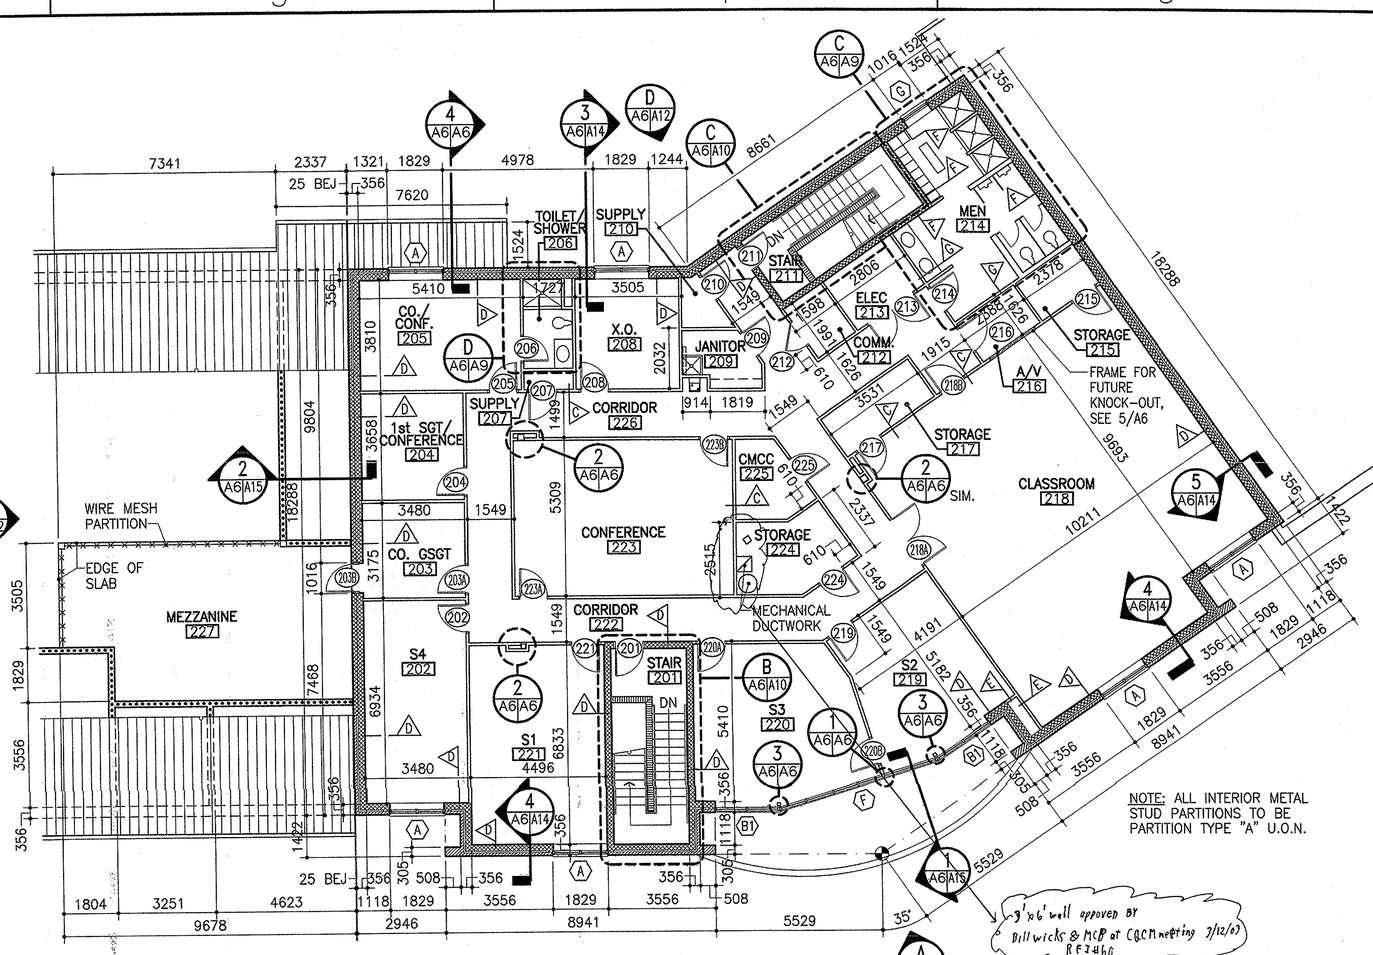

SECOND FLOOR PLAN

1:100

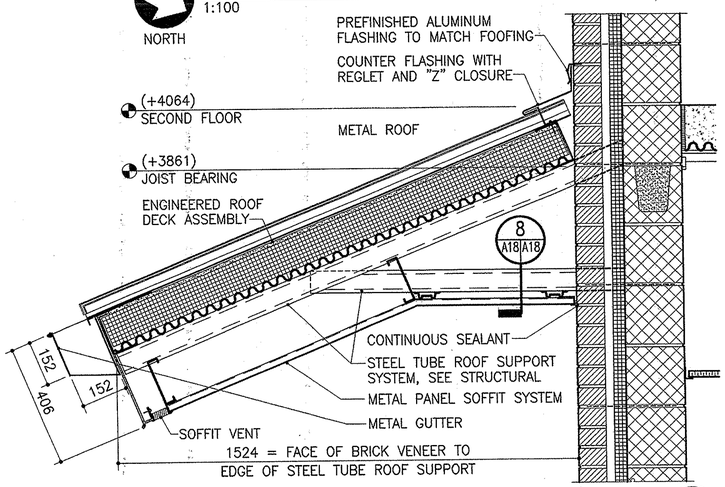

ROOF OVERHANG DETAIL

1:10 — 4 A6|A6

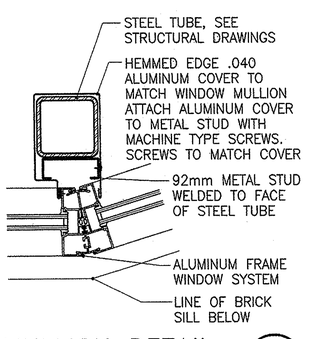

MULLION DETAIL

1:5 — 3 A21|A6|A6

AS BUILT CONDITIONS

SATISFACTORY TO ARCHCC: DATE 3/6/03

SATISFACTORY TO INSPECTOR: DATE 11-4-03

CONTRACTOR

1:5 0 50 100 200 300 400 500mm
1:10 0 100 300 500 1000mm
1:15 0 100 300 500 1000 1500mm
1:50 0 1000 3000 5000mm
1:100 0 1000 5000 10000mm

ALL DIMENSIONS ARE MILLIMETERS (mm) UNLESS OTHERWISE INDICATED

HBA ARCHITECTURE ENGINEERING INTERIOR DESIGN

WILLIAM H. HARGROVE III REGISTERED ARCHITECT 03610 01-30-01 VIRGINIA BEACH, VA NORTH CAROLINA SEAL

APPROVED
ACTIVITY – SATISFACTORY TO
DATE
APPROVED
FOR EFD FOR COMMANDER, NAVFAC
DATE 3/20/03

A/E	EFD
HBA	DESIGN
HBA	DRAWN
JDB	REVIEW JMA
HAJ	QC
WHH	CHIEF ARCH./ ENGR.
PROJECT MANAGER	
FIRE PROTECTION	
BRANCH MANAGER	
DESIGN DIRECTOR	

NAVAL FACILITIES ENGINEERING COMMAND — ATLANTIC DIVISION — NORFOLK, VIRGINIA
DEPARTMENT OF THE NAVY — NAVAL STATION — COURTHOUSE BAY, U.S. MARINE CORPS BASE — CAMP LEJEUNE, NORTH CAROLINA

AMPHIBIOUS OPERATIONS AND MAINTENANCE COMPLEX

SECOND FLOOR PLAN

CODE ID. NO. 80091 | SIZE D
SCALE: GRAPHIC
EFD NO.
STA. PROJ. NO. P-019
SPEC. NO. 05-99-9152
CONSTR. CONTR. NO. N62470-99-B-9152
NAVFAC DRAWING NO. 4430530
SHEET 86 OF 197
A-6