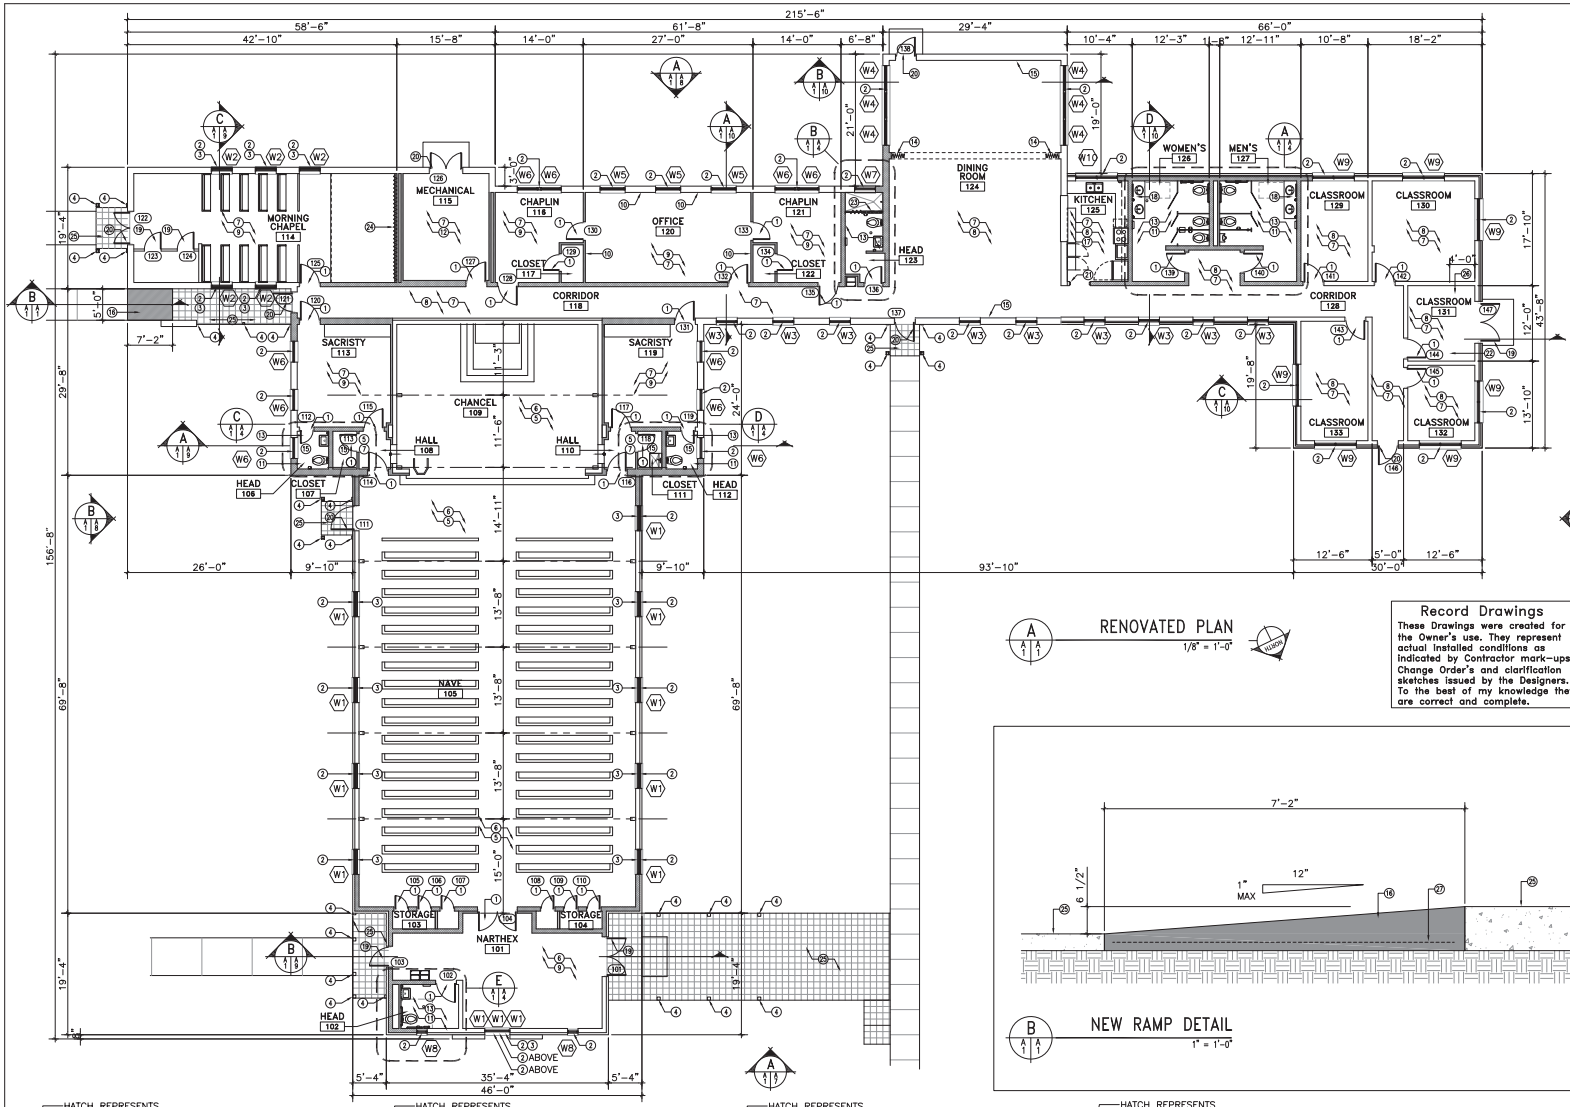

A RENOVATED PLAN
1/8" = 1'-0"

Record Drawings
These Drawings were created for the Owner's use. They represent actual installed conditions as indicated by Contractor mark-ups, Change Order's and clarification sketches issued by the Designers. To the best of my knowledge they are correct and complete.

B NEW RAMP DETAIL
1" = 1'-0"

SYM	REVISIONS	DATE	APPROVED

GENERAL NOTES

1. CONTRACTOR TO FIELD VERIFY ALL EXISTING DIMENSIONS BEFORE COMMENCING WORK.
2. CONTRACTOR TO REVIEW LEAD PAINT SURVEY AND REPORT OF ASBESTOS BEFORE COMMENCING WORK.
3. SEE PLUMBING, MECHANICAL, AND ELECTRICAL DRAWINGS FOR ADDITIONAL NOTES.

RENOVATION NOTES

MARK	DESCRIPTION
①	INSTALL NEW INTERIOR PERSONNEL DOOR INTO EXISTING DOOR FRAME. PAINT FRAME.
②	INSTALL NEW ALUMINUM FRAME WINDOW. SEE WINDOW SCHEDULE.
③	EXISTING ALUMINUM WINDOW FRAME WITH COLORED GLASS MOSAIC PANEL TO REMAIN. CONTRACTOR TO INSTALL NEW WINDOW ON EXTERIOR OF EXISTING PANEL.
④	EXISTING ALUMINUM COLUMNS AT ENTRY TO REMAIN, CONTRACTOR TO PROTECT DURING RENOVATION.
⑤	EXISTING CARPET, PADDING, AND BASE IN NAVE/CHANCEL TO REMAIN. CONTRACTOR TO PROTECT DURING RENOVATION.
⑥	EXISTING UN-PAINTED BLOCK WALLS (IN ASHLAR PATTERN) TO REMAIN UN-PAINTED. CONTRACTOR TO PROTECT DURING RENOVATION.
⑦	PREP AND REPAINT EXISTING PAINTED BLOCK WALLS.
⑧	INSTALL NEW VINYL COMPOSITION TILE FLOOR AND 4" RUBBER COVE BASE. SEE FINISH SCHEDULE.
⑨	INSTALL NEW CARPET AND 4" RUBBER COVE BASE. SEE FINISH SCHEDULE.
⑩	(4) EXISTING CUSTOM PAINTED DEPARTMENT OF NAVY PAINTINGS TO REMAIN. CONTRACTOR TO PROTECT DURING RENOVATIONS. SEE DIAGRAMS BELOW.
⑪	EXISTING FLOOR/WALL TILE TO REMAIN. CONTRACTOR TO REPAIR AS NECESSARY. SEE NOTE 11 SHEET D-1.
⑫	EXISTING CONCRETE FLOOR TO BE CLEANED AND RE-SEALED
⑬	INSTALL NEW PLUMBING FIXTURES INCLUDING SINKS, TOILETS, URINALS, & PARTITIONS. SEE ENLARGED PLANS & PLUMBING PLANS FOR ADDITIONAL NOTES.
⑭	EXISTING MOVABLE PARTITION TO REMAIN. CONTRACTOR TO PROTECT DURING RENOVATION.
⑮	EXISTING PAINTED GYPSUM WALL BOARD TO BE REPAINTED.
⑯	INSTALL NEW 3000 PSI, 4" (MIN), CONCRETE RAMP FROM EXISTING SIDEWALK GRADE TO EXISTING LANDING (+/- 6½") WITH A MAXIMUM SLOPE OF 1" IN 12".
⑰	EXISTING KITCHEN CABINETS AND APPLIANCES TO REMAIN. CONTRACTOR TO PROTECT DURING RENOVATION.
⑱	EXISTING BATHROOM COUNTERTOPS TO REMAIN. CONTRACTOR TO PROTECT DURING RENOVATION.
⑲	INSTALL NEW INTERIOR/EXTERIOR PERSONNEL DOOR & FRAME.
⑳	EXISTING PERSONNEL DOOR & FRAME TO REMAIN, PAINT.
㉑	CONTRACTOR TO "INFILL" HINGE RABBITS IN EXISTING H.M. DOOR FRAME BEFORE PAINTING.
㉒	INSTALL NEW 3 ⅝" METAL STUD WALL W/ STUDS @ 16" O.C. R-11 FIBERGLASS INSULATION & ⅝" GYPBOARD EACH SIDE, PAINT.
㉓	INSTALL NEW 4" CMU WALL TO 7'-0" A.F.F.
㉔	NEW FIRE RESISTANT CURTAINS TO BE INSTALLED AFTER RENOVATIONS.
㉕	EXISTING COLOR COATED CONCRETE TO REMAIN. CONTRACTOR TO PROTECT DURING RENOVATION.
㉖	NEW CONCRETE FLOOR, SEAL.
㉗	4X4 WWF REINFORCEMENT IN NEW CONCRETE RAMP.

GRAPHIC SCALE

HATCH REPRESENTS NEW WALL PAINT. NO PAINT WITHIN 1" OF EXISTING PAINTING.

HATCH REPRESENTS NEW WALL PAINT. NO PAINT WITHIN 1" OF EXISTING PAINTING.

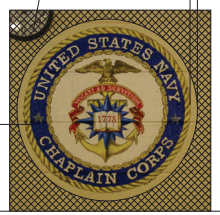

HATCH REPRESENTS NEW WALL PAINT. NO PAINT WITHIN 1" OF EXISTING PAINTING.

HATCH REPRESENTS NEW WALL PAINT. NO PAINT WITHIN 1" OF EXISTING PAINTING.

A-1

The Walker Group Architecture, Inc
P.O. Box 541, New Bern, NC 28563
252.638.2778 (PHONE)
252.638.2992 (FAX)

DEPARTMENT OF THE NAVY NAVAL FACILITIES ENGINEERING COMMAND
MARINE CORPS BASE
CAMP LEJEUNE, NORTH CAROLINA

DES.
DR. K.WRIGHT
CHK. B.WALKER
SUBMITTED BY: J.WALKER
DESIGN DIR. B. MARSHBURN
APPROVED: PWO OR OICC DATE
SATISFACTORY TO: DATE

13-0005 INTERIOR/EXTERIOR REPAIRS, BLDG. AS236

RENOVATED FLOOR PLAN

SIZE F | CODE IDENT. NO | NAVFAC DRAWING NO. 60013339
CONST. CONTR. NO. N40085-13-B-0005
SCALE: NOTED | SPEC. 05-13-0005 | SHEET 17 OF 43