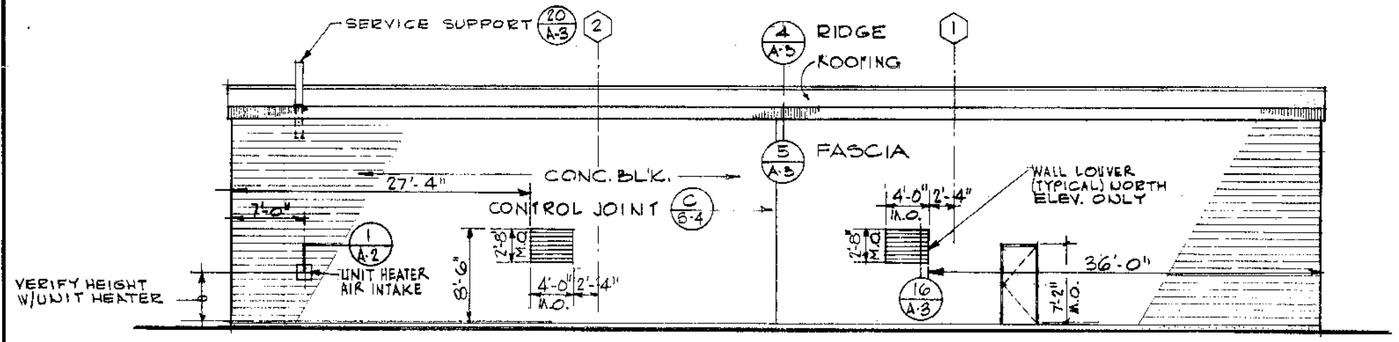

B A-1 NORTH ELEVATION (SOUTH ELEV. SIMILAR)
1/8" = 1'-0"

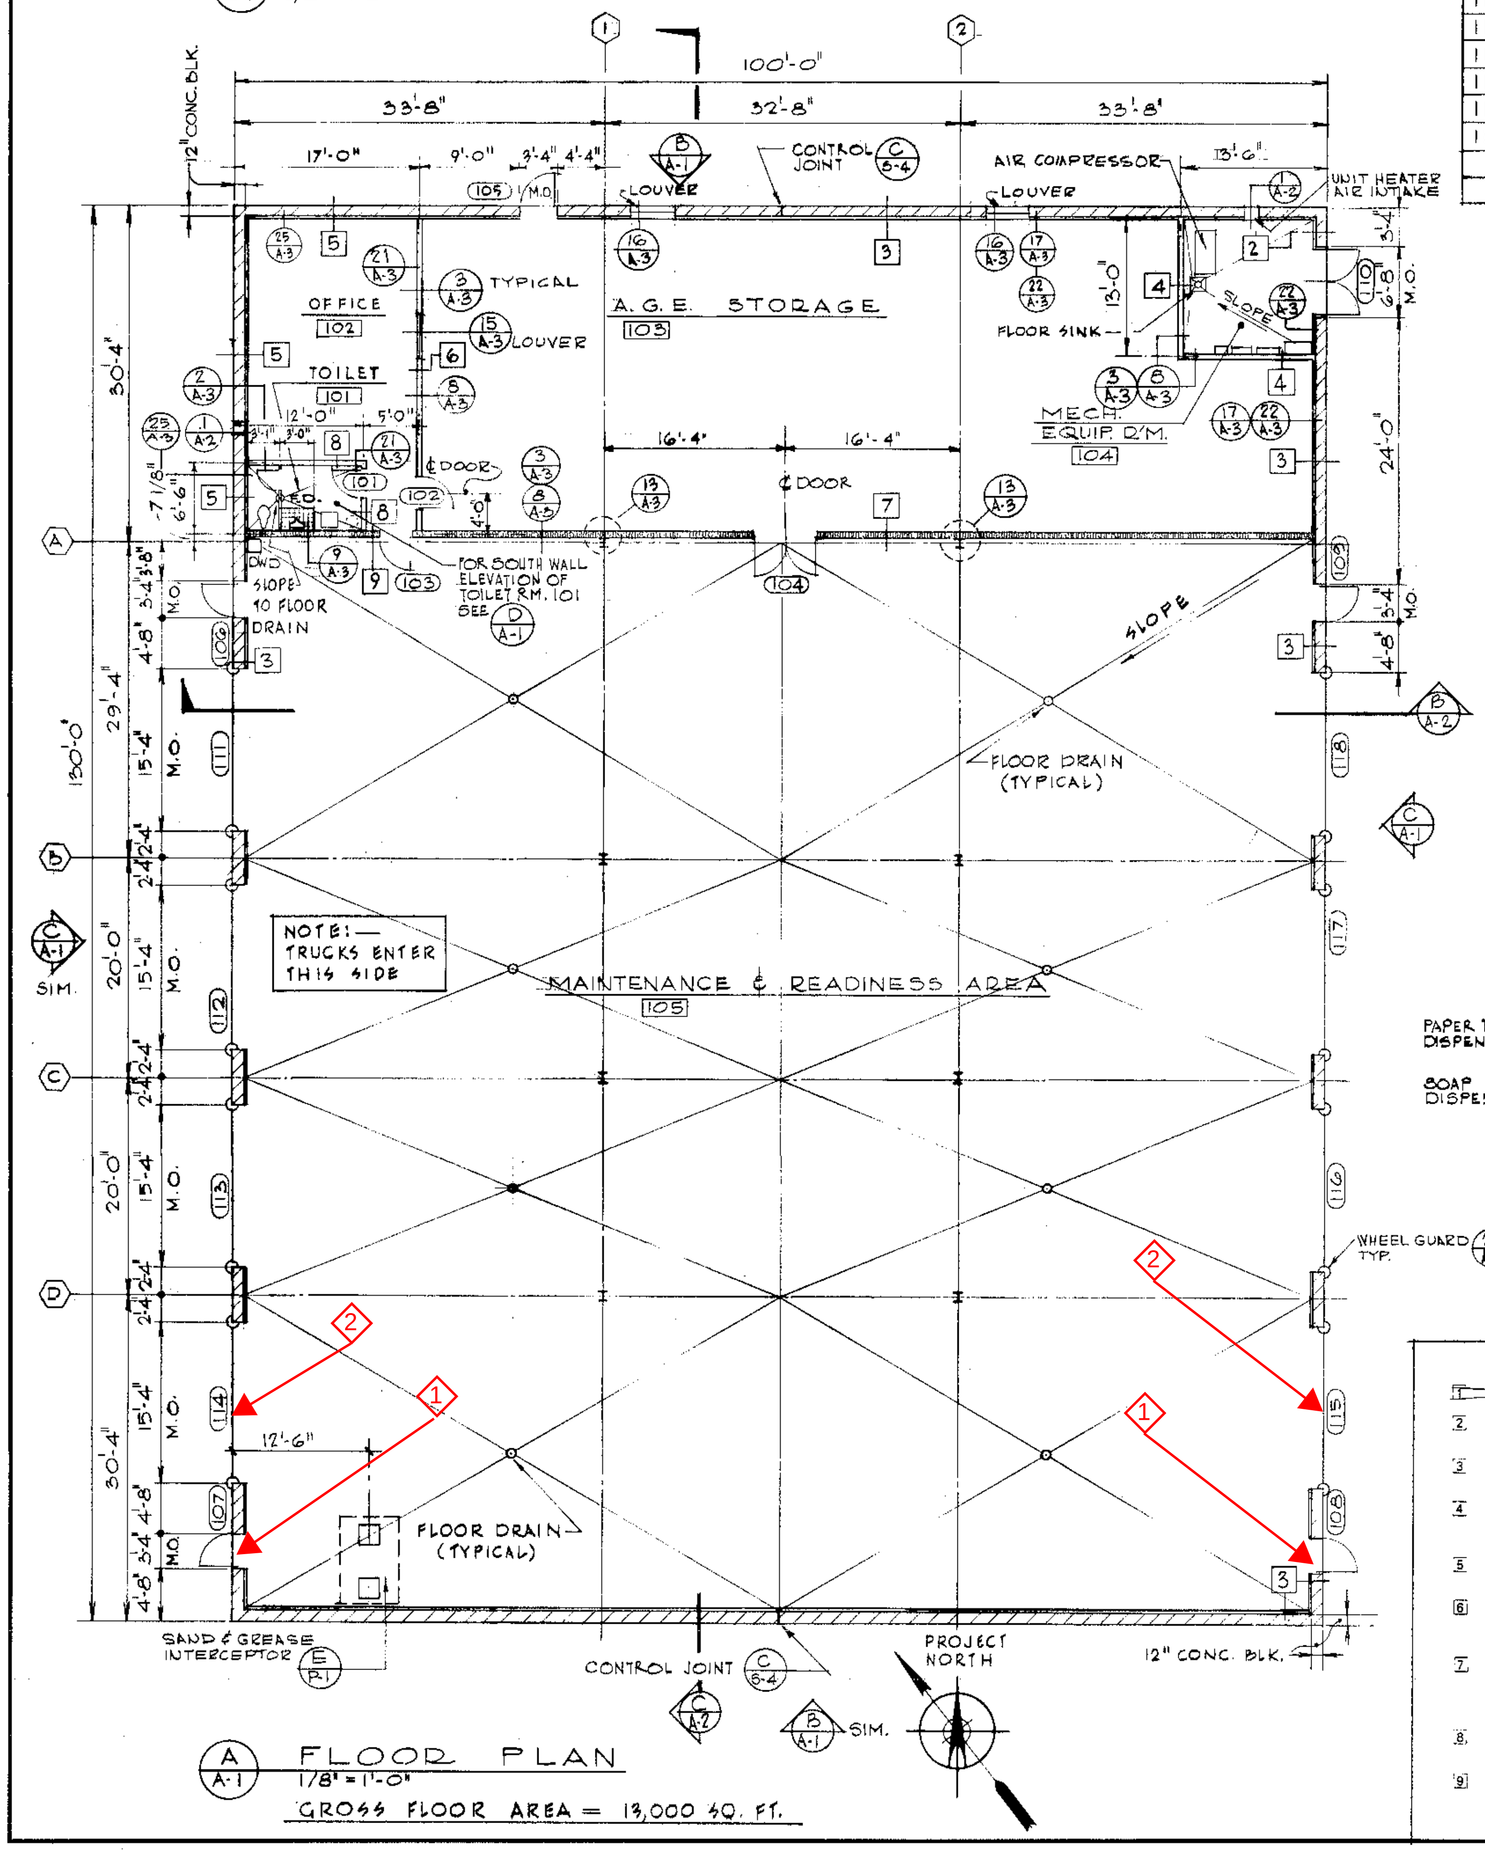

A A-1 FLOOR PLAN
1/8" = 1'-0"
GROSS FLOOR AREA = 13,000 SQ. FT.

DOOR SCHEDULE

MARK	PAIR	WIDTH	HEIGHT	THICKNESS	TYPE	LOUVER	HDWE SET	DETAILS HEAD	DETAILS JAMB	DETAILS SILL	G.L. LABEL	REMARKS
101		2'-8"	7'-0"	1 3/4"	A		HW2	12/A3	12/A3	—		UNDERCUT 1"
102		3'-0"	↑	↑	A		HW6	↑	↑	—		
103		3'-0"			A		HW5			—		
104	○	6'-0"			B		HW4	12/A3	12/A3	—		
105		3'-0"			A		HW1	1/A3	10/A3	11/A3		
106		↑			↑		HW1	↑	↑	↑		
107							HW1					
108							HW1					
109		3'-0"			A		HW1					
110	○	6'-4"	7'-0"	1 3/4"	B		HW3	1/A3	10/A3	11/A3		4-LOUVERS
111		15'-4"	16'-6"	2"	C		HW7	19/A3	23/A3	24/A3		
112		↑					HW7	↑	↑	↑		
113							HW7					
114							HW7					
115							HW7					
116							HW7					
117							HW7					
118		15'-4"	16'-6"	2"	C		HW7	19/A3	23/A3	24/A3		

ROOM FINISH SCHEDULE

MARK	DESCRIPTION	FLOOR CONC.	FLOOR CER. TILE	FLOOR	FLOOR	BASE CONC	BASE T.S. RUBBER	BASE CONC. BLK.	WALLS CONC. BLK.	WALLS GYP. BD.	WALLS INSULATION	CEILING EXP. STRUC.	CEILING GYP. BD.	CEILING	HEIGHT	WAINSCOT CER. TILE (4'-0")	WAINSCOT GYP. BD. (8'-4")	WAINSCOT ASB. CEM. (8'-4")
101	TOILET	○	6				5			○			○		9'-6"	1		
102	OFFICE	○					4			○	2		○		9'-6"			
103	A.G.E STOR.	○				○		2		○	2	○		—			4	
104	MECH. RM.	○				○		2		○	2	○		—		2		
105	MAINT. AREA	○				○		2	○	○		○		—			4	

REMARKS:
1 FIXTURE WALL ONLY
2 EXTERIOR WALLS ONLY
3 DELETE
4 ALL WALLS
5 THREE WALLS

CLG. DET. = 21/A-3
CLG. DET. = 21/A-3

6 UNDER URINAL ONLY

DOOR TYPES

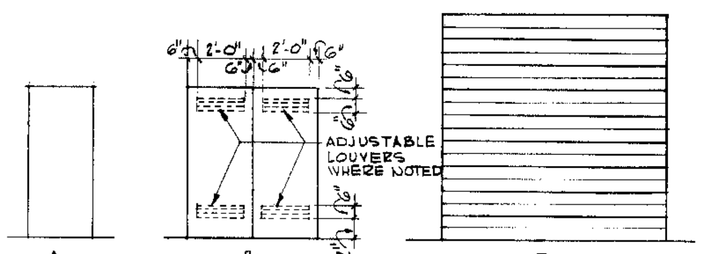

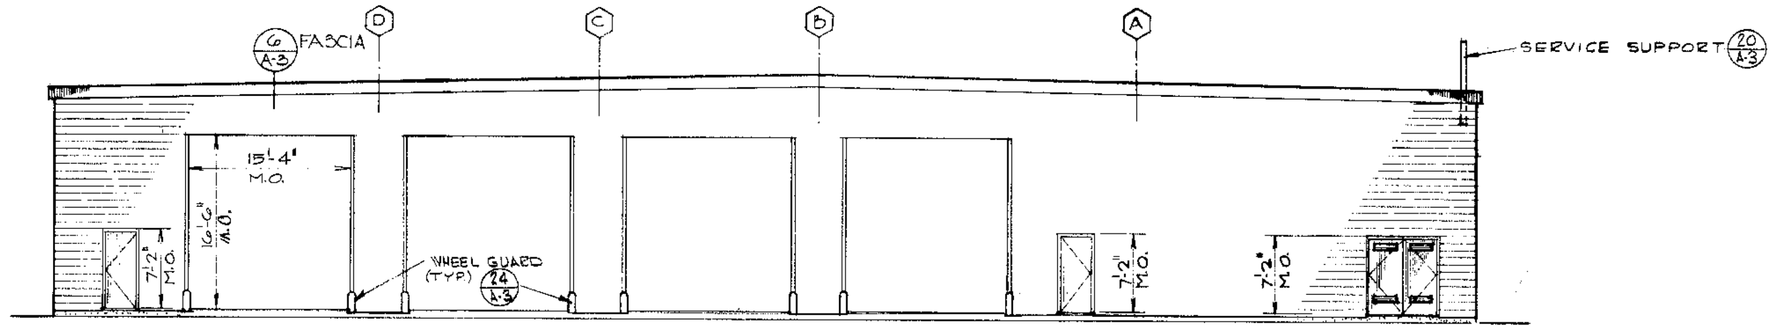

C A-1 EAST ELEVATION (WEST ELEV. SIM. - OPP. HAND)
1/8" = 1'-0"

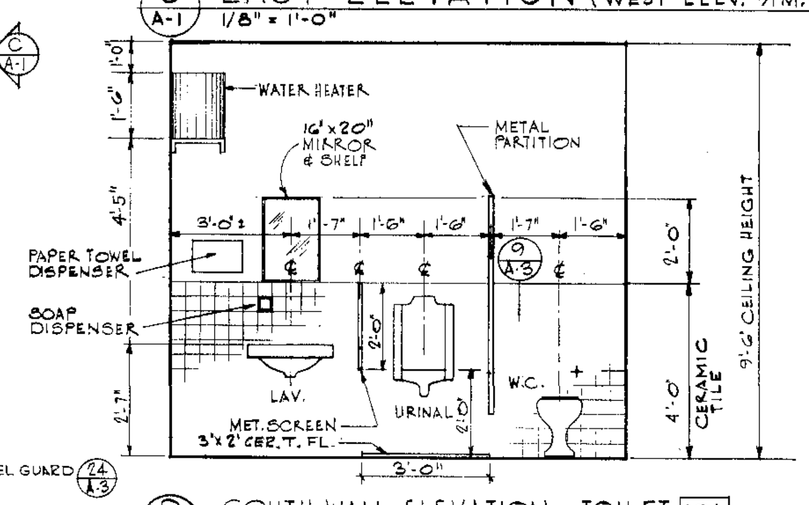

D A-1 SOUTH WALL ELEVATION - TOILET 101
SCALE: 1/2" = 1'-0"

NOTES:

1. LOCATION OF MAN DOORS
2. LOCATION OF GARAGE DOORS

AS-BUILT

WALL TYPES

1. ~~12" CONCRETE BLOCK~~ OMIT
2. 12" CONCRETE BLOCK W/INSULATION ONE SIDE FULL HGT. & 1/2" GYP. BD. WAINSCOT 8'-4" HIGH ONE SIDE
3. 12" CONCRETE BLOCK W/INSULATION ONE SIDE FULL HGT. & 1/4" ASBESTOS-CEMENT BD. WAINSCOT 8'-4" HIGH ONE SIDE
4. 6" METAL STUDS @ 16" O.C. TO EXP. STRUCT. W/5/8" GYP. BD. BOTH SIDES FULL HGT. - 1 HR. FIRE RATED & 1/4" ASBESTOS-CEMENT BD. WAINSCOT 8'-4" HIGH ONE SIDE
5. 12" CONCRETE BLOCK W/INSULATION ONE SIDE FULL HGT. & 1/2" GYP. BD. WAINSCOT 10'-4" HIGH ONE SIDE
6. 6" METAL STUDS @ 16" O.C. TO EXP. STRUCT. W/1/2" GYP. BD. BOTH SIDES FULL HGT. & 1/4" ASBESTOS-CEMENT BD. WAINSCOT 8'-4" HIGH ONE SIDE
7. 6" METAL STUDS @ 16" O.C. TO EXP. STRUCT. W/1/2" GYP. BD. BOTH SIDES FULL HGT. W/INSULATION IN PARTITION CAVITY & 1/4" ASBESTOS-CEMENT BD. WAINSCOT 8'-4" HIGH TWO SIDES
8. 6" METAL STUDS @ 16" O.C. TO 9'-6" CLG. W/1/2" GYP. BD. BOTH SIDES TO 9'-6" CLG.
9. 6" METAL STUDS @ 16" O.C. TO EXP. STRUCT. W/1/2" GYP. BD. BOTH SIDES FULL HGT. W/INSULATION IN PARTITION CAVITY

5 0 10 20
1/8" = 1'-0" GRAPHIC SCALE
1 0 1 2 3 4 5
1/2" = 1'-0" GRAPHIC SCALE

REVISION NO.	DATE	DESCRIPTION	AGENCY	BY

DANIEL, MANN, JOHNSON, & MENDENHALL
PLANNING • ARCHITECTURE • ENGINEERING • SYSTEMS

DEPARTMENT OF AIR FORCE
SPACE & MISSILE SYSTEMS ORGANIZATIONS
NORTON AIR FORCE BASE, CALIFORNIA

DESIGNED BY L.L.G.
DRAWN BY E.A.M.
CHECKED BY D.S.
SUBMITTED BY DATE

A-E SHEET NO. A-1
A-E JOB NO. 201-11-1

MALMSTROM AIR FORCE BASE, MONTANA
PAYLOAD TRANSPORTER ALERT AND READINESS FACILITY

ARCHITECTURAL PLAN, ELEVATIONS & SCHEDULES

APPROVED: DATE
James Barry Proj Eng 10 Feb 70
William E. Pratt SMSD 18 Feb 70

SPECIFICATION NO. 3867
DATE 18 JUN 1970 SCALE AS NOTED
DRAWING NUMBER 33-39-10
SHEET 5

DIST. FILE No. 225-25-01 SHT. 5

1448