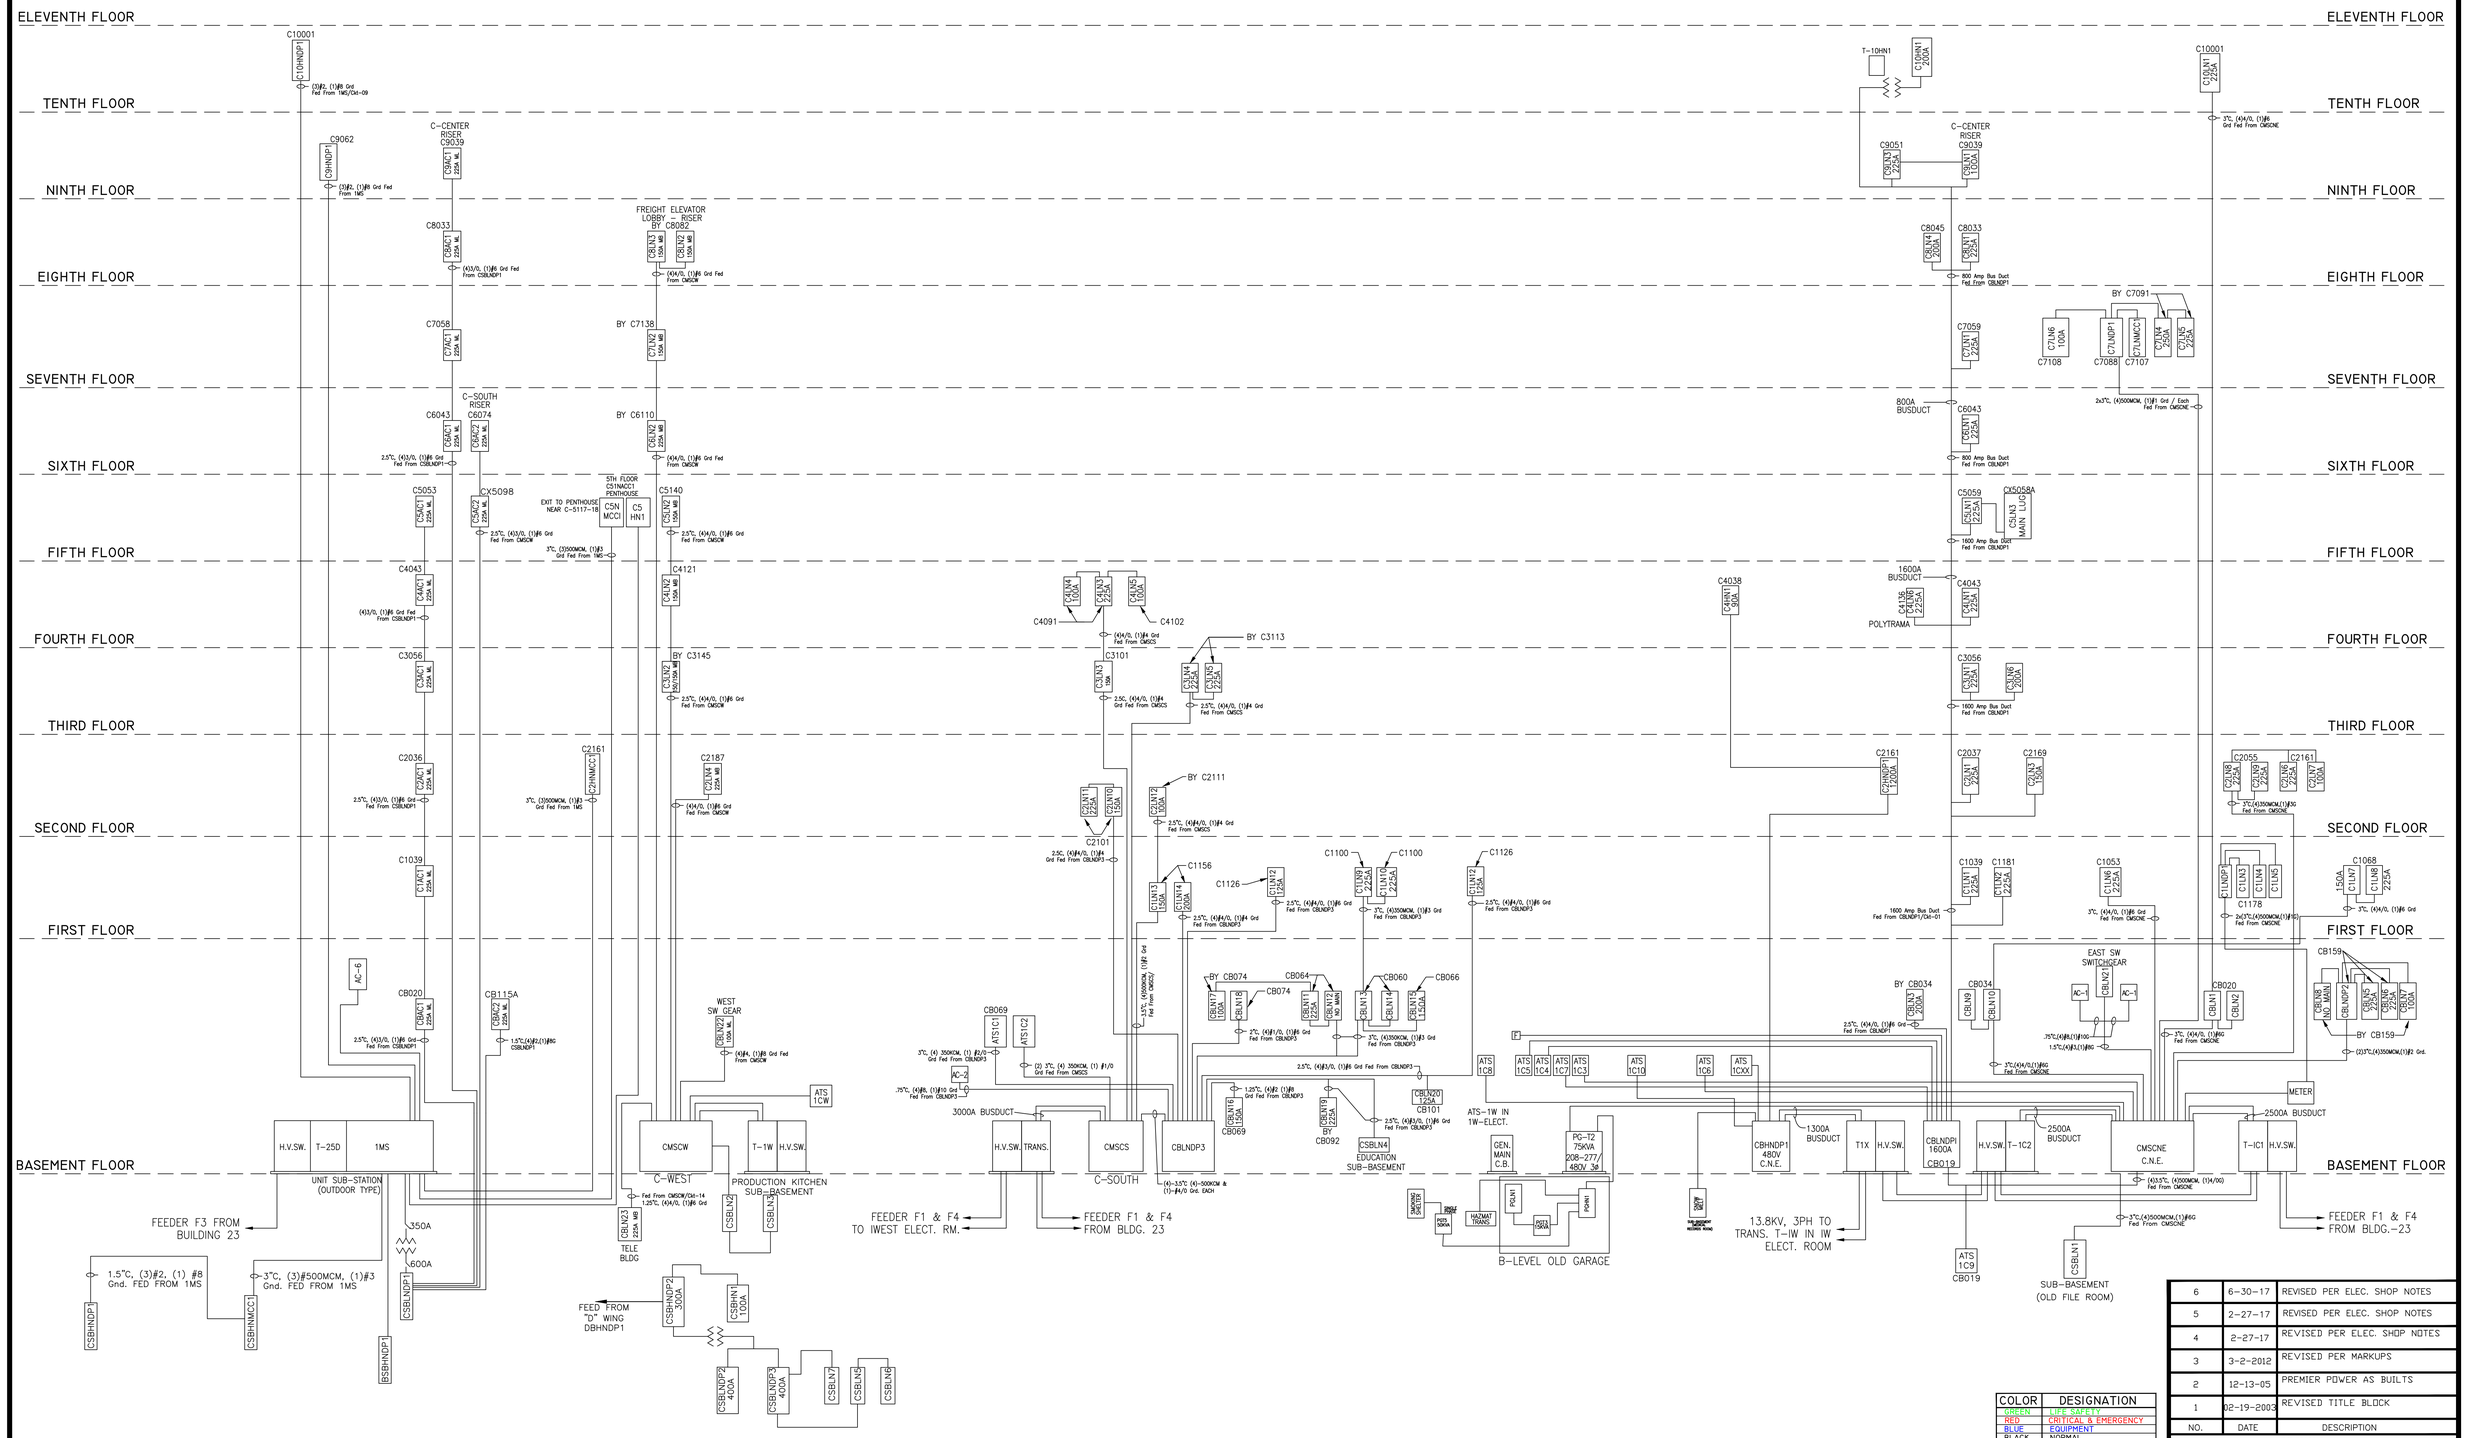

COLOR	DESIGNATION
GREEN	LIFE SAFETY
RED	CRITICAL & EMERGENCY
BLUE	EQUIPMENT
BLACK	NORMAL

EQUIPMENT ID DEFINITION EXAMPLES

ABHCRDPI
- A-WING
- BASEMENT
- HIGH VOLTAGE
- CRITICAL & EMERGENCY
- DISTRIBUTION PANEL
- SEQUENTIAL NUMBER

A4LLSI
- A-WING
- 4TH FLOOR
- LOW VOLTAGE
- LIFE SAFETY
- SEQUENTIAL NUMBER

DRAWING LIST

SHEET 1 OF 9-DISTRIBUTION SYSTEM SCHEMATIC
SHEET 2 OF 9-SINGLE LINE DIAGRAM, BRANCH CIRCUITS, RELAYING
SHEET 3 OF 9-A-WING RISER DIAGRAM, EMERGENCY FEED
SHEET 4 OF 9-A-WING RISER DIAGRAM, NORMAL FEED
SHEET 5 OF 9-B-WING RISER DIAGRAM, EMERGENCY & NORMAL FEED
SHEET 6 OF 9-C-WING RISER DIAGRAM, EMERGENCY FEED
SHEET 7 OF 9-C-WING RISER DIAGRAM, NORMAL FEED
SHEET 8 OF 9-D/E-WING RISER DIAGRAM EMERGENCY & NORMAL FEED
SHEET 9 OF 9-IU SUBSTATION VA SWITCHGEAR

NO.	DATE	DESCRIPTION
6	6-30-17	REVISED PER ELEC. SHOP NOTES
5	2-27-17	REVISED PER ELEC. SHOP NOTES
4	2-27-17	REVISED PER ELEC. SHOP NOTES
3	3-2-2012	REVISED PER MARKUPS
2	12-13-05	PREMIER POWER AS BUILTS
1	02-19-2003	REVISED TITLE BLOCK

REVISIONS

PROJ. TITLE: WIRING DIAGRAM

SHEET TITLE: C-WING RISER DIAGRAM, NORMAL FEED

DEPT. OF VETERANS AFFAIRS
INDIANAPOLIS, INDIANA

Drawn By: V.B.S.	Date: 7-1-2002	NUMBER
Checked By:		
Plot Date: 03/02/12	Scale: N.T.S.	DRAWING No. 7
Service Chief:		
Ass't. Hosp. Dir.:		
Chief Eng.:		7 OF 9
Concur:		Proj.

C-WING RISER DIAGRAM, NORMAL FEED.dwg

1/15/2004