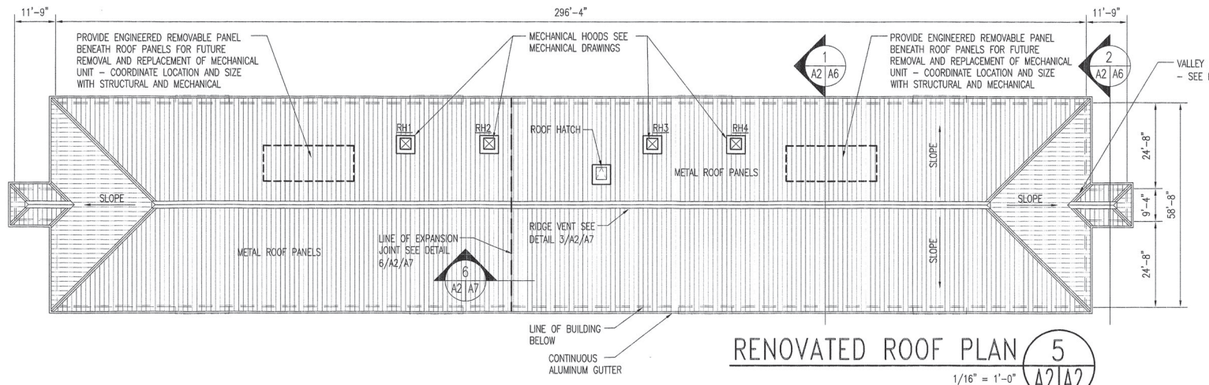

RENOVATED ROOF PLAN 5 A2 A2

1/16" = 1'-0"

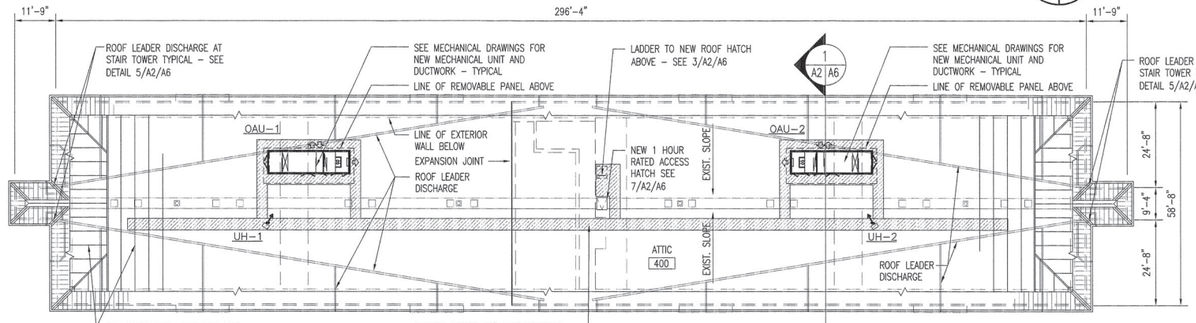

RENOV. ATTIC PLAN 4 A2 A2

1/16" = 1'-0"

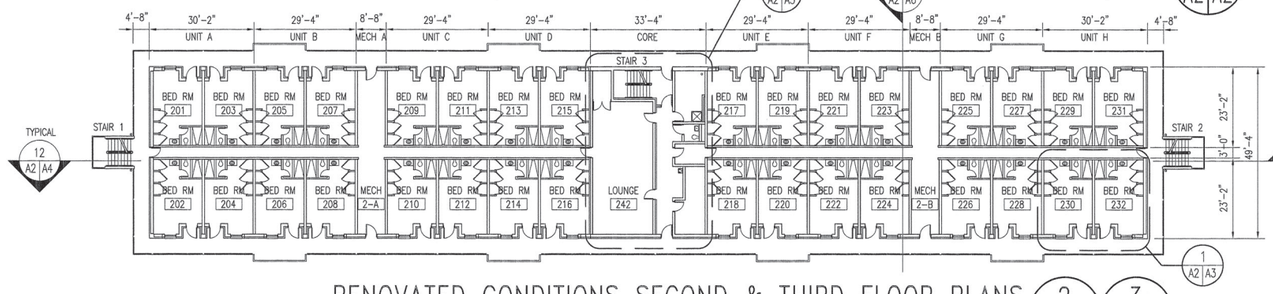

RENOVATED CONDITIONS SECOND & THIRD FLOOR PLANS 2 A2 A2 3 A2 A2

1/16" = 1'-0"

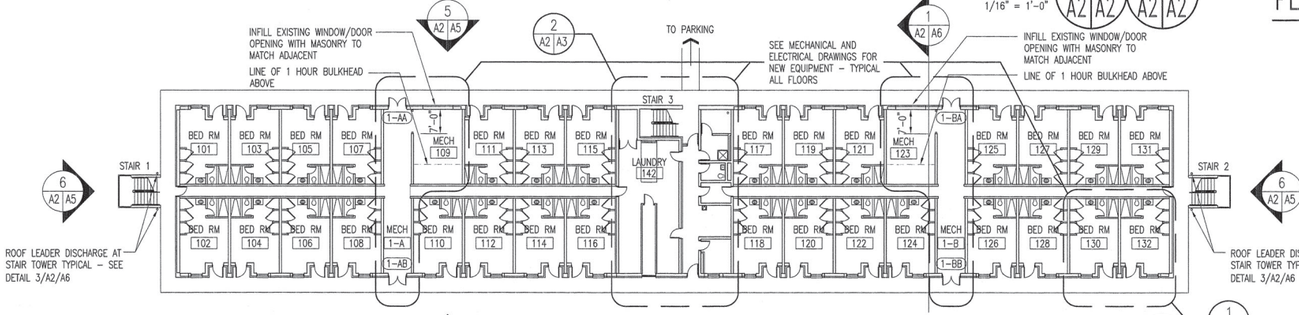

RENOVATED CONDITIONS FIRST FLOOR PLAN 1 A2 A2

1/16" = 1'-0"

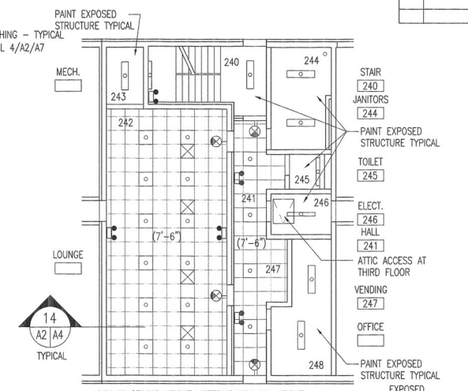

LAY–IN CEILING HEIGHT NOTED IS MINIMUM HEIGHT. INSTALL CEILING HIGHER IF POSSIBLE.

ENLARGED RENOVATED CORE AREA 2ND & 3RD REFLECTED CEILING PLAN 8 A2 A2

1/8" = 1'-0"

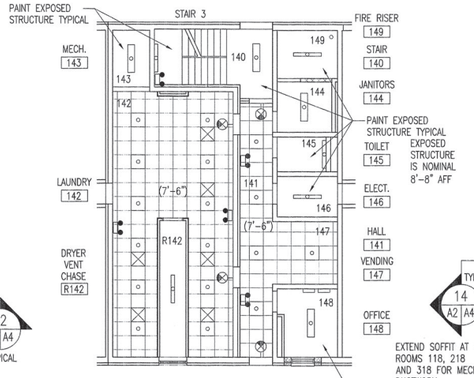

LAY–IN CEILING HEIGHT NOTED IS MINIMUM HEIGHT. INSTALL CEILING HIGHER IF POSSIBLE.

ENLARGED RENOV CORE FIRST FLOOR REFLECTED CEILING PLAN 7 A2 A2

1/8" = 1'-0"

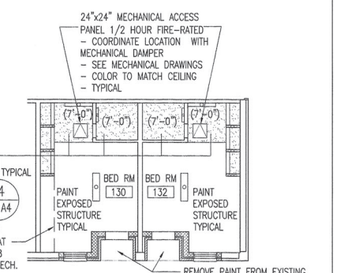

TYPICAL ENLARGED BEDROOM REFLECTED CEILING PLAN 6 A2 A2

TYPICAL ALL BEDROOMS. 1/8" = 1'-0"

CEILING PLAN LEGEND

THIS PLAN SHOWS MAJOR CEILING COMPONENTS FOR THE COORDINATION OF ALL WORK. NOT ALL ITEMS THAT OCCUR ON CEILINGS ARE NECESSARILY SHOWN. SEE MECHANICAL AND ELECTRICAL DRAWINGS FOR MORE INFORMATION.

- EXISTING WALL CONSTRUCTION.
- NEW EXTERIOR WALL CONSTRUCTION.
- NEW 4" OR 6" NOM. CMU WALL CONST.
- (7'-4") GYPSUM BOARD CEILING TYPICAL (CEILING HEIGHT)
- (7'-6") 2x2 LAY–IN CEILING (CEILING HEIGHT)
- LIGHT FIXTURES – SEE ELECTRICAL DRAWINGS
- HVAC AND EXHAUST GRILLES – SEE MECHANICAL DRAWINGS
- EMERGENCY LIGHTING – SEE ELECTRICAL DRAWINGS
- EXIT SIGNS – SEE ELECTRICAL DRAWINGS

CODE DATA

CODE INFORMATION – EVALUATED PER 2006 IBC (2009 NORTH CAROLINA BUILDING CODE):

BUILDING OCCUPANCY IS R–2
BUILDING CONSTRUCTION IS TYPE II–B.
BUILDING IS SPRINKLERED.
MECHANICAL AREAS ARE ONE HOUR FIRE RATED CONSTRUCTION.
STAIR #3 IS TWO HOUR FIRE RATED CONSTRUCTION.
APPROXIMATELY 14,159 SQ.FT. PER FLOOR
THREE STORIES = 42,477 SQ.FT. TOTAL
ORIGINAL CONSTRUCTION COMPLETED IN 1990.

NOTE: SEE ELECTRICAL DRAWINGS FOR GENERAL LIGHTING FOR ALL FLOORS AND ATTIC.

AS BUILT DRAWINGS 12/03/2015

NORTH

1/8" = 1'-0" FEET 0 5 10 15

1/16" = 1'-0" FEET 0 10 20 30

REVISIONS			
SYM.		DATE	APPROVED

TALLEY L. SMITH ARCHITECTURE, REGISTERED ARCHITECTURAL CORPORATION, CERT. NO. 50153, NORTH CAROLINA, SHELBY, N.C.

ROBERT L. SMITH III, REGISTERED ARCHITECT, NORTH CAROLINA, SHELBY, N.C. 4/27/11

SHEET TITLE: RENOVATED FLOOR, ROOF, & REFLECTED CEILING PLANS — A–2

TALLEY & SMITH ARCHITECTURE INC.
P.O. BOX 518 SHELBY, NC 28151–0518
409 EAST MARION ST. SHELBY, NC 28150

DES. Robert L. Smith, III
DR. Robert C. Vail, III
CHK. Robert L. Smith, III
SUBMITTED BY:
DESIGN DIR. Brian R. Marshburn, P.E.
APPROVED: DATE
SATISFACTORY TO: DATE

DEPARTMENT OF THE NAVY — NAVAL FACILITIES ENGINEERING COMMAND
MARINE CORPS BASE
CAMP LEJEUNE, NORTH CAROLINA

REPAIR BEQ M430
MCB, CAMP LEJEUNE, N.C.

SIZE F | CODE IDENT. NO. 80091 | NAVFAC DRAWING NO. 60007956
CONST. CONTR. NO. N40085–10–D–0224
SCALE: NOTED | SPEC. 05–10–0224 | SHEET 6 OF 49

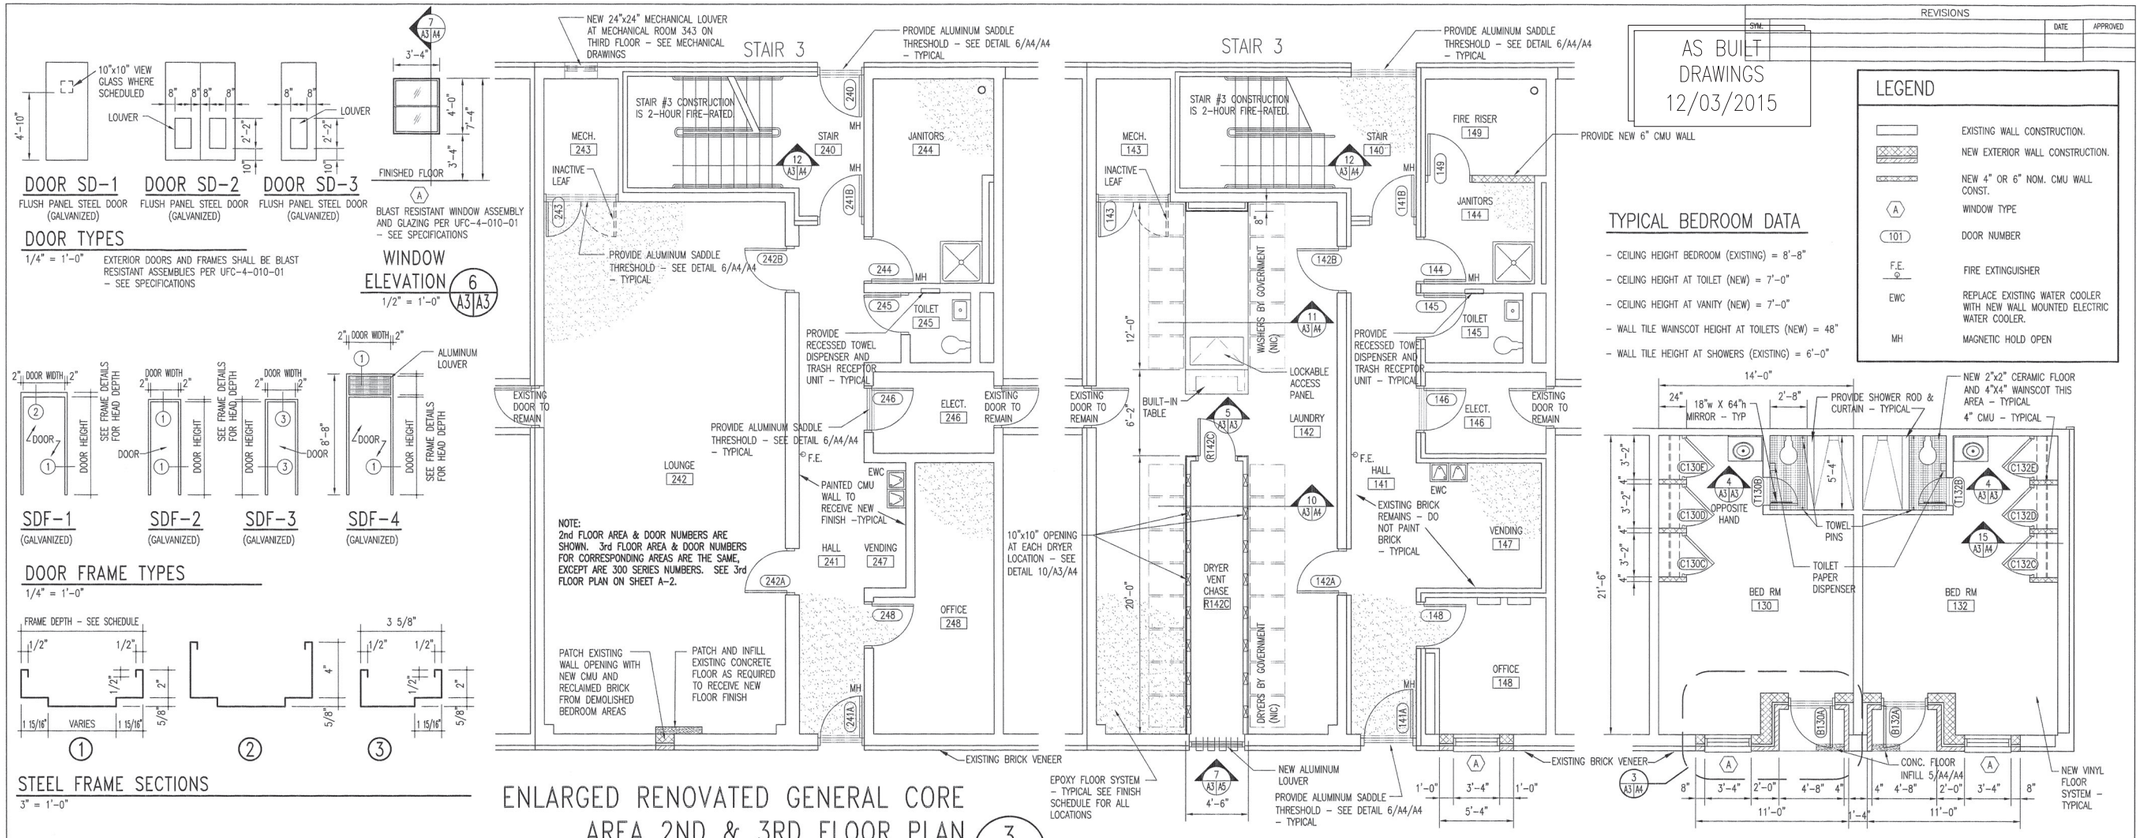

RENOVATED DOOR & FRAME SCHEDULE

(100) — SEE THIS SYMBOL ON FLOOR PLANS FOR CORRESPONDING DOOR NUMBER

	DOOR NO.	DOOR SIZE	DOOR TYPE	GLASS PANEL	HDWR SCHED	FIRE RATING	FRAME TYPE	FRAME DEPTH	LINTEL	UC	THRES DETAIL	REMARKS	DOOR NO.
SAME FOR ALL BEDROOMS	B130A	3-0 x 7-0	SD-1	–	01	–	SDF-1	6 3/4"	SEE DETAIL 3/A3/A4	–	6/A4/A4	TYPICAL ALL BED ROOMS	B130A
	T130B	2-0 x 6-8	SD-1	–	02	–	SDF-2	6 7/8"	EXISTING 8/A4/A4	1"	–	TYPICAL ALL BED ROOMS	T130B
	C130C	2-10 x 6-8	SD-3	–	03	–	SDF-3	3 5/8"	SEE DETAIL 9/A4/A4	–	–	TYPICAL ALL BED ROOMS	C130C
	C130D	2-10 x 6-8	SD-3	–	03	–	SDF-3	3 5/8"	SEE DETAIL 9/A4/A4	–	–	TYPICAL ALL BED ROOMS	C130D
	C130E	2-10 x 6-8	SD-3	–	04	–	SDF-3	3 5/8"	SEE DETAIL 9/A4/A4	–	–	TYPICAL ALL BED ROOMS	C130E
SAME FOR THIRD FLOOR	141A	3-6 x 6-8	SD-1	–	05	–	SDF-2	6 3/4"	EXISTING	–	6/A4/A4	PROVIDE MAGNETIC HOLD OPEN	141A
	141B	3-0 x 6-8	SD-1	10"x10"	07	1 HR	SDF-2	8 3/4"	EXISTING	–	–	PROVIDE MAGNETIC HOLD OPEN	141B
	142A	3-0 x 6-8	SD-1	–	08	20 MIN	SDF-2	9 1/8"	EXISTING	–	–	–	142A
	142B	3-0 x 6-8	SD-1	–	08	20 MIN	SDF-2	9 1/8"	EXISTING	–	–	–	142B
	R142C	3-0 x 6-8	SD-1	–	09	–	SDF-2	4 1/2"	STEEL STUD HEADER	–	–	–	142D
	143	PR. 2-6x6-8	SD-2	–	10	20 MIN	SDF-2	6 3/4"	EXISTING	–	–	PROVIDE LOUVERS IN DOORS	143
	144	3-0 x 6-8	SD-3	–	11	20 MIN	SDF-2	8 3/4"	EXISTING	–	–	PROVIDE MAGNETIC HOLD OPEN	144
	145	3-0 x 6-8	SD-1	–	12	–	SDF-2	8 3/4"	EXISTING	1"	–	–	145
	146	3-0 x 6-8	SD-1	–	13	–	SDF-2	8 3/4"	EXISTING	1"	6/A4/A4	–	146
	148	3-0 x 6-8	SD-1	–	14	–	SDF-2	8 3/4"	EXISTING	1"	–	–	148
	149	3-0 x 6-8	SD-3	–	13	–	SDF-2	6 3/4"	SEE DETAIL 8/A4/A4	–	–	–	149
	1-AA	PR. 2-6x6-8	SD-2	–	15	–	SDF-4	6 3/4"	SEE DETAIL 4/A3/A4	–	6/A4/A4	NEW MECH ROOM 1-A DOORS	1-AA
	1-AB	PR. 2-6x6-8	SD-2	–	15	–	SDF-4	6 3/4"	SEE DETAIL 4/A3/A4	–	6/A4/A4	NEW MECH ROOM 1-A DOORS	1-AB
	1-BA	PR. 2-6x6-8	SD-2	–	15	–	SDF-4	6 3/4"	SEE DETAIL 4/A3/A4	–	6/A4/A4	NEW MECH ROOM 1-B DOORS	1-BA
	1-BB	PR. 2-6x6-8	SD-2	–	15	–	SDF-4	6 3/4"	SEE DETAIL 4/A3/A4	–	6/A4/A4	NEW MECH ROOM 1-B DOORS	1-BB
	240	3-0 x 6-8	SD-1	10"x10"	06	1 HR	SDF-2	6 3/4"	EXISTING	–	6/A4/A4	PROVIDE MAGNETIC HOLD OPEN	240
	241A	3-0 x 6-8	SD-1	10"x10"	06	–	SDF-2	6 3/4"	EXISTING	–	6/A4/A4	PROVIDE MAGNETIC HOLD OPEN	241A
	241B	3-0 x 6-8	SD-1	10"x10"	07	1 HR	SDF-2	8 3/4"	EXISTING	–	–	PROVIDE MAGNETIC HOLD OPEN	241B
	242A	3-0 x 6-8	SD-1	–	16	–	SDF-2	9 1/8"	EXISTING	1"	–	–	242A
	242B	3-0 x 6-8	SD-1	–	16	–	SDF-2	9 1/8"	EXISTING	1"	–	–	242B
	243	PR. 3-0x6-8	SD-2	–	10	–	SDF-2	8 3/4"	EXISTING	–	–	PROVIDE LOUVERS IN DOORS	243
	*244	3-0 x 6-8	SD-3	–	11	20 MIN	SDF-2	8 3/4"	EXISTING	–	–	*PROVIDE MAGNETIC HOLD OPEN	244
	245	2-8 x 6-8	SD-1	–	12	–	SDF-2	8 3/4"	EXISTING	1"	–	–	245
	246	3-0 x 6-8	SD-1	–	13	–	SDF-2	8 3/4"	EXISTING	1"	6/A4/A4	–	246
	248	3-0 x 6-8	SD-1	–	14	–	SDF-2	8 3/4"	EXISTING	1"	–	–	248

NOTES:
– DOORS AND FRAMES B130, T130 AND C130 SCHEDULED ABOVE ARE TYPICAL FOR EACH BED ROOM IN THIS PROJECT ON ALL FLOORS – SEE DETAILS 8/A4/A4 AND 9/A4/A4 FOR FRAME POSITIONING. SEE PLAN ON SHEET A-2 TO VERIFY DOOR SWINGS.
– DOORS AND FRAMES 240 THRU 248 SCHEDULED ABOVE ARE TYPICAL FOR SECOND AND THIRD FLOOR DOORS AND FRAMES TO BE REPLACED IN THIS PROJECT. SEE PLAN ON SHEET A-2 TO VERIFY DOOR SWINGS.
* DO NOT PROVIDE MAGNETIC HOLD OPEN AT THIRD FLOOR JANITORS ROOM.
– FOR DOORS AND FRAMES NOT CALLED OUT ON SCHEDULE THAT SERVE MECHANICAL ROOMS AND PIPE CHASES: CLEAN, REPAIR, PRIME AND PAINT – TYPICAL ALL DOORS NOT CALLED OUT ON SCHEDULE. APPROXIMATELY 24 DOORS AND FRAMES – VERIFY.

NEW FINISH SCHEDULE BUILDING M430

(100) — SEE THIS SYMBOL ON FLOOR PLANS FOR CORRESPONDING ROOM NUMBER

	ROOM NO.	ROOM NAME	FLOOR: EPOXY RESIN FLOORING	FLOOR: LAMINATE VINYL FLOORING	FLOOR: 2x2 CERAMIC TILE	FLOOR: EXISTING CONCRETE	BASE: 4" COVED RUBBER BASE	BASE: NO. BASE	WALL: 4x4 CERAMIC TILE WSCOT	WALL: ACRYLIC TEXTURE COATING	CEILING: PAINT	CEILING: ACOUSTICAL CEILING TILE	CEILING HT.	REMARKS	ROOM NO.
ALL BEDROOMS	130	TYPICAL BEDROOM		*			*			*		*	8'-8" +/–	BEDROOMS AND CLOSETS	130
	T130	TYPICAL BEDRM. TOILET			*			*	*	*		*	7'-4" +/–	PROVIDE "SILTANIUM" OR EQUAL OVER NEW TILE FLOOR & UP WALLS 12" FROM FLOOR TYPICAL	T130
	T130A	TYPICAL BEDRM. SHOWER	EXISTING REMAINS UNLESS NOTED OTHERWISE									*		SEE NOTE BELOW FOR SHOWER FLOOR SEALANT	T130A
ALL BEDROOMS	140	STAIR 1, 2, & 3	*					*	EXISTING BRICK		*		VARIES	DO NOT PROVIDE COATING ON BRICK	140
	141	HALL	*					*		*		*	7'-6" +/–	DO NOT PROVIDE COATING ON BRICK, FIRST FLR	141
	142	LAUNDRY/LOUNGE	*					*		*		*	7'-6" +/–	LAUNDRY IS ON FIRST FLOOR ONLY	142
	142D	DRYER VENT CHASE				*		*					–	NO CEILING IN THIS AREA – EXPOSED	142A
	143	MECH.				*		*			*	*	–	–	143
	144	JANITORS	*					*			*	*	–	–	144
	145	TOILET	*					*		*		*	–	REMOVE EXISTING AND PROVIDE NEW PAPER HOLDER. INSTALL IN SAME LOCATION.	145
	146	ELECT.	*			*		*			*	*	–	–	146
	147	VENDING	*					*		*			7'-6" +/–	DO NOT PROVIDE COATING ON BRICK, FIRST FLR	147
	148	OFFICE	*					*		*		*	8'-8" +/–	–	148
	149	FIRE RISER				*		*			*	*	8'-8" +/–		149

NOTES:
– FINISHES SCHEDULED ABOVE ARE TYPICAL FOR EACH GENERAL CORE AREA ON ALL FLOORS AND FOR ALL BEDROOMS IN THIS PROJECT. SECOND AND THIRD FLOOR CORE AREAS RECEIVE SAME FINISHES AS FIRST FLOOR UNLESS NOTED OTHERWISE.
– PROVIDE NEW GROUT IN SHOWERS IN BEDROOMS 206 & 208 AND INSPECT ALL EXISTING SHOWERS AT BEDROOMS FOR AREAS THAT REQUIRE NEW GROUT. INCLUDE TO PROVIDE 1 SF OF REPAIRS IN EACH BEDROOM. SEAL ALL SHOWER FLOORS AND CERAMIC TILE BATHROOM FLOORS AND 12" UP WALLS WITH "SILTANIUM" SEALANT OR EQUAL.
– PROVIDE NEW TOILET PAPER DISPENSER @ 24" MIN. ABOVE FLOOR, AND 2 TOWEL PINS (ROBE HOOKS) IN EACH BEDROOM TOILET AS SHOWN IN 1/A2/A3. MOUNT AT 60" ABOVE FINISHED FLOOR.
– PROTECT ALL EXISTING WALL MURALS DURING CONSTRUCTION AND PAINTING – TYPICAL UNLESS OTHERWISE DIRECTED BY BASE. PROVIDE 3" PAINTED BAND OR RAISED PAINTED WOOD TRANSITION FRAME AROUND EXISTING MURALS.

ENLARGED RENOVATED GENERAL CORE FIRST FLOOR PLAN

2 | A2|A3 — 1/4" = 1'-0"

TYPICAL ENLARGED RENOVATED BED ROOM FLOOR PLAN

1 | A2|A3 — 1/4" = 1'-0"

TYPICAL ALL BEDROOMS.

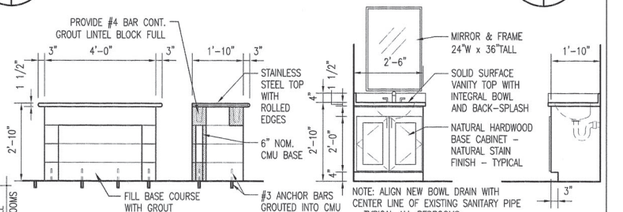

BUILT-IN TABLE

5 | A3|A3 — 1/2" = 1'-0"

TYPICAL CASEWORK

4 | A3|A3 — 1/2" = 1'-0"

1/4" = 1'-0" FEET 0 5 10
1/2" = 1'-0" FEET 0 1 2 3 4 5
3" = 1'-0" FEET 0 3 6 12

TALLEY & SMITH ARCHITECTURE, INC. REGISTERED ARCHITECTURE ENGINEERING SHELBY, NORTH CAROLINA CERT. NO. 50153

ROBERT L. SMITH III REGISTERED ARCHITECT SEAL 6102 NORTH CAROLINA SHELBY, N.C. 4/27/16

SHEET TITLE: ENLARGED PLANS & SCHEDULES — A–3

TALLEY & SMITH ARCHITECTURE INC.
P.O. BOX 518 SHELBY, NC 28151–0518
409 EAST MARION ST. SHELBY, NC 28150

DEPARTMENT OF THE NAVY — NAVAL FACILITIES ENGINEERING COMMAND
MARINE CORPS BASE
CAMP LEJEUNE, NORTH CAROLINA

DES. Robert L. Smith, III
DR. Robert C. Vail, III
CHK. Robert L. Smith, III
SUBMITTED BY:
DESIGN DIR. Brian R. Marshburn, P.E.
APPROVED: DATE
SATISFACTORY TO: DATE

REPAIR BEQ M430
MCB, CAMP LEJEUNE, N.C.

SIZE F | CODE IDENT. NO. 80091 | NAVFAC DRAWING NO. 60007957
CONST. CONTR. NO. N40085–10–D–0224
SCALE: NOTED | SPEC. 05–10–0224 | SHEET 7 OF 49