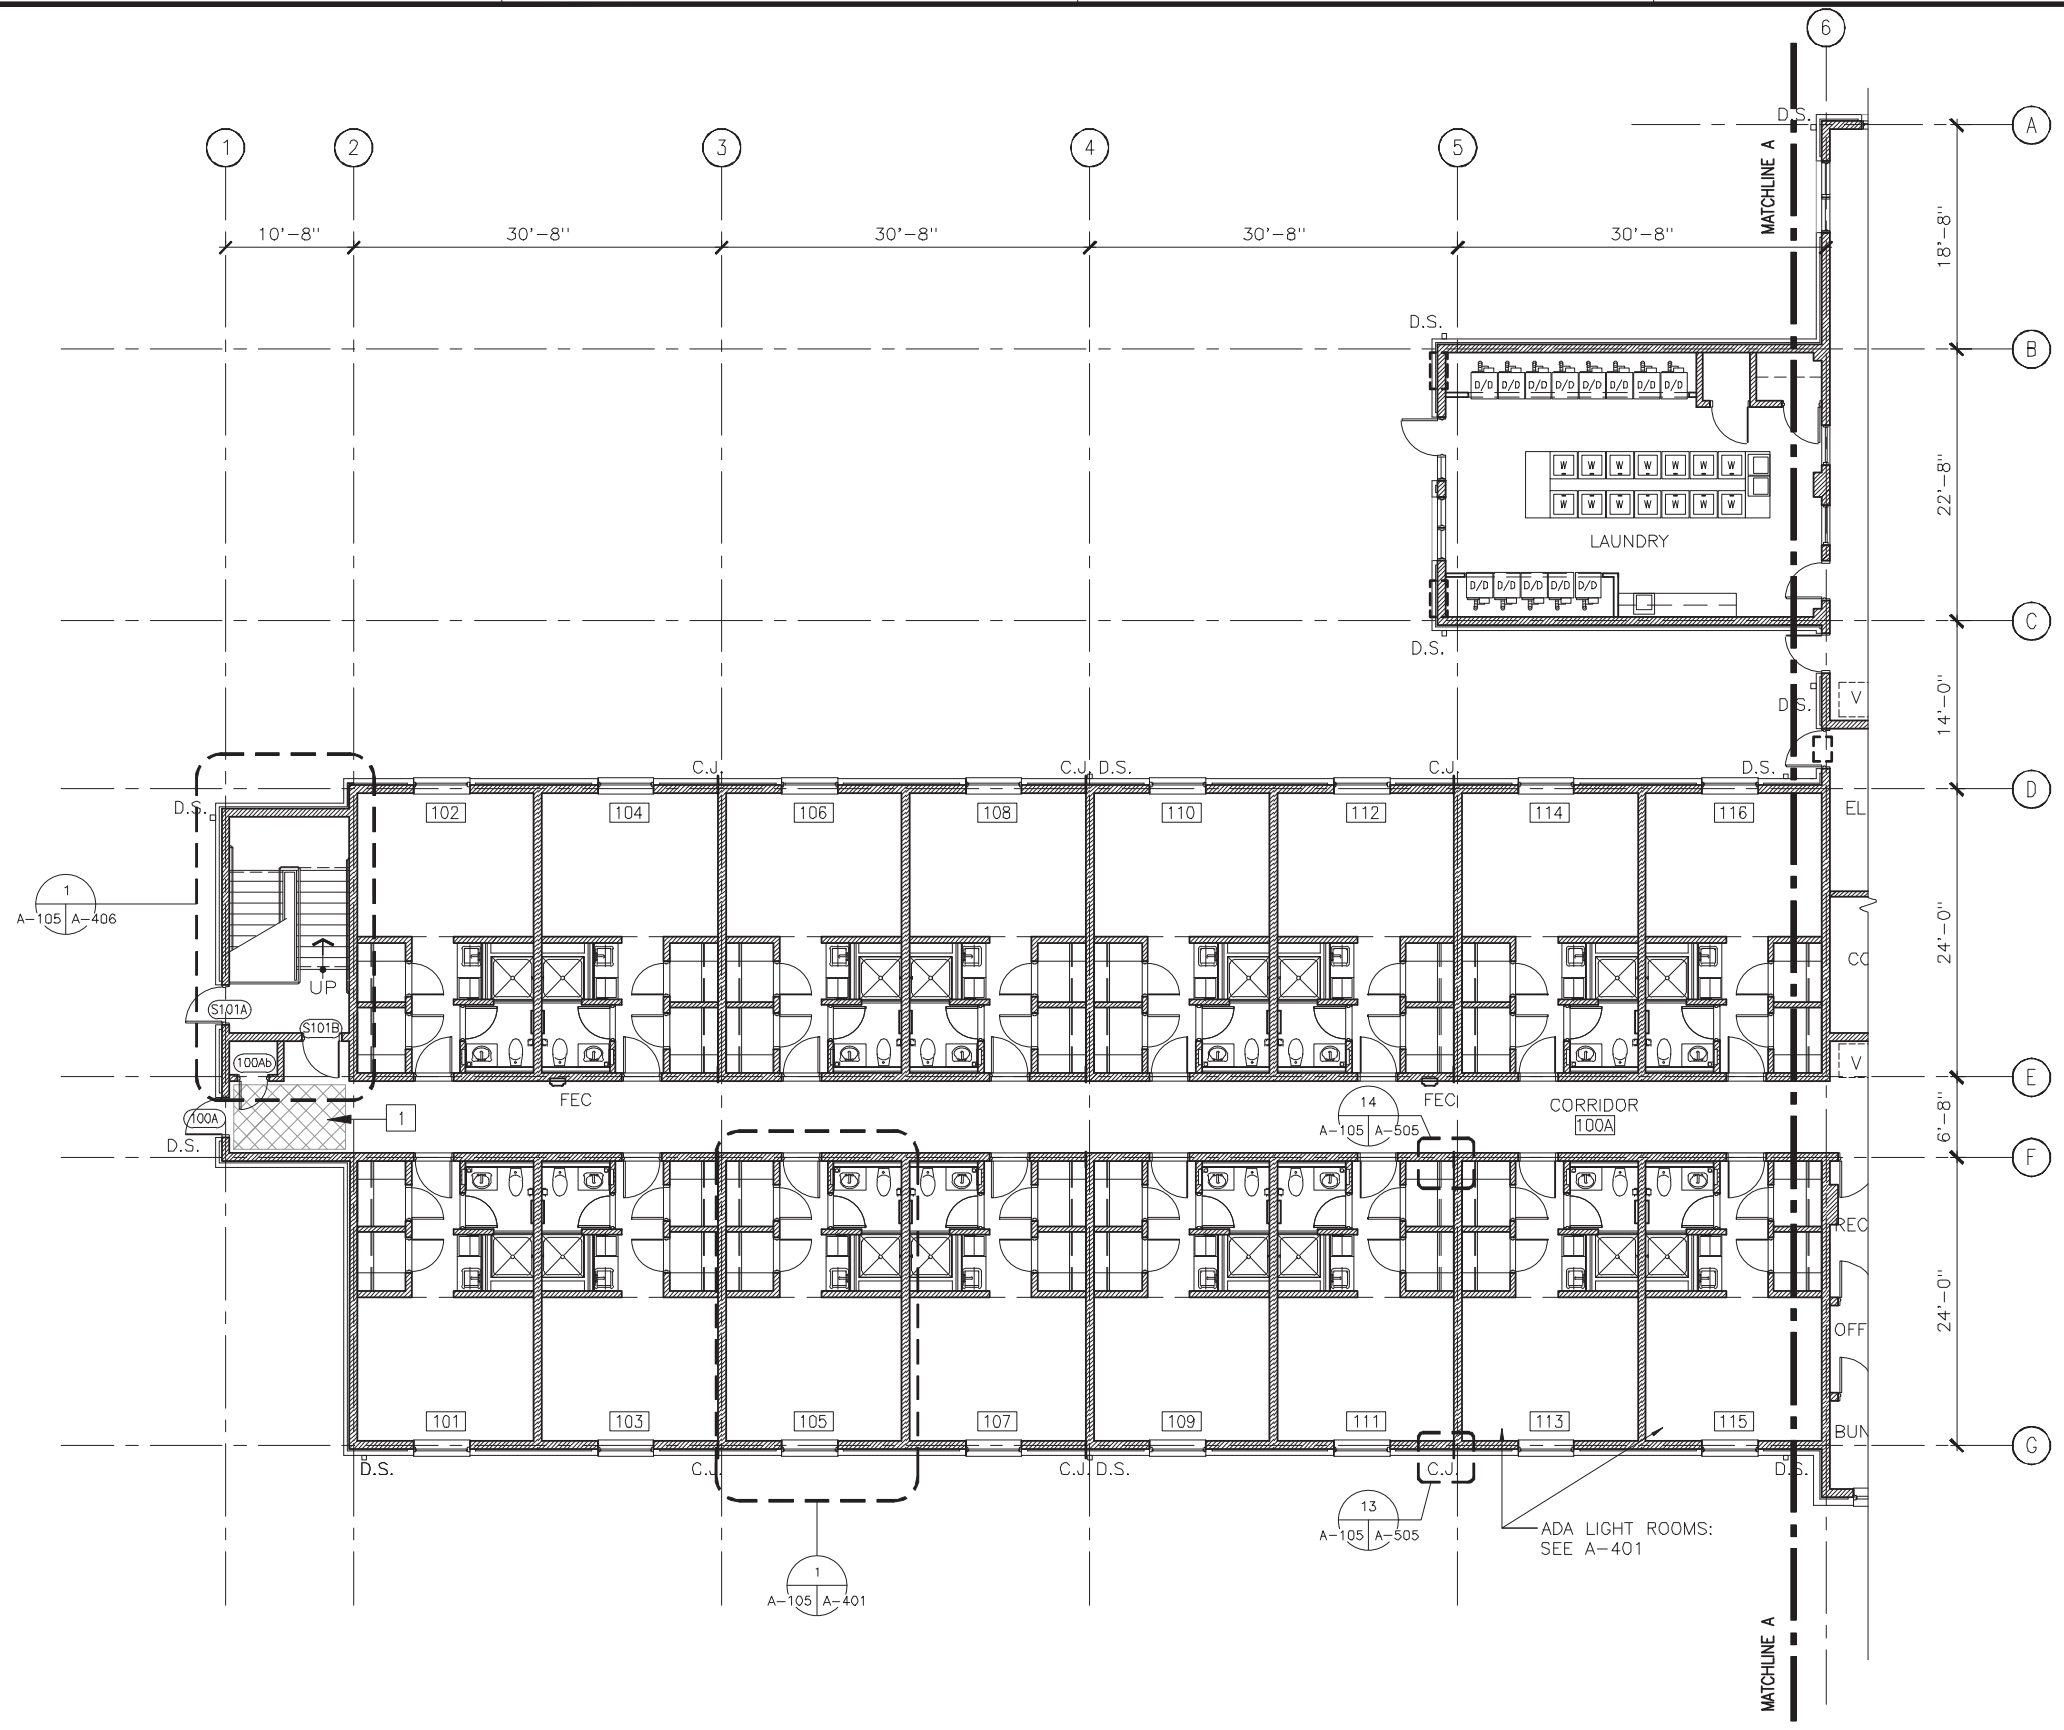

FIRST FLOOR
ENLARGED LEFT WING PLAN
A101 A105 SCALE: SCALE 1/8" = 1'-0"

AS-BUILT

ENLARGED AREA KEYNOTES

1 RECESSED FLOOR MAT WITH ALUMINUM FRAME: SEE 2/A-509

LEGEND

XXX	INDICATES DOOR TYPE – SEE SHEET A-601 FOR DOOR SCHEDULE
X	INDICATES WINDOW OR LOUVER TYPE – SEE SHEET A-601 FOR DOOR AND A-602 FOR LOUVER SCHEDULE
	CMU WALL
	METAL STUD WALL
D.S.	INDICATES DOWNSPOUT
X	INDICATES WALL TYPE – SEE SHEET A-501
C.J.	INDICATES EXTERIOR CMU/ BRICK CONTROL JOINT LOCATIONS: SEE 13,14/A-505
FEC	INDICATES FIRE EXTINGUISHER CABINET: SEE LS SHEETS FOR EXACT TYPE AND LOCATION

GENERAL NOTES

1. SEE SHEET A-401 FOR TYPICAL ROOM MODULE PLAN.
2. SEE SHEET A-117 – A-122 FOR REFLECTED CEILING PLANS.
3. SEE SHEET A-501 FOR TYPICAL FIRE STOPPING DETAILS.
4. SEE SHEET I-001/I-601 FOR FINISH SCHEDULE.
5. SEE SHEET A-601 – A-602 FOR DOOR AND WINDOW TYPES FOR TYPICAL ROOM MODULE.
6. SEE SHEET A-501 FOR WALL TYPE DESIGNATIONS AT TYPICAL ROOM MODULE.
7. FIRE EXTINGUISHER LOCATIONS FOR REFERENCE ONLY, SEE LS SHEETS FOR EXACT LOCATION AND TYPE
8. SEE SHEET A-123 FOR CMU DIMENSION PLAN

KEY PLAN

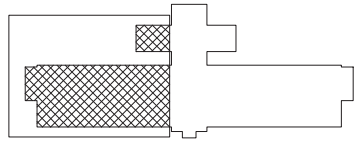

0 5' 15' 25'
2' 10'
SCALE 1/8" = 1'-0" (1 : 96)

RECORD DRAWING
AS-BUILT – 21 FEBRUARY 2012

NAVFAC

BOBBY CANADY
08/06/10

DES	DRW
CHK	
<<PM/DM>>	–
BRANCH MANAGER	–
CHIEF ENG/ARCH	–
<<XX>>	–

DEPARTMENT OF THE NAVY
NAVAL FACILITIES ENGINEERING COMMAND
MARINE CORPS NORTH CAROLINA IPT

NAVAL FACILITIES ENGINEERING COMMAND – MID-ATLANTIC
<<NAVAL STATION – NORFOLK, VIRGINIA>>

JACKSONVILLE, NORTH CAROLINA
MCB CAMP LEJEUNE

FY09 BACHELOR ENLISTED QUARTERS
CAMP JOHNSON P-1011 P-1016

PARTIAL FIRST FLOOR PLAN – LEFT WING

SCALE: AS INDICATED
EPROJECT NO.: –
CONSTR. CONTR. NO.: N40085-09-R-3215
NAVFAC DRAWING NO.: 12564402
SHEET 76 OF 270

A-105

21 FEBRUARY 2012 CAMP JOHNSON RECORD DRAWINGS

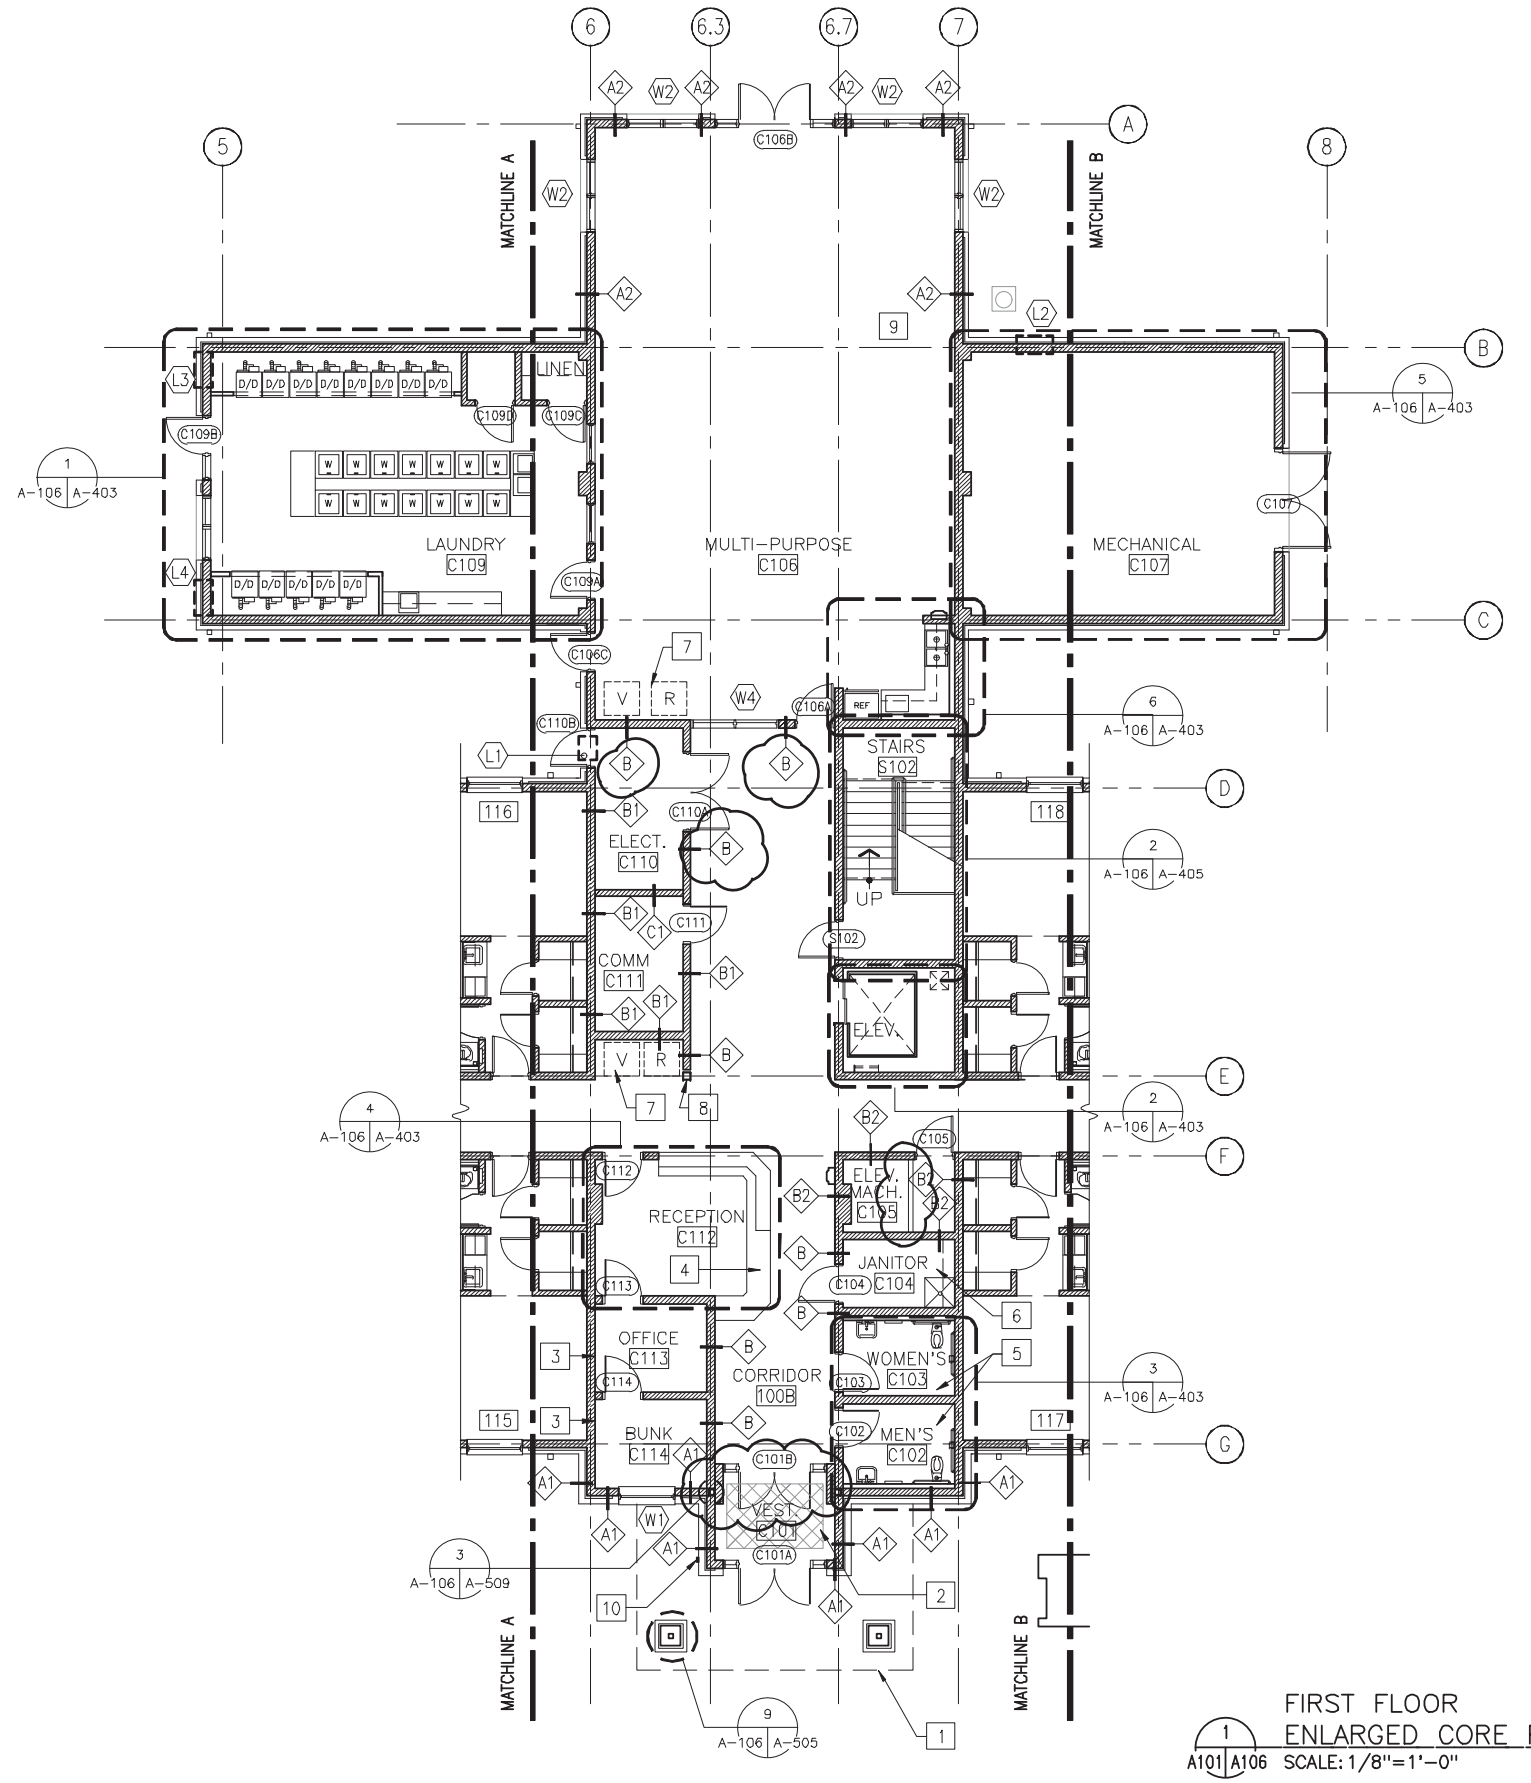

FIRST FLOOR
ENLARGED CORE PLAN
A101 A106 SCALE: 1/8"=1'-0"

AS-BUILT CONDITIONS SHOWN

ENLARGED CORE AREA KEYNOTES

1. COVERED ENTRY AREA: SEE 3/A-409
2. RECESSED ENTRY MAT WITH ALUMINUM FRAME: SEE 2/A-509
3. 5'X3' MARKER BOARD (BARRACK'S MANAGERS OFFICE)
4. SOLID SURFACE CHECK-IN COUNTER W/ BUILT IN DESK
5. SINGLE OCCUPANCY TOILET: ACCES. TO INCLUDE:
   1. TOILET TISSUE DISPENSER
   2. WALL MIRROR W/ INTEGRAL SHELF
   3. COMBINATION UNIT PAPER TOWEL DISPENSER/DISPOSAL
   4. SOAP DISPENSER
   5. GRAB BARS
6. JANITOR'S CLOSET W/ MOP SINK AND METAL SHELVING AND SMOKE PARTITION: SEE 1c/A-501
7. VENDING MACHINES/ RECYCLE BINS
8. STEEL TUBE PER STRUCTURAL: PAINT TO MATCH ADJACENT WALL
9. (2) 8' x 4' MARKER BOARDS TO BE LOCATED IN MULTI PURPOSE ROOM: SEE INTERIOR DESIGN SHEETS FOR LOCATIONS
10. KNOX BOX: TOP OF BOX TO BE LOCATED 4'-6" A.F.F.

LEGEND

XXX	INDICATES DOOR TYPE – SEE SHEET A-601 FOR DOOR SCHEDULE
X	INDICATES WINDOW OR LOUVER TYPE – SEE SHEET A-601 FOR DOOR AND A-602 FOR LOUVER SCHEDULE
	CMU WALL
	METAL STUD WALL
D.S.	INDICATES DOWNSPOUT
X	INDICATES WALL TYPE – SEE SHEET A-501
C.J.	INDICATES EXTERIOR CMU/ BRICK CONTROL JOINT LOCATIONS: SEE 13,14/A-505
D FEC	INDICATES FIRE EXTINGUISHER CABINET: SEE LS SHEETS FOR EXACT TYPE AND LOCATION

GENERAL NOTES

1. SEE SHEET A-401 FOR TYPICAL ROOM MODULE PLAN.
2. SEE SHEET A-117 – A-122 FOR REFLECTED CEILING PLANS.
3. SEE SHEET A-501 FOR TYPICAL FIRE STOPPING DETAILS.
4. SEE SHEET I-001/I-601 FOR FINISH SCHEDULE.
5. SEE SHEET A-601 – A-602 FOR DOOR AND WINDOW TYPES FOR TYPICAL ROOM MODULE.
6. SEE SHEET A-501 FOR WALL TYPE DESIGNATIONS AT TYPICAL ROOM MODULE.
7. 7. FIRE EXTINGUISHER LOCATIONS FOR REFERENCE ONLY, SEE LS SHEETS FOR EXACT LOCATION AND TYPE
8. SEE SHEET A-124 FOR CMU DIMENSION PLAN

KEY PLAN

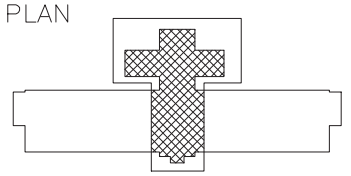

0 2' 5' 10' 15' 25'

SCALE 1/8" = 1'-0" (1 : 96)

RECORD DRAWING
AS-BUILT – 21 FEBRUARY 2012

NAVFAC

BOBBY CANADY

08/06/10

DES | DRW | CHK

<<PM/DM>> –
BRANCH MANAGER –
CHIEF ENG/ARCH –
<<XX>> –

DEPARTMENT OF THE NAVY
NAVAL FACILITIES ENGINEERING COMMAND
MARINE CORPS NORTH CAROLINA IPT

NAVAL FACILITIES ENGINEERING COMMAND ~ MID-ATLANTIC
<<NAVAL STATION – NORFOLK, VIRGINIA>>

MCB CAMP LEJEUNE

JACKSONVILLE, NORTH CAROLINA

FY09 BACHELOR ENLISTED QUARTERS
CAMP JOHNSON P-1011 P-1016

PARTIAL FIRST FLOOR PLAN – CORE

SCALE: AS INDICATED
EPROJECT NO.. –
CONSTR. CONTR. NO. N40085-09-R-3215
NAVFAC DRAWING NO. 12564403
SHEET 77 OF 270

A-106

21 FEBRUARY 2012 CAMP JOHNSON RECORD DRAWINGS

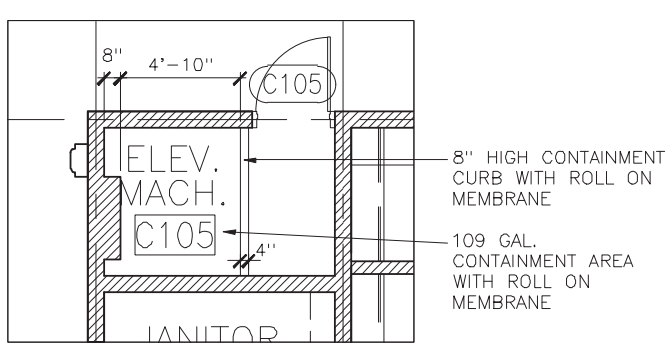

3569 5th Avenue
San Diego, CA 92103
FAX (619) 298-7470
(619) 298-3480

EDWARD JOHN CASS
REGISTERED
No. C11912
ARCHITECT
STATE OF CALIFORNIA

PROJECT NAME: FY09 11 BEQ CAMP LEJEUNE		CSCA PROJECT # 09-18
DRAWING: CONTAINMENT CURB AT ELEVATOR EQUIPMENT ROOM		ASI # 25
DESIGN/BUILD CONTRACTOR: ARCHER WESTERN/ RQ JOINT VENTURE	SCALE 1/4"= 1'-0"	DATE: 09/06/11

PARTIAL FIRST FLOOR PLAN – CORE

77

12564403

A-106

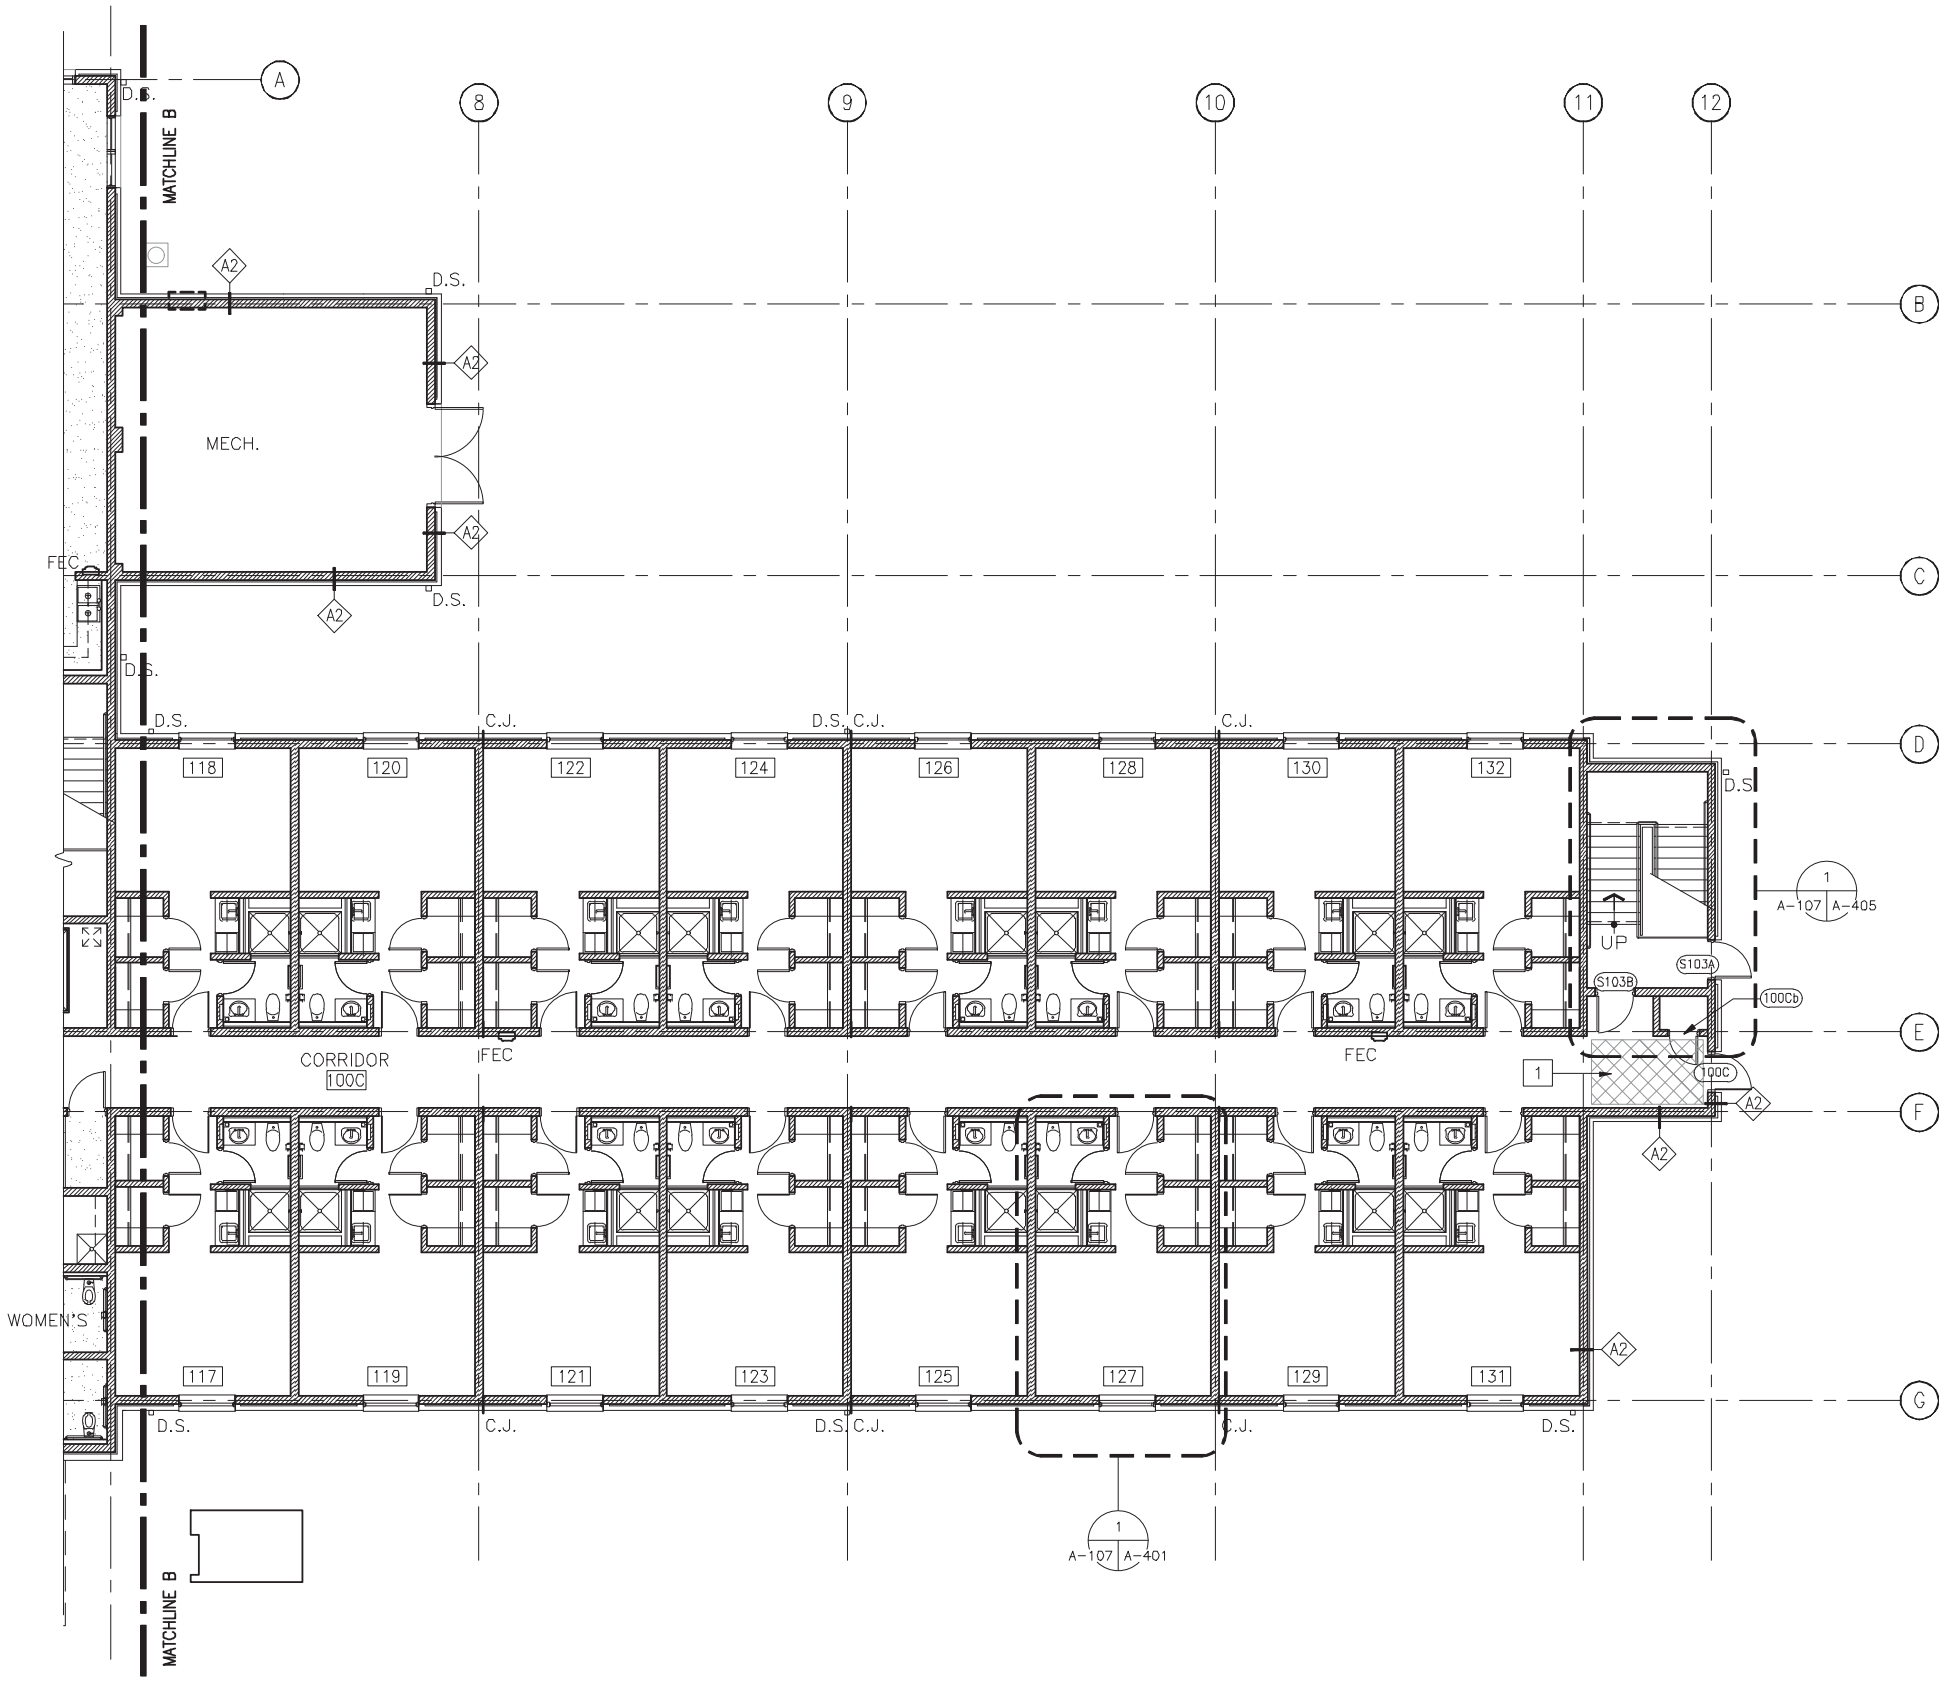

FIRST FLOOR
ENLARGED RIGHT WING PLAN
SCALE: 1/8" = 1'-0"

AS-BUILT

ENLARGED AREA KEYNOTES

1 RECESSED FLOOR MAT WITH ALUMINUM FRAME: SEE 2/A-509

LEGEND

XXX	INDICATES DOOR TYPE – SEE SHEET A-601 FOR DOOR SCHEDULE
X	INDICATES WINDOW OR LOUVER TYPE – SEE SHEET A-601 FOR DOOR AND A-602 FOR LOUVER SCHEDULE
	CMU WALL
	METAL STUD WALL
D.S.	INDICATES DOWNSPOUT
X	INDICATES WALL TYPE – SEE SHEET A-501
C.J.	INDICATES EXTERIOR CMU/ BRICK CONTROL JOINT LOCATIONS: SEE 13,14/A-505
FEC	INDICATES FIRE EXTINGUISHER CABINET: SEE LS SHEETS FOR EXACT TYPE AND LOCATION

GENERAL NOTES

1. SEE SHEET A-401 FOR TYPICAL ROOM MODULE PLAN.
2. SEE SHEET A-117 – A-122 FOR REFLECTED CEILING PLANS.
3. SEE SHEET A-501 FOR TYPICAL FIRE STOPPING DETAILS.
4. SEE SHEET I-001/I-601 FOR FINISH SCHEDULE.
5. SEE SHEET A-601 – A-602 FOR DOOR AND WINDOW TYPES FOR TYPICAL ROOM MODULE.
6. SEE SHEET A-501 FOR WALL TYPE DESIGNATIONS AT TYPICAL ROOM MODULE.
7. 7. FIRE EXTINGUISHER LOCATIONS FOR REFERENCE ONLY, SEE LS SHEETS FOR EXACT LOCATION AND TYPE
8. SEE SHEET A-127 FOR CMU DIMENSION PLAN

KEY PLAN

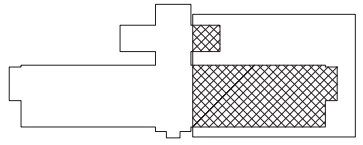

0 5' 15' 25'
2' 10'
SCALE 1/8" = 1'-0" (1 : 96)

DATE	DESCRIPTION	INIT
RECORD DRAWING AS-BUILT – 21 FEBRUARY 2012		

NAVFAC

CS&Ca

BOBBY CANADY

08/06/10

DES MS DRW MJB CHK EJS
<<PM/DM>> –
BRANCH MANAGER –
CHIEF ENG/ARCH –
<<XX>> –

DEPARTMENT OF THE NAVY
NAVAL FACILITIES ENGINEERING COMMAND
MARINE CORPS NORTH CAROLINA IPT

NAVAL FACILITIES ENGINEERING COMMAND ~ MID-ATLANTIC
<<NAVAL STATION – NORFOLK, VIRGINIA>>

MCB CAMP LEJEUNE
JACKSONVILLE, NORTH CAROLINA

FY09 BACHELOR ENLISTED QUARTERS CAMP JOHNSON P-1011 P-1016

PARTIAL FIRST FLOOR PLAN – RIGHT WING

SCALE: AS INDICATED
EPROJECT NO.. –
CONSTR. CONTR. NO. N40085-09-R-3215
NAVFAC DRAWING NO. 12564404
SHEET 78 OF 270

A-107

21 FEBRUARY 2012 CAMP JOHNSON RECORD DRAWINGS

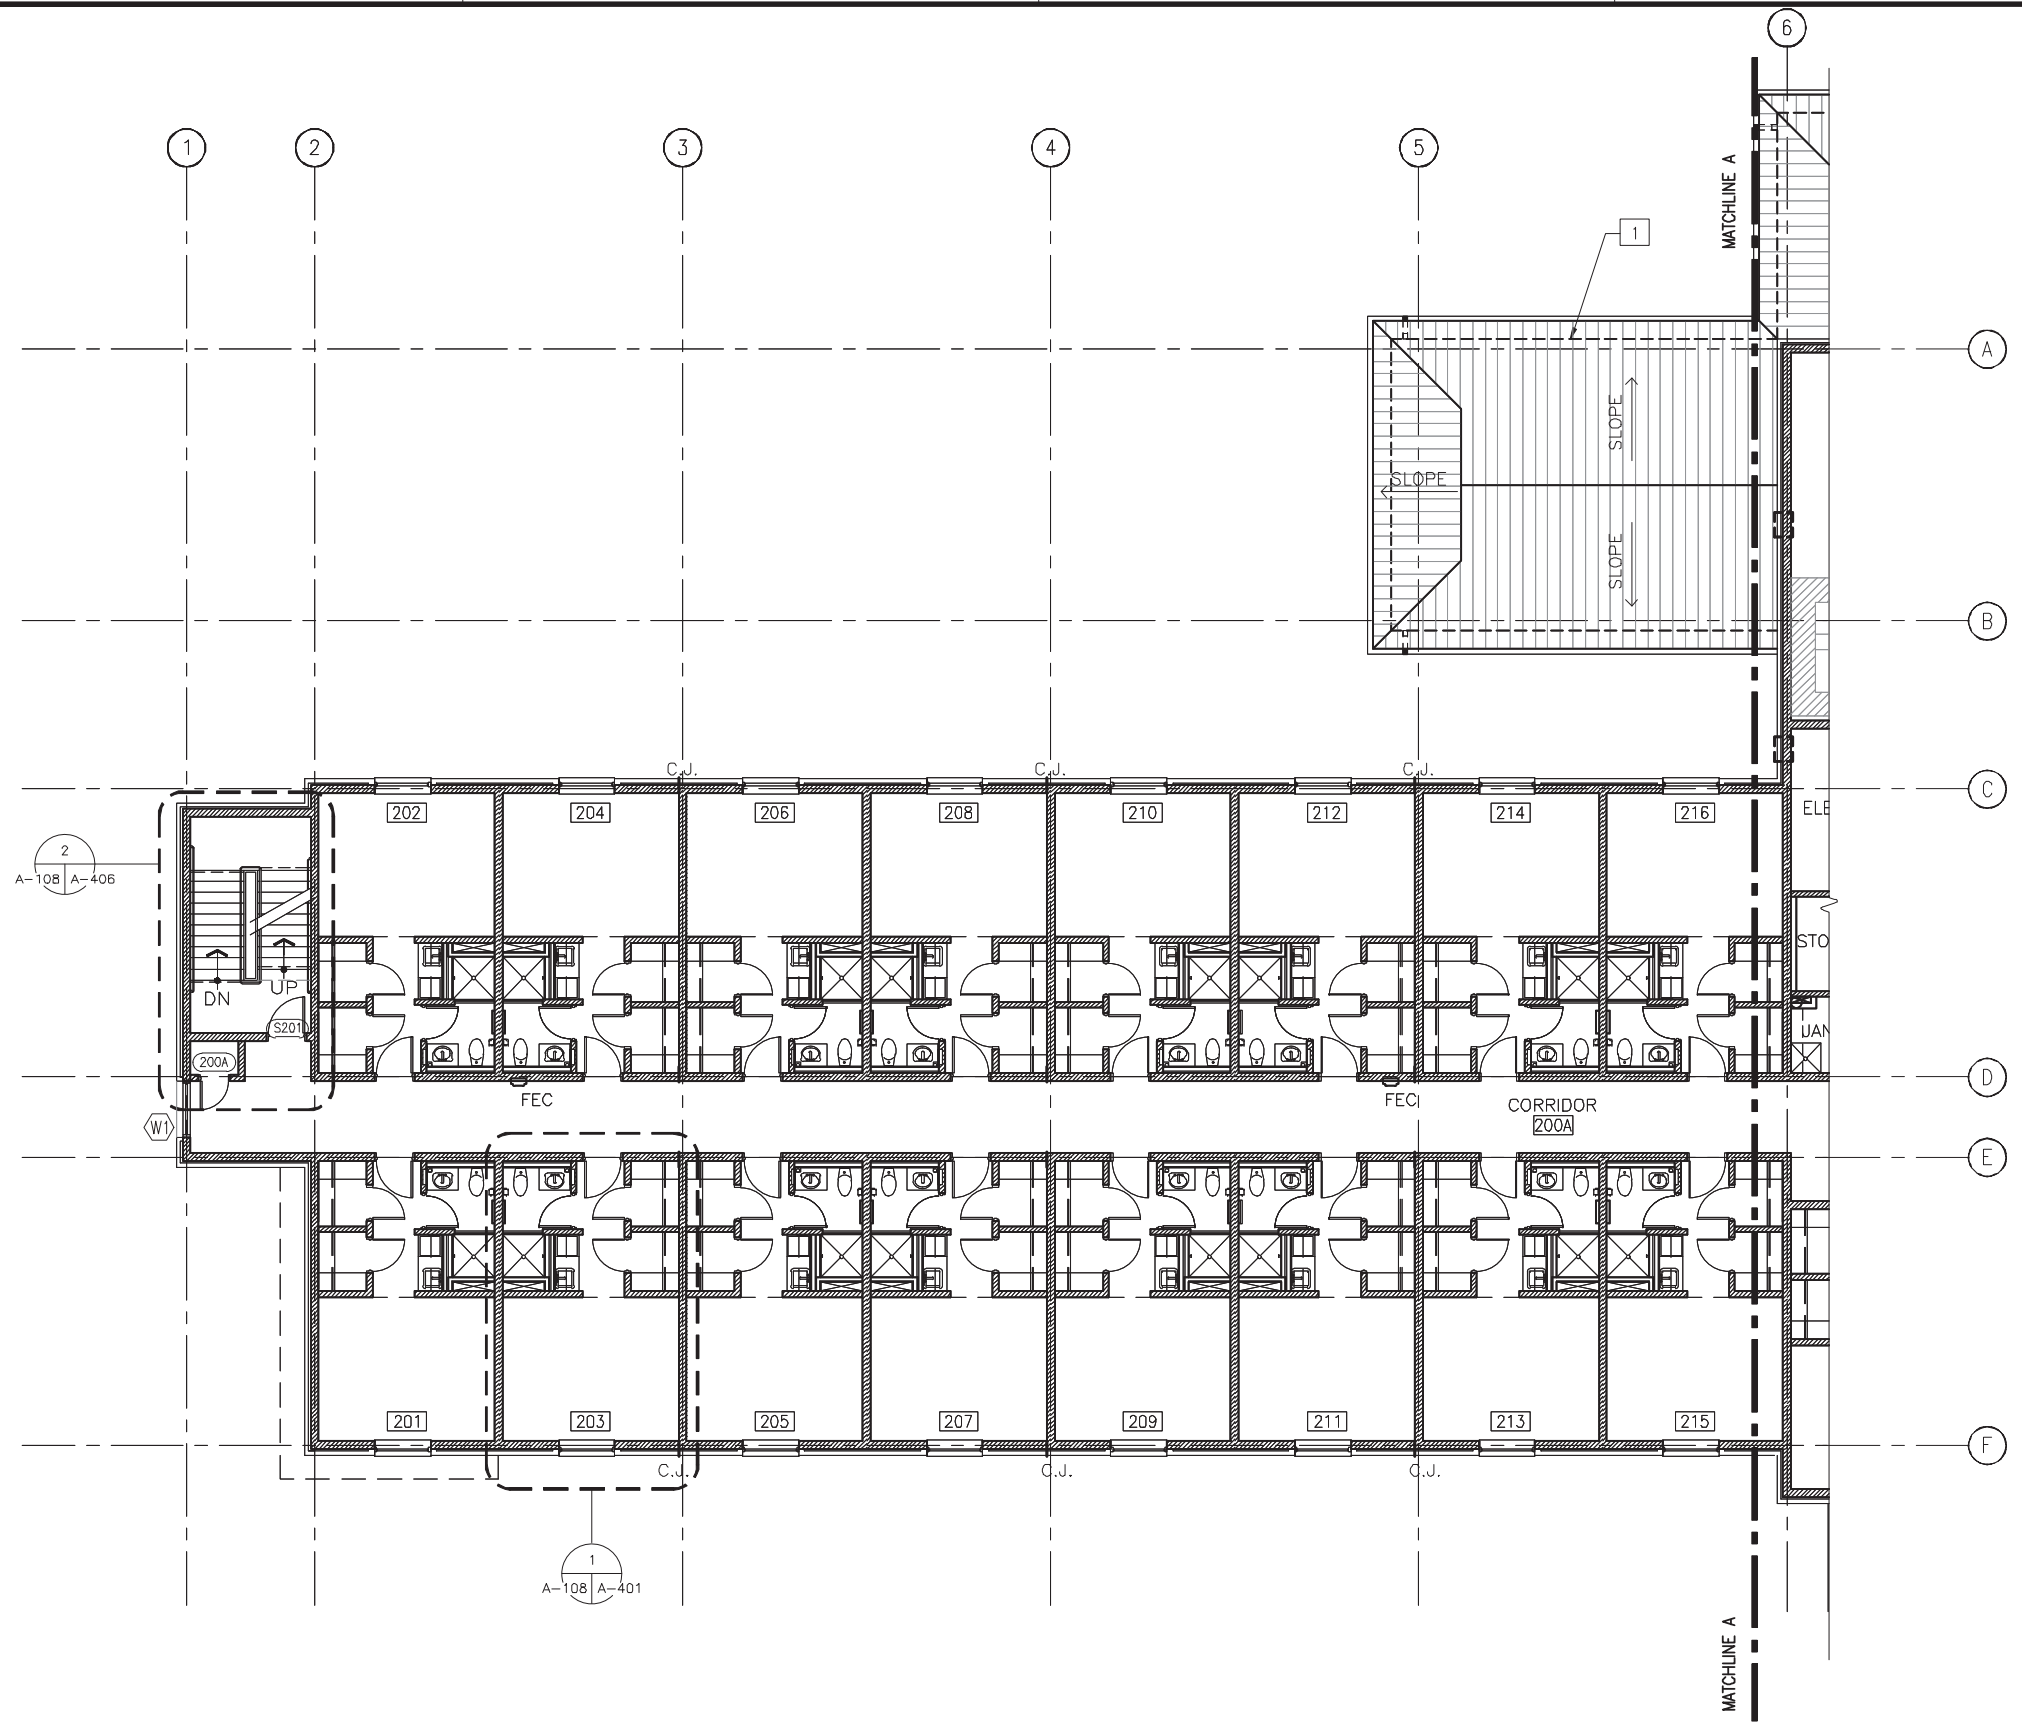

SECOND FLOOR
ENLARGED LEFT WING PLAN
A-102 A-108 SCALE: 1/8" = 1'-0"

AS-BUILT

ENLARGED CORE AREA KEYNOTES

1 4 :12 STANDING SEAM METAL ROOF

LEGEND

XXX	INDICATES DOOR TYPE – SEE SHEET A-601 FOR DOOR SCHEDULE
X	INDICATES WINDOW OR LOUVER TYPE – SEE SHEET A-601 FOR DOOR AND A-602 FOR LOUVER SCHEDULE
	CMU WALL
	METAL STUD WALL
D.S.	INDICATES DOWNSPOUT
X	INDICATES WALL TYPE – SEE SHEET A-501
C.J.	INDICATES EXTERIOR CMU/ BRICK CONTROL JOINT LOCATIONS: SEE 13,14/A-505
FEC	INDICATES FIRE EXTINGUISHER CABINET: SEE LS SHEETS FOR EXACT TYPE AND LOCATION

GENERAL NOTES

1. SEE SHEET A-401 FOR TYPICAL ROOM MODULE PLAN.
2. SEE SHEET A-117 – A-122 FOR REFLECTED CEILING PLANS.
3. SEE SHEET A-501 FOR TYPICAL FIRE STOPPING DETAILS.
4. SEE SHEET I-001/I-601 FOR FINISH SCHEDULE.
5. SEE SHEET A-601 – A-602 FOR DOOR AND WINDOW TYPES FOR TYPICAL ROOM MODULE.
6. SEE SHEET A-501 FOR WALL TYPE DESIGNATIONS AT TYPICAL ROOM MODULE.
7. 7. FIRE EXTINGUISHER LOCATIONS FOR REFERENCE ONLY, SEE LS SHEETS FOR EXACT LOCATION AND TYPE
8. SEE SHEET A-123 FOR TYPICAL CMU DIMENSION PLAN

KEY PLAN

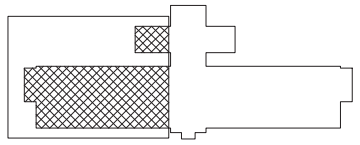

0 5' 15' 25'
2' 10'
SCALE 1/8" = 1'-0" (1 : 96)

RECORD DRAWING AS-BUILT – 21 FEBRUARY 2012	

NAVFAC

CS&Ca

BOBBY CANADY

08/06/10

DES	DRW KLB CHK
<<PM/DM>>	–
BRANCH MANAGER	–
CHIEF ENG/ARCH	–
<<XX>>	–

DEPARTMENT OF THE NAVY
NAVAL FACILITIES ENGINEERING COMMAND
MARINE CORPS NORTH CAROLINA IPT

NAVAL FACILITIES ENGINEERING COMMAND – MID-ATLANTIC
<<NAVAL STATION – NORFOLK, VIRGINIA>>

MCB CAMP LEJEUNE
JACKSONVILLE, NORTH CAROLINA

FY09 BACHELOR ENLISTED QUARTERS
CAMP JOHNSON P-1011 P-1016

PARTIAL SECOND FLOOR PLAN – LEFT WING

SCALE: AS INDICATED
EPROJECT NO.. –
CONSTR. CONTR. NO. N40085-09-R-3215
NAVFAC DRAWING NO. 12564405
SHEET 79 OF 270

A-108

21 FEBRUARY 2012 CAMP JOHNSON RECORD DRAWINGS

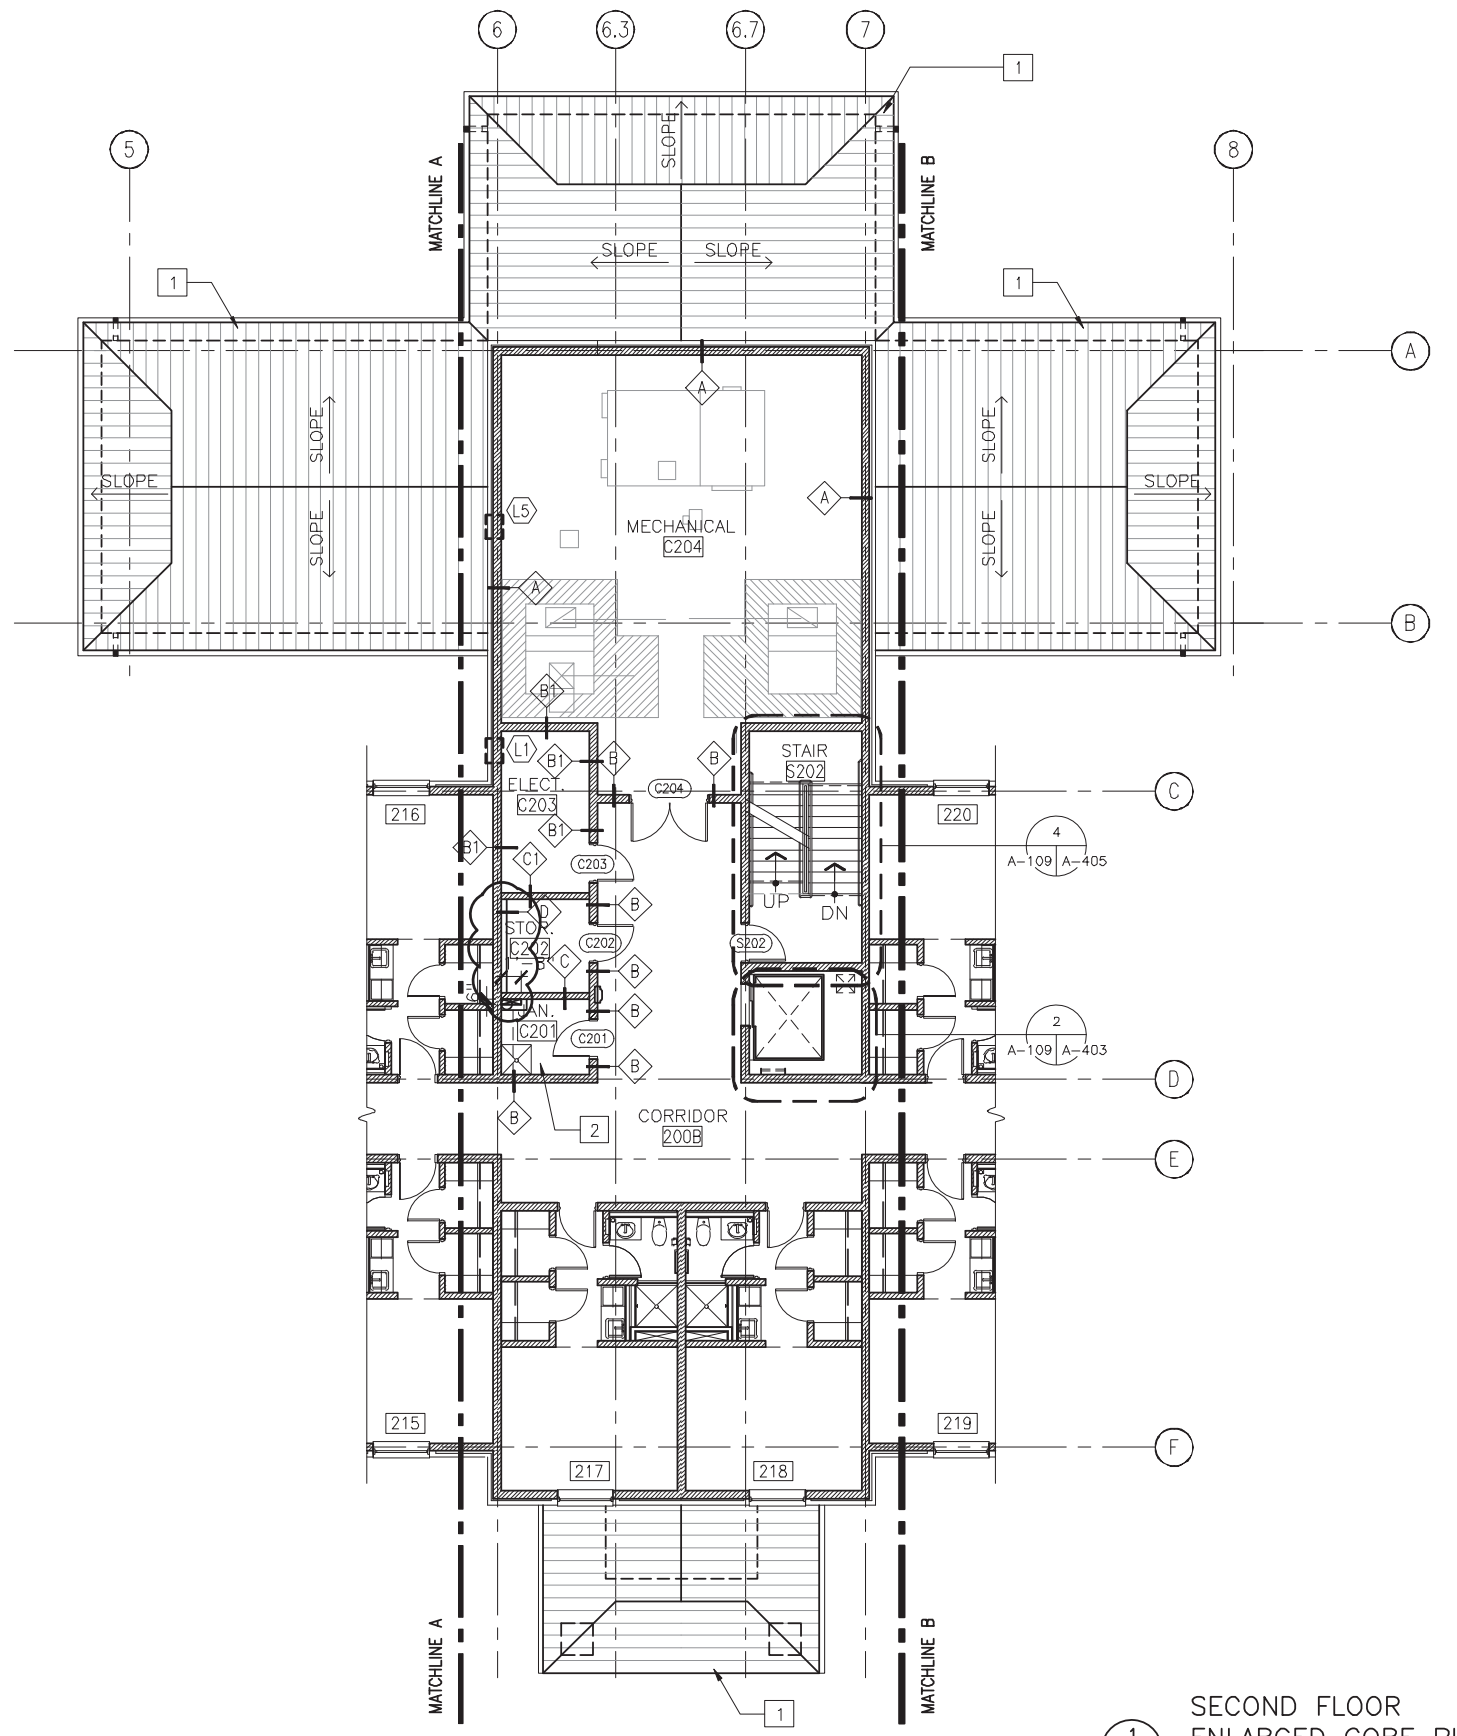

SECOND FLOOR
ENLARGED CORE PLAN
A-102 A-109 SCALE: 1/8" = 1'-0"

AS-BUILT CONDITIONS SHOWN

ENLARGED CORE AREA KEYNOTES

1. 4:12 STANDING SEAM METAL ROOF
2. JANITOR'S CLOSET W/ MOP SINK AND METAL SHELVING: SMOKE PARTITION PER FIRE LIFE SAFETY DRAWINGS

LEGEND

XXX	INDICATES DOOR TYPE – SEE SHEET A–601 FOR DOOR SCHEDULE
X	INDICATES WINDOW OR LOUVER TYPE – SEE SHEET A–601 FOR DOOR AND A–602 FOR LOUVER SCHEDULE
	CMU WALL
	METAL STUD WALL
D.S.	INDICATES DOWNSPOUT
X	INDICATES WALL TYPE – SEE SHEET A–501
C.J.	INDICATES EXTERIOR CMU/ BRICK CONTROL JOINT LOCATIONS: SEE 13,14/A–505
D FEC	INDICATES FIRE EXTINGUISHER CABINET: SEE LS SHEETS FOR EXACT TYPE AND LOCATION

GENERAL NOTES

1. SEE SHEET A–401 FOR TYPICAL ROOM MODULE PLAN.
2. SEE SHEET A–117 – A–122 FOR REFLECTED CEILING PLANS.
3. SEE SHEET A–501 FOR TYPICAL FIRE STOPPING DETAILS.
4. SEE SHEET I–001/I–601 FOR FINISH SCHEDULE.
5. SEE SHEET A–601 – A–602 FOR DOOR AND WINDOW TYPES FOR TYPICAL ROOM MODULE.
6. SEE SHEET A–501 FOR WALL TYPE DESIGNATIONS AT TYPICAL ROOM MODULE.
7. 7. FIRE EXTINGUISHER LOCATIONS FOR REFERENCE ONLY, SEE LS SHEETS FOR EXACT LOCATION AND TYPE
8. SEE SHEET A–125 FOR CMU DIMENSION PLAN

KEY PLAN

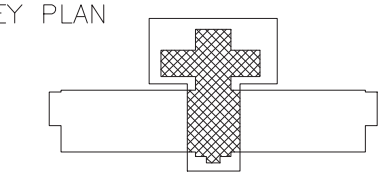

0 5' 15' 25'
2' 10'
SCALE 1/8" = 1'-0" (1 : 96)

RECORD DRAWING AS-BUILT – 21 FEBRUARY 2012	

NAVFAC

CS Ca

BOBBY CANADY

08/06/10

DES | DRW | CHK

<<PM/DM>> –
BRANCH MANAGER –
CHIEF ENG/ARCH –
<<XX>> –

DEPARTMENT OF THE NAVY
NAVAL FACILITIES ENGINEERING COMMAND
MARINE CORPS NORTH CAROLINA IPT

NAVAL FACILITIES ENGINEERING COMMAND – MID-ATLANTIC
<<NAVAL STATION – NORFOLK, VIRGINIA>>

MCB CAMP LEJEUNE
JACKSONVILLE, NORTH CAROLINA

FY09 BACHELOR ENLISTED QUARTERS
CAMP JOHNSON P-1011 P-1016

PARTIAL SECOND FLOOR PLAN – CORE

SCALE: AS INDICATED
EPROJECT NO.. –
CONSTR. CONTR. NO. N40085–09–R–3215
NAVFAC DRAWING NO. 12564406
SHEET 80 OF 270

A–109

21 FEBRUARY 2012 CAMP JOHNSON RECORD DRAWINGS

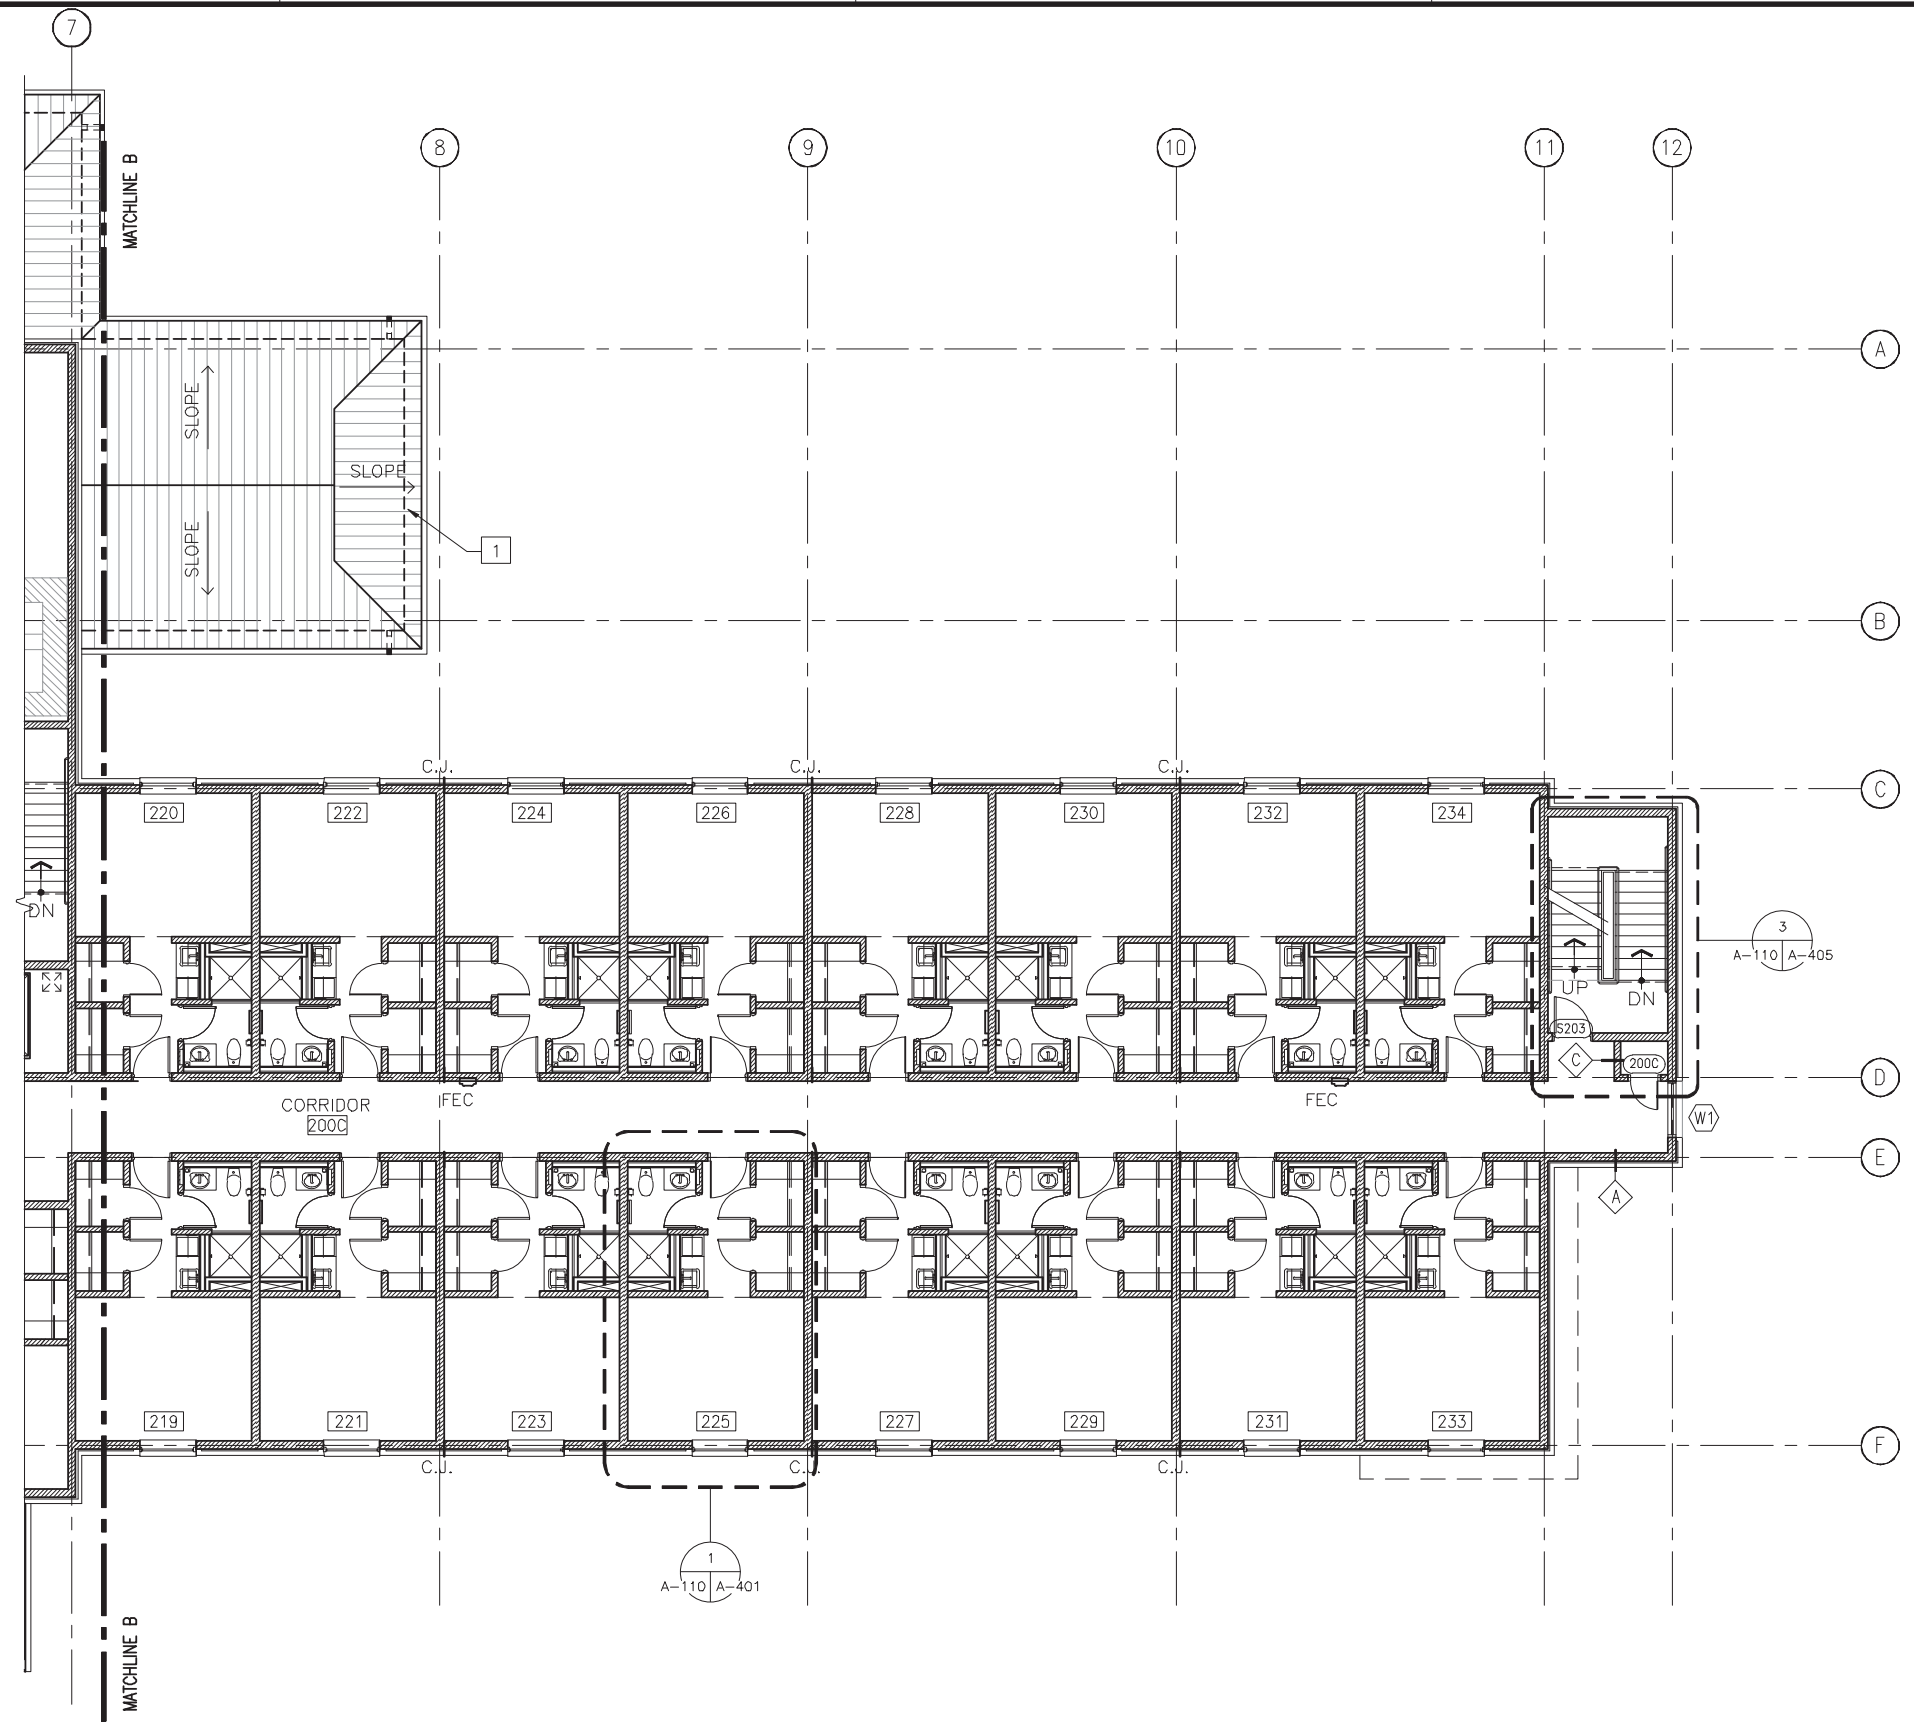

SECOND FLOOR ENLARGED RIGHT WING PLAN

1 / A-102 A-110 SCALE: 1/8" = 1'-0"

AS-BUILT

ENLARGED CORE AREA KEYNOTES

1 4:12 STANDING SEAM METAL ROOF

LEGEND

XXX	INDICATES DOOR TYPE – SEE SHEET A–601 FOR DOOR SCHEDULE
X	INDICATES WINDOW OR LOUVER TYPE – SEE SHEET A–601 FOR DOOR AND A–602 FOR LOUVER SCHEDULE
	CMU WALL
	METAL STUD WALL
D.S.	INDICATES DOWNSPOUT
X	INDICATES WALL TYPE – SEE SHEET A–501
C.J.	INDICATES EXTERIOR CMU/ BRICK CONTROL JOINT LOCATIONS: SEE 13,14/A–505
D FEC	INDICATES FIRE EXTINGUISHER CABINET: SEE LS SHEETS FOR EXACT TYPE AND LOCATION

GENERAL NOTES

1. SEE SHEET A–401 FOR TYPICAL ROOM MODULE PLAN.
2. SEE SHEET A–117 – A–122 FOR REFLECTED CEILING PLANS.
3. SEE SHEET A–501 FOR TYPICAL FIRE STOPPING DETAILS.
4. SEE SHEET I–001/I–601 FOR FINISH SCHEDULE.
5. SEE SHEET A–601 – A–602 FOR DOOR AND WINDOW TYPES FOR TYPICAL ROOM MODULE.
6. SEE SHEET A–501 FOR WALL TYPE DESIGNATIONS AT TYPICAL ROOM MODULE.
7. 7. FIRE EXTINGUISHER LOCATIONS FOR REFERENCE ONLY, SEE LS SHEETS FOR EXACT LOCATION AND TYPE
8. SEE SHEET A–127 FOR TYPICAL CMU DIMENSION PLAN

KEY PLAN

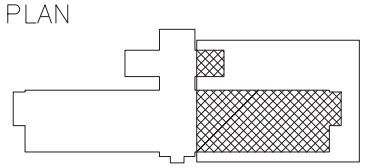

0 5' 15' 25'
2' 10'

SCALE 1/8" = 1'-0" (1 : 96)

REV	DATE	DESCRIPTION
		RECORD DRAWING AS-BUILT – 21 FEBRUARY 2012

NAVFAC

CS&Ca

DESIGNER BOBBY CANADY

DESIGNER IS COMPANY UNDER

DATE 08/06/10

DES MS	DRW MJB CHK CJC
<<PM/DM>>	–
BRANCH MANAGER	–
CHIEF ENG/ARCH	–
<<XX>>	–

DEPARTMENT OF THE NAVY
NAVAL FACILITIES ENGINEERING COMMAND
MARINE CORPS NORTH CAROLINA NFT

NAVAL FACILITIES ENGINEERING COMMAND ~ MID-ATLANTIC
<<NAVAL STATION – NORFOLK, VIRGINIA>>

MCB CAMP LEJEUNE
JACKSONVILLE, NORTH CAROLINA

FY09 BACHELOR ENLISTED QUARTERS CAMP JOHNSON P-1011 P-1016

PARTIAL SECOND FLOOR PLAN – RIGHT WING

SCALE: AS INDICATED

EPROJECT NO. –

CONSTR. CONTR. NO. N40085–09–R–3215

NAVFAC DRAWING NO. 12564407

SHEET 81 OF 270

A–110

21 FEBRUARY 2012 CAMP JOHNSON RECORD DRAWINGS

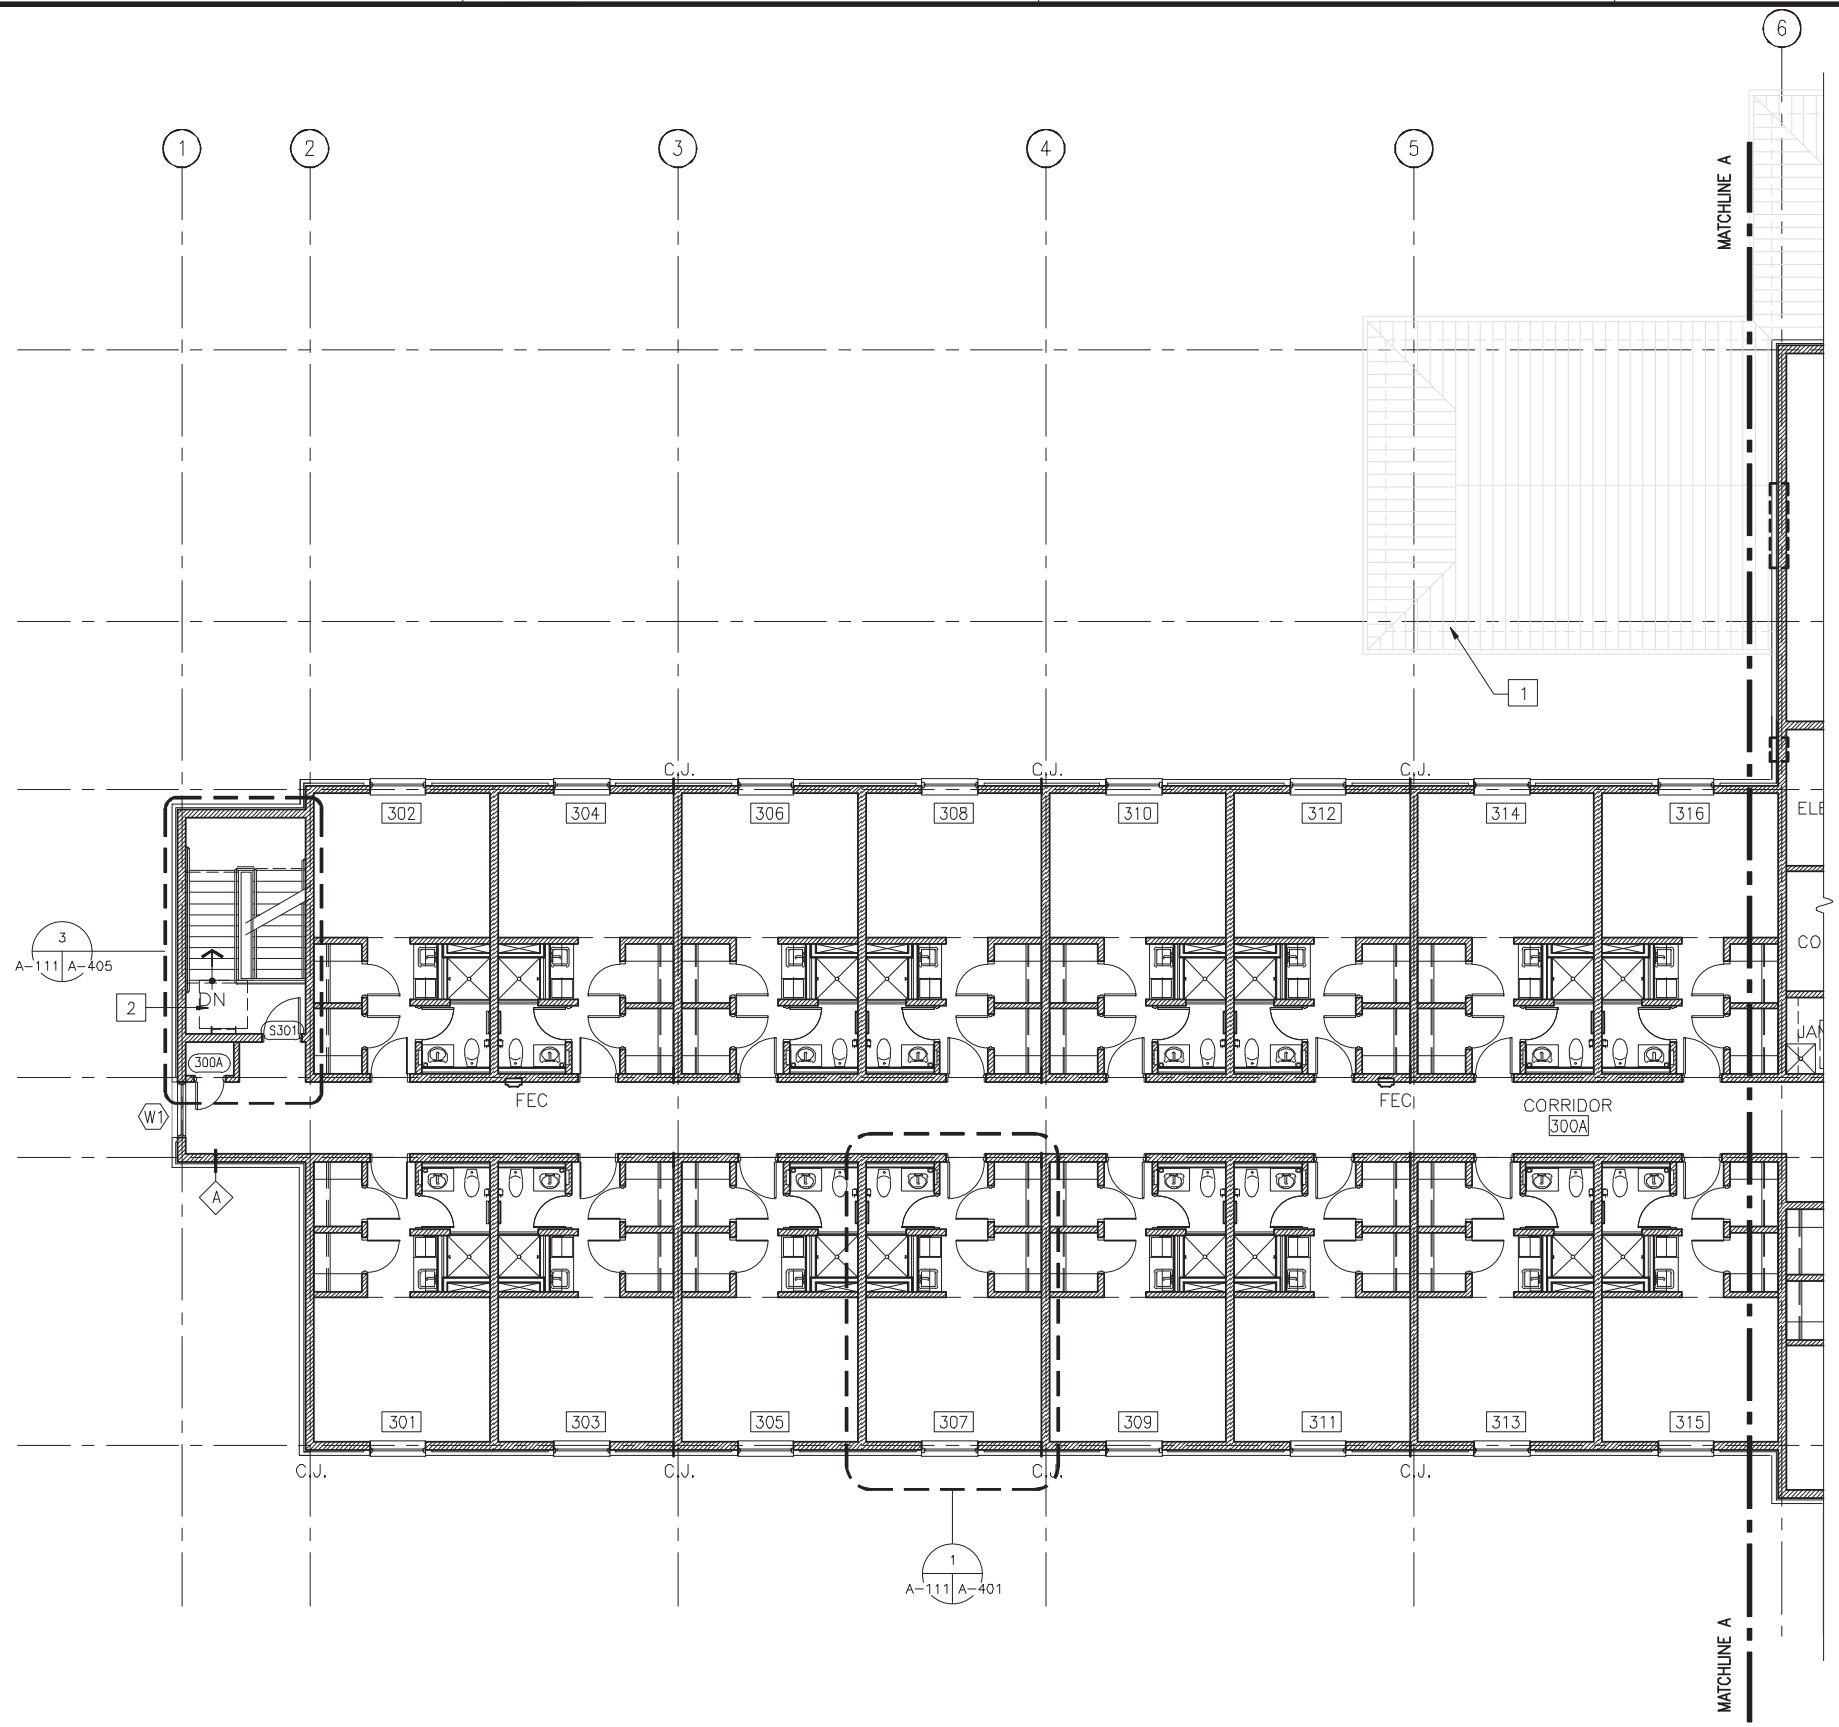

THIRD FLOOR
ENLARGED LEFT WING PLAN
1 A-103 A-111 SCALE: 1/8" = 1'-0"

AS-BUILT

ENLARGED CORE AREA KEYNOTES

1. ROOF BELOW
2. ROOF HATCH ABOVE: SEE 6/A-508

LEGEND

XXX	INDICATES DOOR TYPE – SEE SHEET A-601 FOR DOOR SCHEDULE
X	INDICATES WINDOW OR LOUVER TYPE – SEE SHEET A-601 FOR DOOR AND A-602 FOR LOUVER SCHEDULE
	CMU WALL
	METAL STUD WALL
D.S.	INDICATES DOWNSPOUT
X	INDICATES WALL TYPE – SEE SHEET A-501
C.J.	INDICATES EXTERIOR CMU/ BRICK CONTROL JOINT LOCATIONS: SEE 13,14/A-505
D FEC	INDICATES FIRE EXTINGUISHER CABINET: SEE LS SHEETS FOR EXACT TYPE AND LOCATION

GENERAL NOTES

1. SEE SHEET A-401 FOR TYPICAL ROOM MODULE PLAN.
2. SEE SHEET A-117 – A-122 FOR REFLECTED CEILING PLANS.
3. SEE SHEET A-501 FOR TYPICAL FIRE STOPPING DETAILS.
4. SEE SHEET I-001/I-601 FOR FINISH SCHEDULE.
5. SEE SHEET A-601 – A-602 FOR DOOR AND WINDOW TYPES FOR TYPICAL ROOM MODULE.
6. SEE SHEET A-501 FOR WALL TYPE DESIGNATIONS AT TYPICAL ROOM MODULE.
7. 7. FIRE EXTINGUISHER LOCATIONS FOR REFERENCE ONLY, SEE LS SHEETS FOR EXACT LOCATION AND TYPE
8. SEE SHEET A-123 FOR TYPICAL CMU DIMENSION PLAN

KEY PLAN

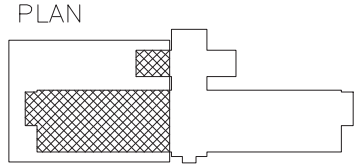

0 5' 15' 25'
2' 10'
SCALE 1/8" = 1'-0" (1 : 96)

RECORD DRAWING
AS-BUILT – 21 FEBRUARY 2012

NAVFAC

CS&Ca

PM COMMANDER NAVFAC
BOBBY CANADY
08/06/10

DES	MS	DRW	KJB	CHK	DJG
<<PM/DM>>		–			
BRANCH MANAGER		–			
CHIEF ENG/ARCH		–			
<<XXX>>		–			

DEPARTMENT OF THE NAVY
NAVAL FACILITIES ENGINEERING COMMAND
MARINE CORPS NORTH CAROLINA IPT

NAVAL FACILITIES ENGINEERING COMMAND ~ MID-ATLANTIC
<<NAVAL STATION – NORFOLK, VIRGINIA>>

MCB CAMP LEJEUNE
JACKSONVILLE, NORTH CAROLINA

FY09 BACHELOR ENLISTED QUARTERS
CAMP JOHNSON P-1011 P-1016

PARTIAL THIRD FLOOR PLAN – LEFT WING

SCALE: AS INDICATED
EPROJECT NO.: –
CONSTR. CONTR. NO. N40085-09-R-3215
NAVFAC DRAWING NO. 12564408
SHEET 82 OF 270

A-111

21 FEBRUARY 2012 CAMP JOHNSON RECORD DRAWINGS

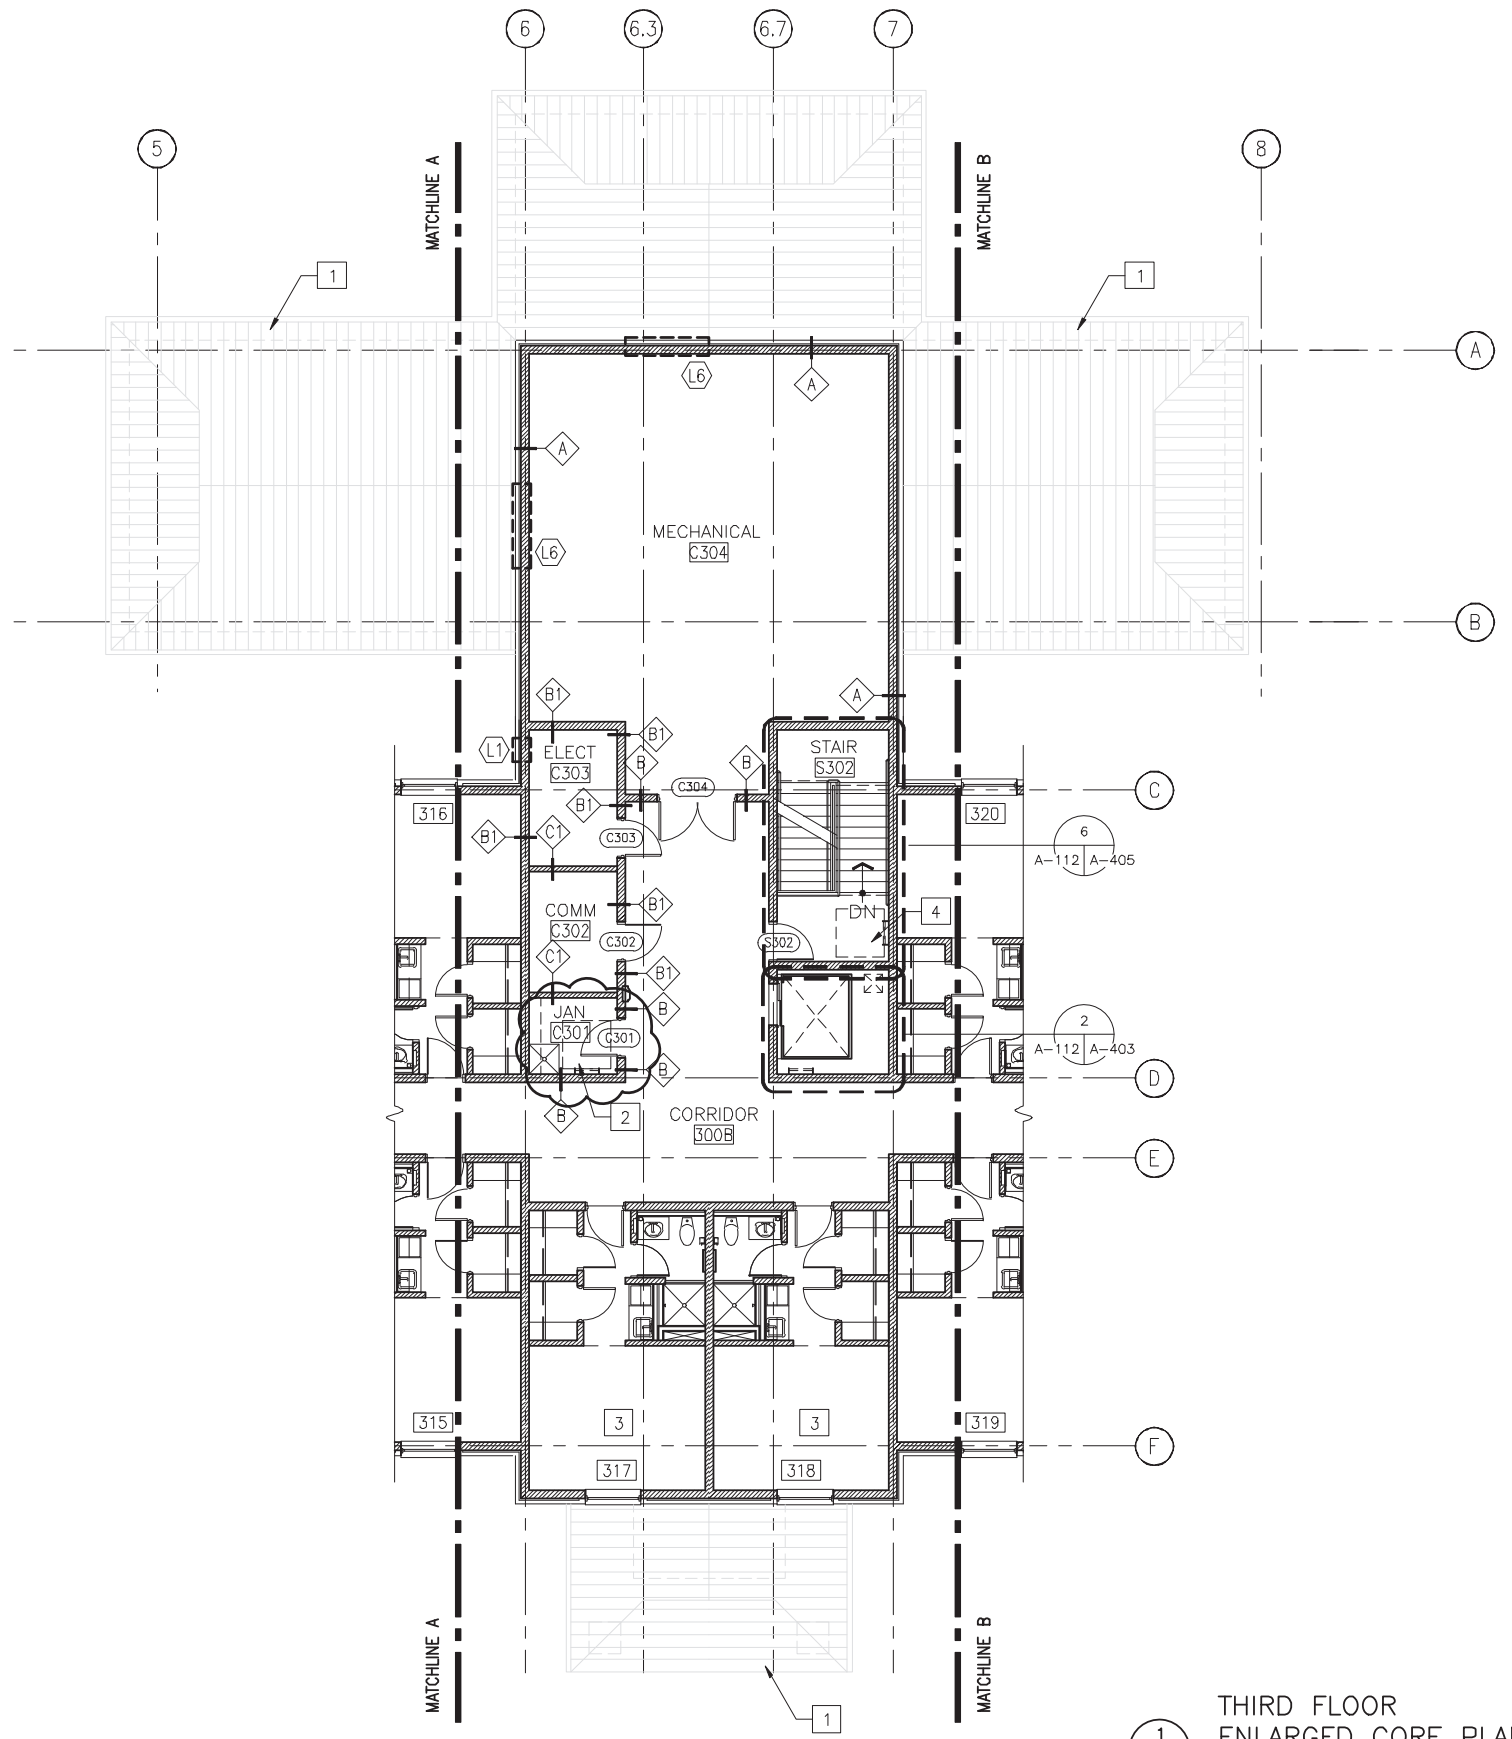

THIRD FLOOR
ENLARGED CORE PLAN
A-103 A-112 SCALE: 1/8" = 1'-0"

AS-BUILT CONDITIONS SHOWN

ENLARGED CORE AREA KEYNOTES

1. ROOF BELOW
2. JANITOR'S CLOSET W/ MOP SINK AND METAL SHELVING
3. TYPICAL LIVING MODULE (SEE 1/A-401)
4. ROOF HATCH ABOVE: SEE 6/A-508
5. CATWALK ACCESS HATCH ABOVE: 30 MIN RATED

LEGEND

XXX	INDICATES DOOR TYPE – SEE SHEET A-601 FOR DOOR SCHEDULE
X	INDICATES WINDOW OR LOUVER TYPE – SEE SHEET A-601 FOR DOOR AND A-602 FOR LOUVER SCHEDULE
	CMU WALL
	METAL STUD WALL
D.S.	INDICATES DOWNSPOUT
X	INDICATES WALL TYPE – SEE SHEET A-501
C.J.	INDICATES EXTERIOR CMU/ BRICK CONTROL JOINT LOCATIONS: SEE 13,14/A-505
FEC	INDICATES FIRE EXTINGUISHER CABINET: SEE LS SHEETS FOR EXACT TYPE AND LOCATION

GENERAL NOTES

1. SEE SHEET A-401 FOR TYPICAL ROOM MODULE PLAN.
2. SEE SHEET A-117 – A-122 FOR REFLECTED CEILING PLANS.
3. SEE SHEET A-501 FOR TYPICAL FIRE STOPPING DETAILS.
4. SEE SHEET I-001/I-601 FOR FINISH SCHEDULE.
5. SEE SHEET A-601 – A-602 FOR DOOR AND WINDOW TYPES FOR TYPICAL ROOM MODULE.
6. SEE SHEET A-501 FOR WALL TYPE DESIGNATIONS AT TYPICAL ROOM MODULE.
7. 7. FIRE EXTINGUISHER LOCATIONS FOR REFERENCE ONLY, SEE LS SHEETS FOR EXACT LOCATION AND TYPE
8. SEE SHEET A-126 FOR CMU DIMENSION PLAN

KEY PLAN

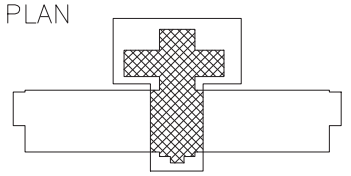

0 5' 15' 25'
2' 10'
SCALE 1/8" = 1'-0" (1 : 96)

RECORD DRAWING
AS-BUILT – 21 FEBRUARY 2012

NAVFAC

BOBBY CANADY

08/06/10

DES	MS	DRW	MJB	CHK	CJC
<<PM/DM>>		–			
BRANCH MANAGER		–			
CHIEF ENG/ARCH		–			
<<XXX>>		–			

DEPARTMENT OF THE NAVY
NAVAL FACILITIES ENGINEERING COMMAND
MARINE CORPS NORTH CAROLINA IPT

NAVAL FACILITIES ENGINEERING COMMAND ~ MID-ATLANTIC
<<NAVAL STATION – NORFOLK, VIRGINIA>>

MCB CAMP LEJEUNE
JACKSONVILLE, NORTH CAROLINA

FY09 BACHELOR ENLISTED QUARTERS
CAMP JOHNSON P-1011 P-1016

PARTIAL THIRD FLOOR PLAN – CORE

SCALE: AS INDICATED
EPROJECT NO.: –
CONSTR. CONTR. NO.: N40085-09-R-3215
NAVFAC DRAWING NO.: 12564409
SHEET 83 OF 270

A-112

21 FEBRUARY 2012 CAMP JOHNSON RECORD DRAWINGS

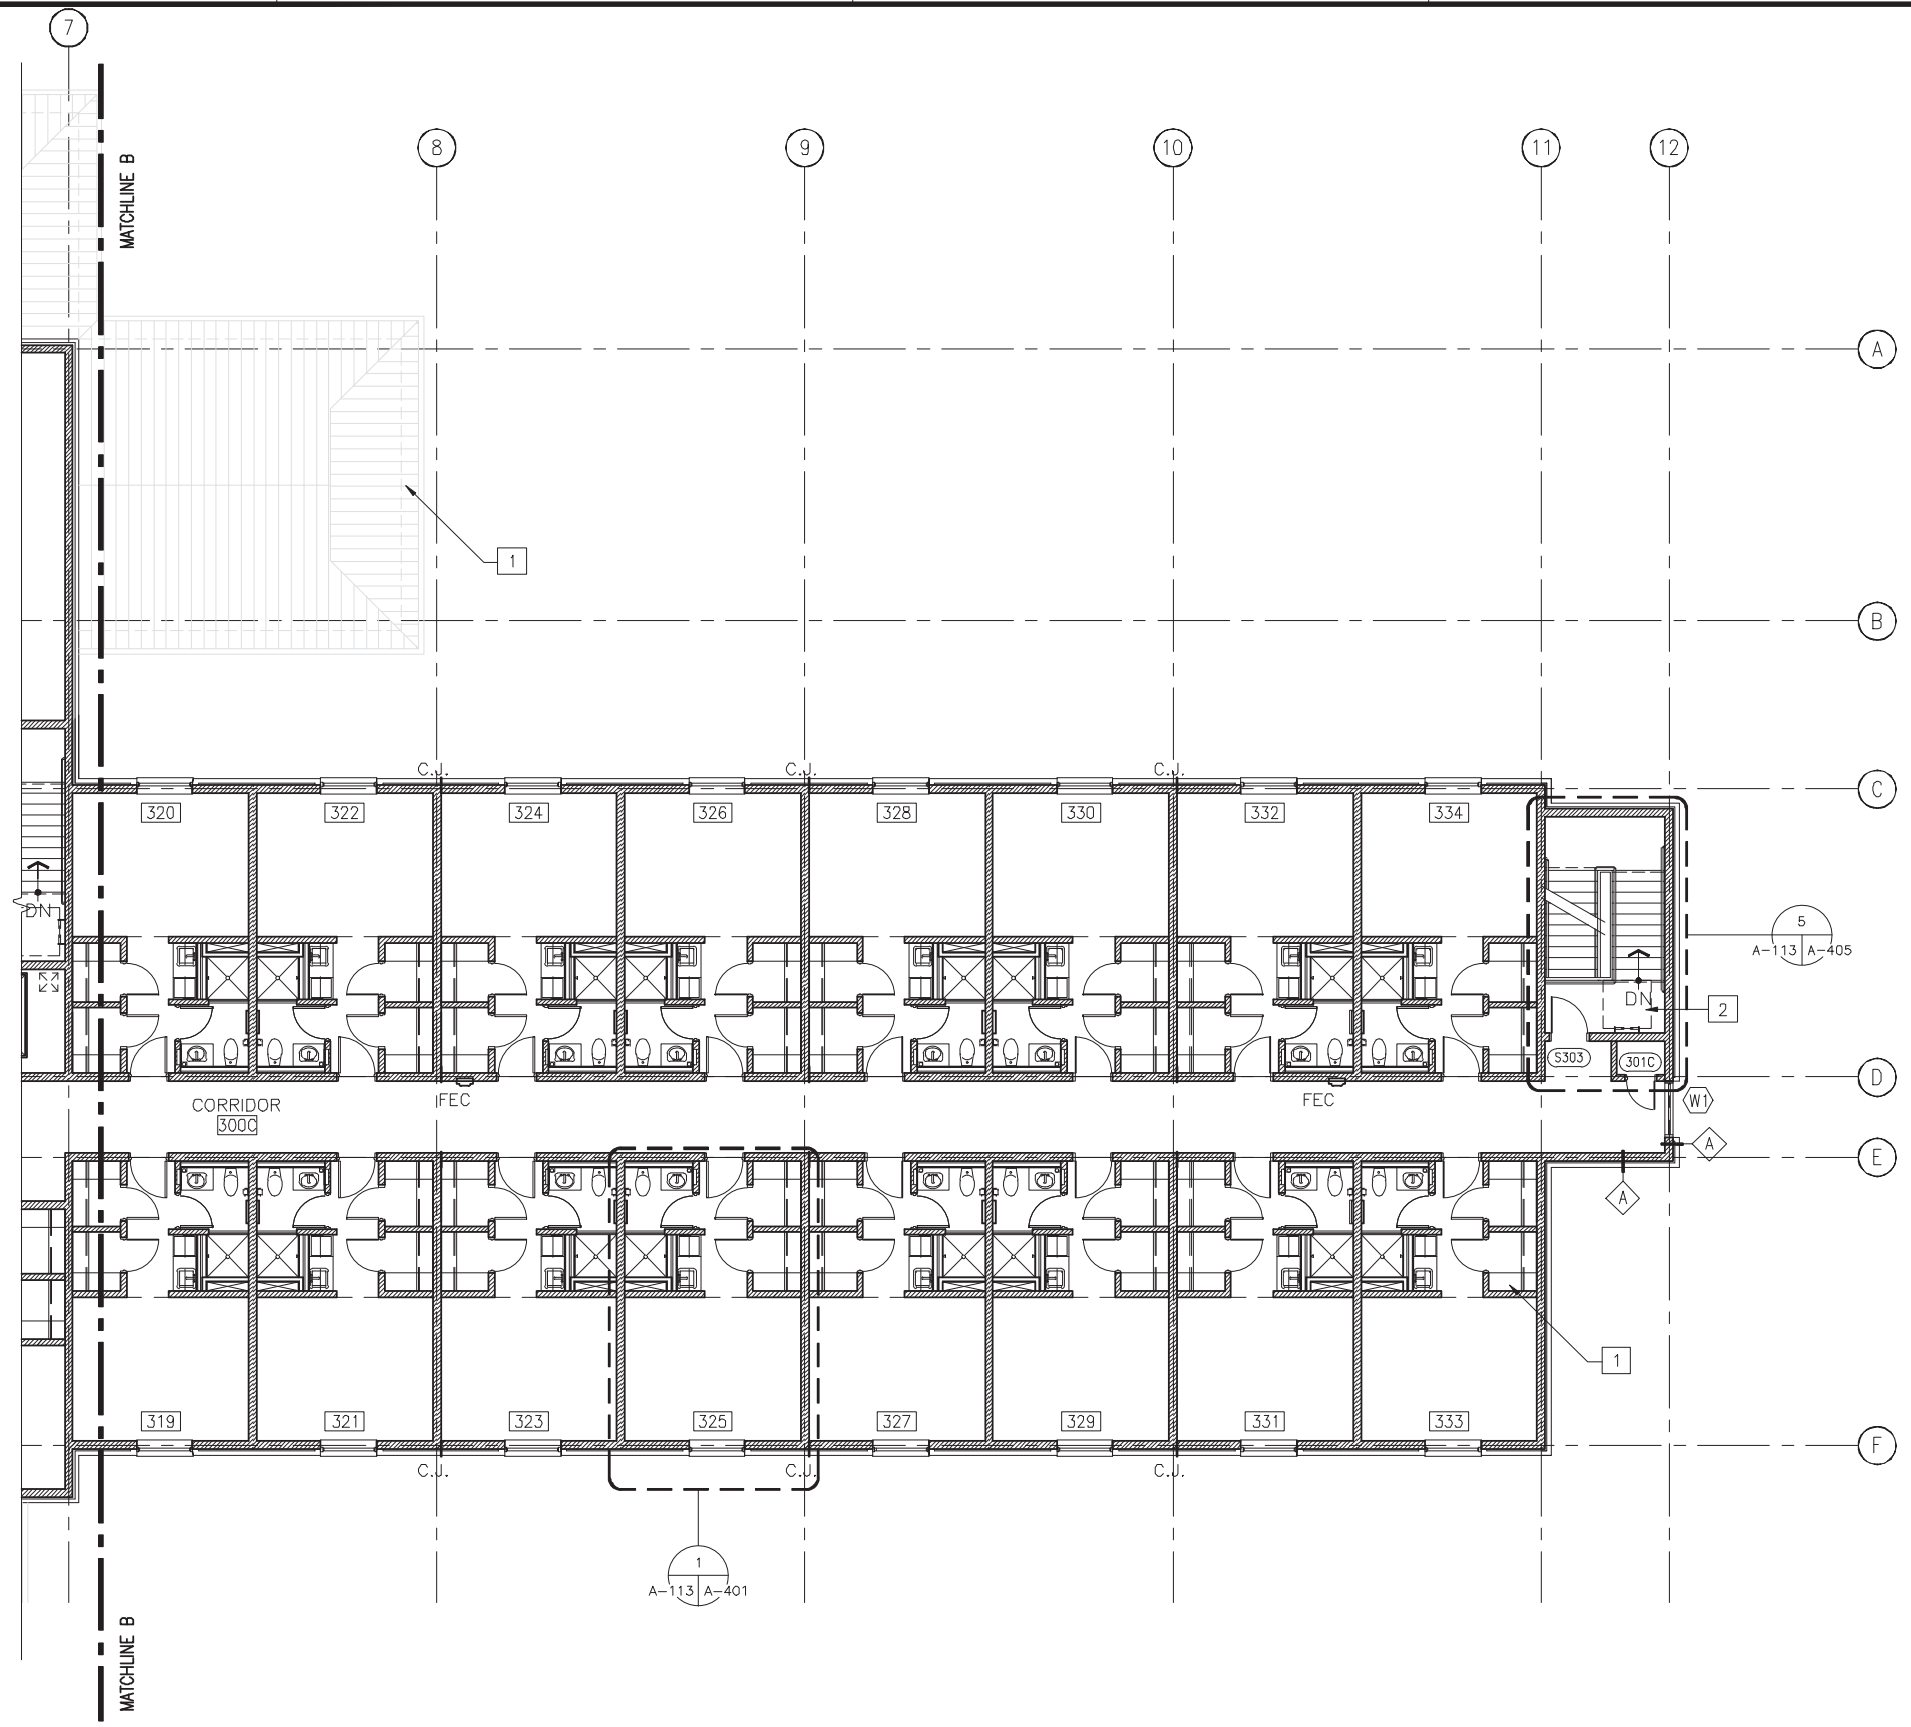

ENLARGED CORE AREA KEYNOTES

1. ROOF BELOW
2. ROOF HATCH ABOVE: SEE 6/A-508

LEGEND

XXX	INDICATES DOOR TYPE – SEE SHEET A-601 FOR DOOR SCHEDULE
X	INDICATES WINDOW OR LOUVER TYPE – SEE SHEET A-601 FOR DOOR AND A-602 FOR LOUVER SCHEDULE
	CMU WALL
	METAL STUD WALL
D.S.	INDICATES DOWNSPOUT
X	INDICATES WALL TYPE – SEE SHEET A-501
C.J.	INDICATES EXTERIOR CMU/ BRICK CONTROL JOINT LOCATIONS: SEE 13,14/A-505
FEC	INDICATES FIRE EXTINGUISHER CABINET: SEE LS SHEETS FOR EXACT TYPE AND LOCATION

GENERAL NOTES

1. SEE SHEET A-401 FOR TYPICAL ROOM MODULE PLAN.
2. SEE SHEET A-117 – A-122 FOR REFLECTED CEILING PLANS.
3. SEE SHEET A-501 FOR TYPICAL FIRE STOPPING DETAILS.
4. SEE SHEET I-001/I-601 FOR FINISH SCHEDULE.
5. SEE SHEET A-601 – A-602 FOR DOOR AND WINDOW TYPES FOR TYPICAL ROOM MODULE.
6. SEE SHEET A-501 FOR WALL TYPE DESIGNATIONS AT TYPICAL ROOM MODULE.
7. 7. FIRE EXTINGUISHER LOCATIONS FOR REFERENCE ONLY, SEE LS SHEETS FOR EXACT LOCATION AND TYPE
8. SEE SHEET A-127 FOR TYPICAL CMU DIMENSION PLAN

KEY PLAN

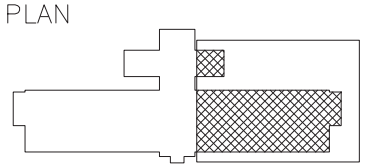

THIRD FLOOR ENLARGED RIGHT WING PLAN

1 / A-103 A-113 SCALE: 1/8" = 1'-0"

0 5' 15' 25'
2' 10'

SCALE 1/8" = 1'-0" (1 : 96)

AS-BUILT

NO.	DATE	DESCRIPTION	BY
		RECORD DRAWING AS-BUILT – 21 FEBRUARY 2012	

NAVFAC

CS&Ca

DESIGNER: BOBBY CANADY

DATE: 08/06/10

DES	DRW	CHK
<<PM/DM>> –		
BRANCH MANAGER –		
CHIEF ENG/ARCH –		
<<XX>> –		

DEPARTMENT OF THE NAVY
NAVAL FACILITIES ENGINEERING COMMAND
MARINE CORPS NORTH CAROLINA NFT

NAVAL FACILITIES ENGINEERING COMMAND ~ MID-ATLANTIC
<<NAVAL STATION – NORFOLK, VIRGINIA>>

MCB CAMP LEJEUNE
JACKSONVILLE, NORTH CAROLINA

FY09 BACHELOR ENLISTED QUARTERS CAMP JOHNSON P-1011 P-1016

PARTIAL THIRD FLOR PLAN – RIGHT WING

SCALE: AS INDICATED

EPROJECT NO.: –

CONSTR. CONTR. NO.: N40085-09-R-3215

NAVFAC DRAWING NO.: 12564410

SHEET 84 OF 270

A-113

21 FEBRUARY 2012 CAMP JOHNSON RECORD DRAWINGS