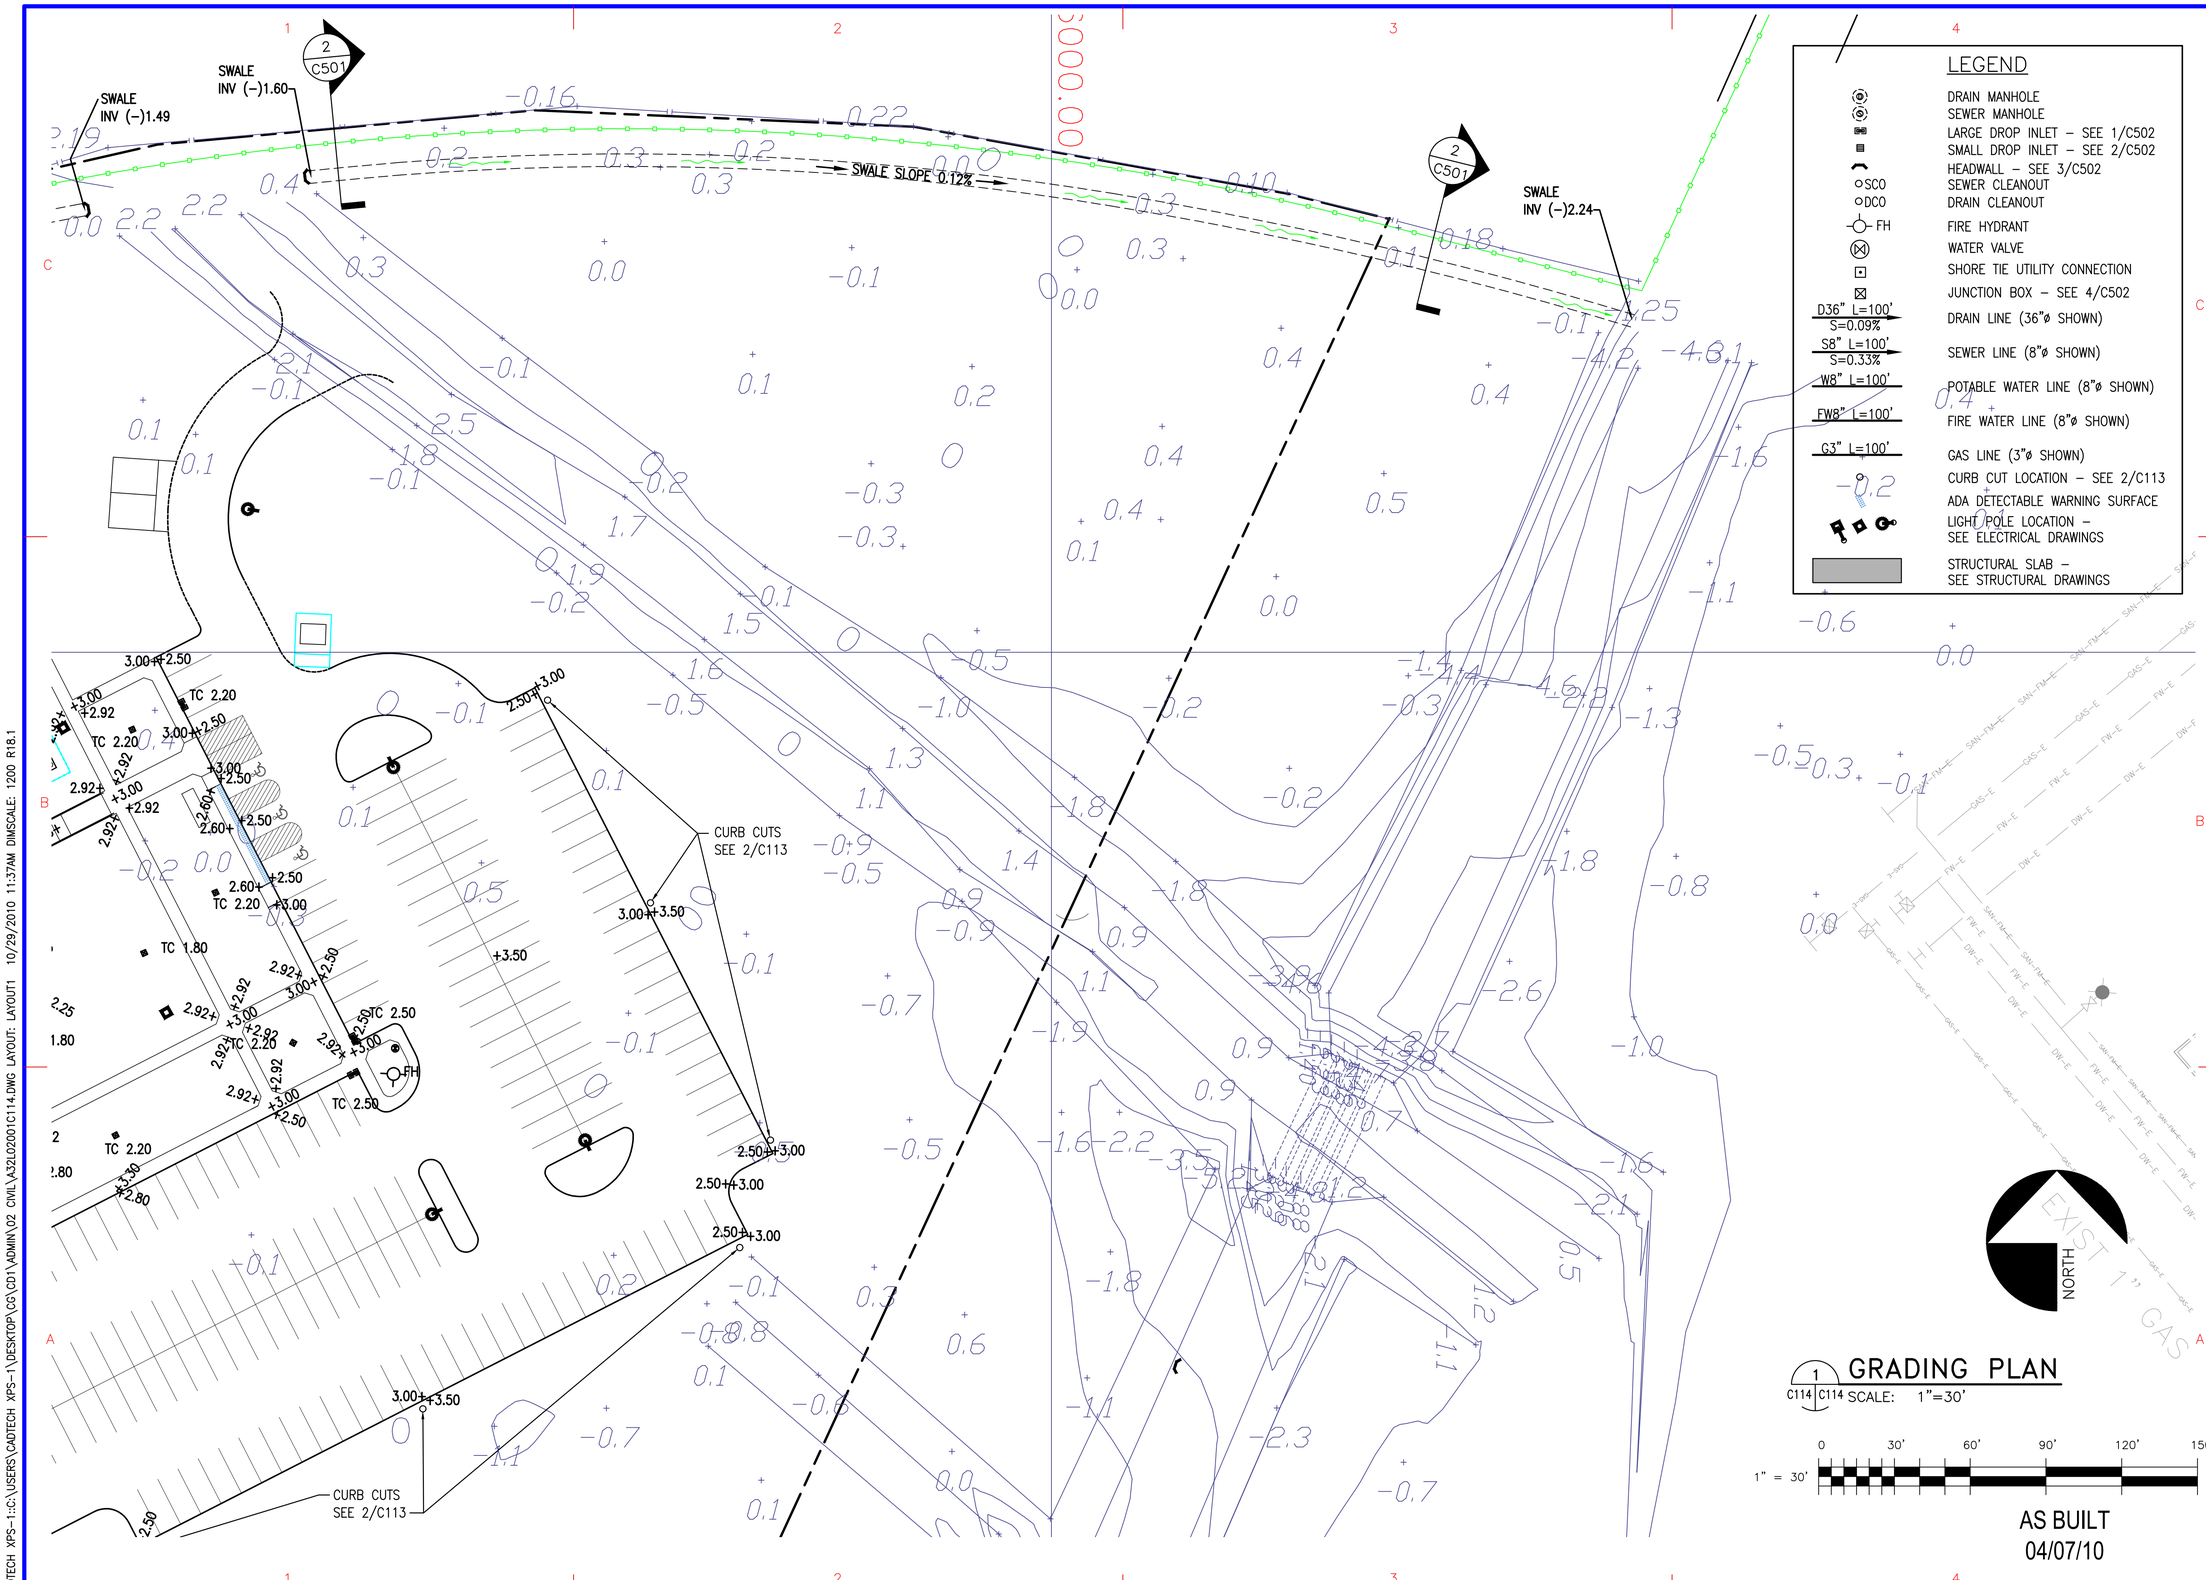

LEGEND

	DRAIN MANHOLE
	SEWER MANHOLE
	LARGE DROP INLET – SEE 1/C502
	SMALL DROP INLET – SEE 2/C502
	HEADWALL – SEE 3/C502
SCO	SEWER CLEANOUT
DCO	DRAIN CLEANOUT
FH	FIRE HYDRANT
	WATER VALVE
	SHORE TIE UTILITY CONNECTION
	JUNCTION BOX – SEE 4/C502
D36" L=100' S=0.09%	DRAIN LINE (36"ø SHOWN)
S8" L=100' S=0.33%	SEWER LINE (8"ø SHOWN)
W8" L=100'	POTABLE WATER LINE (8"ø SHOWN)
FW8" L=100'	FIRE WATER LINE (8"ø SHOWN)
G3" L=100'	GAS LINE (3"ø SHOWN)
	CURB CUT LOCATION – SEE 2/C113
	ADA DETECTABLE WARNING SURFACE
	LIGHT POLE LOCATION – SEE ELECTRICAL DRAWINGS
	STRUCTURAL SLAB – SEE STRUCTURAL DRAWINGS

1 C114 C114 GRADING PLAN SCALE: 1"=30'

0 30' 60' 90' 120' 150'

1" = 30'

AS BUILT
04/07/10

MORPHY MAKOFSKY INCORPORATED
Consulting Engineers
336 N. Jeff Davis Pkwy.
New Orleans, LA 70119
Phone 504/488-1317 Fax 504/488-0924
Email: info@mmi-eng.com
JOB NO. 08023

CONSULTANTS

A JOINT VENTURE
BROADMOOR BUILDING by DESIGN
BOH BROS. CONSTRUCTION CO., LLC

BROADMOOR / BOH BROS.
A JOINT VENTURE
2740 NORTH ARNOULT RD.
METAIRIE, LA 70002
LA LICENSE NO. 7908

U. S. COAST GUARD
FACILITIES DESIGN & CONSTRUCTION CENTER
FDCC LANT

FDCC LANT
5505 ROBIN HOOD ROAD
NORFOLK, VIRGINIA 23513-2431

ISSUE

MARK	DATE	DESCRIPTION

A/E PROJECT NO: 3001.70
CAD FILE NAME: A32L02001C114.dwg
DESIGNED BY: AM
DRAWN BY: JTS
EDITED BY:
CHECKED BY: AM

SCALE: 1" = 30'-0" PLOT SCALE: 1 : 1

SHEET TITLE

RECONSTRUCTION OF USCG
INTEGRATED SUPPORT COMMAND
NEW ORLEANS LA
NASA MICHOUD

GRADING PLAN

REVIEWED BY:	REVIEWED BY:	REVIEWED BY:
PROJECT ENG.	BRANCH CHIEF	TECH. DIRECTOR

APPROVING OFFICER — DATE 12/22/08

PROJECT NUMBER	DRAWING NUMBER
32-L02001	A32L02001C114

DISCIPLINE/SHT NO C114

SHEET 23 OF 405

CADTECH XPS-1::C:\USERS\CADTECH XPS-1\DESKTOP\CG\CD1\ADMIN\02 CIVIL\A32L02001C114.DWG LAYOUT: LAYOUT1 10/29/2010 11:37AM DIMSCALE: 1200 R18.1